

GENERAL NOTES

- ES-1 UNLESS OTHERWISE INDICATED, ALL VEGETATIVE AND STRUCTURAL EROSION AND SEDIMENT CONTROL PRACTICES WILL BE CONSTRUCTED AND MAINTAINED ACCORDING TO MINIMUM STANDARDS AND SPECIFICATIONS OF THE VIRGINIA EROSION AND SEDIMENT CONTROL HANDBOOK AND VIRGINIA REGULATIONS VR 625-02-00 EROSION AND SEDIMENT CONTROL REGULATIONS.
- ES-2 THE PLAN APPROVING AUTHORITY MUST BE NOTIFIED ONE WEEK PRIOR TO THE PRECONSTRUCTION CONFERENCE, ONE WEEK PRIOR TO THE COMMENCEMENT OF LAND DISTURBING ACTIVITY, AND ONE WEEK PRIOR TO THE FINAL INSPECTION.
- ES-3 ALL EROSION AND SEDIMENT CONTROL MEASURES ARE TO BE PLACED PRIOR TO OR AS THE FIRST STEP IN CLEARING.
- ES-4 A COPY OF THE APPROVED EROSION AND SEDIMENT CONTROL PLAN SHALL BE MAINTAINED ON THE SITE AT ALL TIMES.
- ES-5 PRIOR TO COMMENCING LAND DISTURBING ACTIVITIES IN AREAS OTHER THAN INDICATED ON THESE PLANS (INCLUDING, BUT NOT LIMITED TO, OFF-SITE BORROW OR WASTE AREAS), THE CONTRACTOR SHALL SUBMIT A SUPPLEMENTARY EROSION CONTROL PLAN TO THE OWNER FOR REVIEW AND APPROVAL BY THE PLAN APPROVING AUTHORITY.
- ES-6 THE CONTRACTOR IS RESPONSIBLE FOR INSTALLATION OF ANY ADDITIONAL EROSION CONTROL MEASURES NECESSARY TO PREVENT EROSION AND SEDIMENTATION AS DETERMINED BY THE PLAN APPROVING AUTHORITY.
- ES-7 ALL DISTURBED AREAS ARE TO DRAIN TO APPROVED SEDIMENT CONTROL MEASURES AT ALL TIMES DURING LAND DISTURBING ACTIVITIES AND DURING SITE DEVELOPMENT UNTIL FINAL STABILIZATION IS ACHIEVED.
- ES-8 DURING DEWATERING OPERATIONS, WATER WILL BE PUMPED INTO AN APPROVED FILTERING DEVICE.
- ES-9 THE CONTRACTOR SHALL INSPECT ALL EROSION CONTROL MEASURES PERIODICALLY AND AFTER EACH RUNOFF-PRODUCING RAINFALL EVENT. ANY NECESSARY REPAIRS OR CLEANUP TO MAINTAIN THE EFFECTIVENESS OF THE EROSION CONTROL DEVICES SHALL BE MADE IMMEDIATELY.

TYPE A

15 OCTOBER TO 1 FEBRUARY
K-31 FESCUE @ 5 LB / 1000 SF
BORZY WINTER RYE @ 1/2 LB / 1000 SF
1 FEBRUARY TO 1 JUNE
K-31 FESCUE @ 5 LB / 1000 SF
ANNUAL RYE @ 1/2 LB / 1000 SF
1 JUNE TO 1 SEPTEMBER
K-31 FESCUE @ 5 LB / 1000 SF
GERMAN MILLET @ 1/2 LB / 1000 SF
1 SEPTEMBER TO 15 OCTOBER
K-31 FESCUE @ 5 LB / 1000 SF
ANNUAL RYE @ 1/2 LB / 1000 SF

TYPE B (SLOPES 3:1 OR STEEPER)

15 MARCH TO 1 MAY
CROWN VETCH @ 1/2 LB / 1000 SF
PERENNIAL RYEGRASS @ 1/2 LB / 1000 SF
RED TOP @ 1/8 LB / 1000 SF
15 AUGUST TO 1 OCTOBER
CROWN VETCH @ 1/2 LB / 1000 SF
PERENNIAL RYEGRASS @ 1/2 LB / 1000 SF
RED TOP @ 1/8 LB / 1000 SF

LIME: 140 LB / 1000 SF PULVERIZED AGRICULTURAL LIMESTONE

FERTILIZER: 5-20-10 @ 25 LB / 1000 SF
38-0-0 @ 7 LB / 1000 SF

MULCH: IF REQUIRED, SHALL BE USED OVER ALL SEEDED AREAS AND SHALL BE APPLIED IN ACCORDANCE WITH SECTION 1.75 OF THE VIRGINIA EROSION AND SEDIMENT CONTROL HANDBOOK, LATEST EDITION.


SOIL CONDITIONING: INCORPORATION OF LIME AND FERTILIZER, SELECTION OF CERTIFIED SEED, MULCHING, MAINTENANCE OF NEW SEEDLINGS, AND RESEEDING SHALL BE IN ACCORDANCE WITH SPECIFICATIONS CONTAINED WITHIN THE VIRGINIA SOIL EROSION AND SEDIMENT CONTROL HANDBOOK, LATEST EDITION. ADDITIONAL SEEDING TO BE PERFORMED AS REQUIRED BY THE INSPECTOR.

SEED APPLICATION: APPLY SEED UNIFORMLY WITH A CYCLONE SEEDER, DRILL, CULTIPACKER SEEDER, OR HYDROSEEDER ON A FIRM, FRIABLE, SEEDBED. MAXIMUM SEEDING DEPTH SHALL BE 1/4 INCH.


TOTAL DISTURBED AREA = APPROXIMATELY 15+/- AC.

(PS) PERMANENT SEEDING MIXTURE


2 ACRES OR LESS OF DRAINAGE AREA:

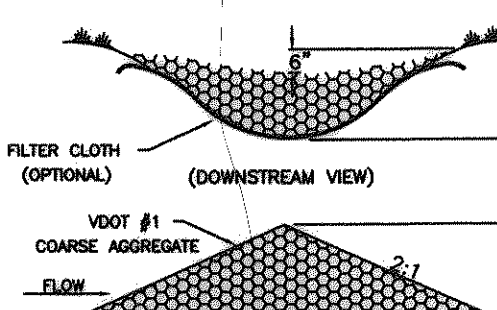


2-10 ACRES OF DRAINAGE AREA:

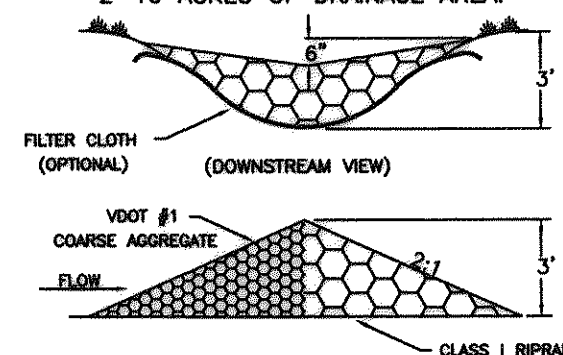

(CD) ROCK CHECK DAM

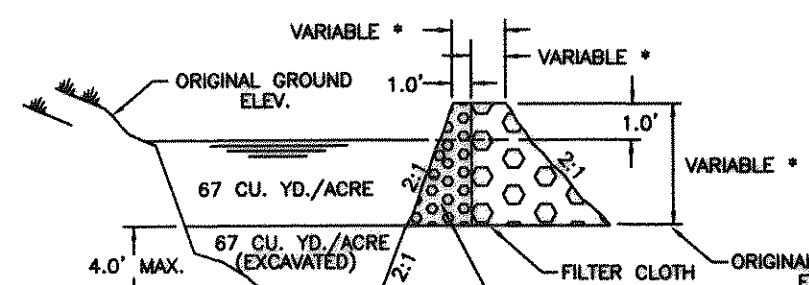


* SEE PLATE 3.13-1


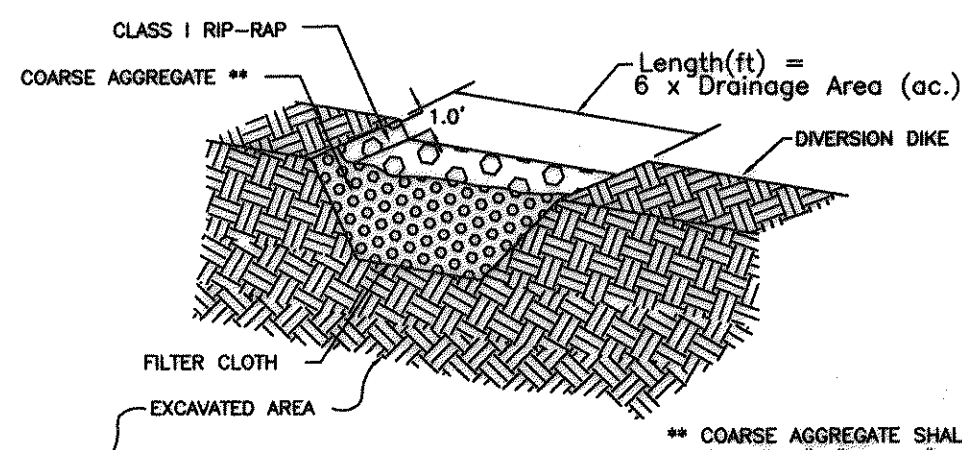


(ST) SEDIMENT TRAP

NOTES
For areas less than 3.0 acres. For areas larger than 3.0 acres, a SEDIMENT TRAP, is required. Please see VDOT #3.357 for design.

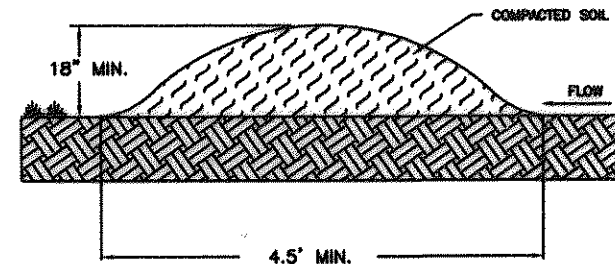


- (DD) TEMPORARY DIVERSION DIKE
- (FD) TEMPORARY FILL DIVERSION
- (RWG) TEMPORARY RIGHT-OF-WAY DIVERSION
- (DV) DIVERSION

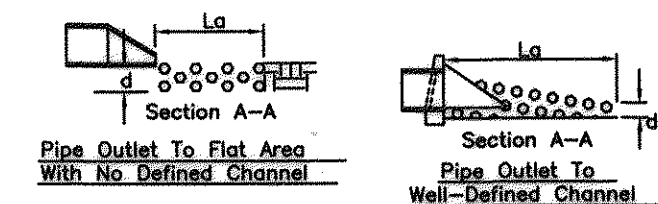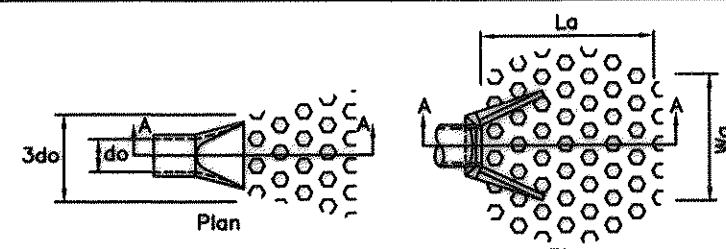


NOTES
1. Apron lining may be rip-rap, grouted rip-rap, or concrete.
2. Ld is the length of the rip-rap apron as calculated using plates 1.35d and 1.35e.
3. d = 1.5 times the maximum stone diameter, but not less than 6'.


(OP) OUTLET PROTECTION

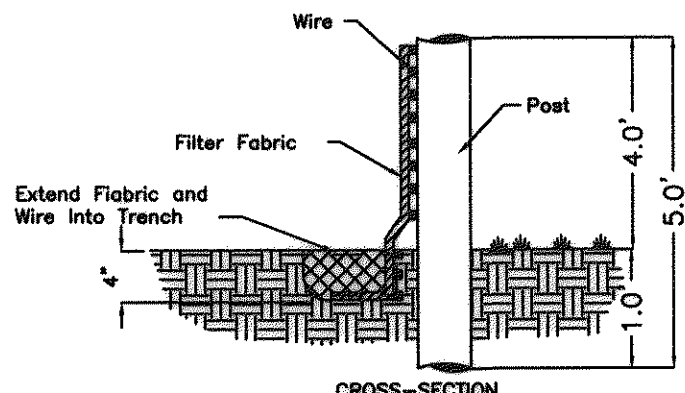



(SF) CONSTRUCTION OF A SILT FENCE

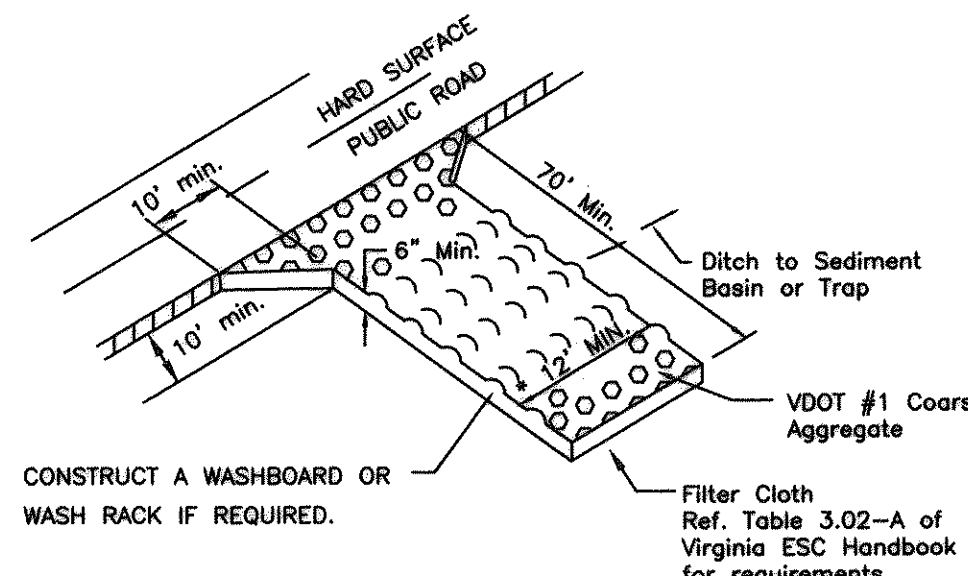

* MUST EXTEND FULL WIDTH OF INGRESS & EGRESS OPERATION.

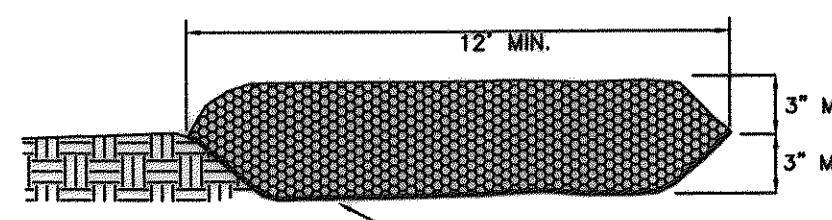


(CE) TEMPORARY GRAVEL CONSTRUCTION ENTRANCE

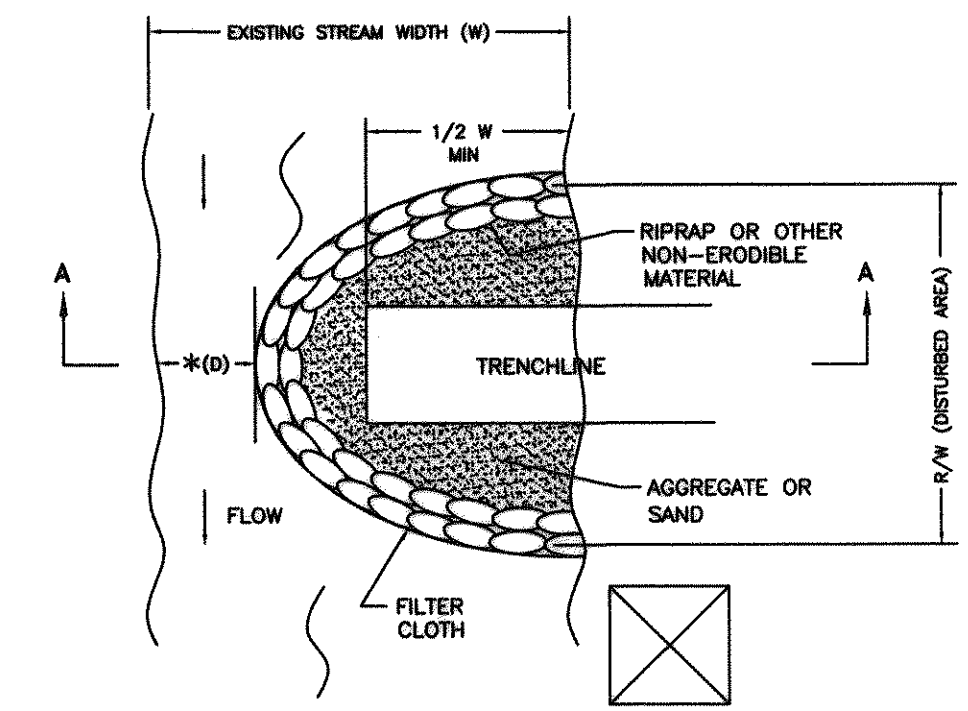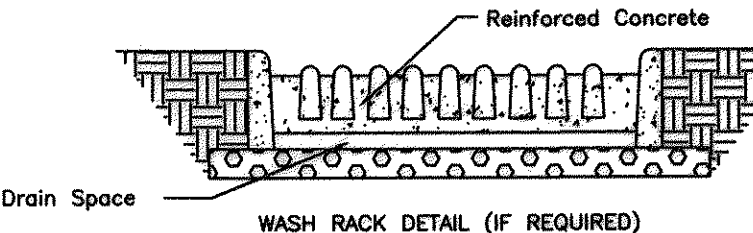


* (D) MINIMUM DISTANCE TO BE 25% OF TOTAL WIDTH (W) OF THE STREAM
DEWATERING DEVICE, SEE STD. & SPEC. 3.26

PLAN VIEW

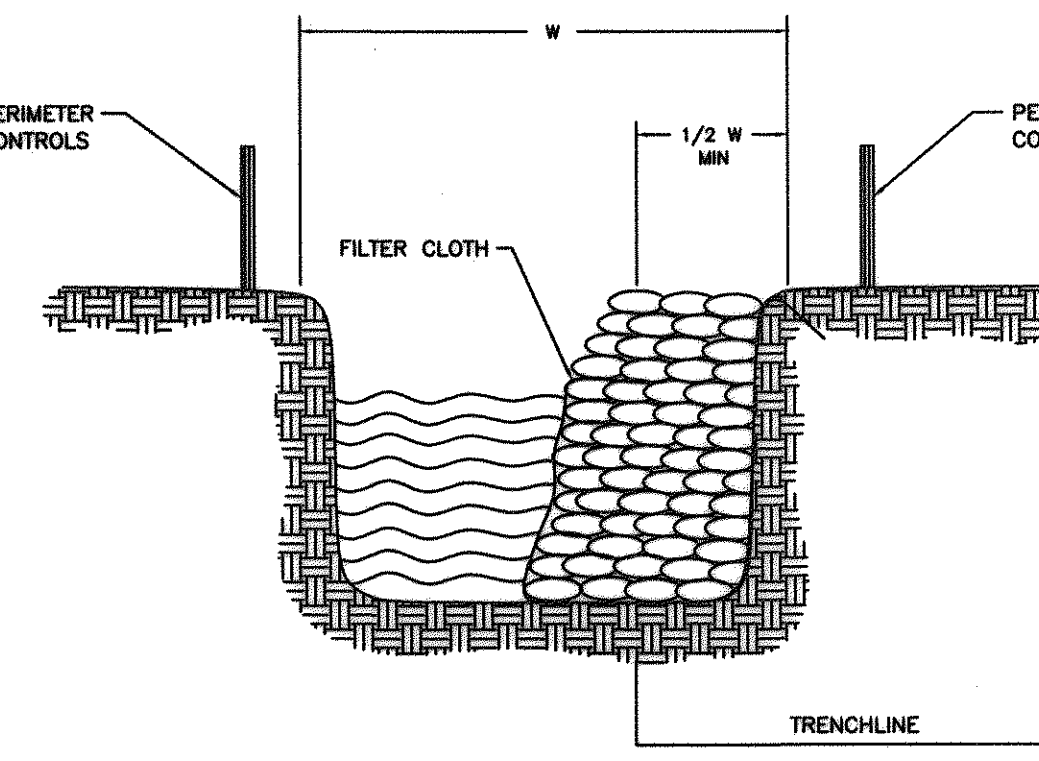

SECTION A-A


(UC) COFFERDAM CROSSING

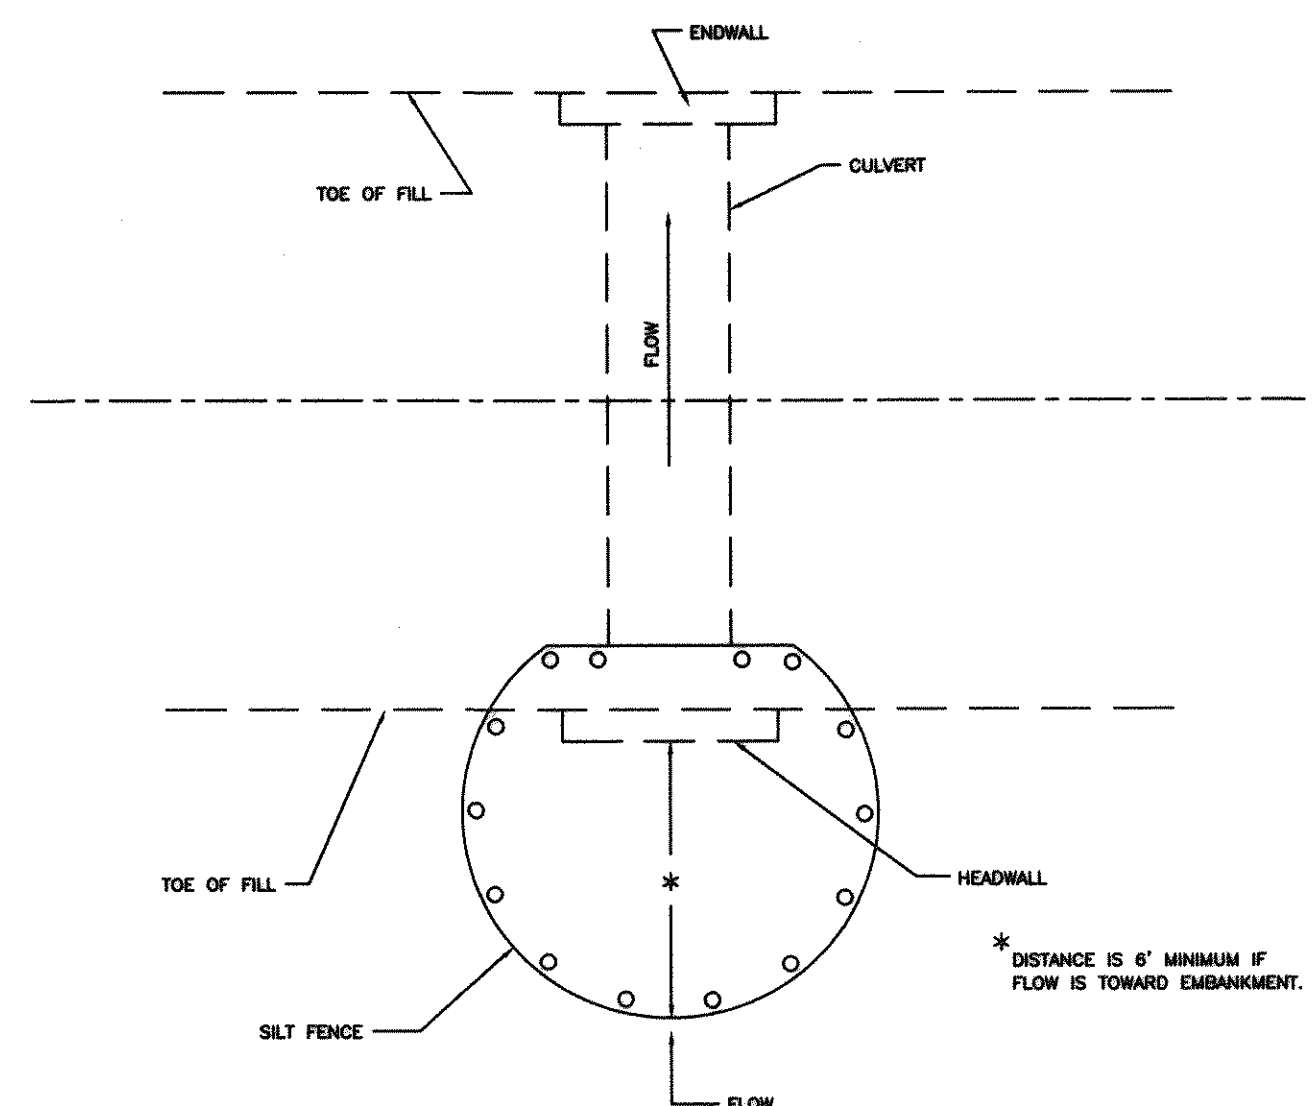


NOTES:
If silt fence culvert inlet protection is not sufficient due to expected high velocity of flow, contractor shall install optional stone and inlet sediment trap protection per STD. & SPEC. 3.08.

(CIP) SILT FENCE CULVERT INLET PROTECTION

SOURCE: 1992 VA. EROSION AND SEDIMENT CONTROL HANDBOOK, STD. & SPEC. 3.08

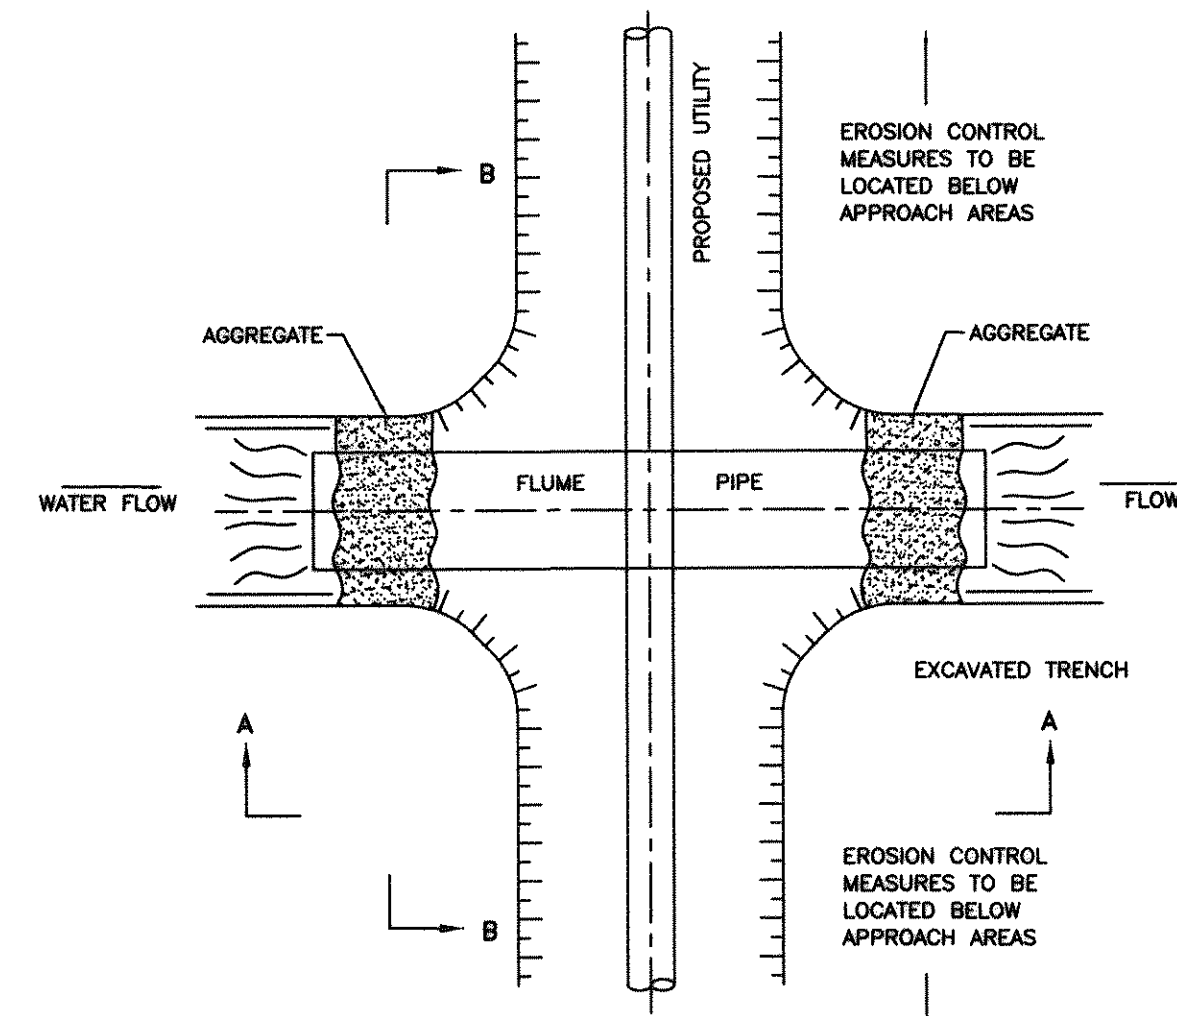

PLAN VIEW

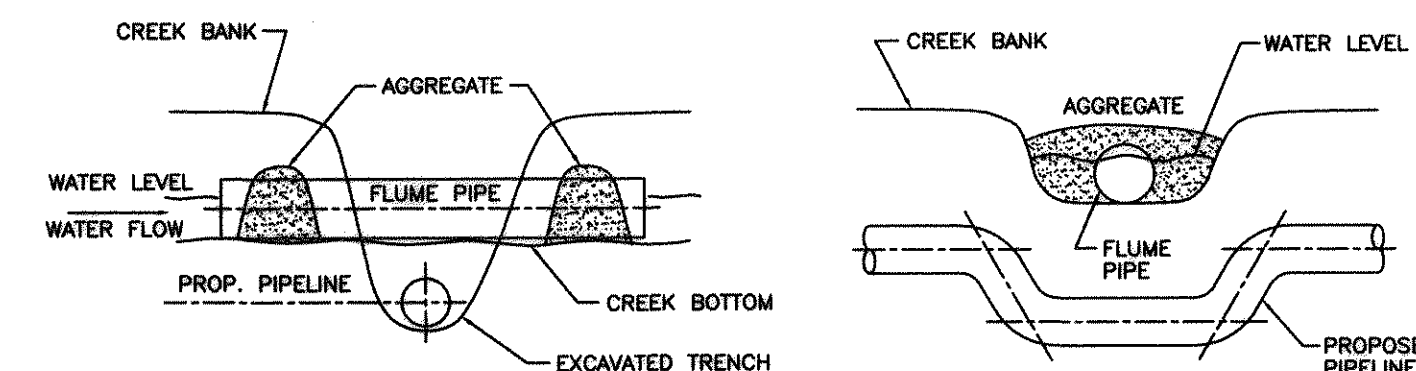

SECTION A-A

SECTION B-B

(USC) FLUME PIPE CROSSING

| NO. | TITLE | KEY | SYMBOL | NO. | TITLE | KEY | SYMBOL |
|------|--|-----|--------|------|---|-----|--------|
| 3.01 | SAFETY FENCE | SAF | | 3.20 | ROCK CHECK DAMS | CD | |
| 3.02 | TEMPORARY GRAVEL CONSTRUCTION ENTRANCE | CE | | 3.21 | LEVEL SPREADER | LS | |
| 3.03 | CONSTRUCTION ROAD STABILIZATION | CRS | | 3.22 | VEGETATIVE STREAMBANK STABILIZATION | VSS | |
| 3.04 | STRAW BALE BARRIER | STB | | 3.23 | STRUCTURAL STREAMBANK STABILIZATION | SSS | |
| 3.05 | SILT FENCE | SF | | 3.24 | TEMPORARY VEHICULAR STREAM CROSSING | VSC | |
| 3.06 | BRUSH BARRIER | BB | | 3.25 | UTILITY STREAM CROSSING | USC | |
| 3.07 | STORM DRAIN INLET PROTECTION | IP | | 3.26 | DEWATERING STRUCTURE | DS | |
| 3.08 | CULVERT INLET PROTECTION | CIP | | 3.27 | TURBIDITY CURTAIN | TC | |
| 3.09 | TEMPORARY DIVERSION DIKE | DD | | 3.28 | SUBSURFACE DRAIN | SD | |
| 3.10 | TEMPORARY FILL DIVERSION | FD | | 3.29 | SURFACE ROUGHENING | SR | |
| 3.11 | TEMPORARY RIGHT-OF-WAY DIVERSION | RWD | | 3.30 | TOPSOILING | TO | |
| 3.12 | DIVERSION | DV | | 3.31 | TEMPORARY SEEDING | TS | |
| 3.13 | TEMPORARY SEDIMENT TRAP | ST | | 3.32 | PERMANENT SEEDING | PS | |
| 3.14 | TEMPORARY SEDIMENT BASIN | SB | | 3.33 | SODDING | SO | |
| 3.15 | TEMPORARY SLOPE DRAIN | TSD | | 3.34 | BERMUDA GRASS AND ZOYSIAURASS ESTABLISHMENT | BW | |
| 3.16 | PAVED FLUME | PF | | 3.35 | MULCHING | MU | |
| 3.17 | STORMWATER CONVEYANCE CHANNEL | SCC | | 3.36 | SOIL STABILIZATION BLANKETS AND MATTING | BSM | |
| 3.18 | OUTLET PROTECTION | OP | | 3.37 | TREES, SHRUBS, VINES AND GROUND COVERS | VEG | |
| 3.19 | RIPRAP | RR | | 3.38 | TREE PRESERVATION AND PROTECTION | TP | |
| | | | | 3.39 | DUST CONTROL | DC | |


CRITICAL EROSION AREAS

Drawn JHG
Designed SCG
Checked WPJ
Approved JST

GREENFIELD PARKWAY PHASE 1

EROSION & SEDIMENT CONTROL DETAILS

SCALE: NONE
NOVEMBER 12, 1997
PROJECT: 97042
5 of 34

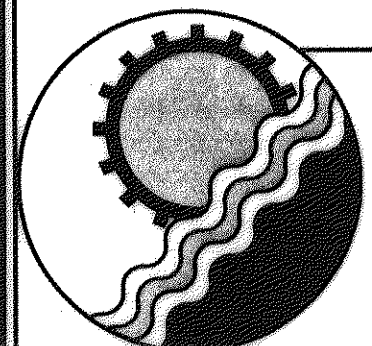

ENGINEERING CONCEPTS, INC.

20 S. ROANOKE ST., PO BOX 619
FINCASTLE, VIRGINIA 24090
540.473.1253 FAX: 540.473.1254

AS-BUILT