
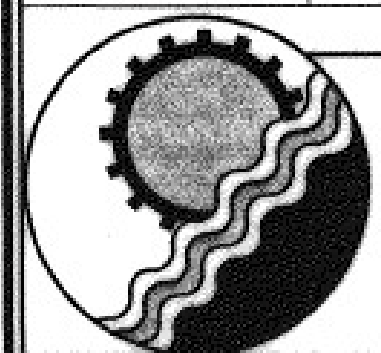
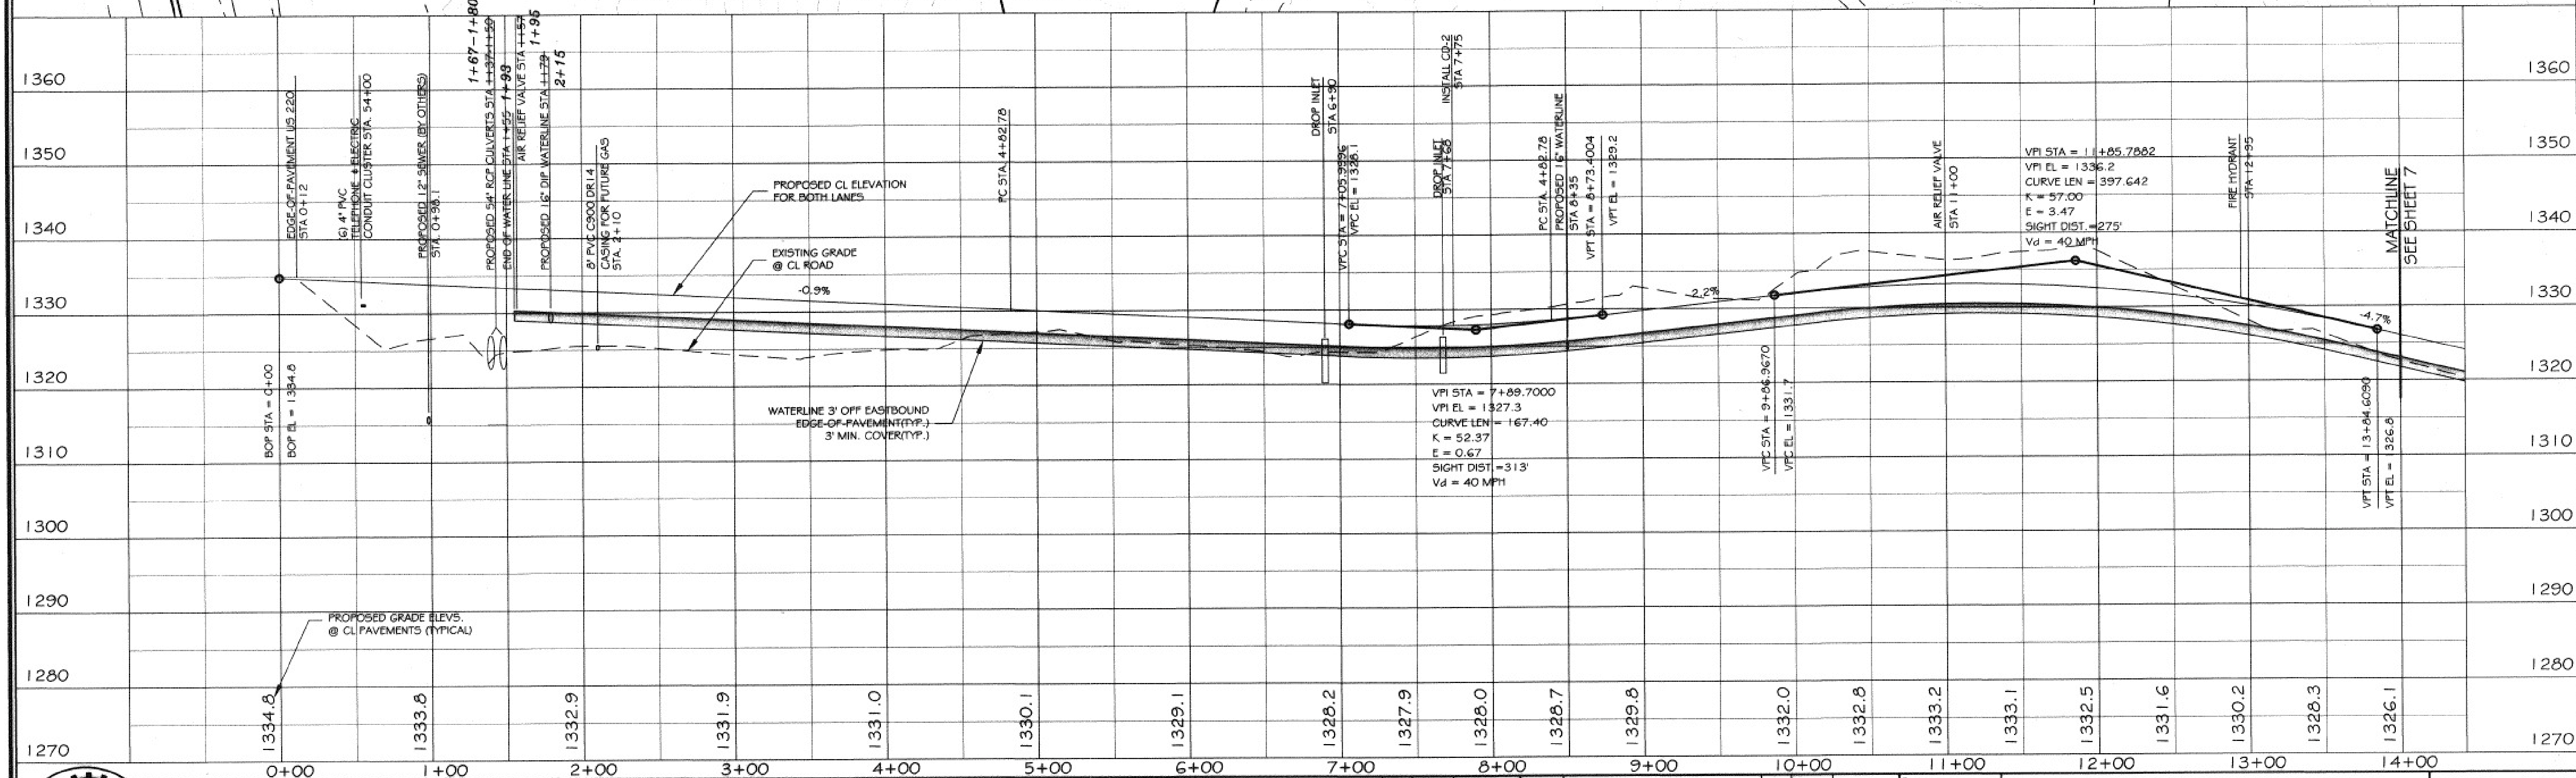


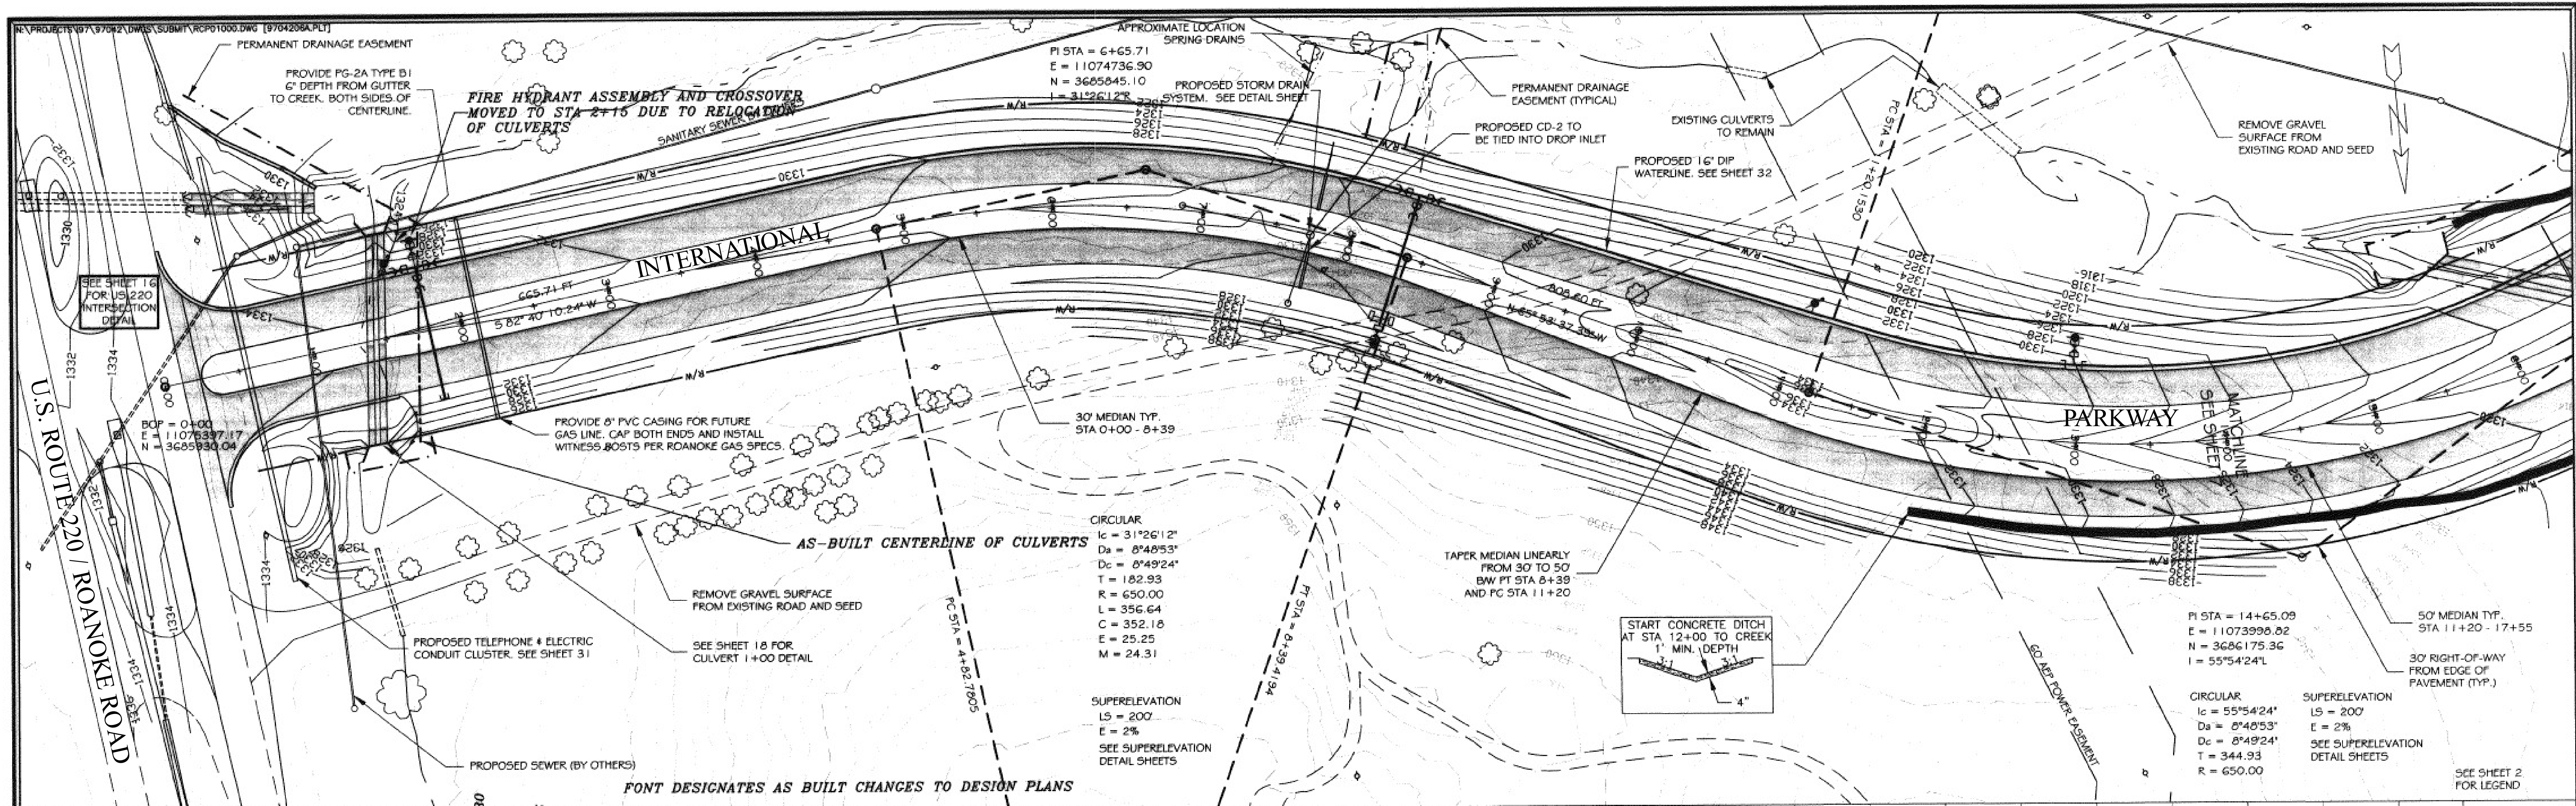

ENGINEERING CONCEPTS, INC.

20 S. ROANOKE ST., PO BOX 619
FINCASTLE, VIRGINIA 24090
540.473.1253 FAX: 540.473.1254

AS-BUILT

No.	Revision	By	Appd.	Date	No.	Revision	By	Appd.	Date	Drawn	Checkd.
					01	ADD R.O.W. & EASEMENTS	RHW	JST	02/13/98		RHW
					02	ADD SIGHT DISTANCES	RHW	JST	04/16/98	Designed	RHW
					03	LENGTHEN VERT. CURVE 11+85	RHW	JST	05/01/98	Checked	WPJ
					04	ADD DESIGN SPEED	RHW	JST	05/01/98	Approved	
					05	ADD UNDERDRAINS	RHW	JST	06/10/98		JST

**GREENFIELD PARKWAY
PHASE 1**

PLAN & PROFILES
STA. 0+00 - 14+00

H: 1"=50' V: 1"=10'

NOVEMBER 12, 1997

PROJECT: 97042

6 of 34