


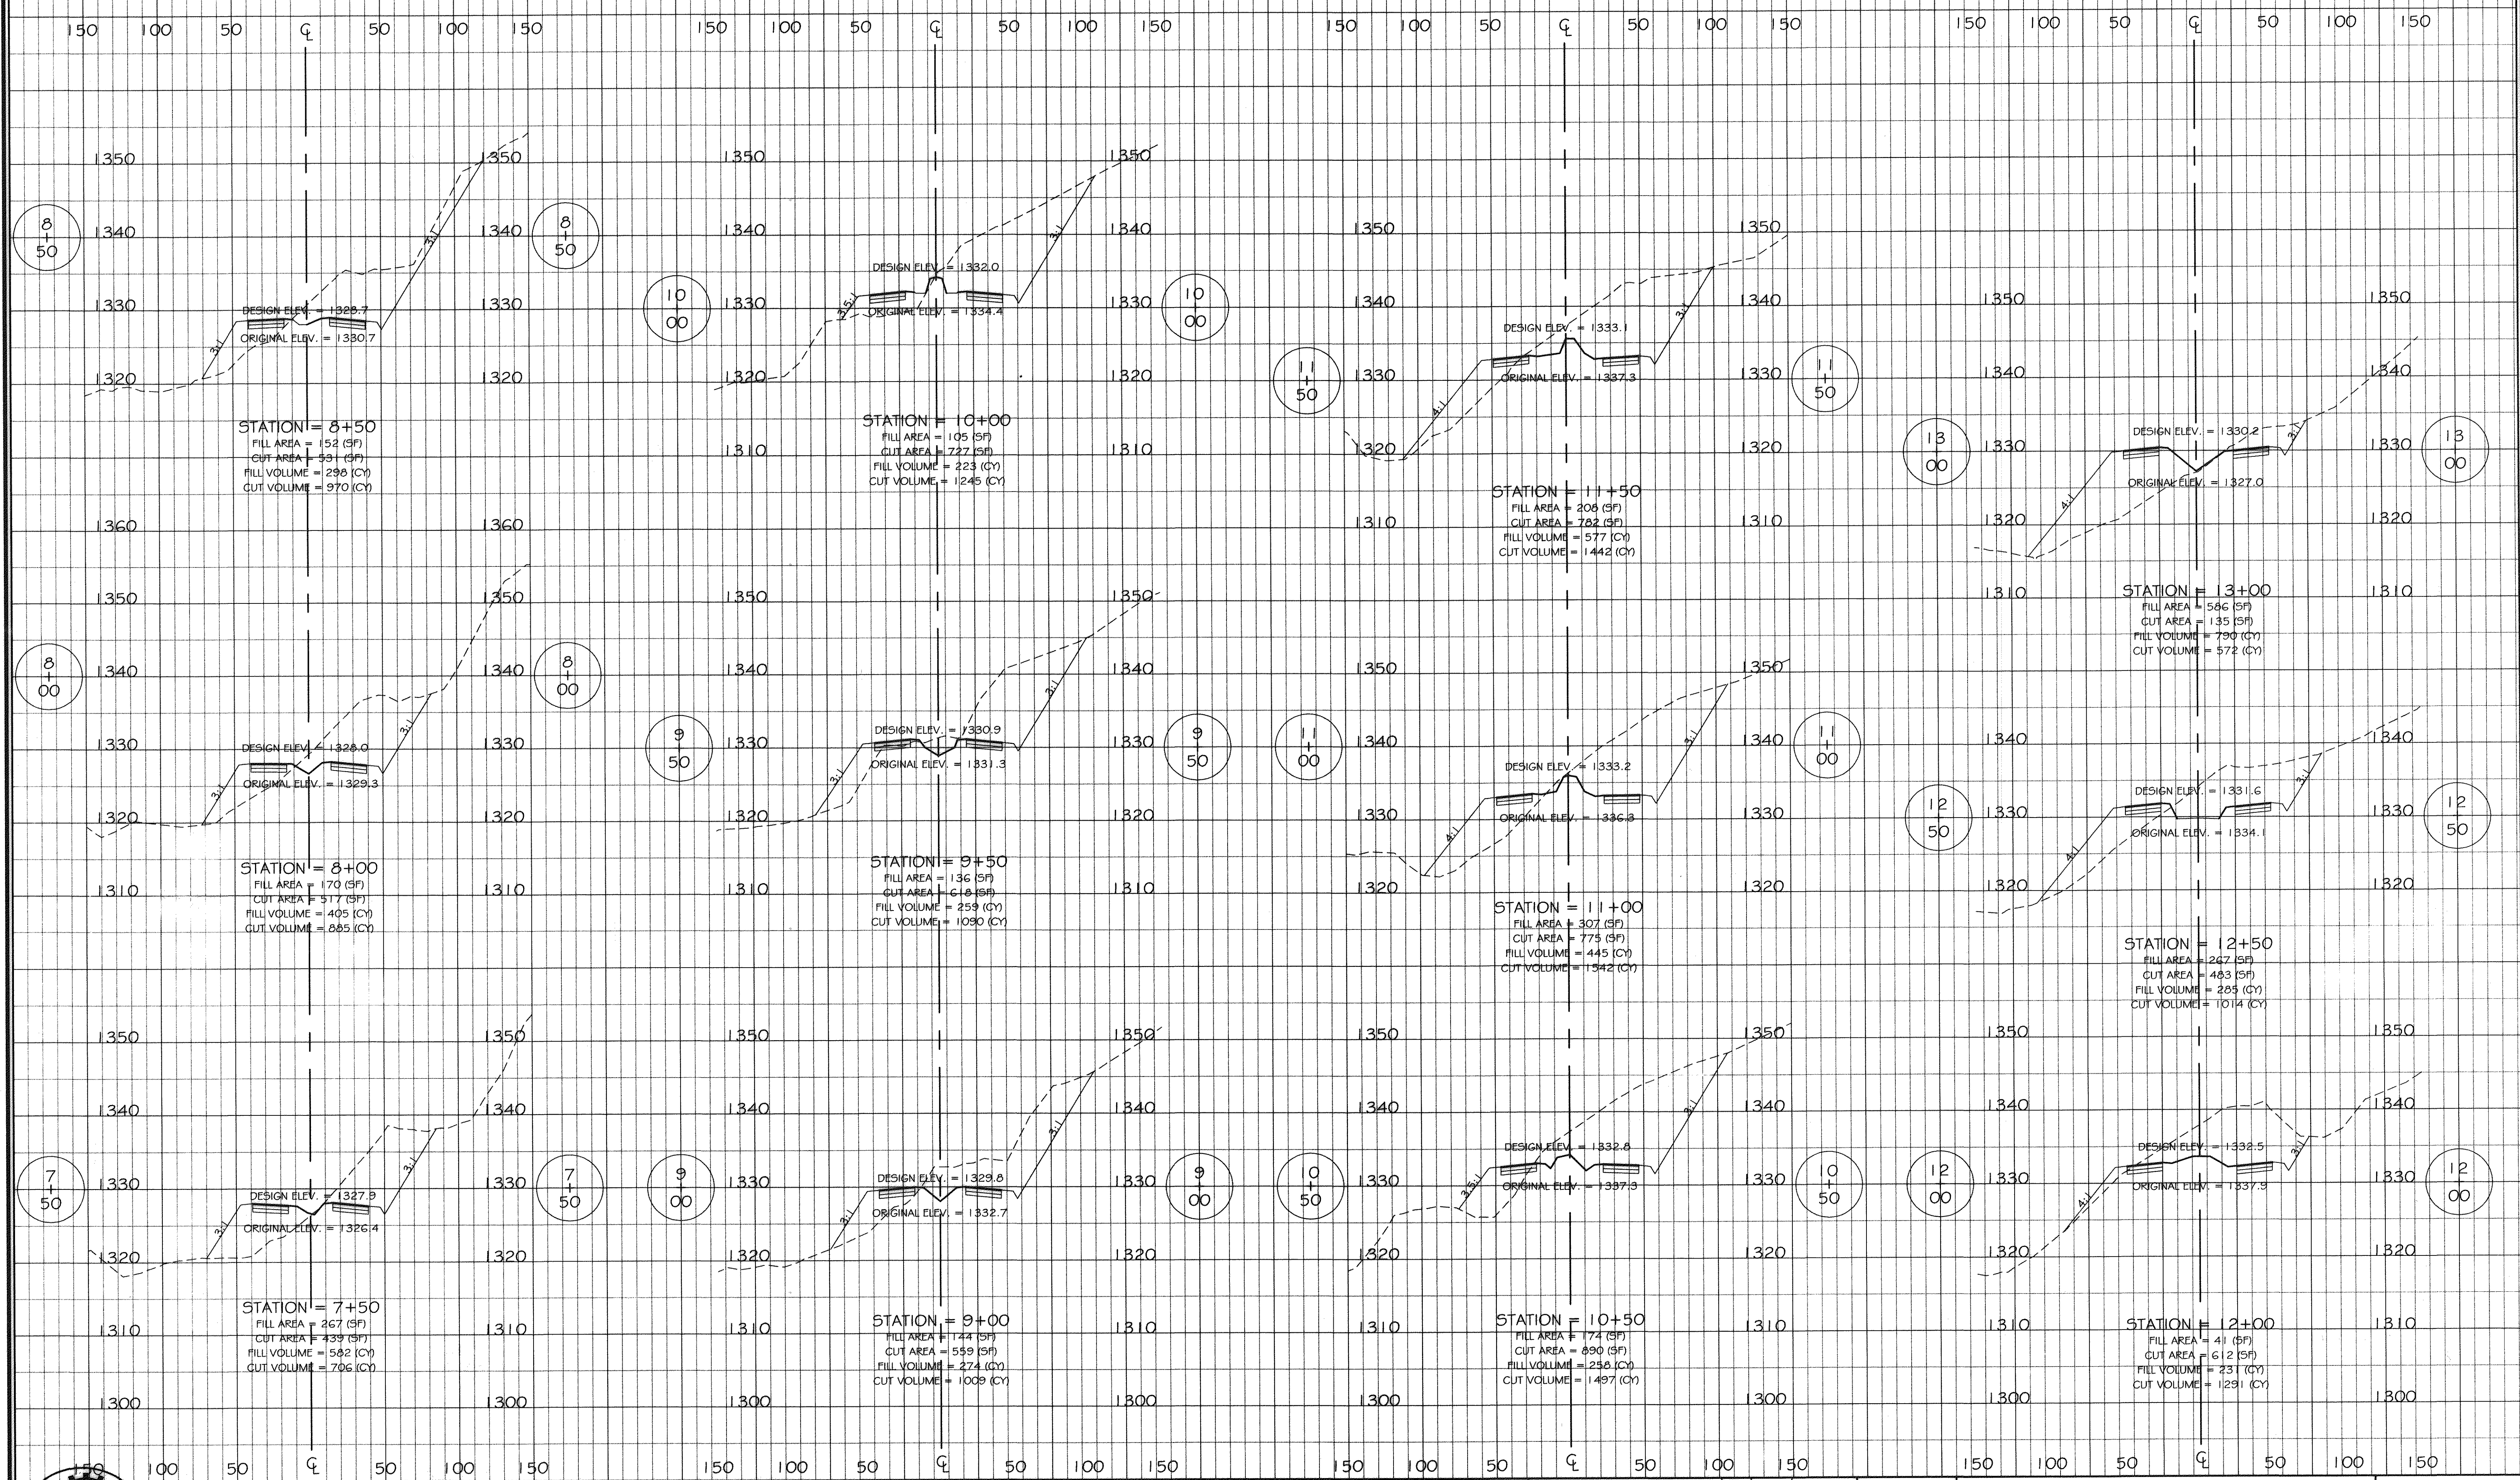

AS-BUILT

No.	Revision	By	Appd.	Date	Drawn
01	ADD 2" 21B BASE	RHW	JST	02/20/98	RHW
02	LOWER STA'S 10+50-13+00	RHW	JST	05/01/98	RHW
					Checked WPJ
					Approved JST

**BOTETOURT CENTER
 AT GREENFIELD**
**CROSS - SECTIONS
 STA 7+50 - 13+00**