



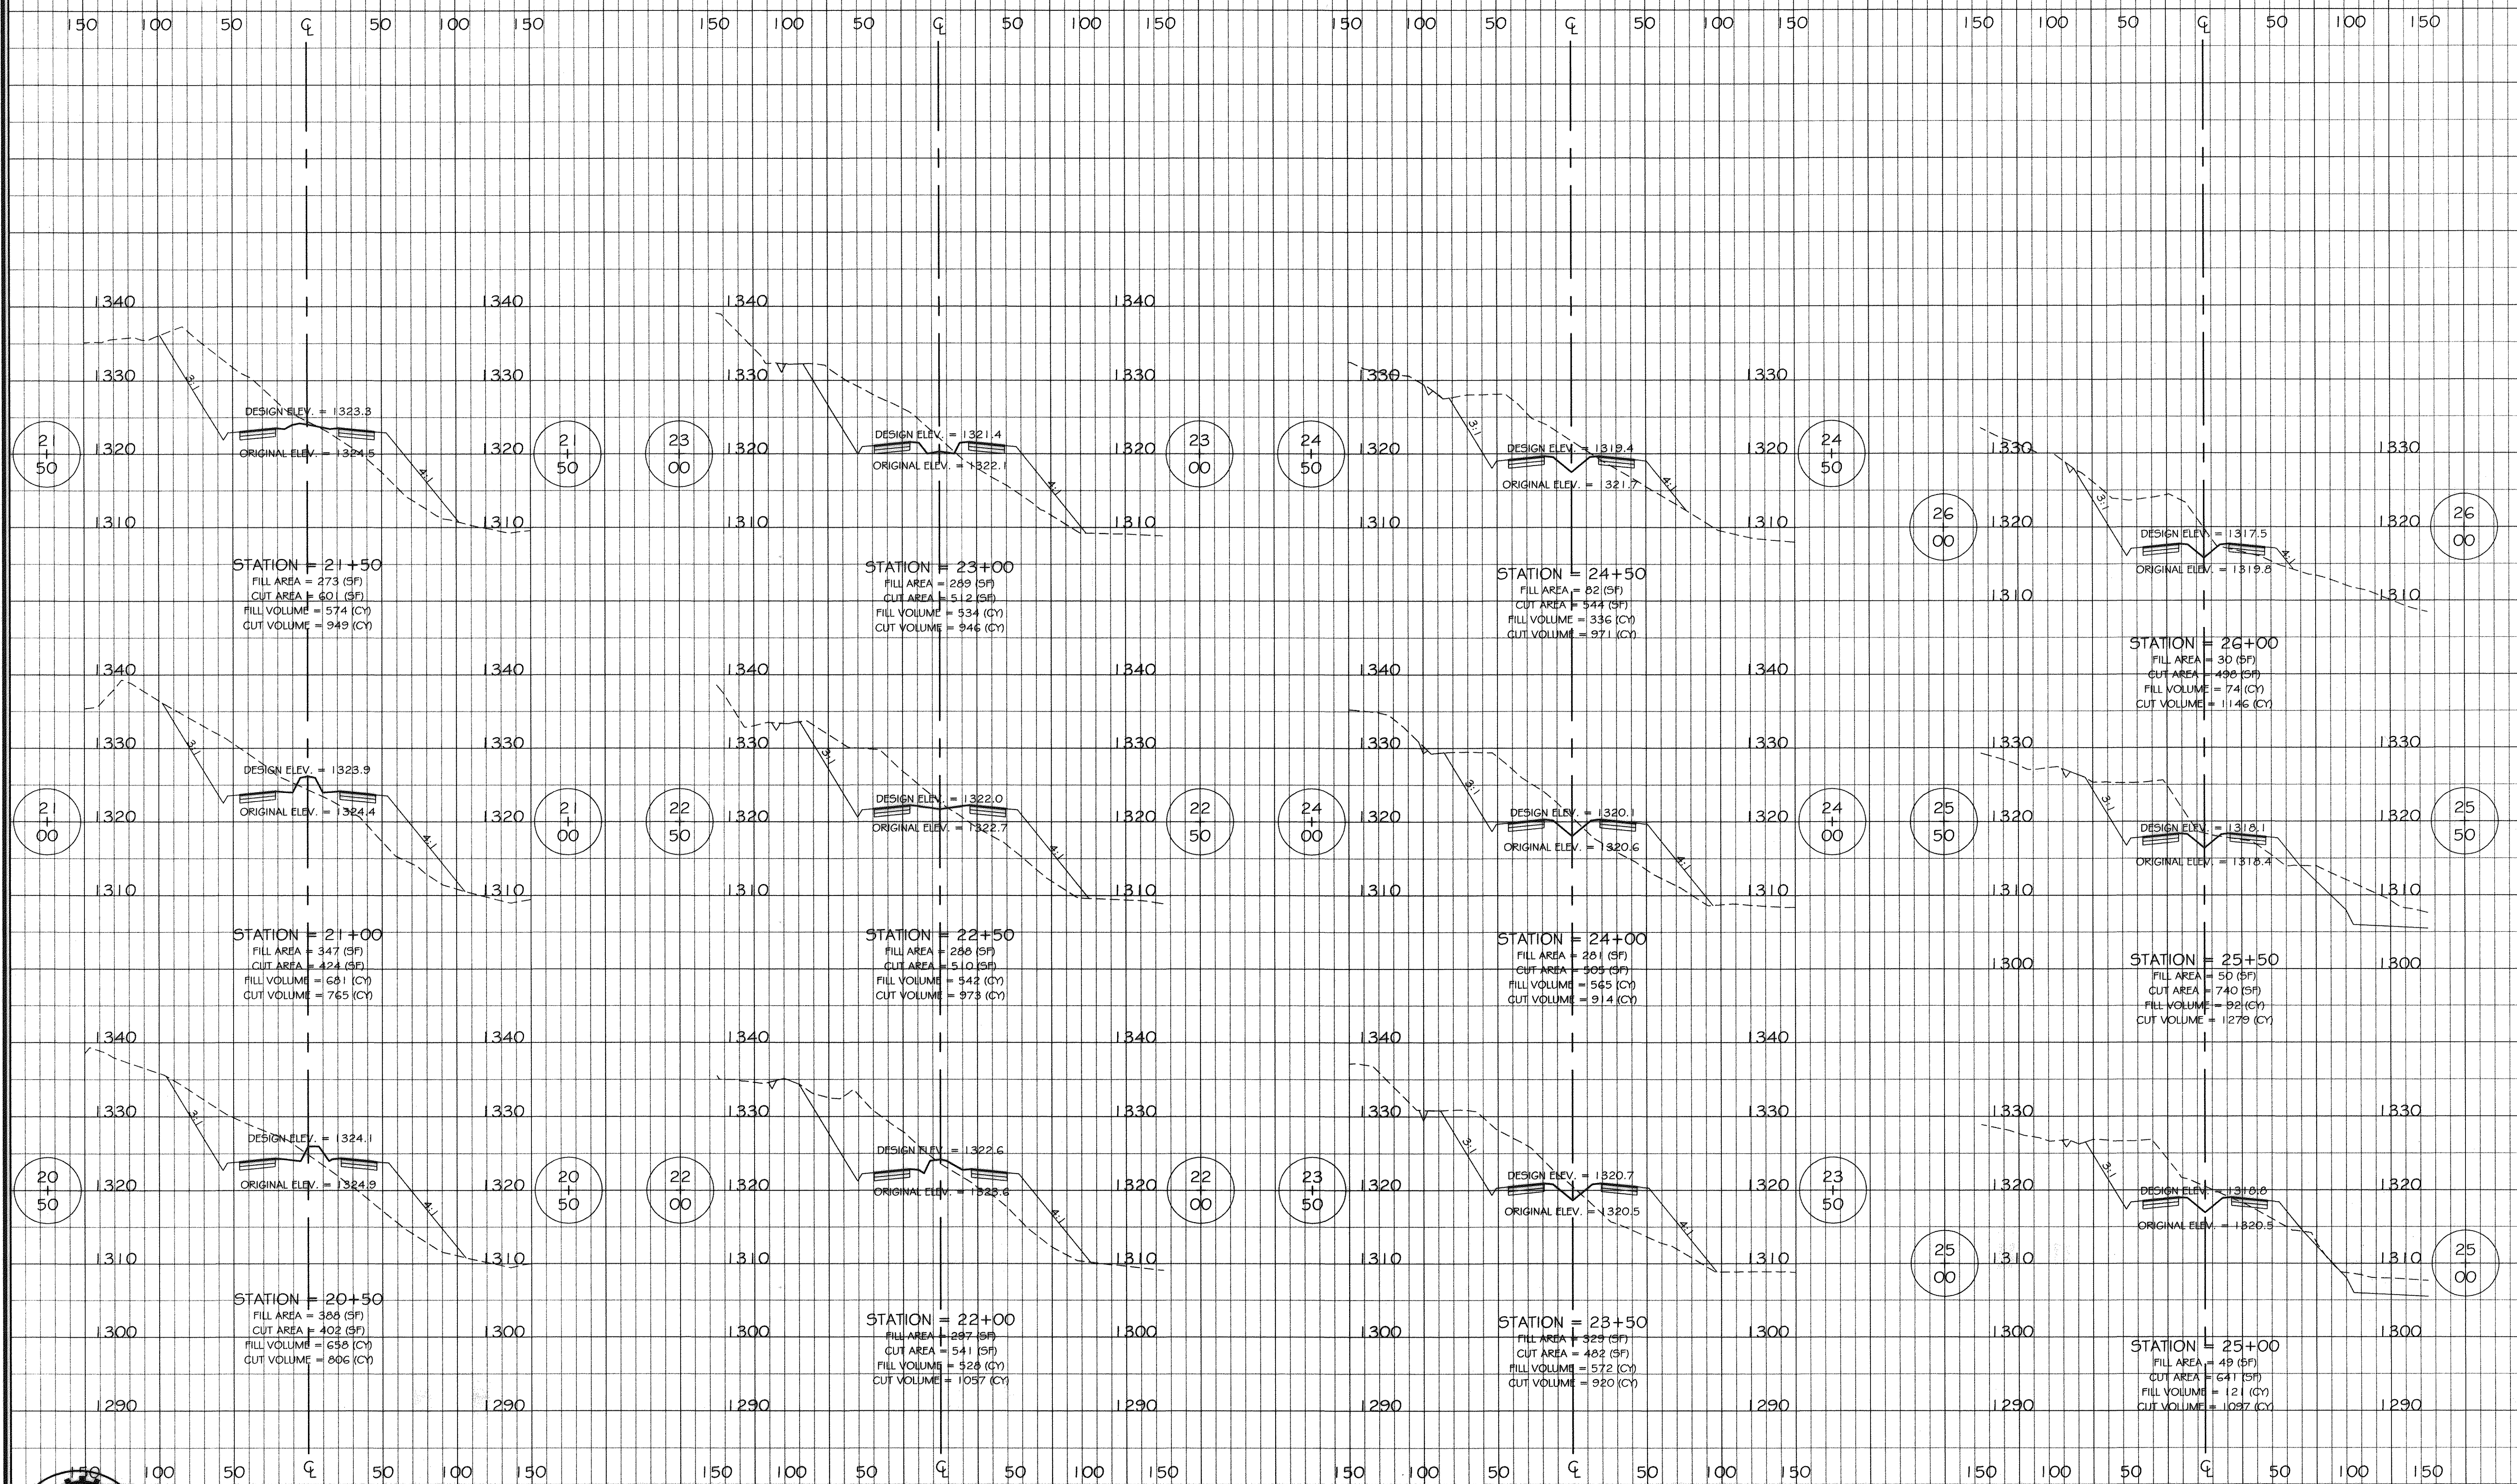

AS-BUILT

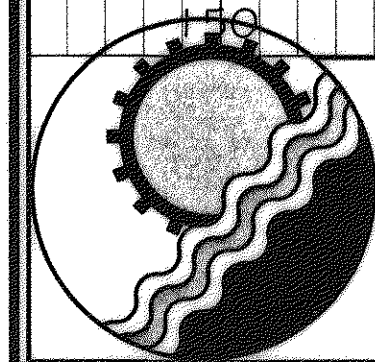

ENGINEERING CONCEPTS, INC.

20 S. ROANOKE ST., PO BOX 619
FINCASTLE, VIRGINIA 24090
540.473.1253 FAX: 540.473.1254

No.	Revision	By	Appd.	Date	Drawn	RHW
01	ADD 2" 21B BASE	RHW	JST	02/20/98	Designed	RHW
					Checked	WPJ
					Approved	JST

**BOTETOURT CENTER
AT GREENFIELD**

**CROSS - SECTIONS
STA 20+50 - 26+00**

H: 1"=50' V: 1"=10'

NOVEMBER 12, 1997

PROJECT: 97042

12 of 34