



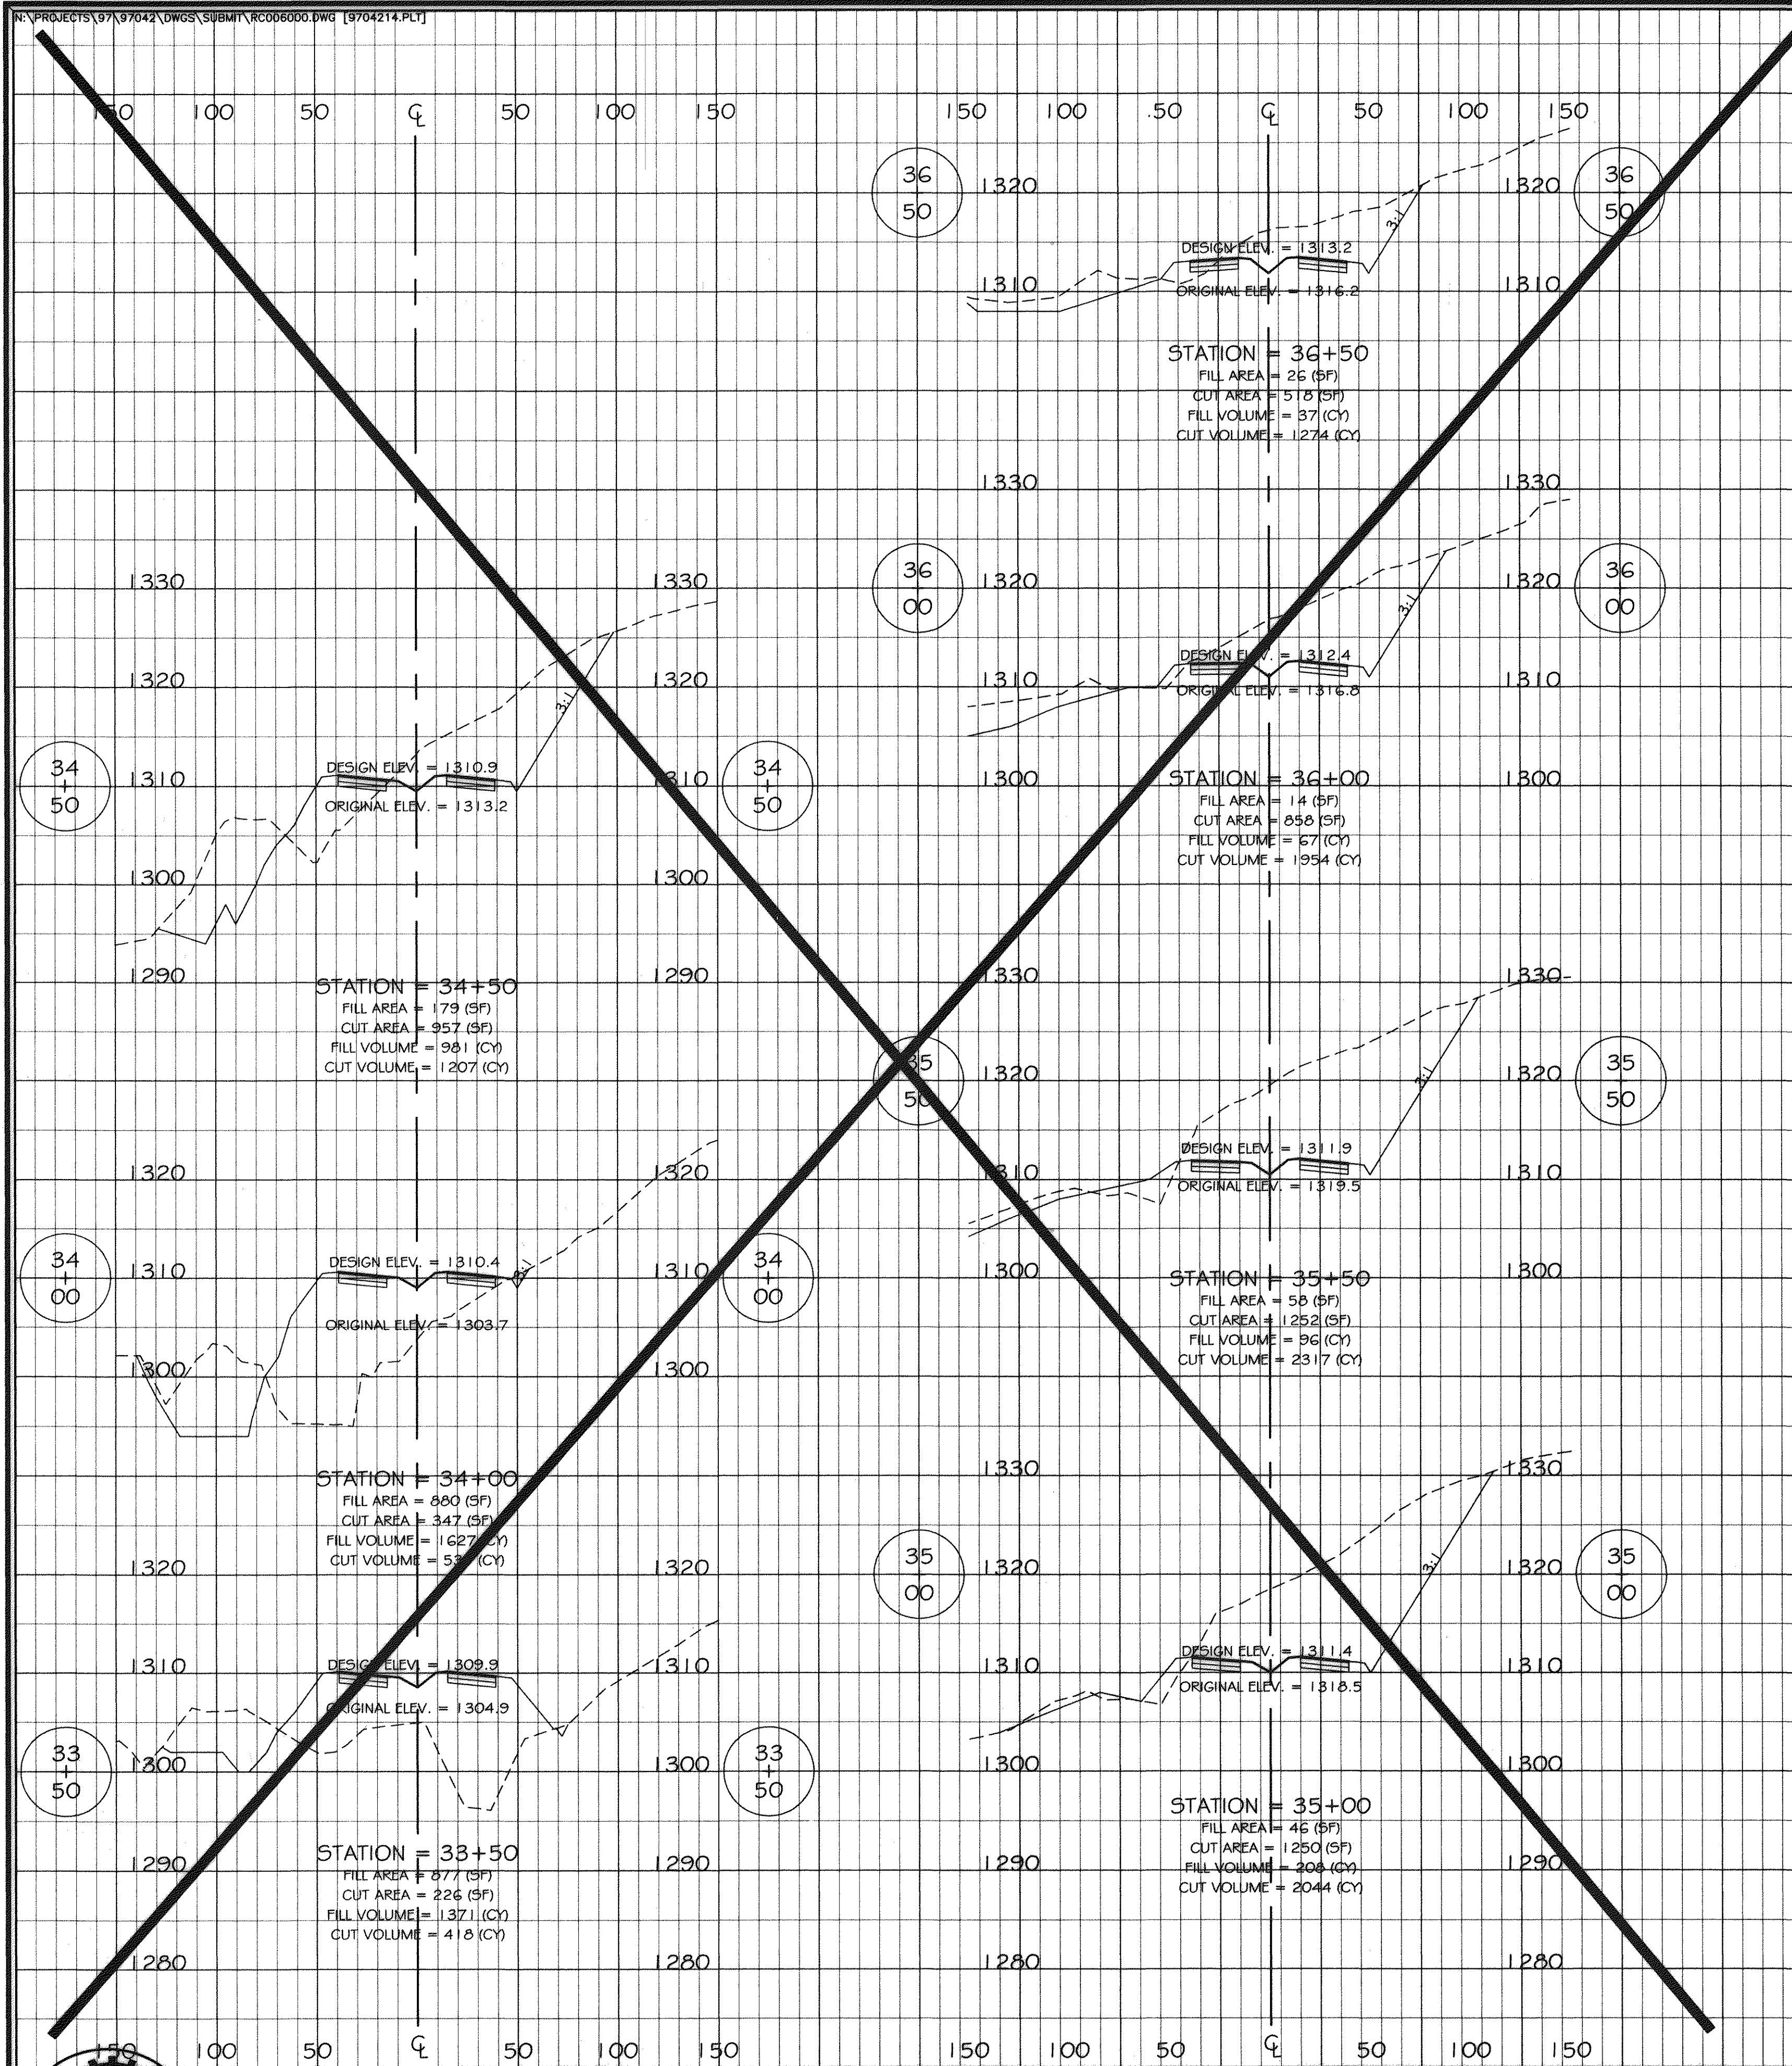

NOT CONSTRUCTED

FONT DESIGNATES AS BUILT CHANGES TO DESIGN PLANS

AS-BUILT

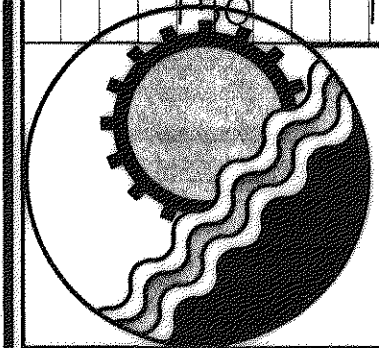

ENGINEERING CONCEPTS, INC.

20 S. ROANOKE ST., PO BOX 619
 FINCASTLE, VIRGINIA 24090
 540.473.1253 FAX: 540.473.1254

No.	Revision	By	Appd.	Date	Drawn
01	ADD 2" 21B BASE	RHW	JST	02/20/98	RHW
					Designed
					Checked
					Approved

**BOTETOURT CENTER
 AT GREENFIELD**

**CROSS - SECTIONS
 STA 33+50 - 36+50**

H: 1"=50' V: 1"=10'

NOVEMBER 12, 1997

PROJECT: 97042

14 of 34