


EXTEND 21-B BASE MINIMUM OF 1 FOOT BEYOND ASPHALT (TYPICAL)

ONE FOOT EXTENSION OF PAVEMENT TO BE TRANSITIONED BACK TO NORMAL WIDTH OVER 20'

MEDIAN TO BE VDOT MS-2.

SHOULDER SLOPE NOTE:  
SITE GRADING BASED ON 2% SLOPE.  
HOWEVER CONTRACTOR SHALL ADJUST SHOULDER SLOPES TO 5/8" PER FOOT.

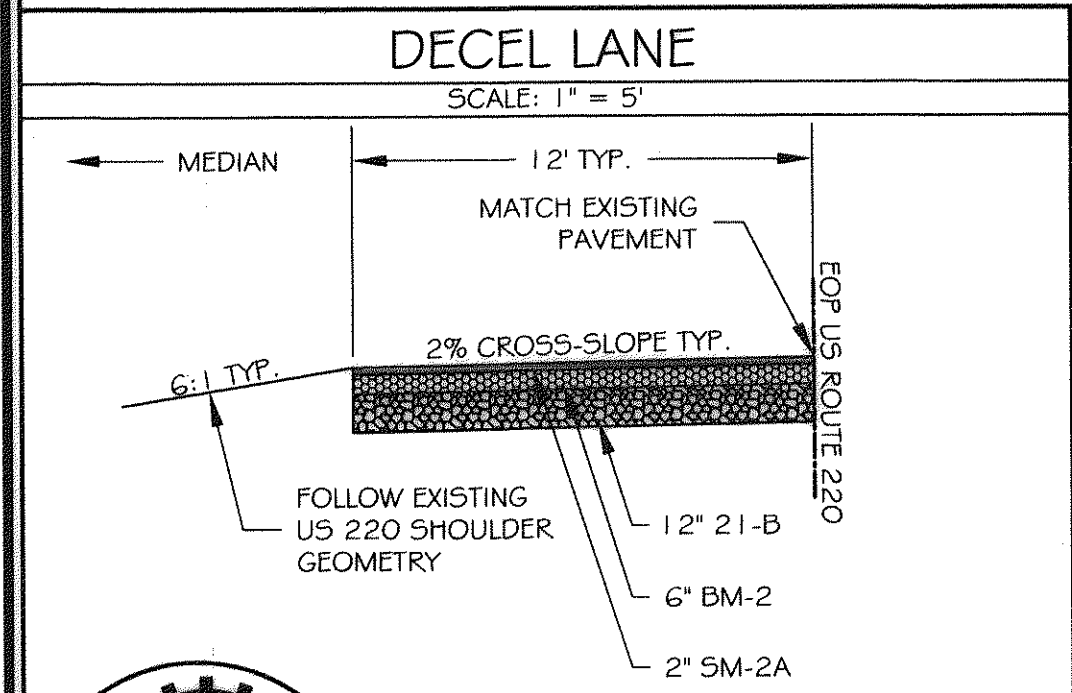

**ENGINEERING CONCEPTS, INC.**  
20 S. ROANOKE ST., PO BOX 619  
FINCASTLE, VIRGINIA 24090  
540.473.1253 FAX: 540.473.1254

AS-BUILT

No.	Revision	By	Appd.	Date	Drawn	Checked	Approved
01	ADD 2" TO 21-B BASE	RHW	JST	02/20/98	Designed	RHW	
02	ADD 21-B UNDER CG-6	RHW	JST	04/16/98	Designed	WPJ	
03	VDOT MS-2 MEDIAN	RHW	JST	04/16/98	Checked	WPJ	
04	EXTEND 21-B 1' BEYOND CURB	RHW	JST	04/29/98	Checked	WPJ	
05	CHANGE SHOULDER SLOPE	RHW	JST	04/29/98	Approved	JST	

**GREENFIELD PARKWAY  
PHASE 1  
TYPICAL  
CROSS-SECTION**

1" = 2'  
NOVEMBER 12, 1997  
PROJECT: 97042  
15 of 34