


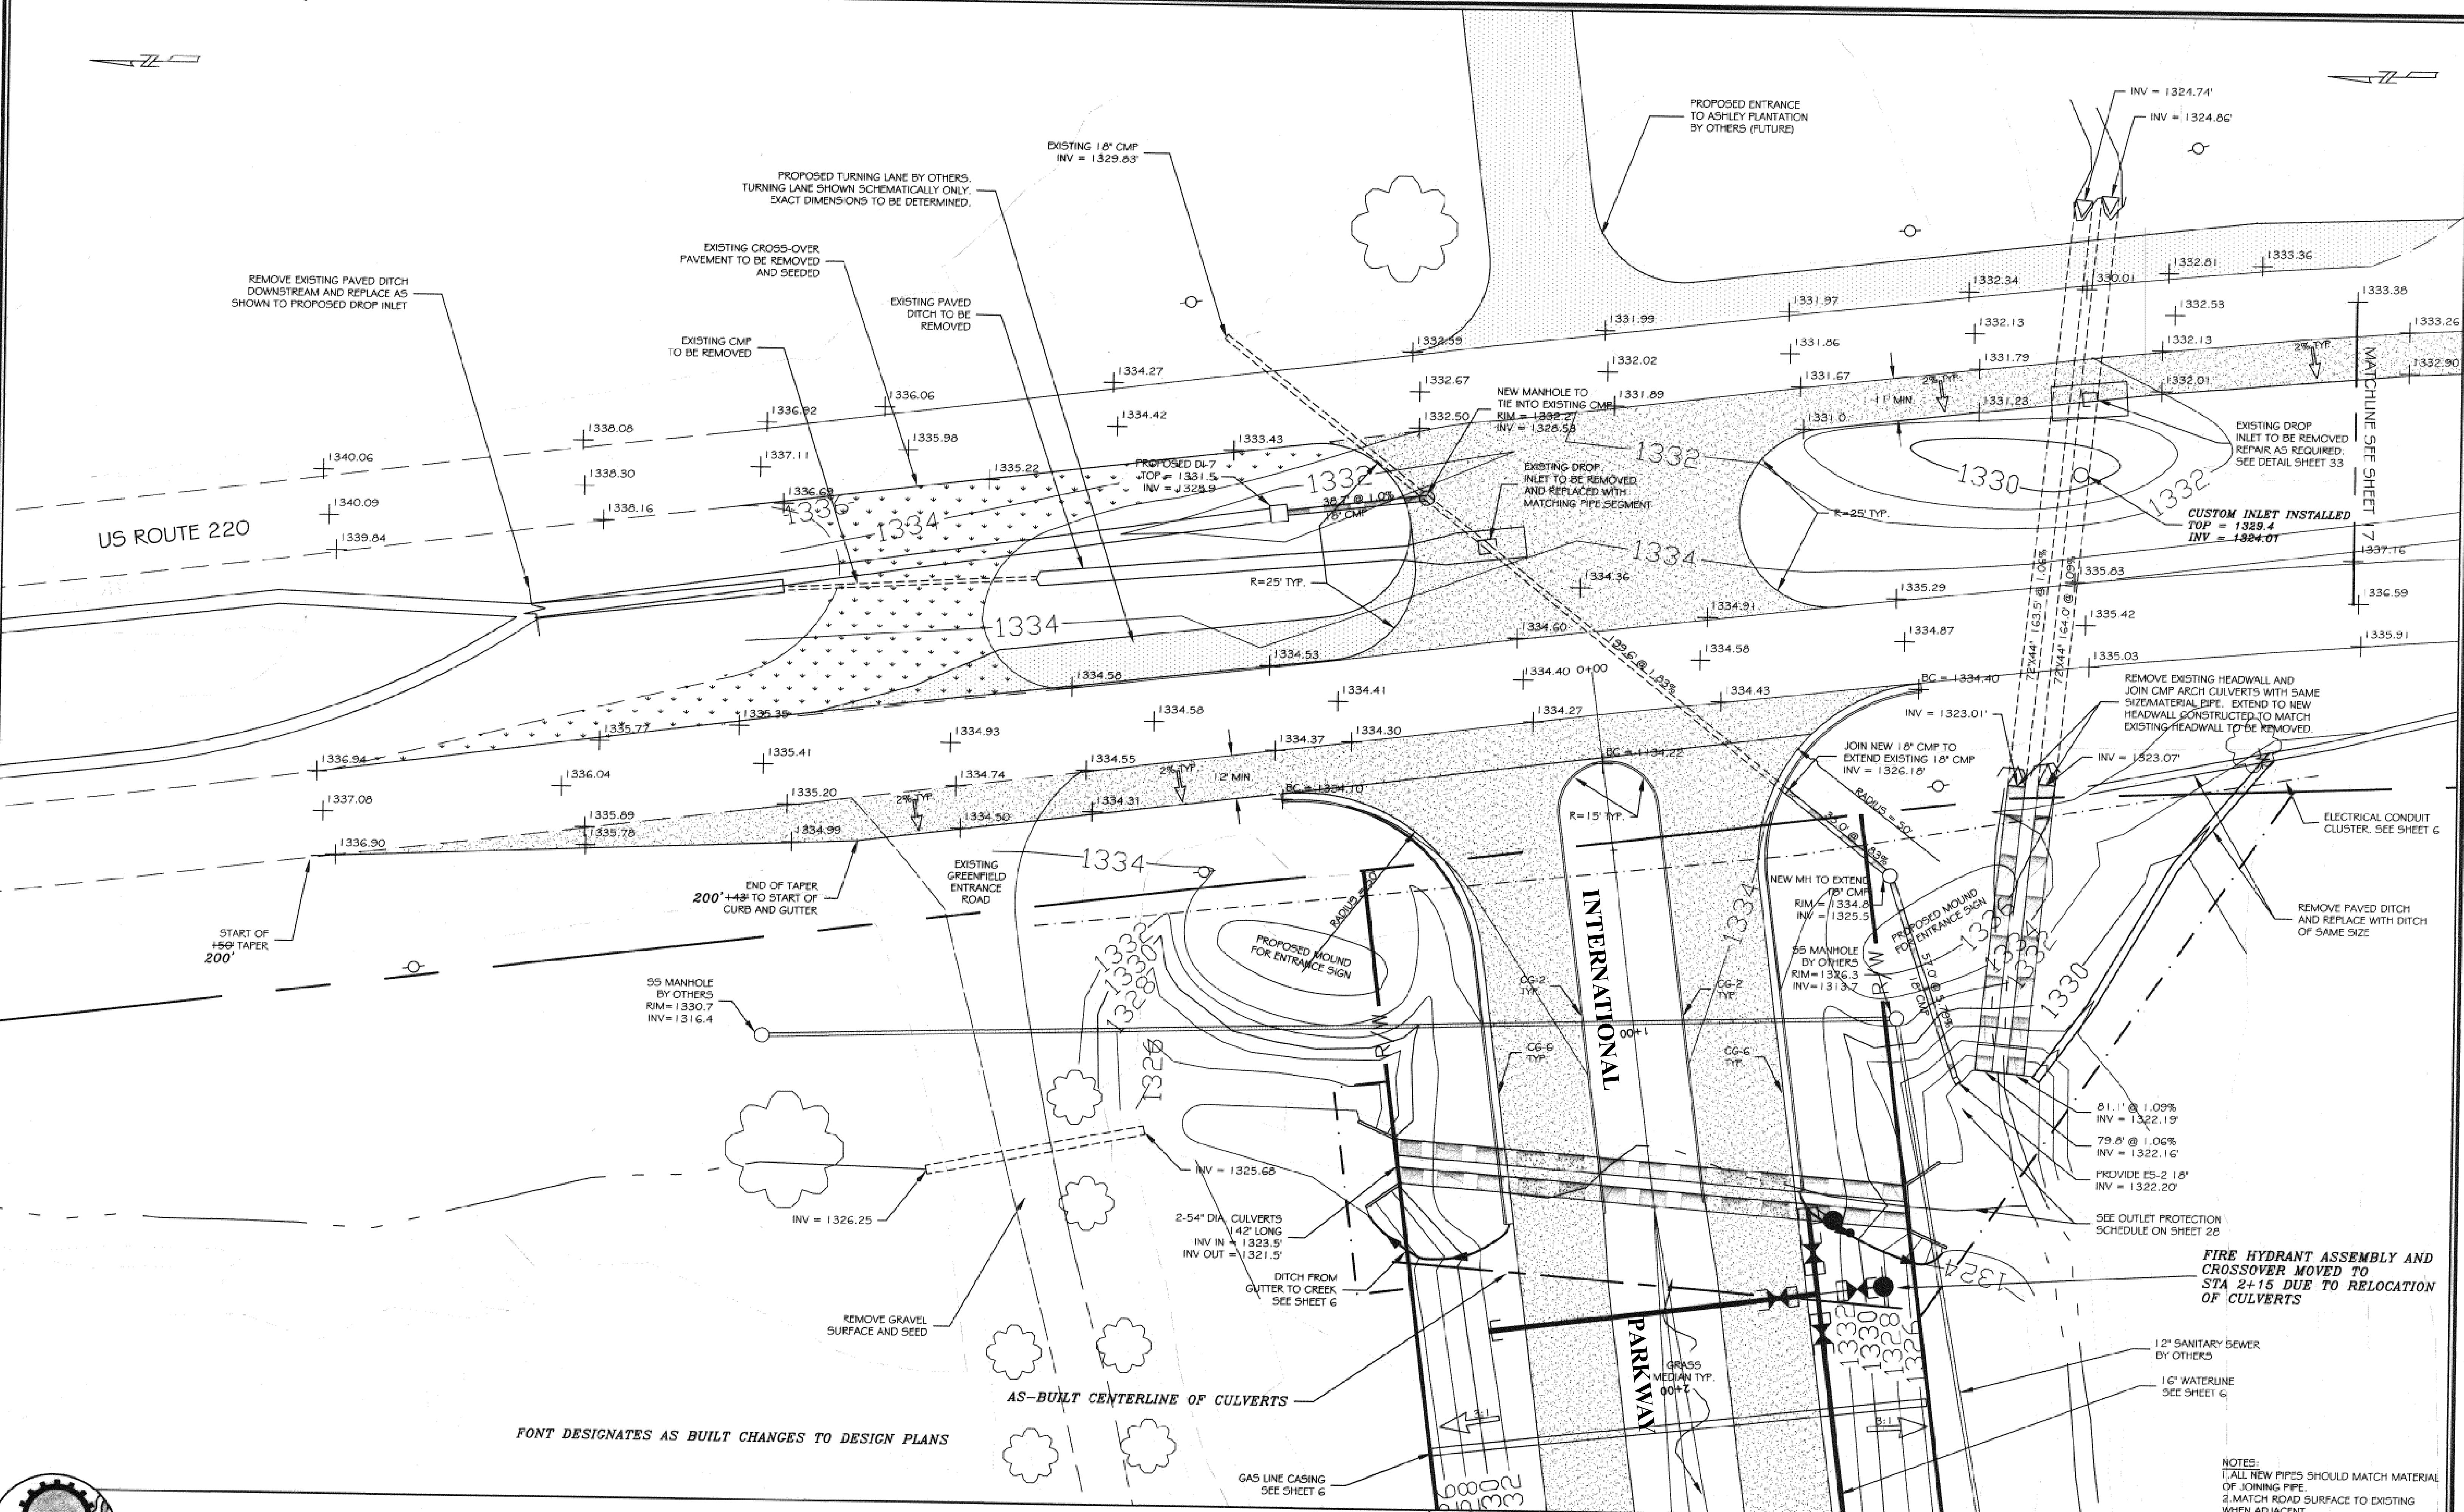

ENGINEERING CONCEPTS, INC.
20 S. ROANOKE ST., PO BOX 619
FINCASTLE, VIRGINIA 24090
540.473.1253 FAX: 540.473.1254

AS-BUILT

No.	Revision	By	Appd.	Date	Drawn
01	REVISE TURN LANE NOTE	RHW	JST	04/16/98	RHW
02	REVISE GUTTER MEDIAN SIDE	RHW	JST	06/10/98	Designed RHW
					Checked WPJ
					Approved JST

**GREENFIELD PARKWAY
PHASE 1**

**US 220
INTERSECTION**

1"=20'
NOVEMBER 12, 1997
PROJECT: 97042
16 of 34

NOTES:
1. ALL NEW PIPES SHOULD MATCH MATERIAL OF JOINING PIPE.
2. MATCH ROAD SURFACE TO EXISTING WHEN ADJACENT.