

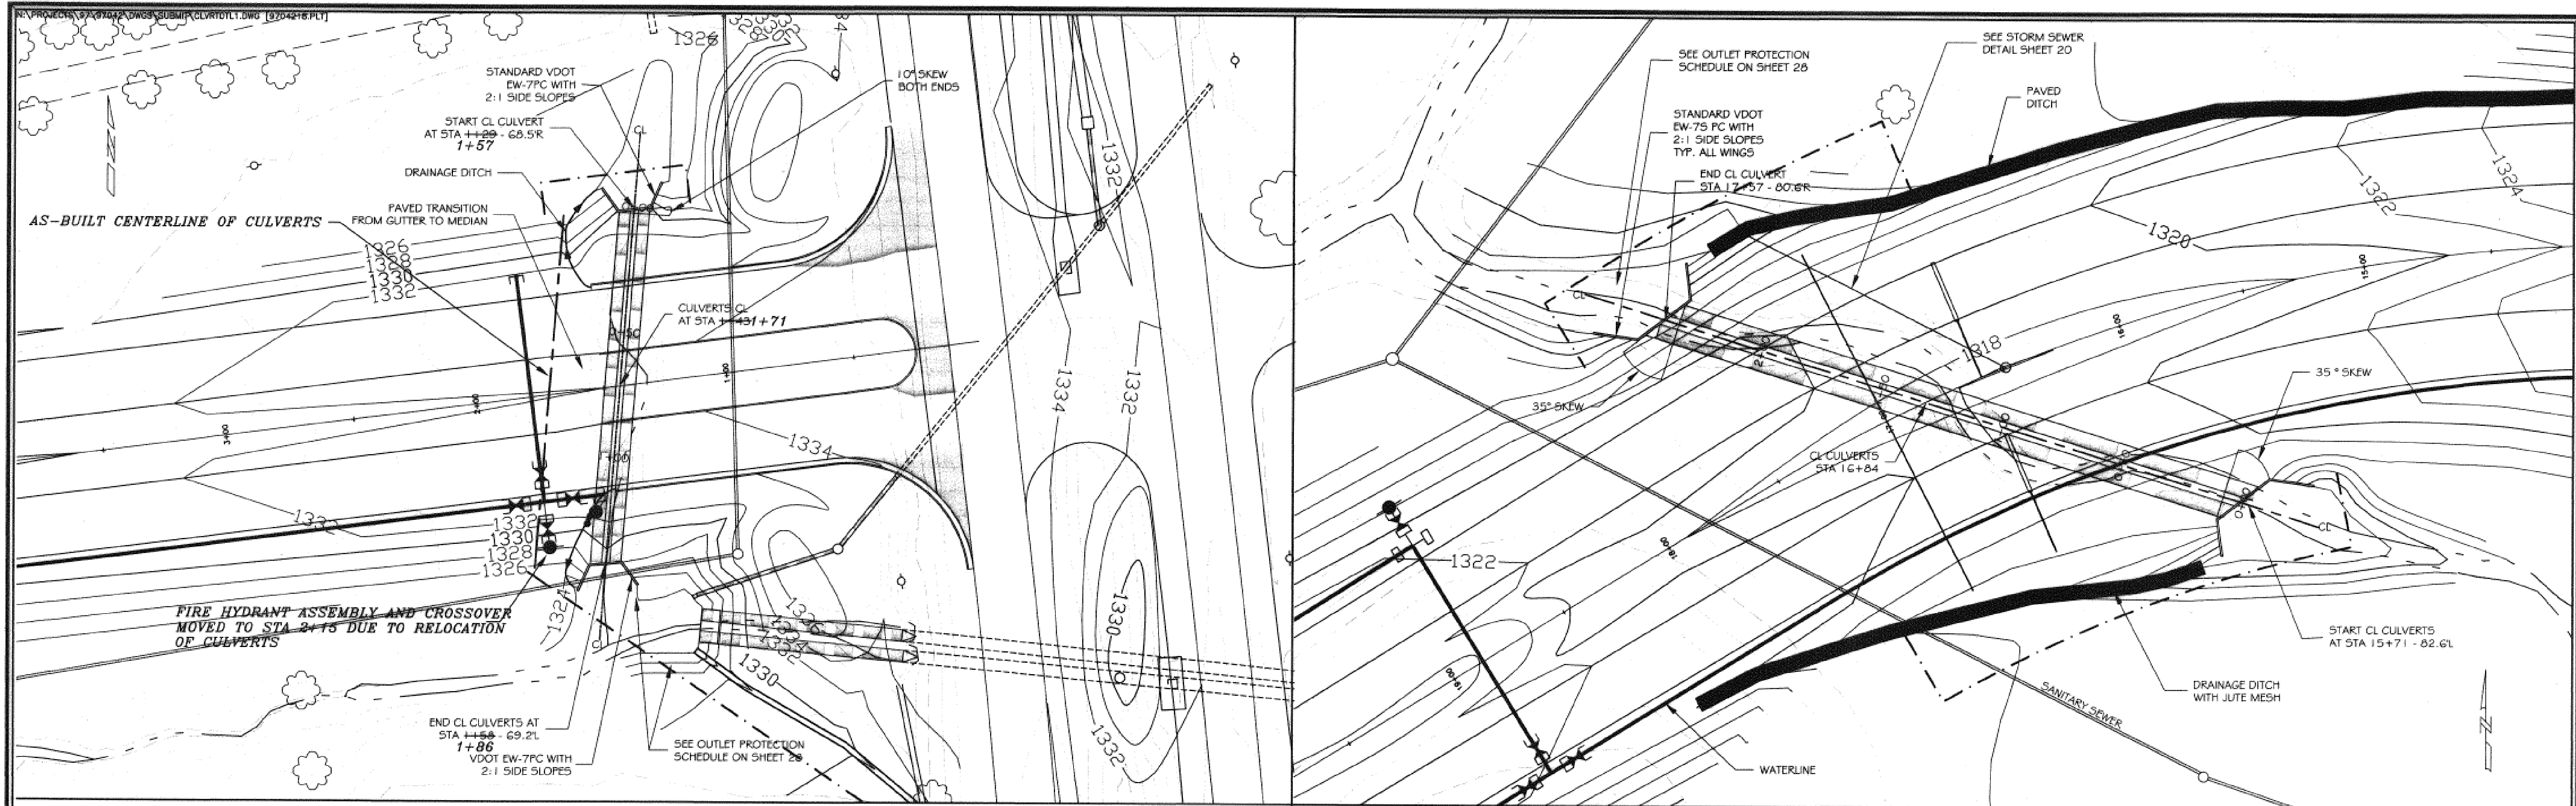
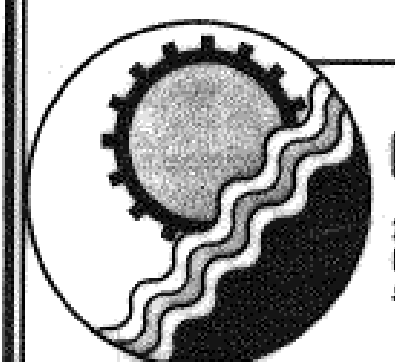


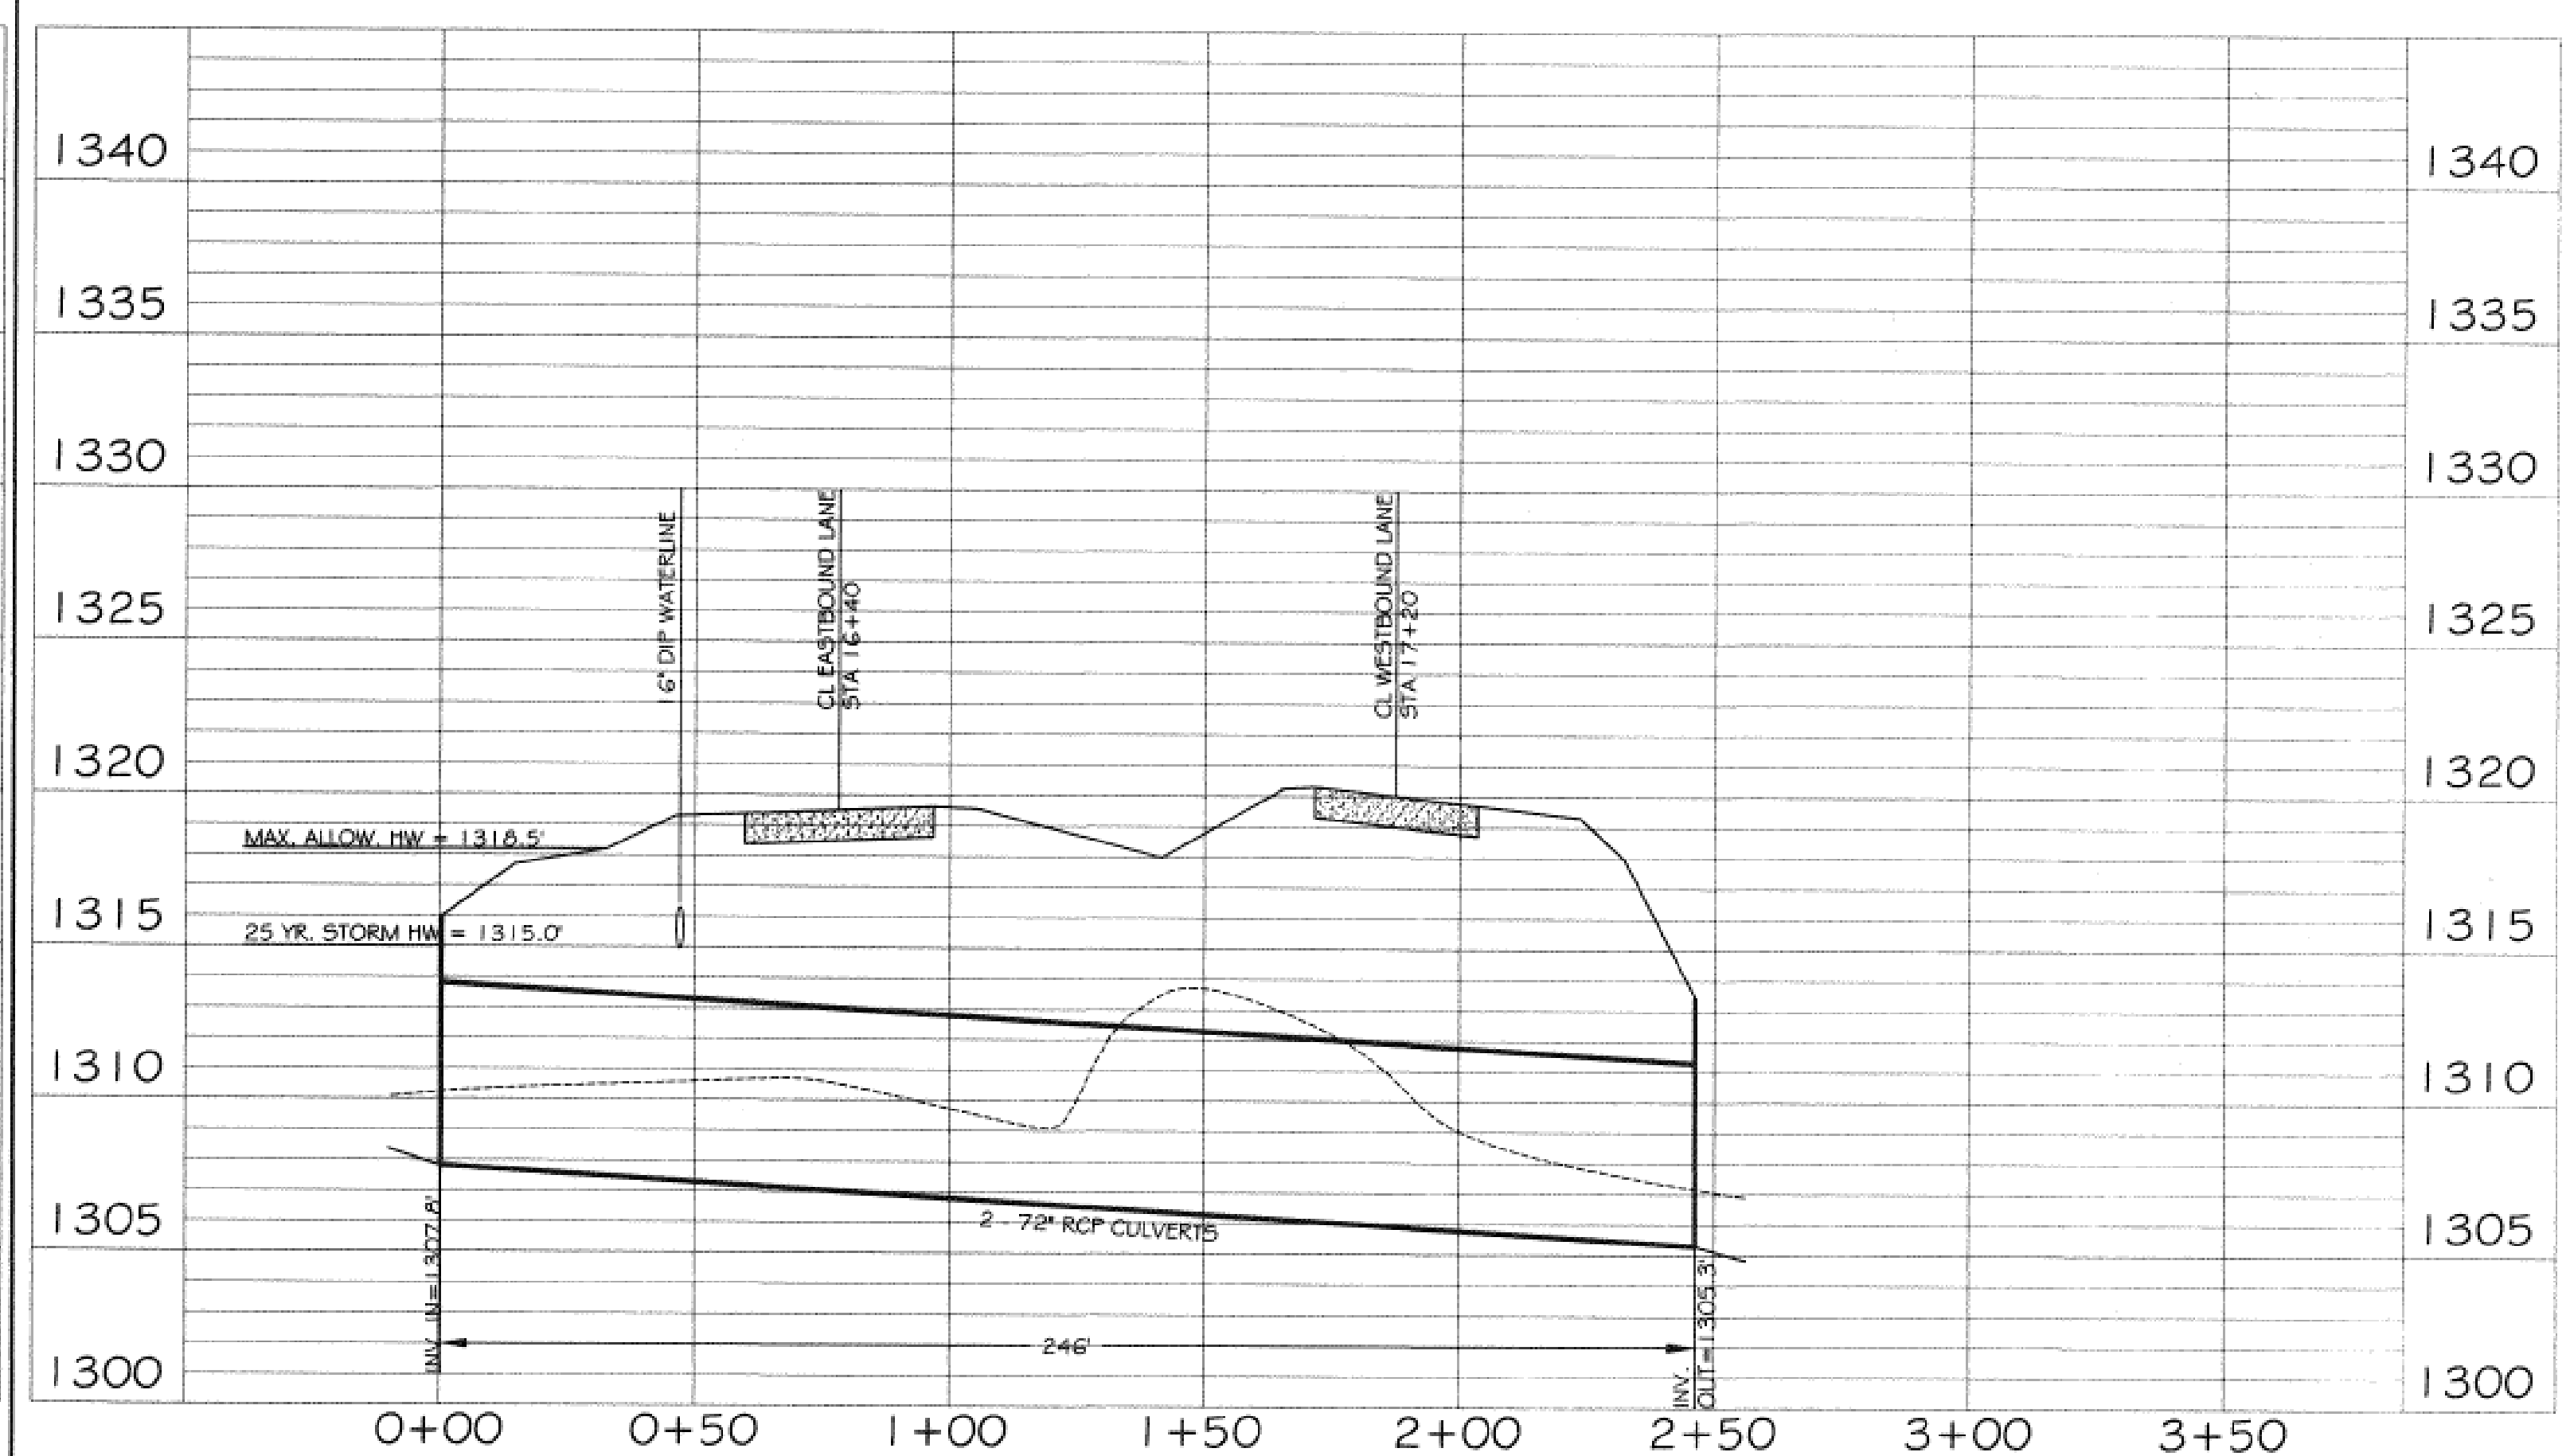

FONT DESIGNATES AS BUILT CHANGES TO DESIGN PLANS

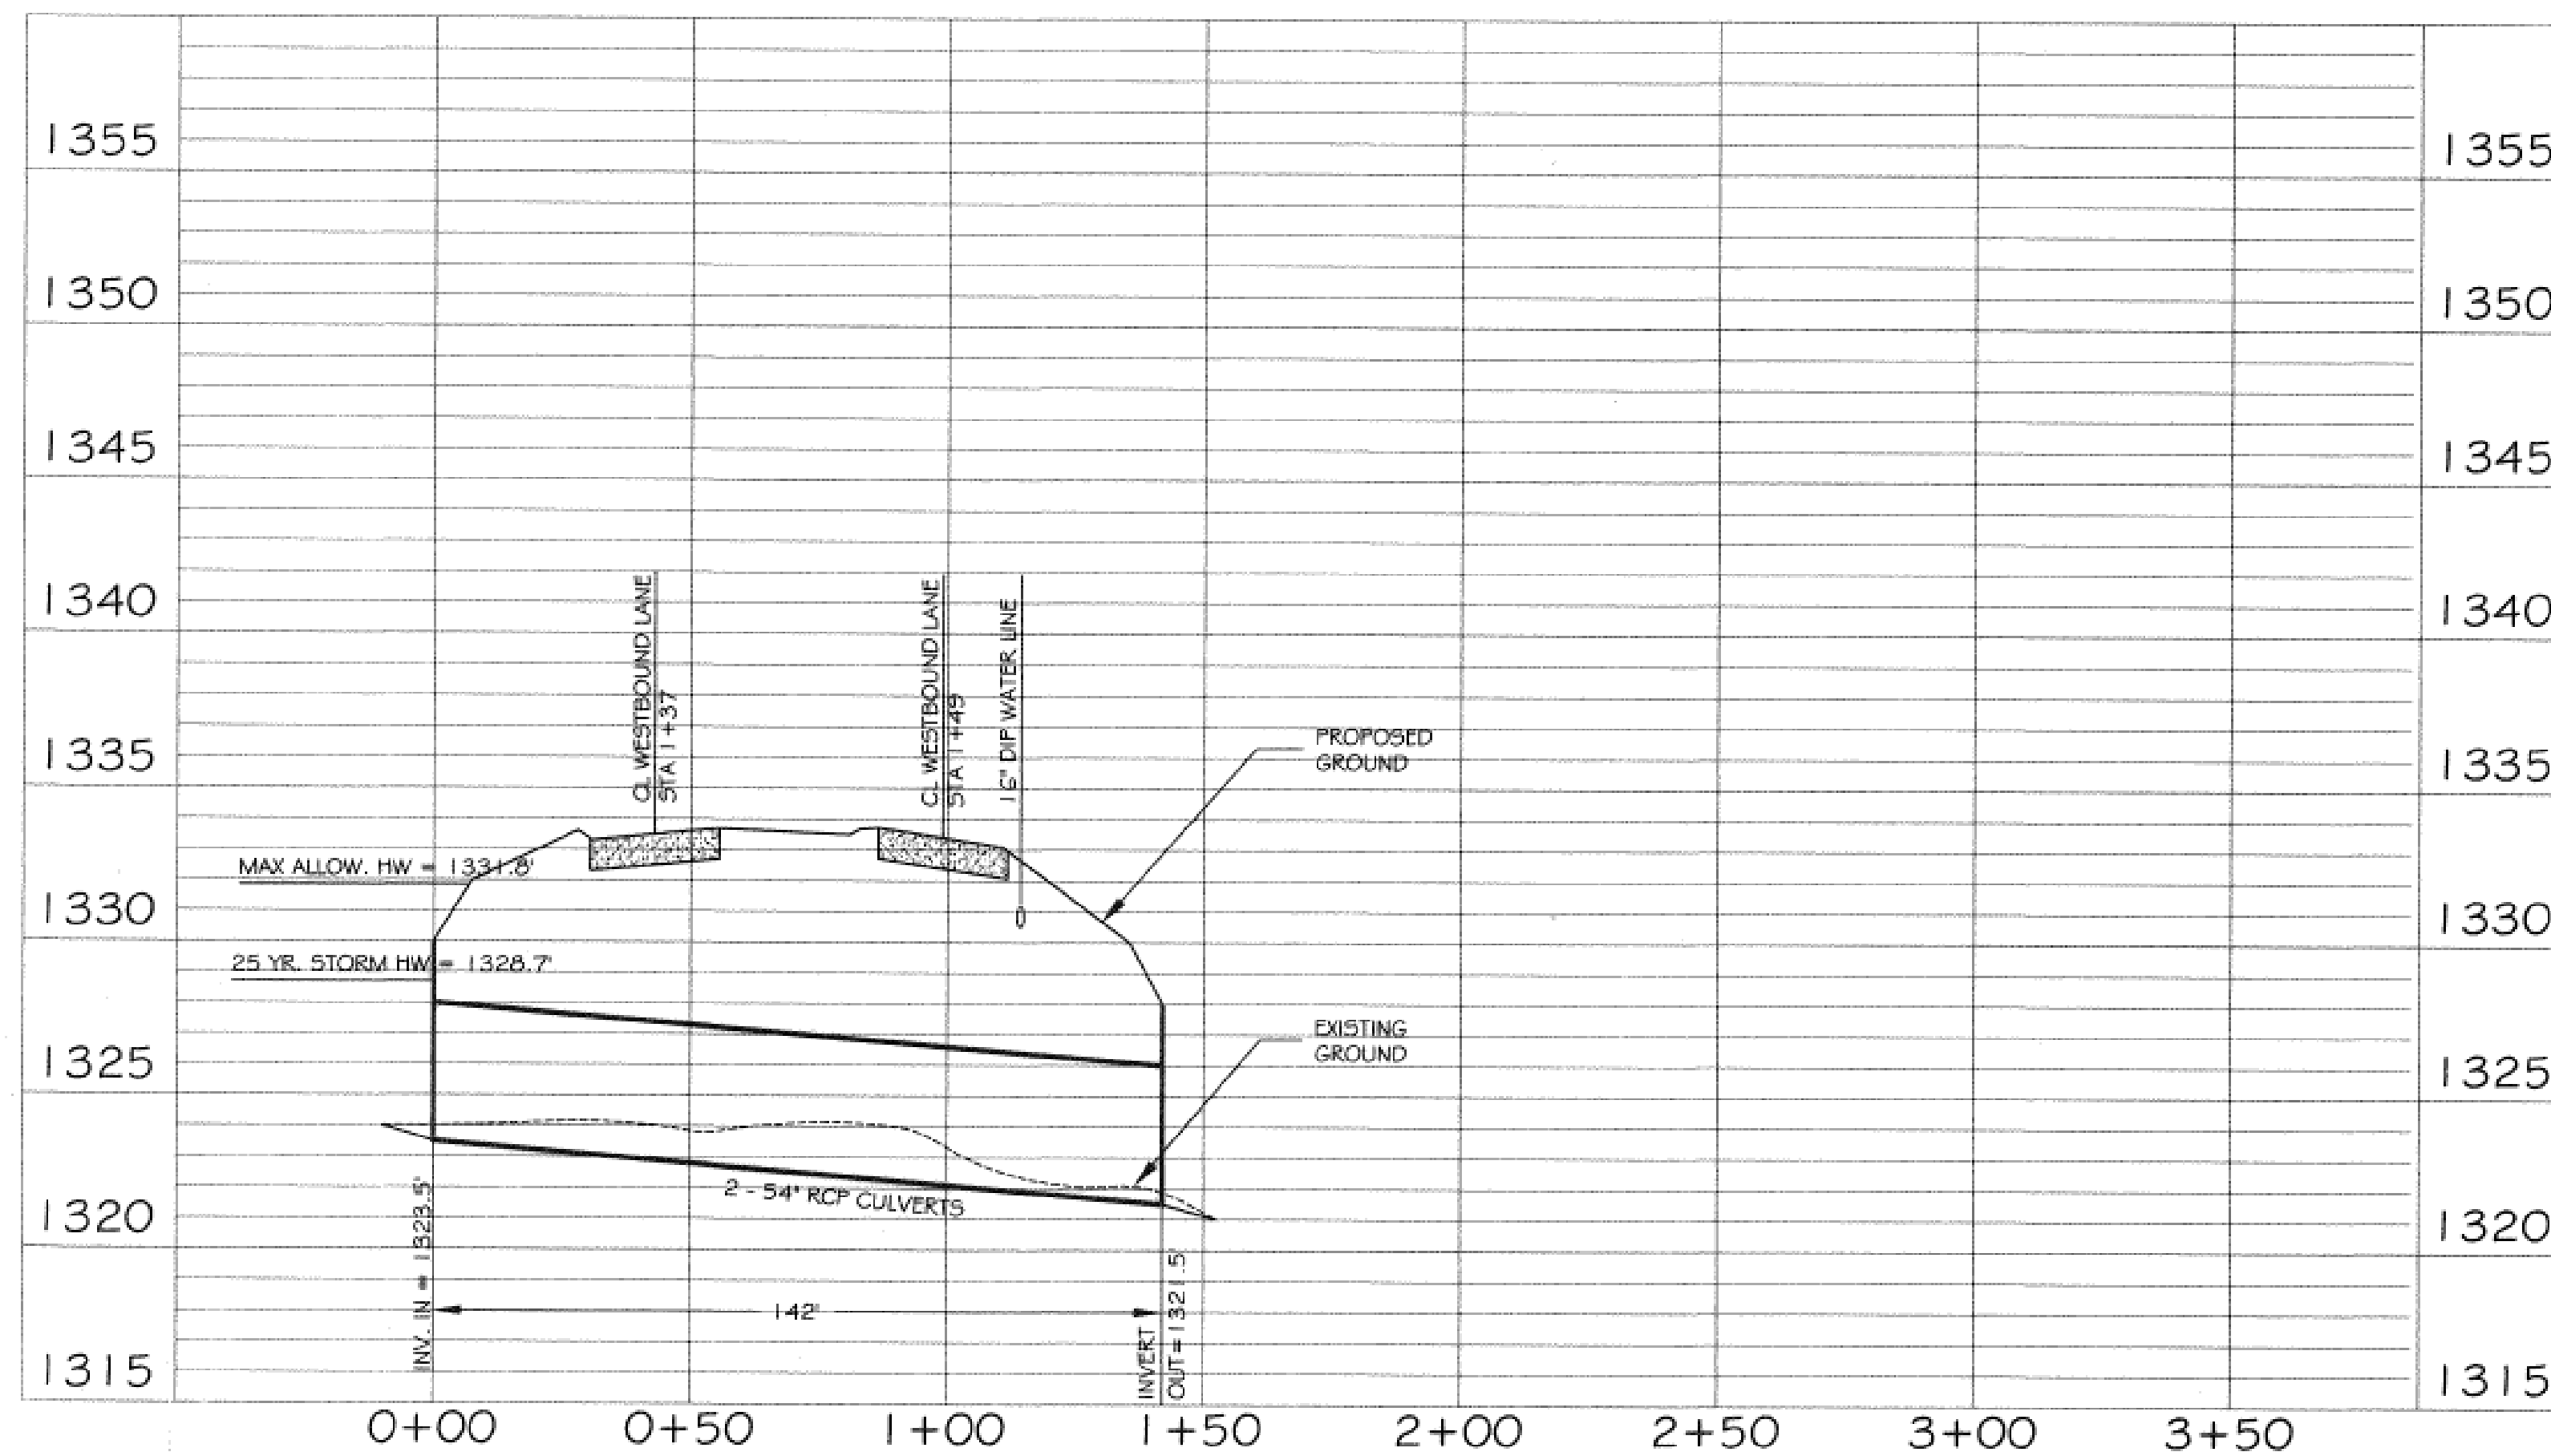

ENGINEERING CONCEPTS, INC.

20 S. ROANOKE ST., PO BOX 619
FINCASTLE, VIRGINIA 24090
540.473.1253 FAX: 540.473.1254

AS-BUILT

Drawn RHW
Designed RHW
Checked WPJ
Approved JST

**GREENFIELD PARKWAY
PHASE 1
CULVERT PLAN & PROFILE
STA 1+00, 16+00**

H:1"=30' V:1"=5'
NOVEMBER 12, 1997
PROJECT: 97042
18 of 34