
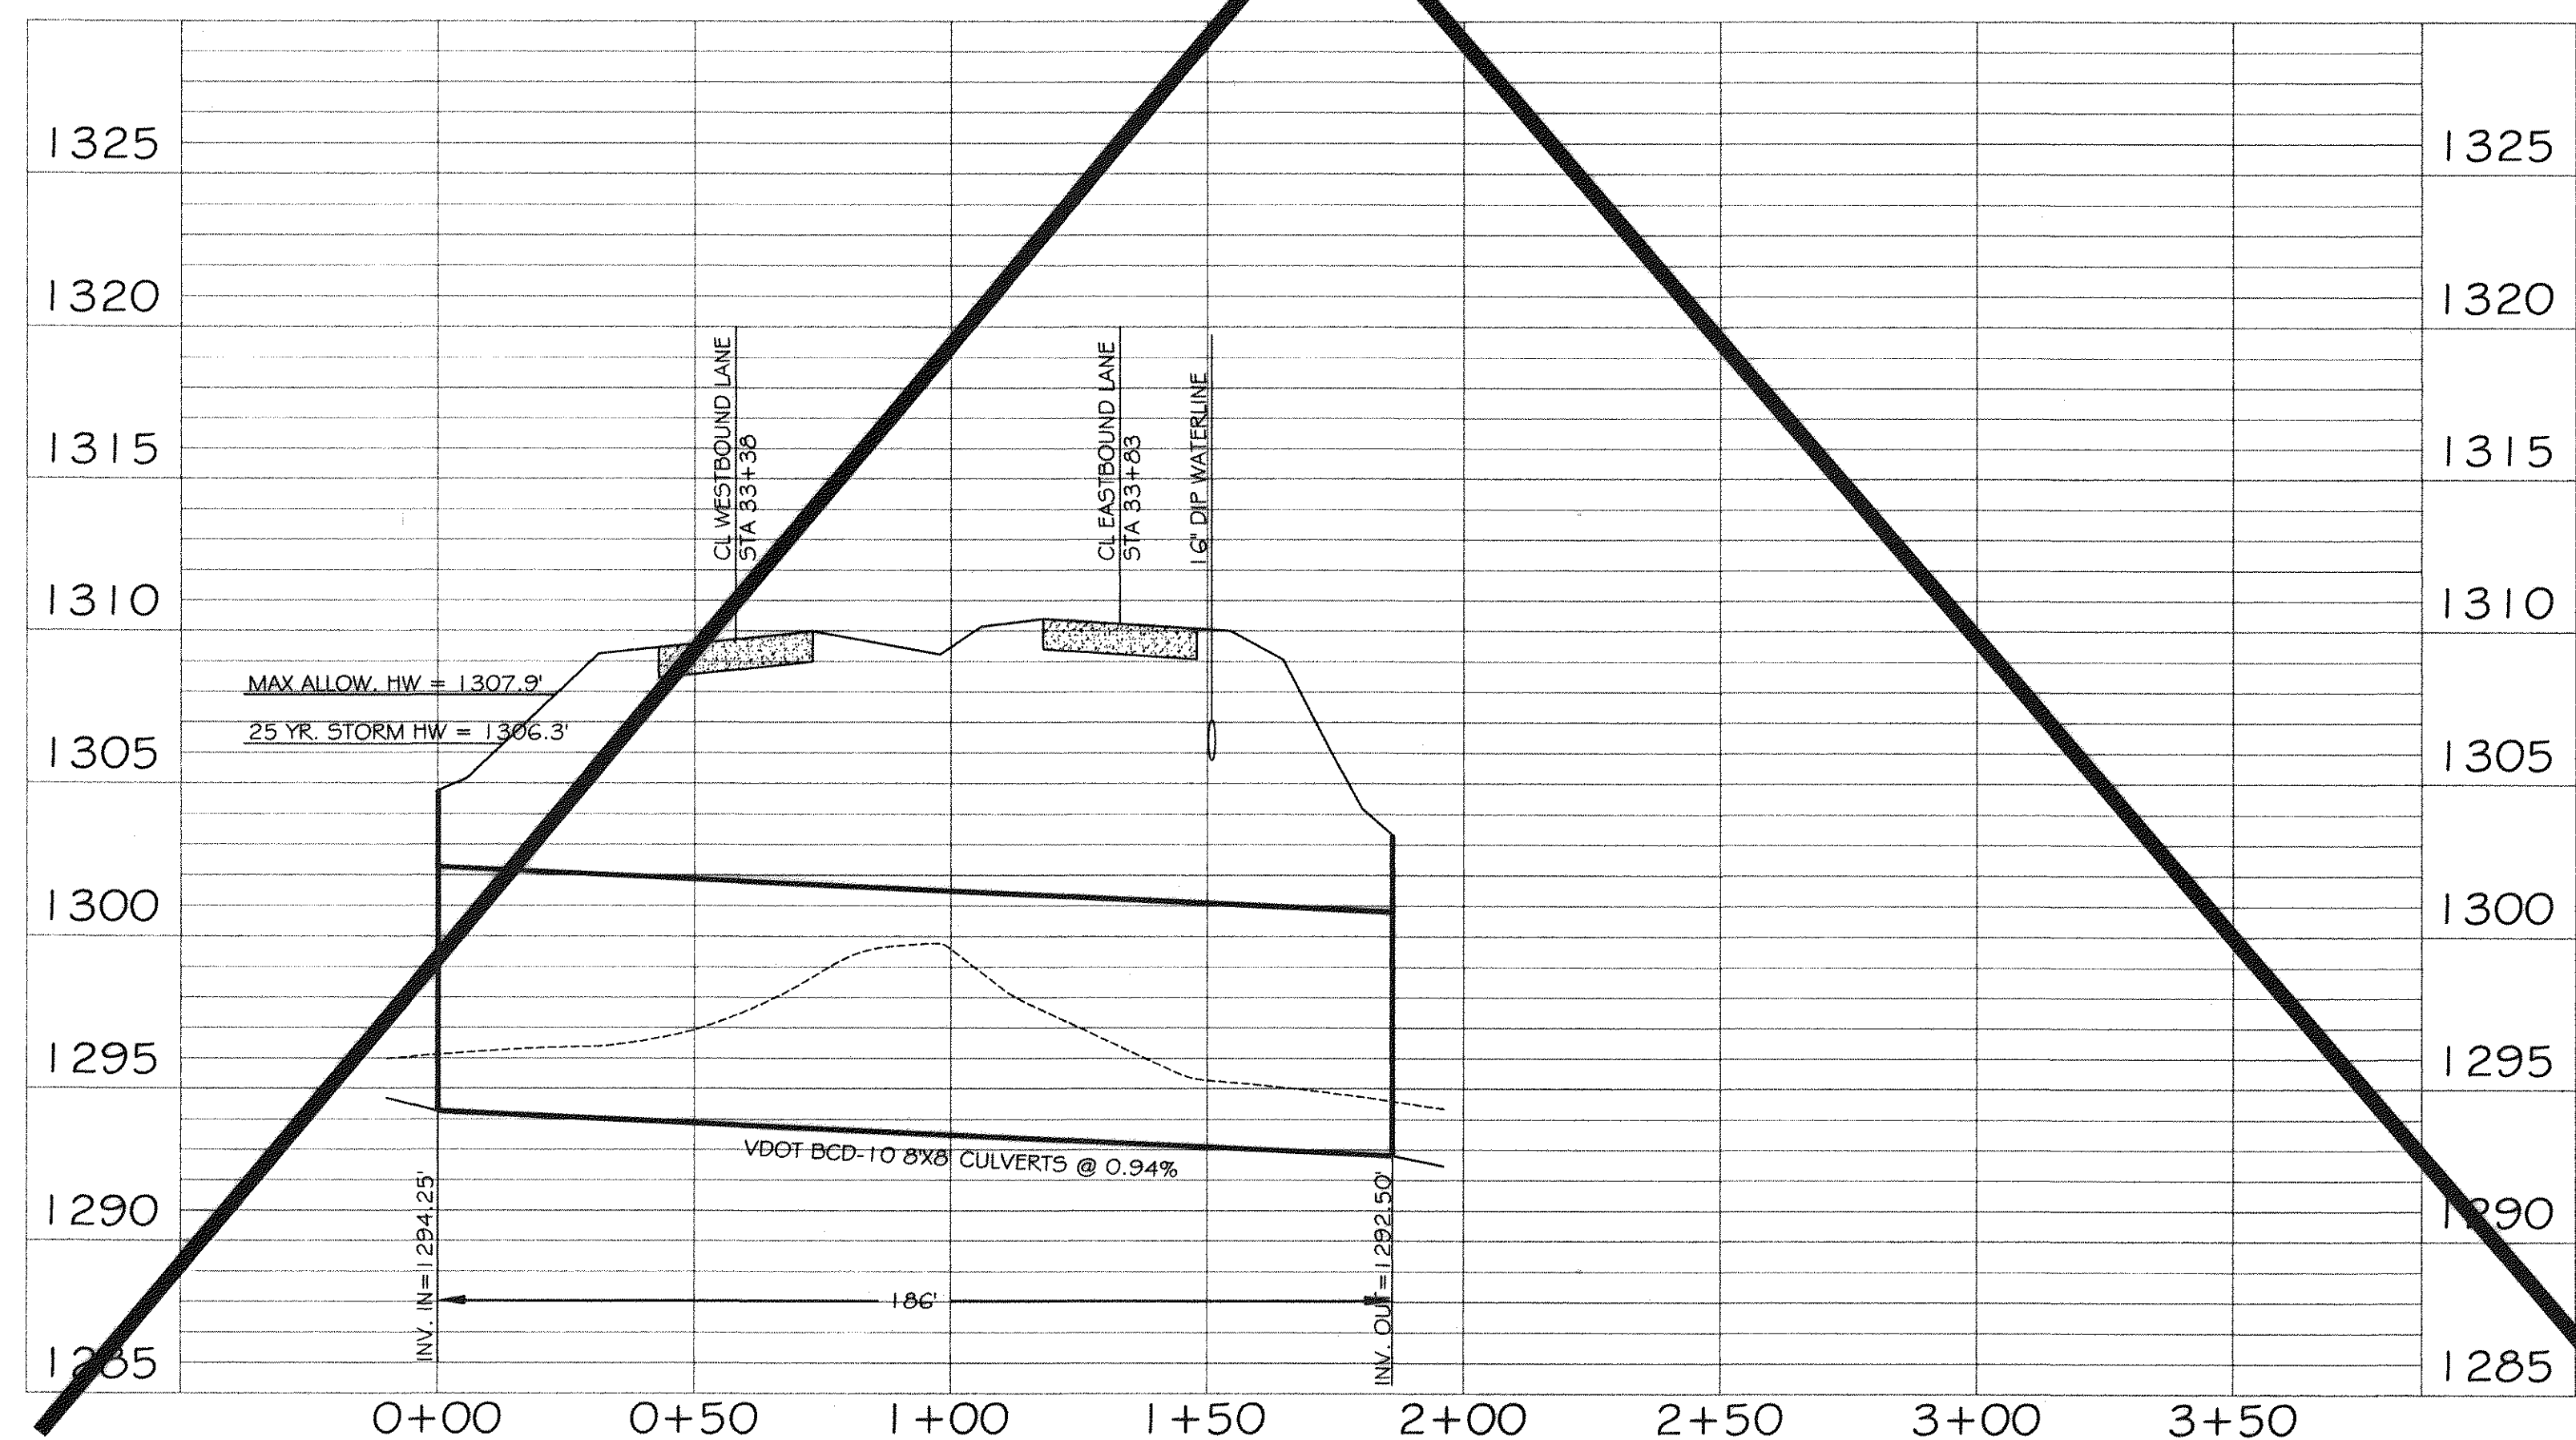


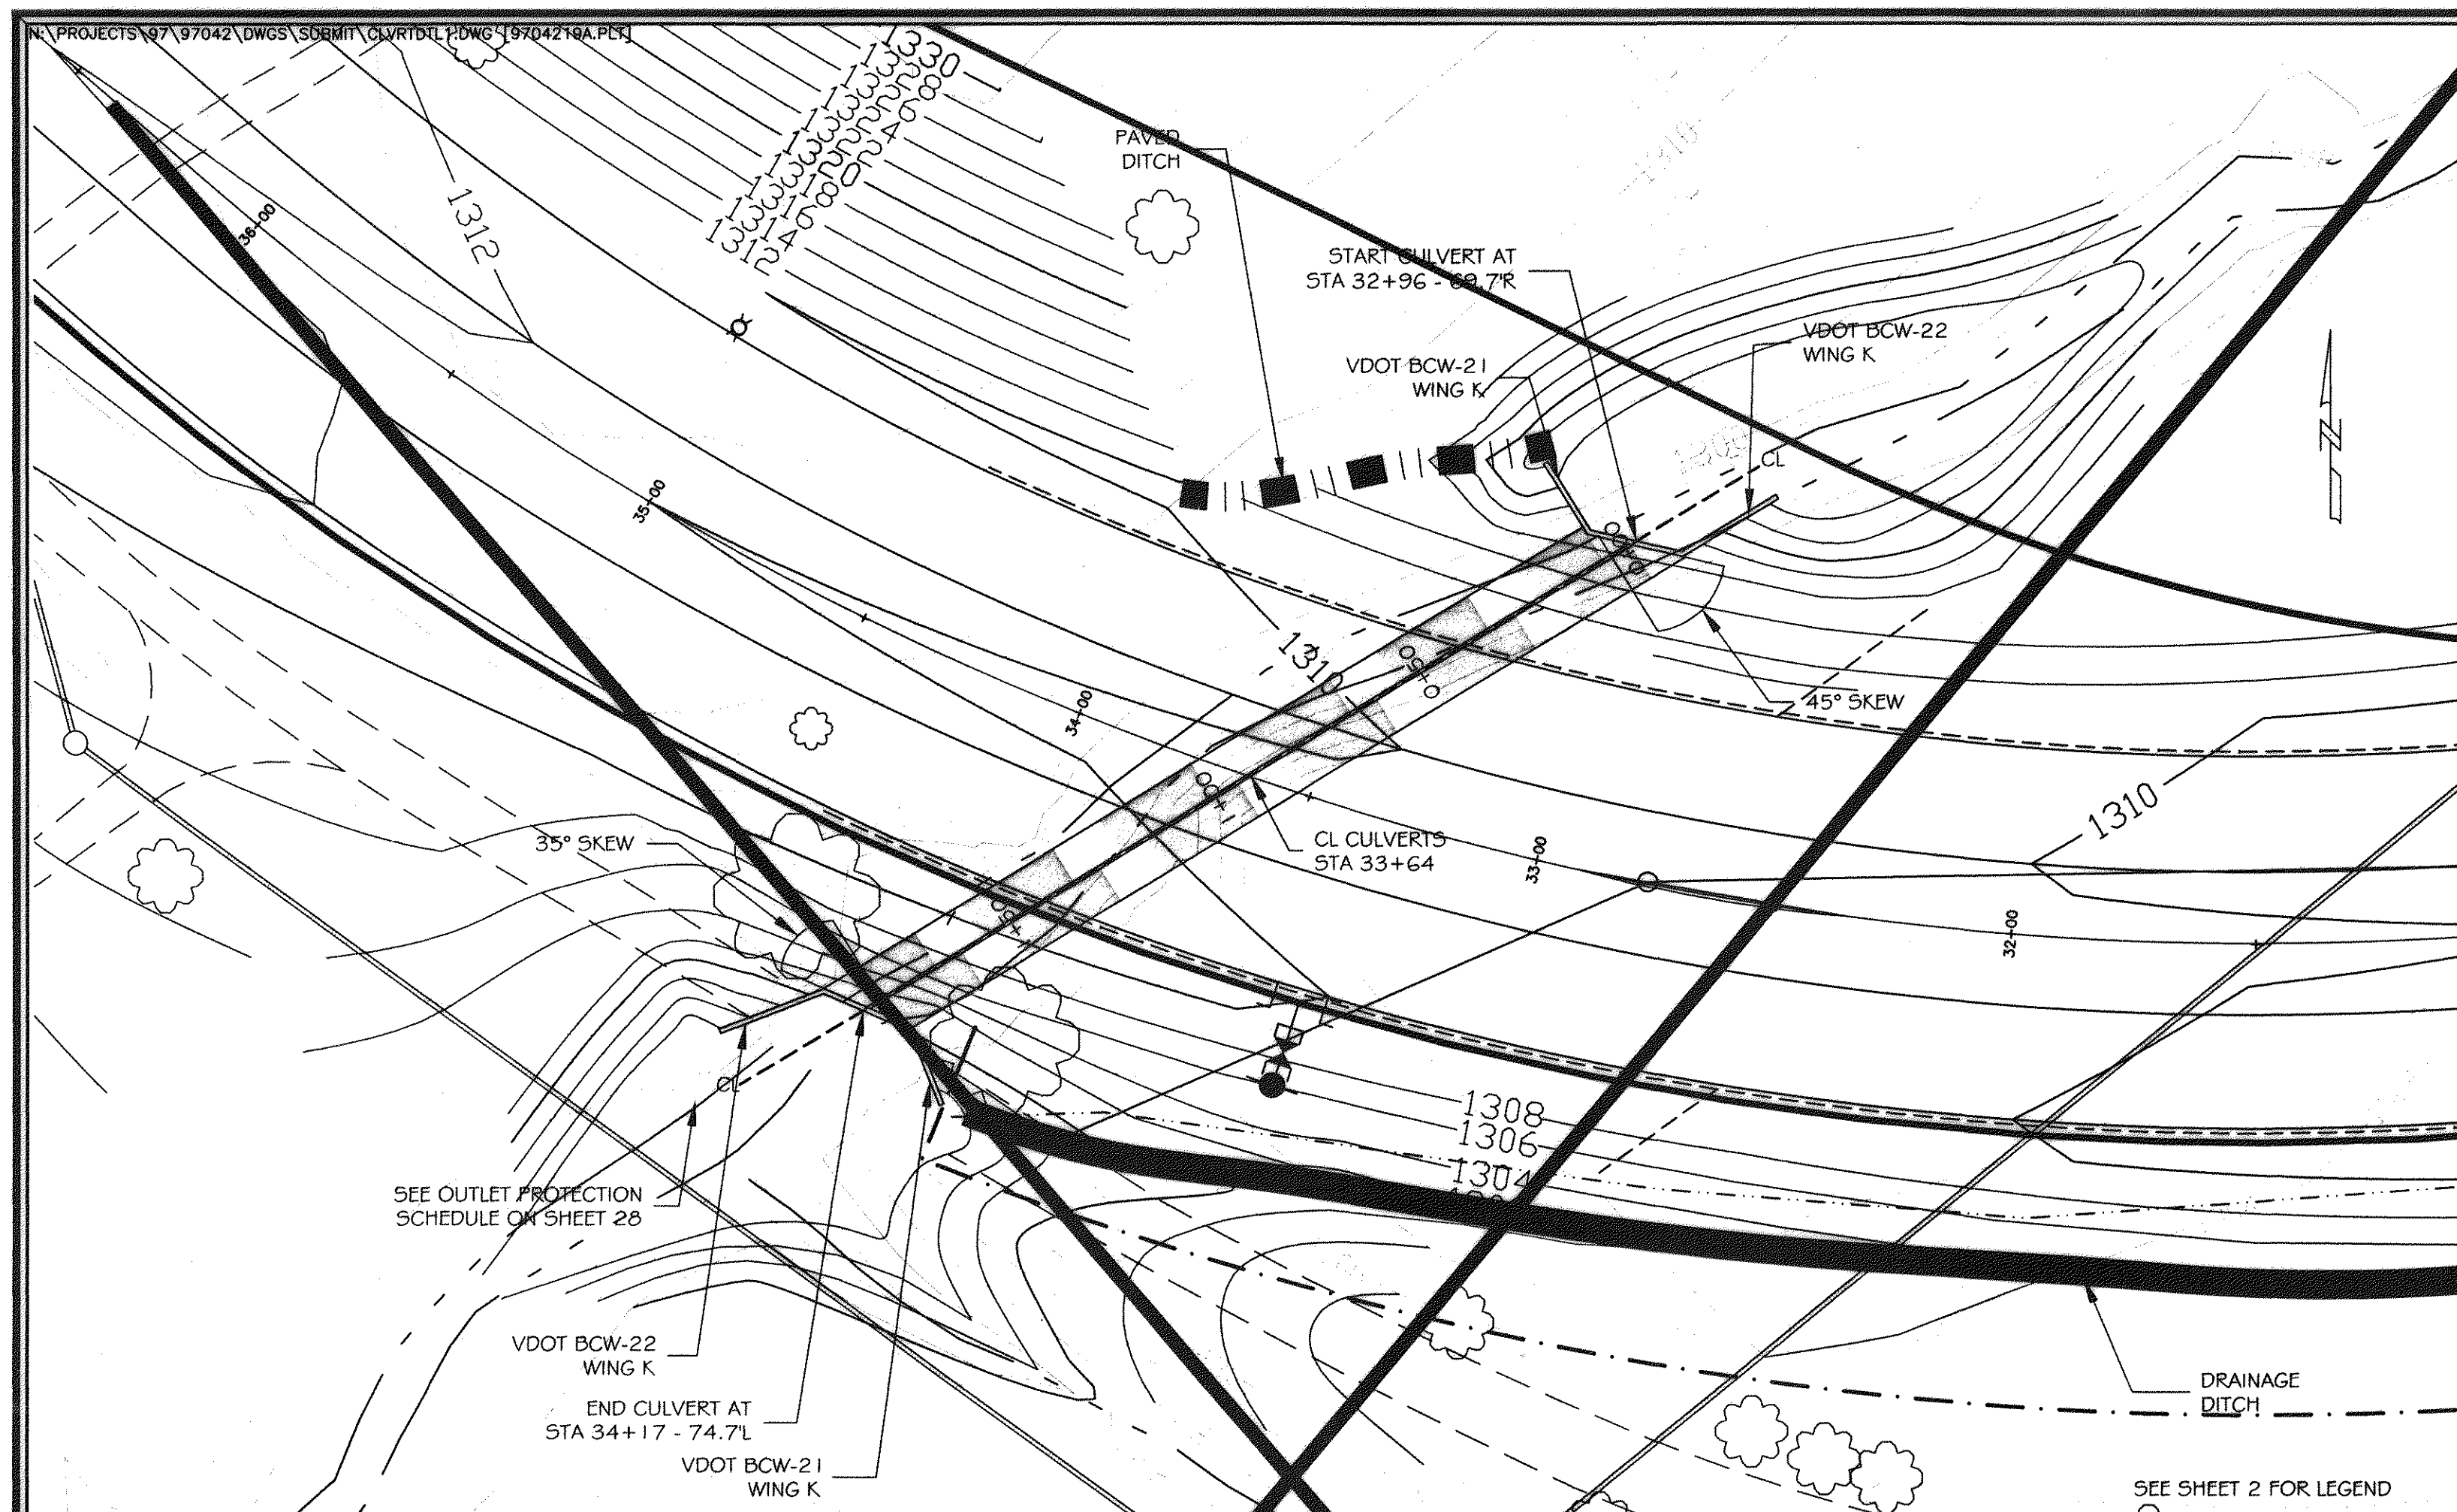

NOT CONSTRUCTED

FONT DESIGNATES AS BUILT CHANGES TO DESIGN PLANS

AS-BUILT