


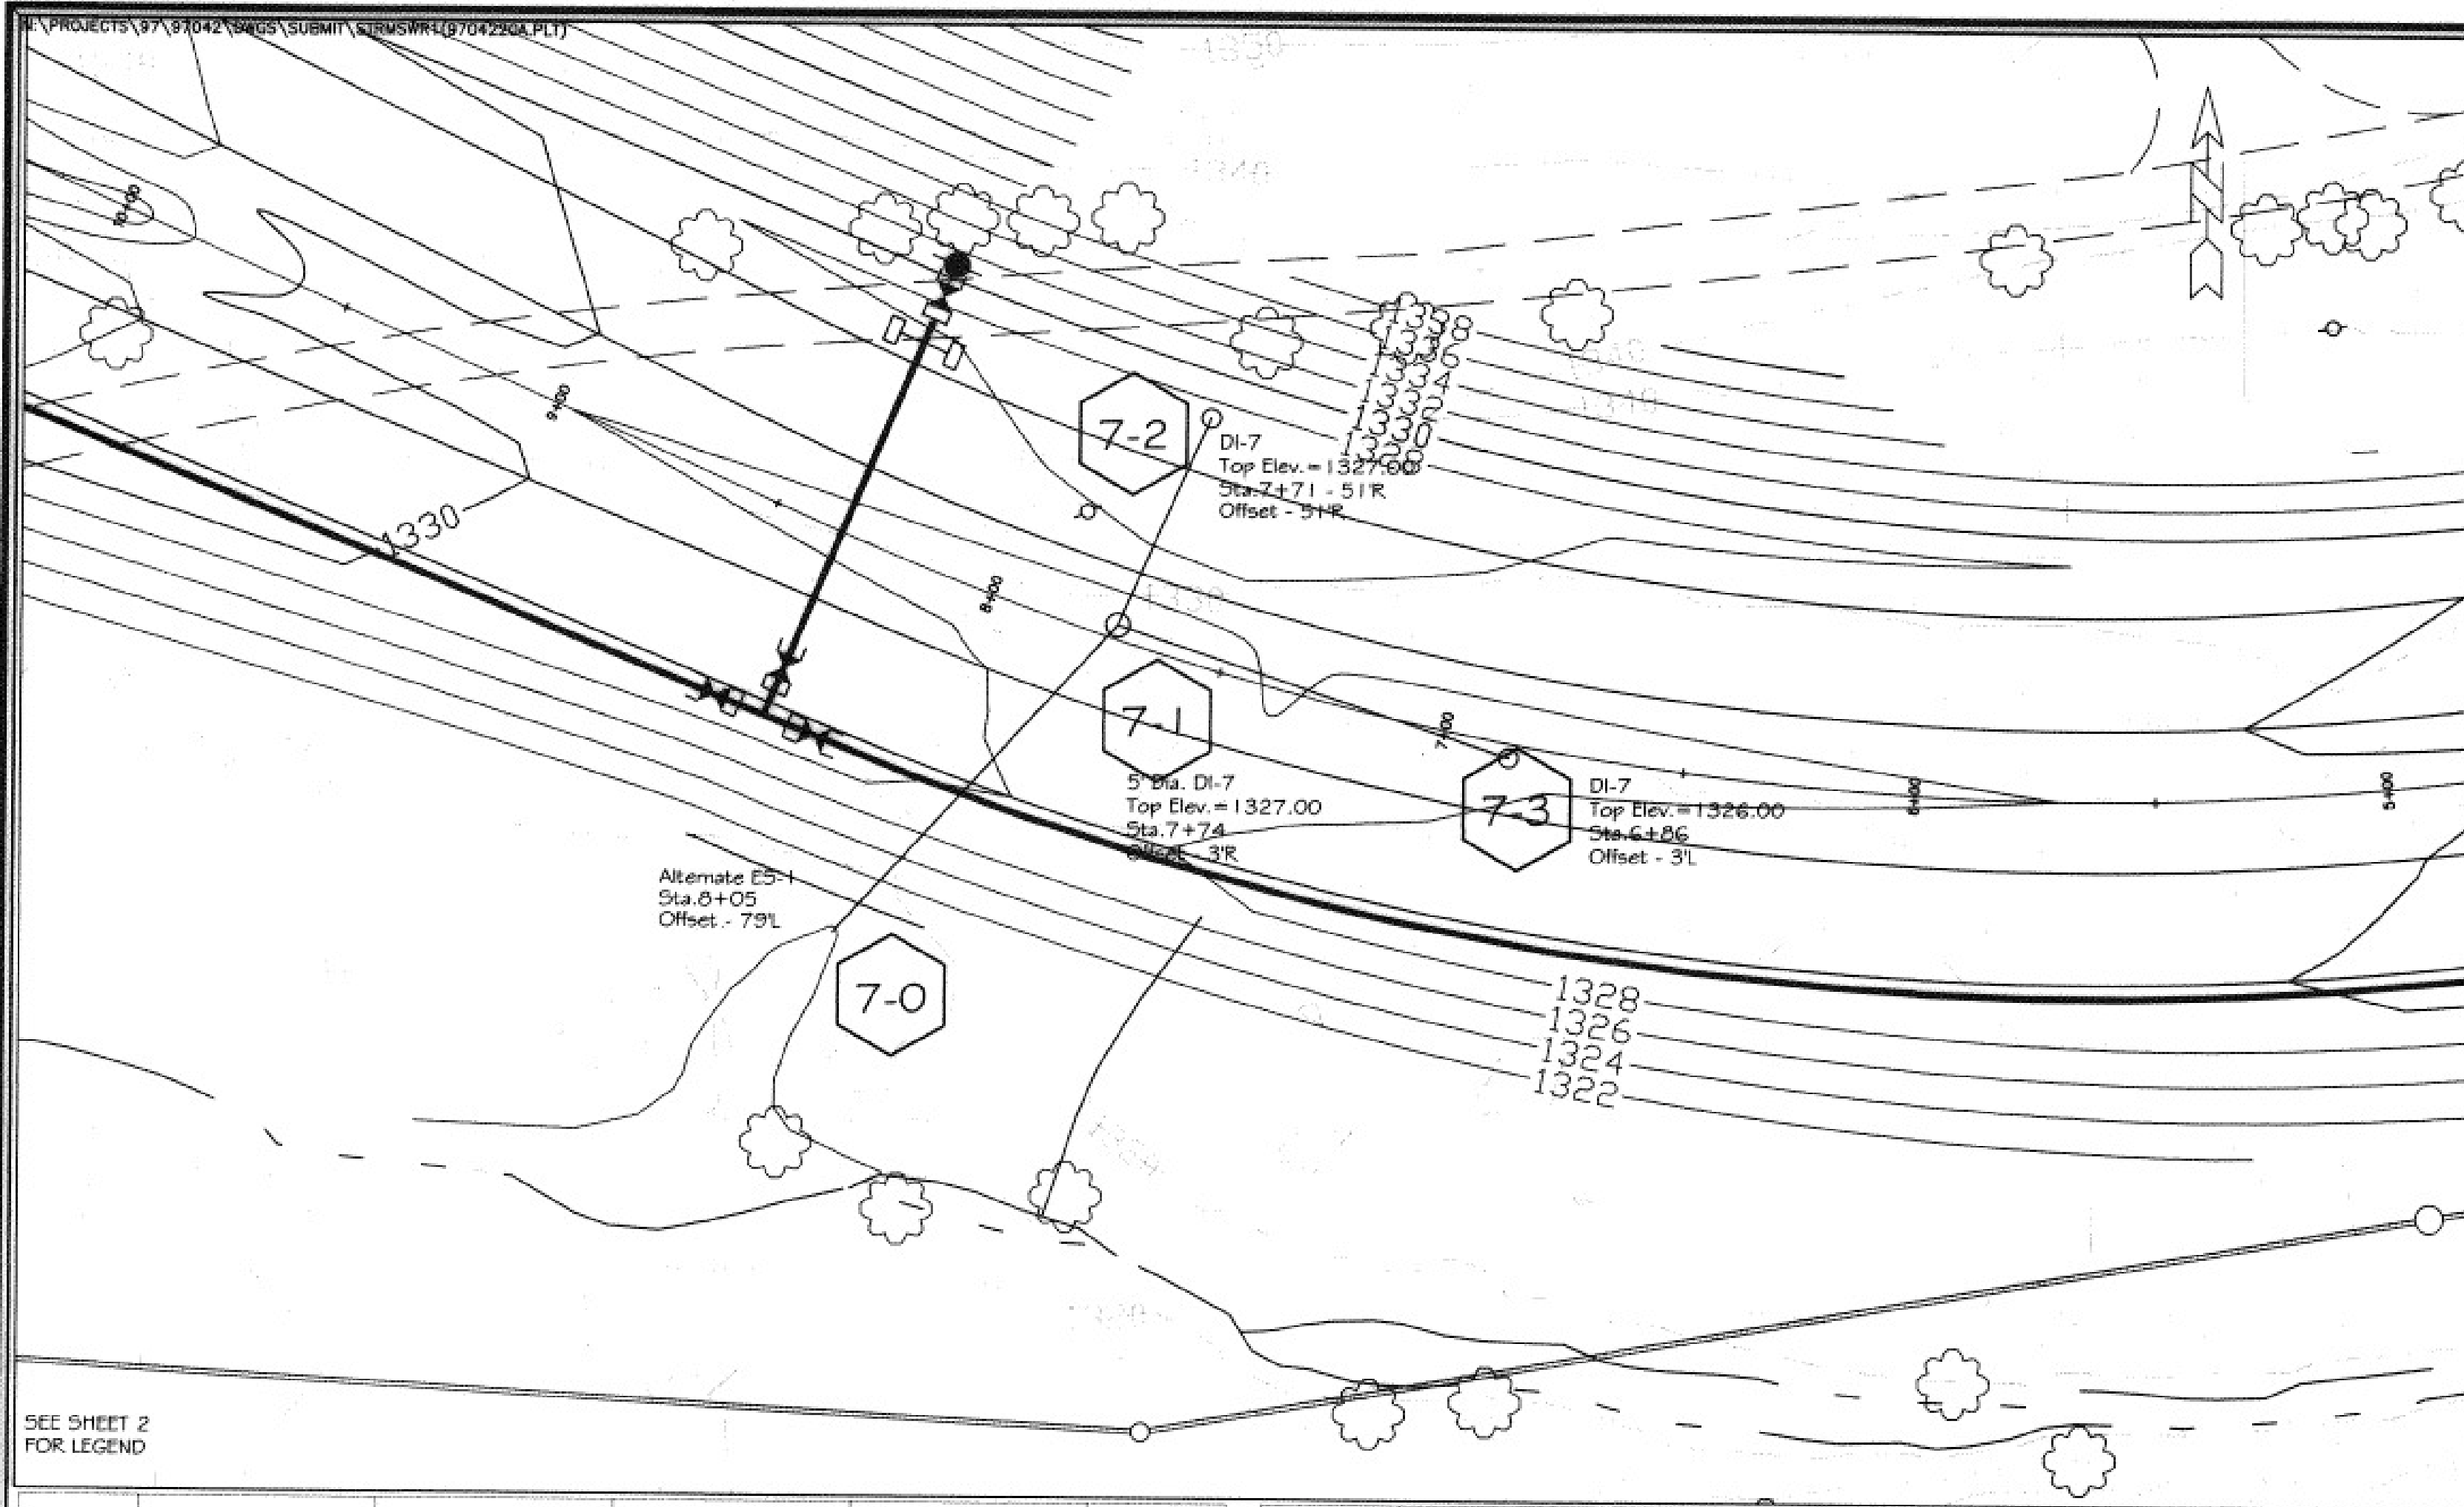
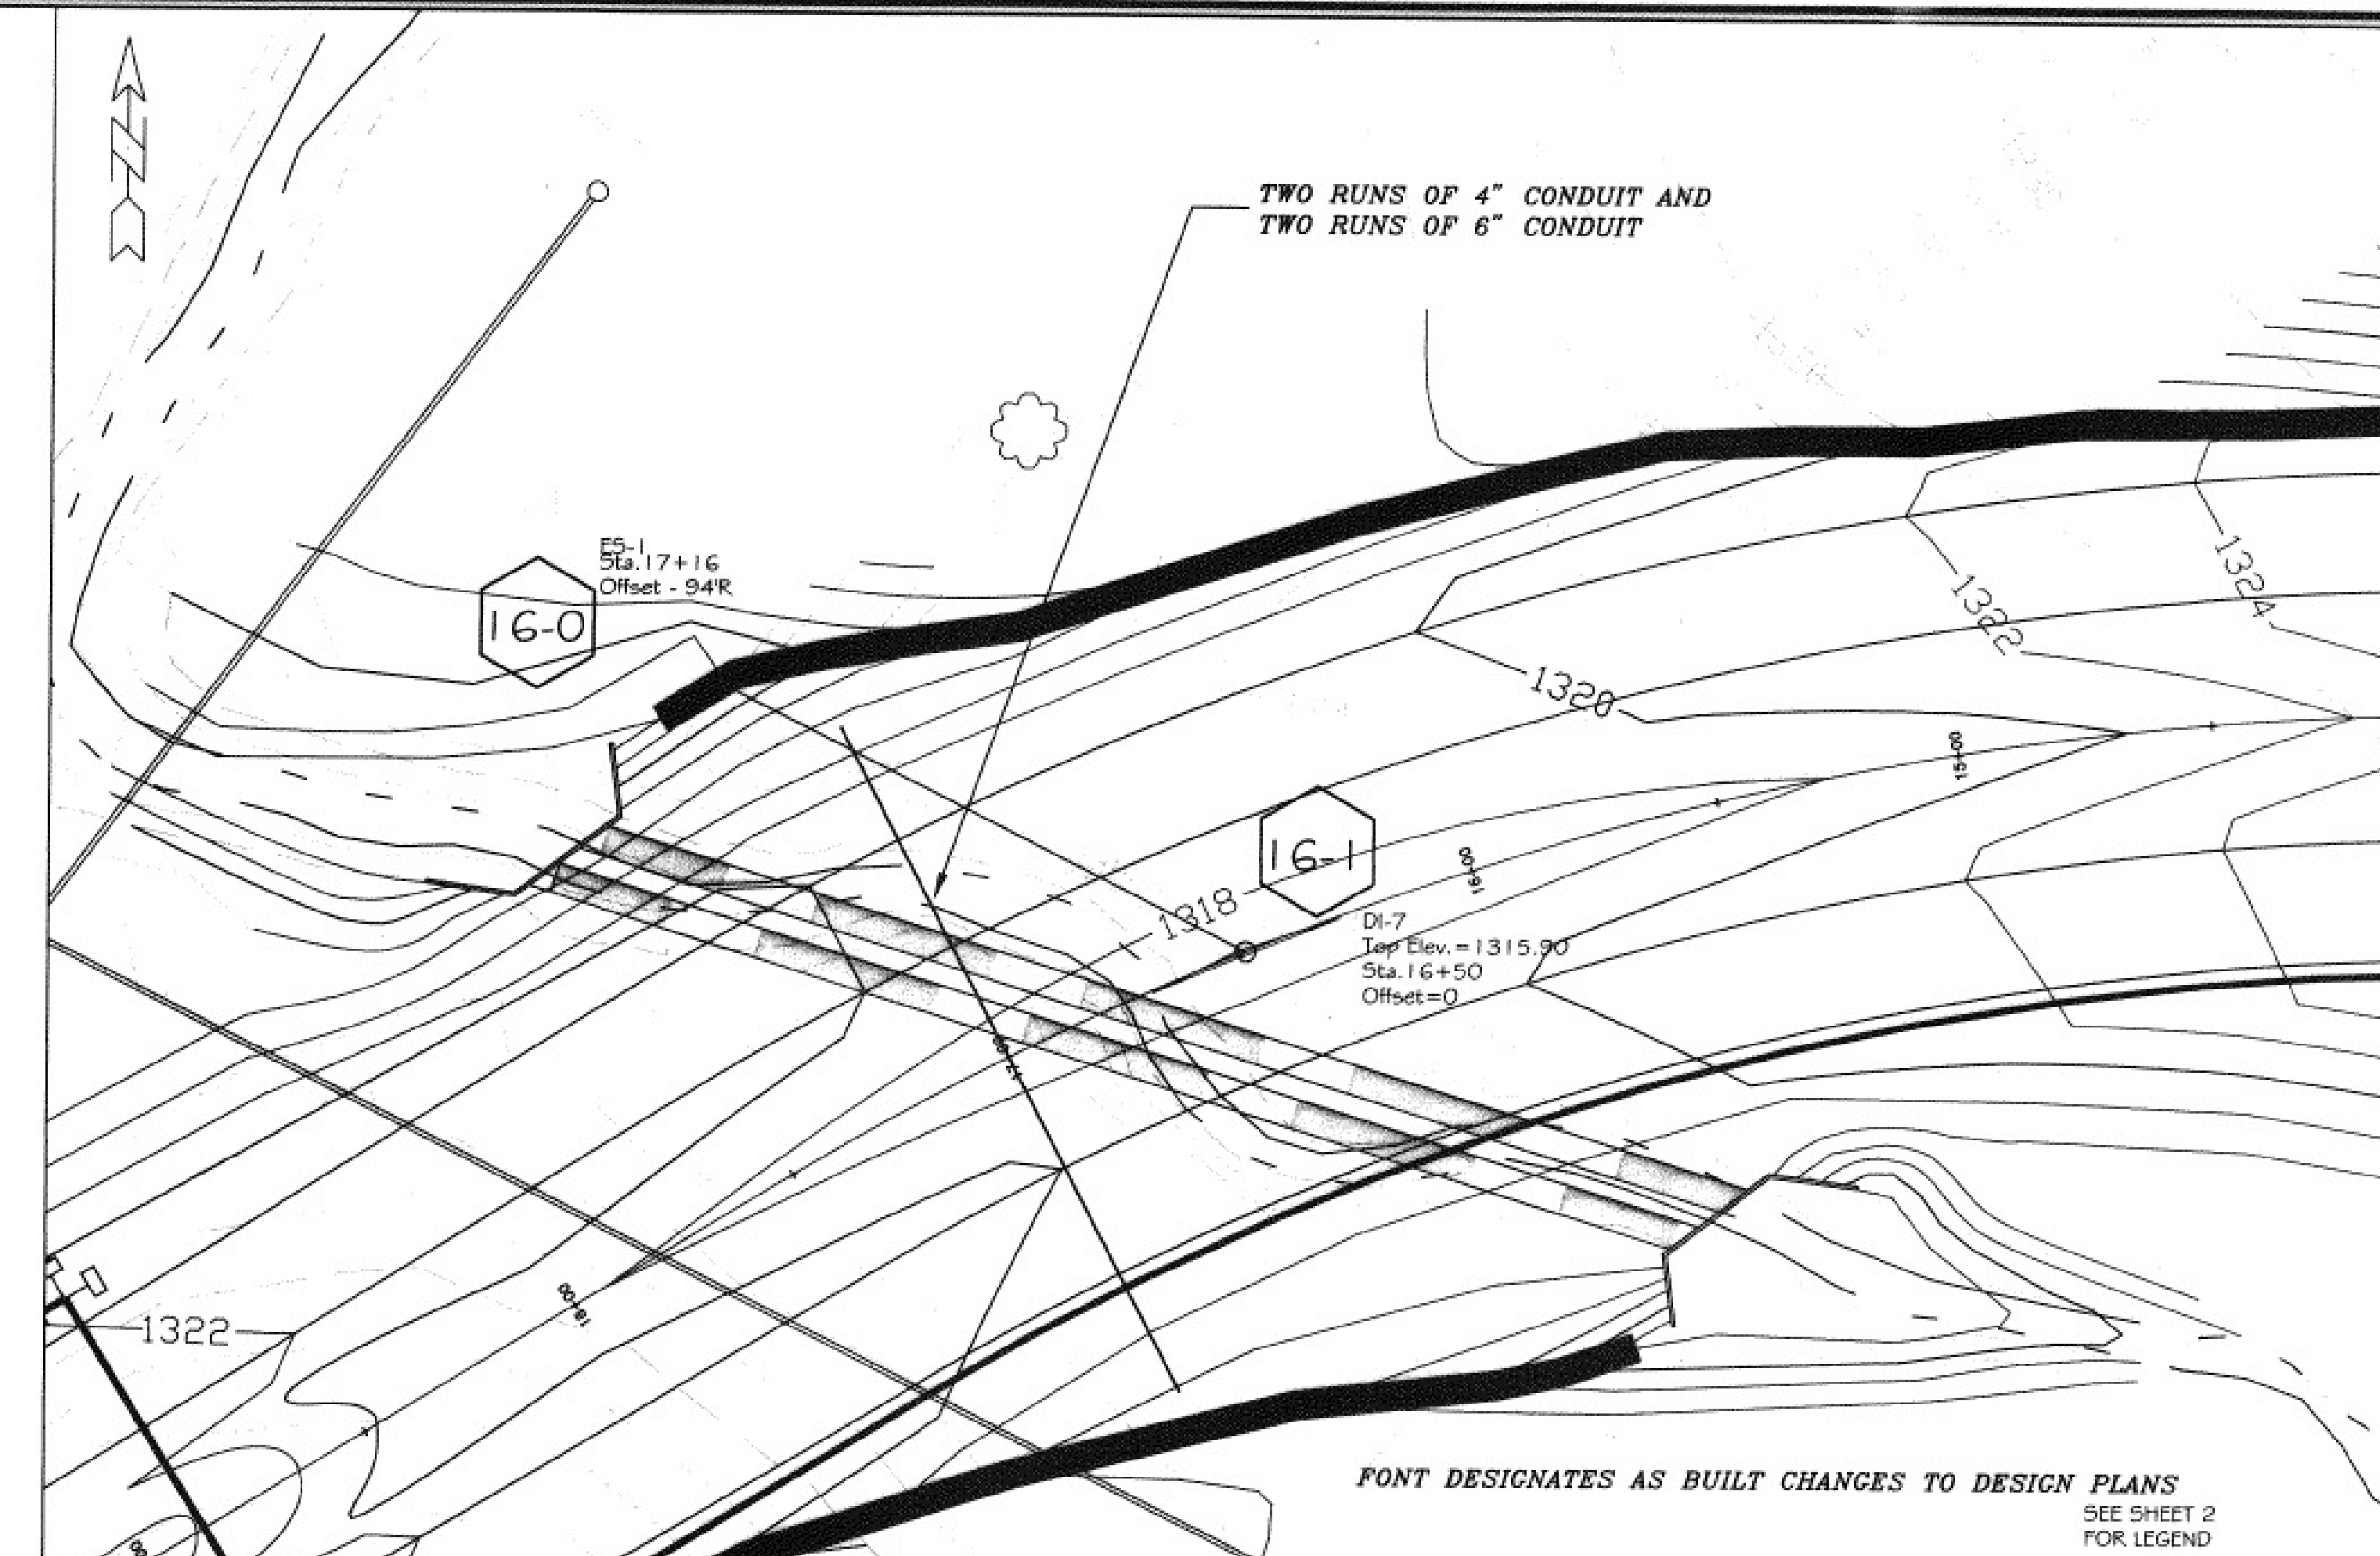


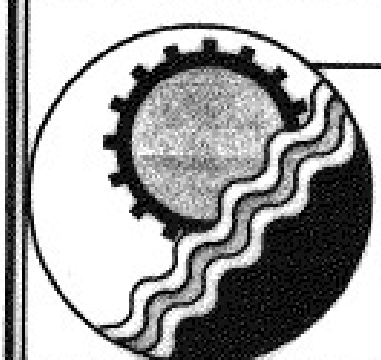

SEE SHEET 2 FOR LEGEND

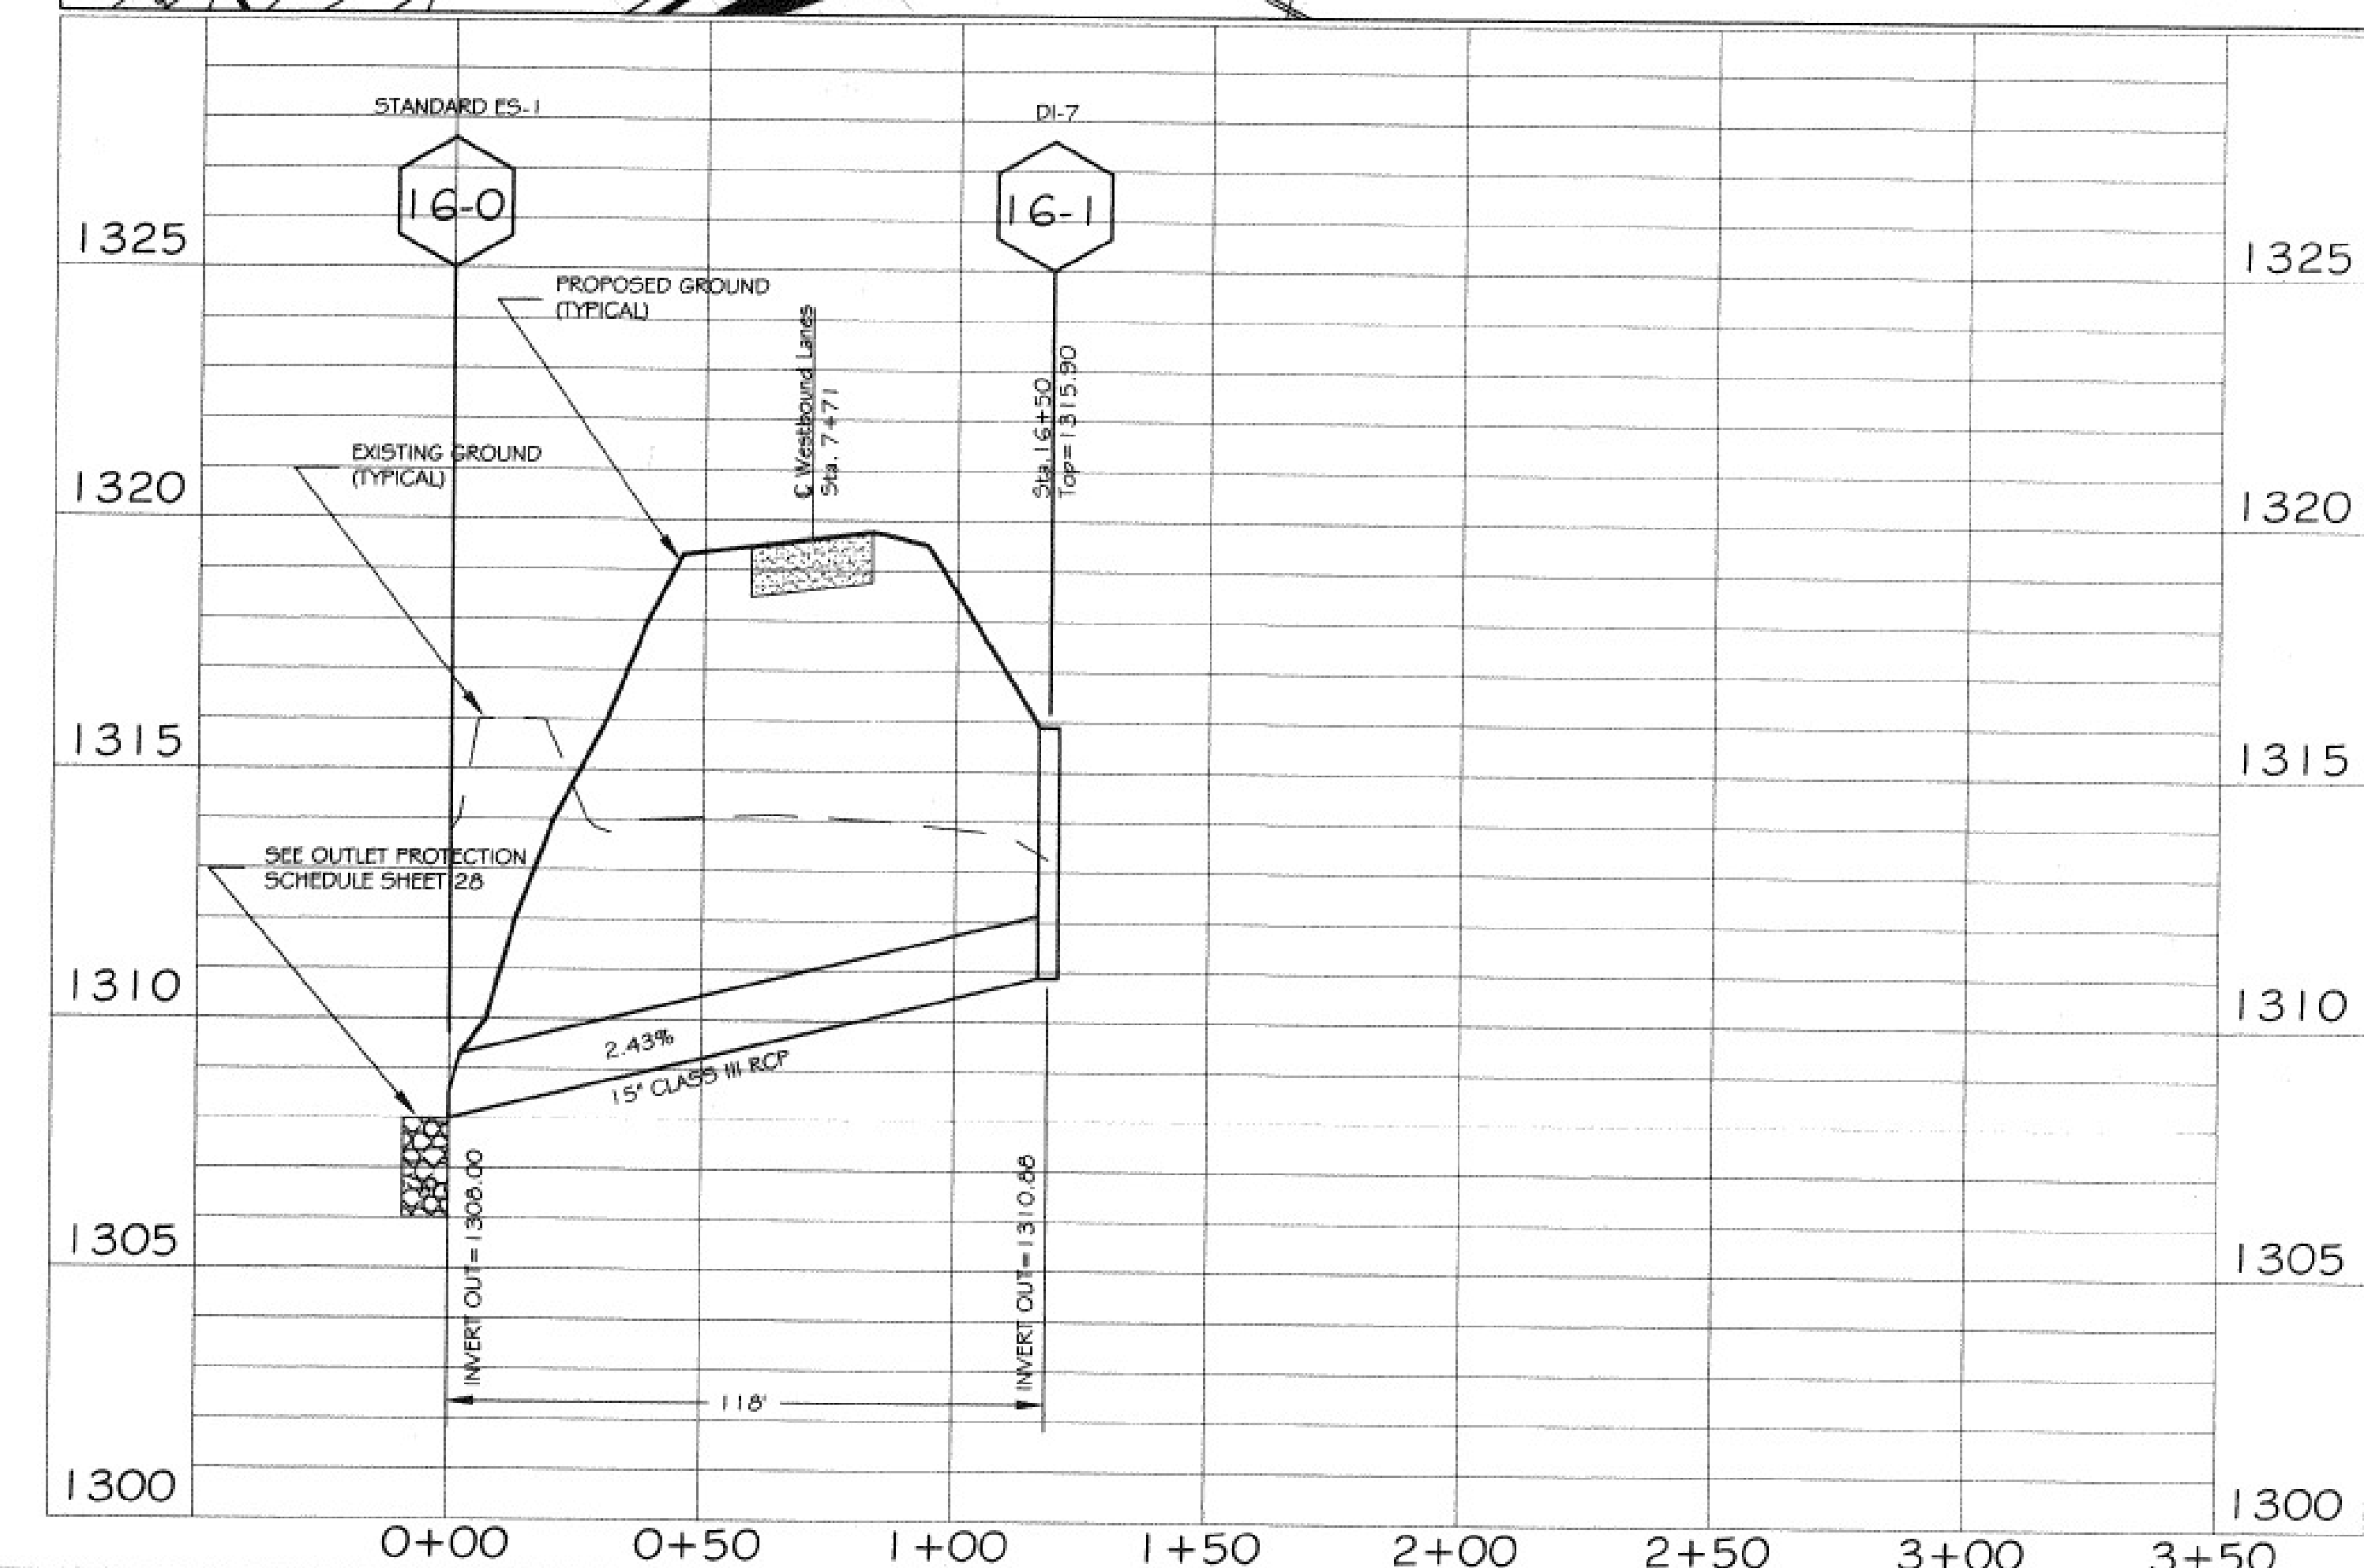

FONT DESIGNATES AS BUILT CHANGES TO DESIGN PLANS
SEE SHEET 2 FOR LEGEND

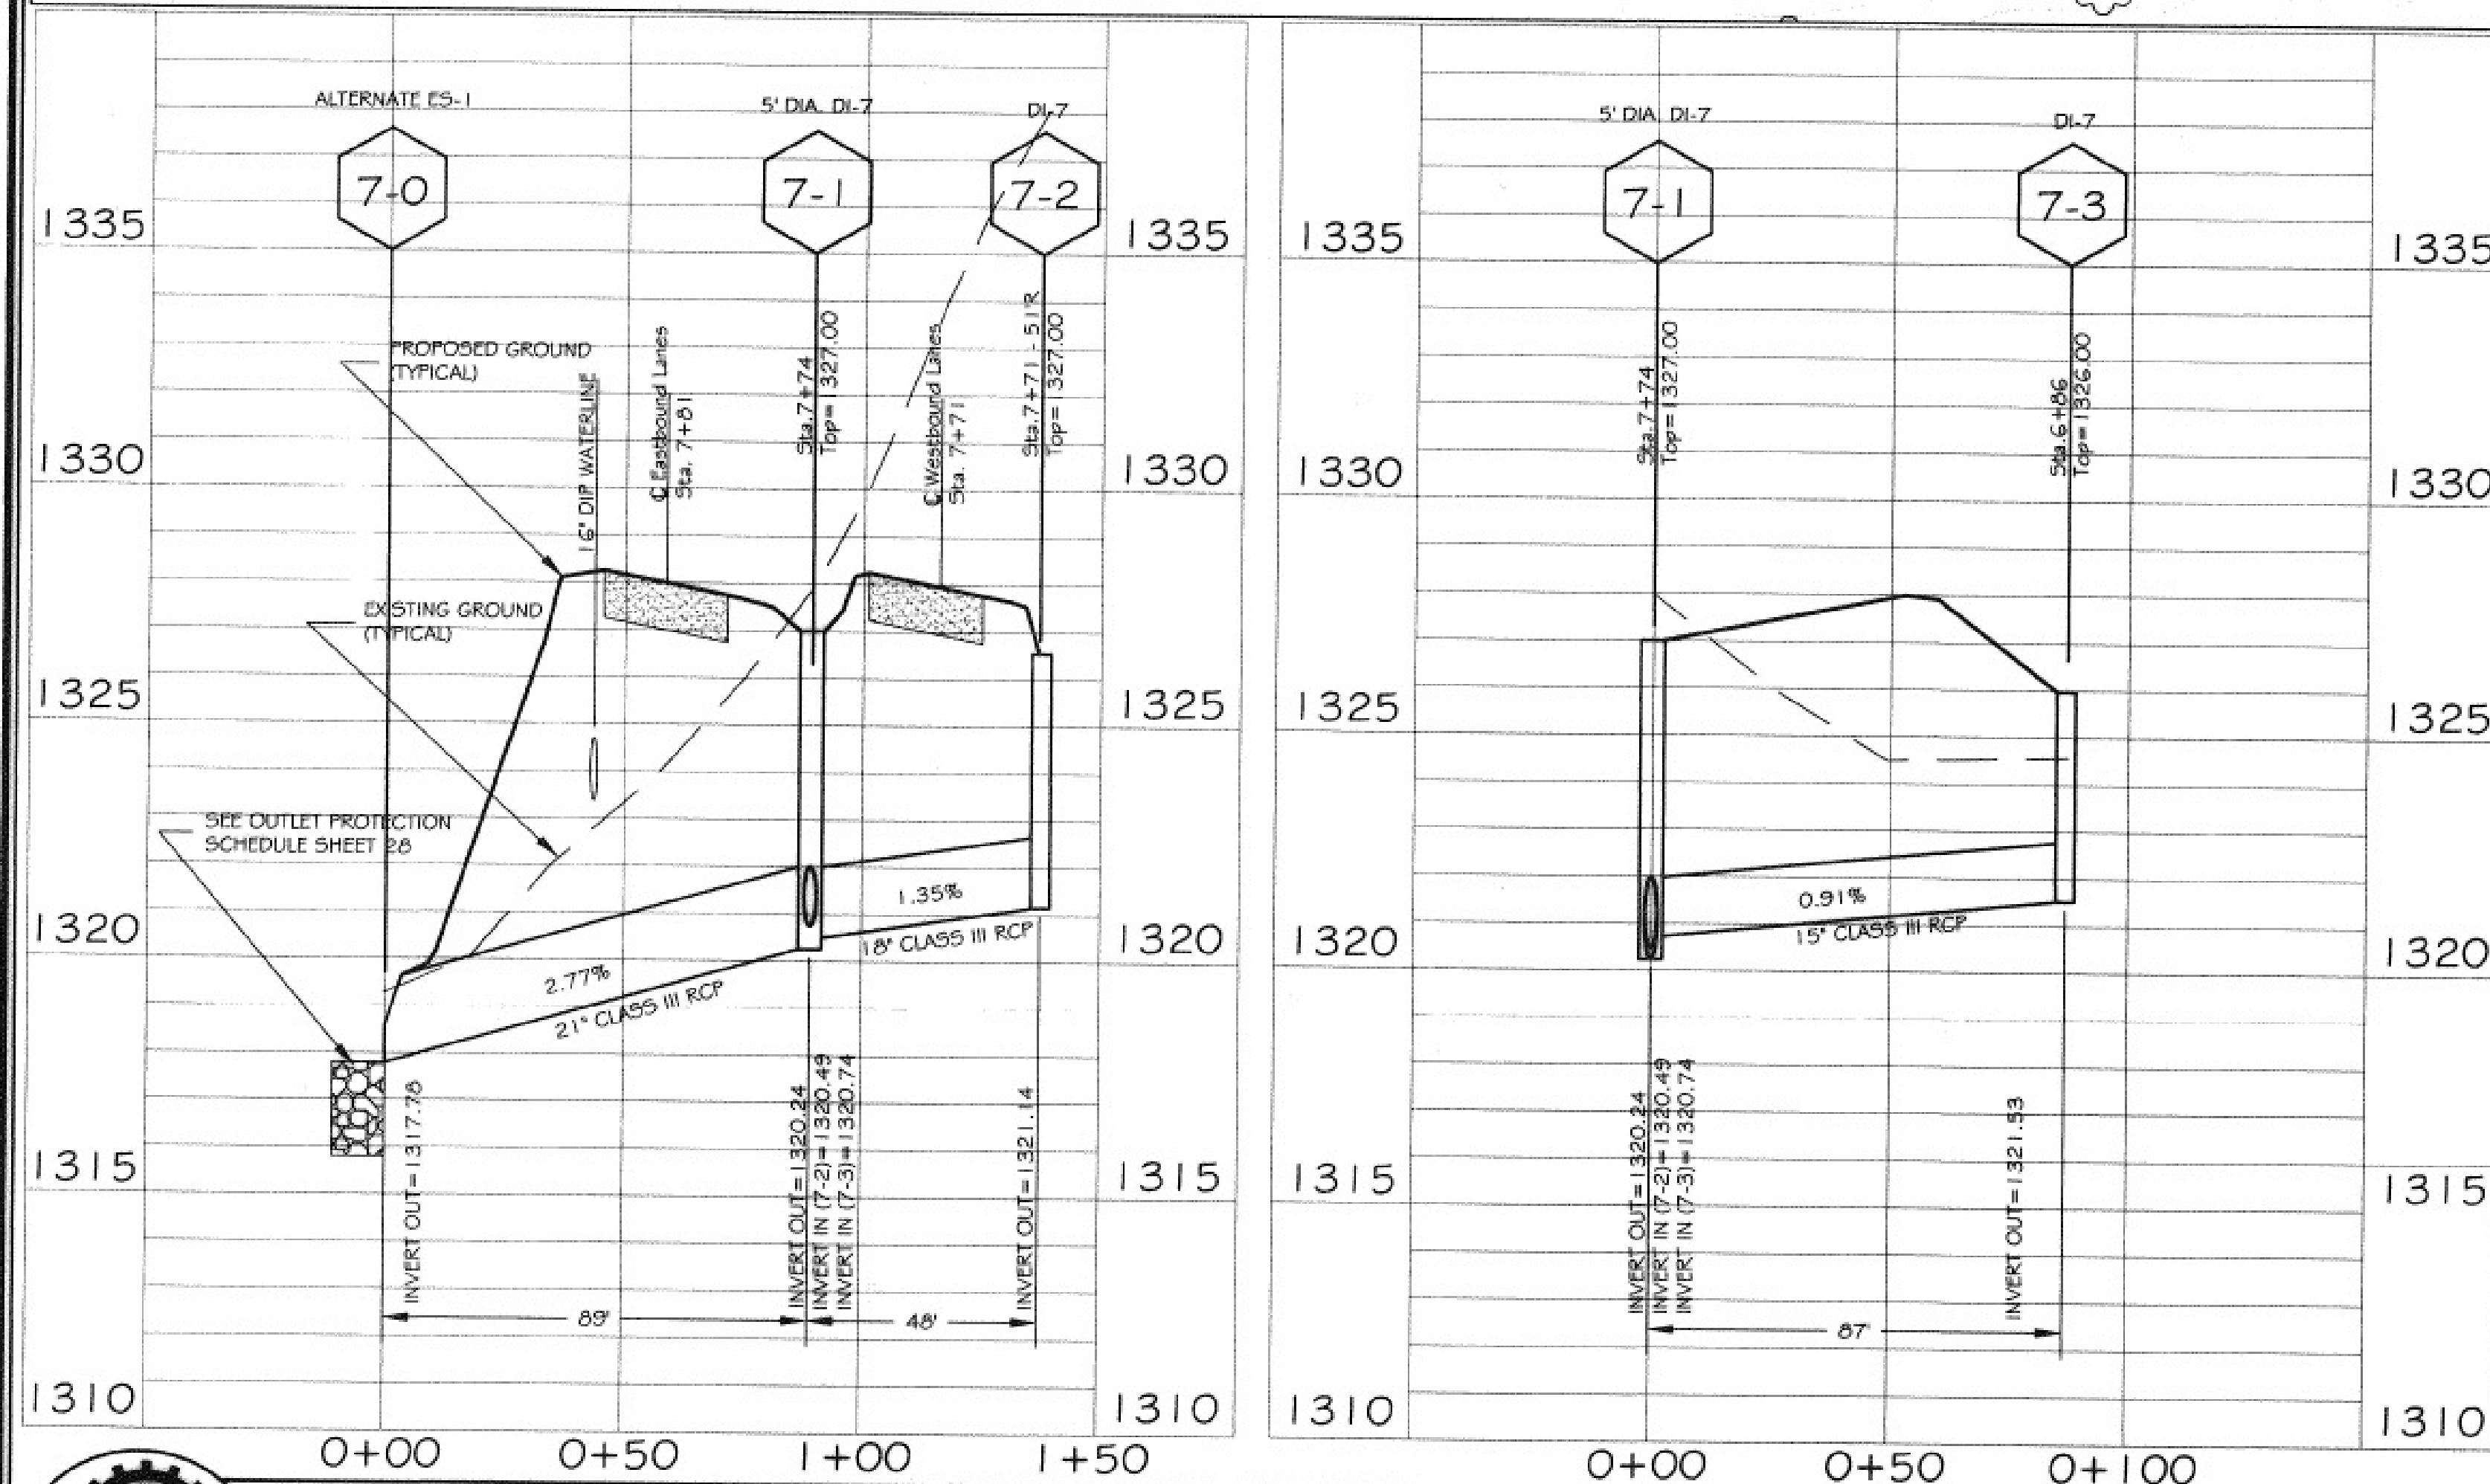

ENGINEERING CONCEPTS, INC.
20 S. ROANOKE ST., PO BOX 619
FINCASTLE, VIRGINIA 24090
540.473.1253 FAX: 540.473.1254

AS-BUILT

Drawn SCG
Designed RHW
Checked WPJ
Approved JST

**GREENFIELD PARKWAY
PHASE 1**
STORM SEWERS PLAN & PROFILE
STA 7+00, 16+00

H:1"=30' V:1"=3'
NOVEMBER 12, 1997
PROJECT: 97042
20 of 34