
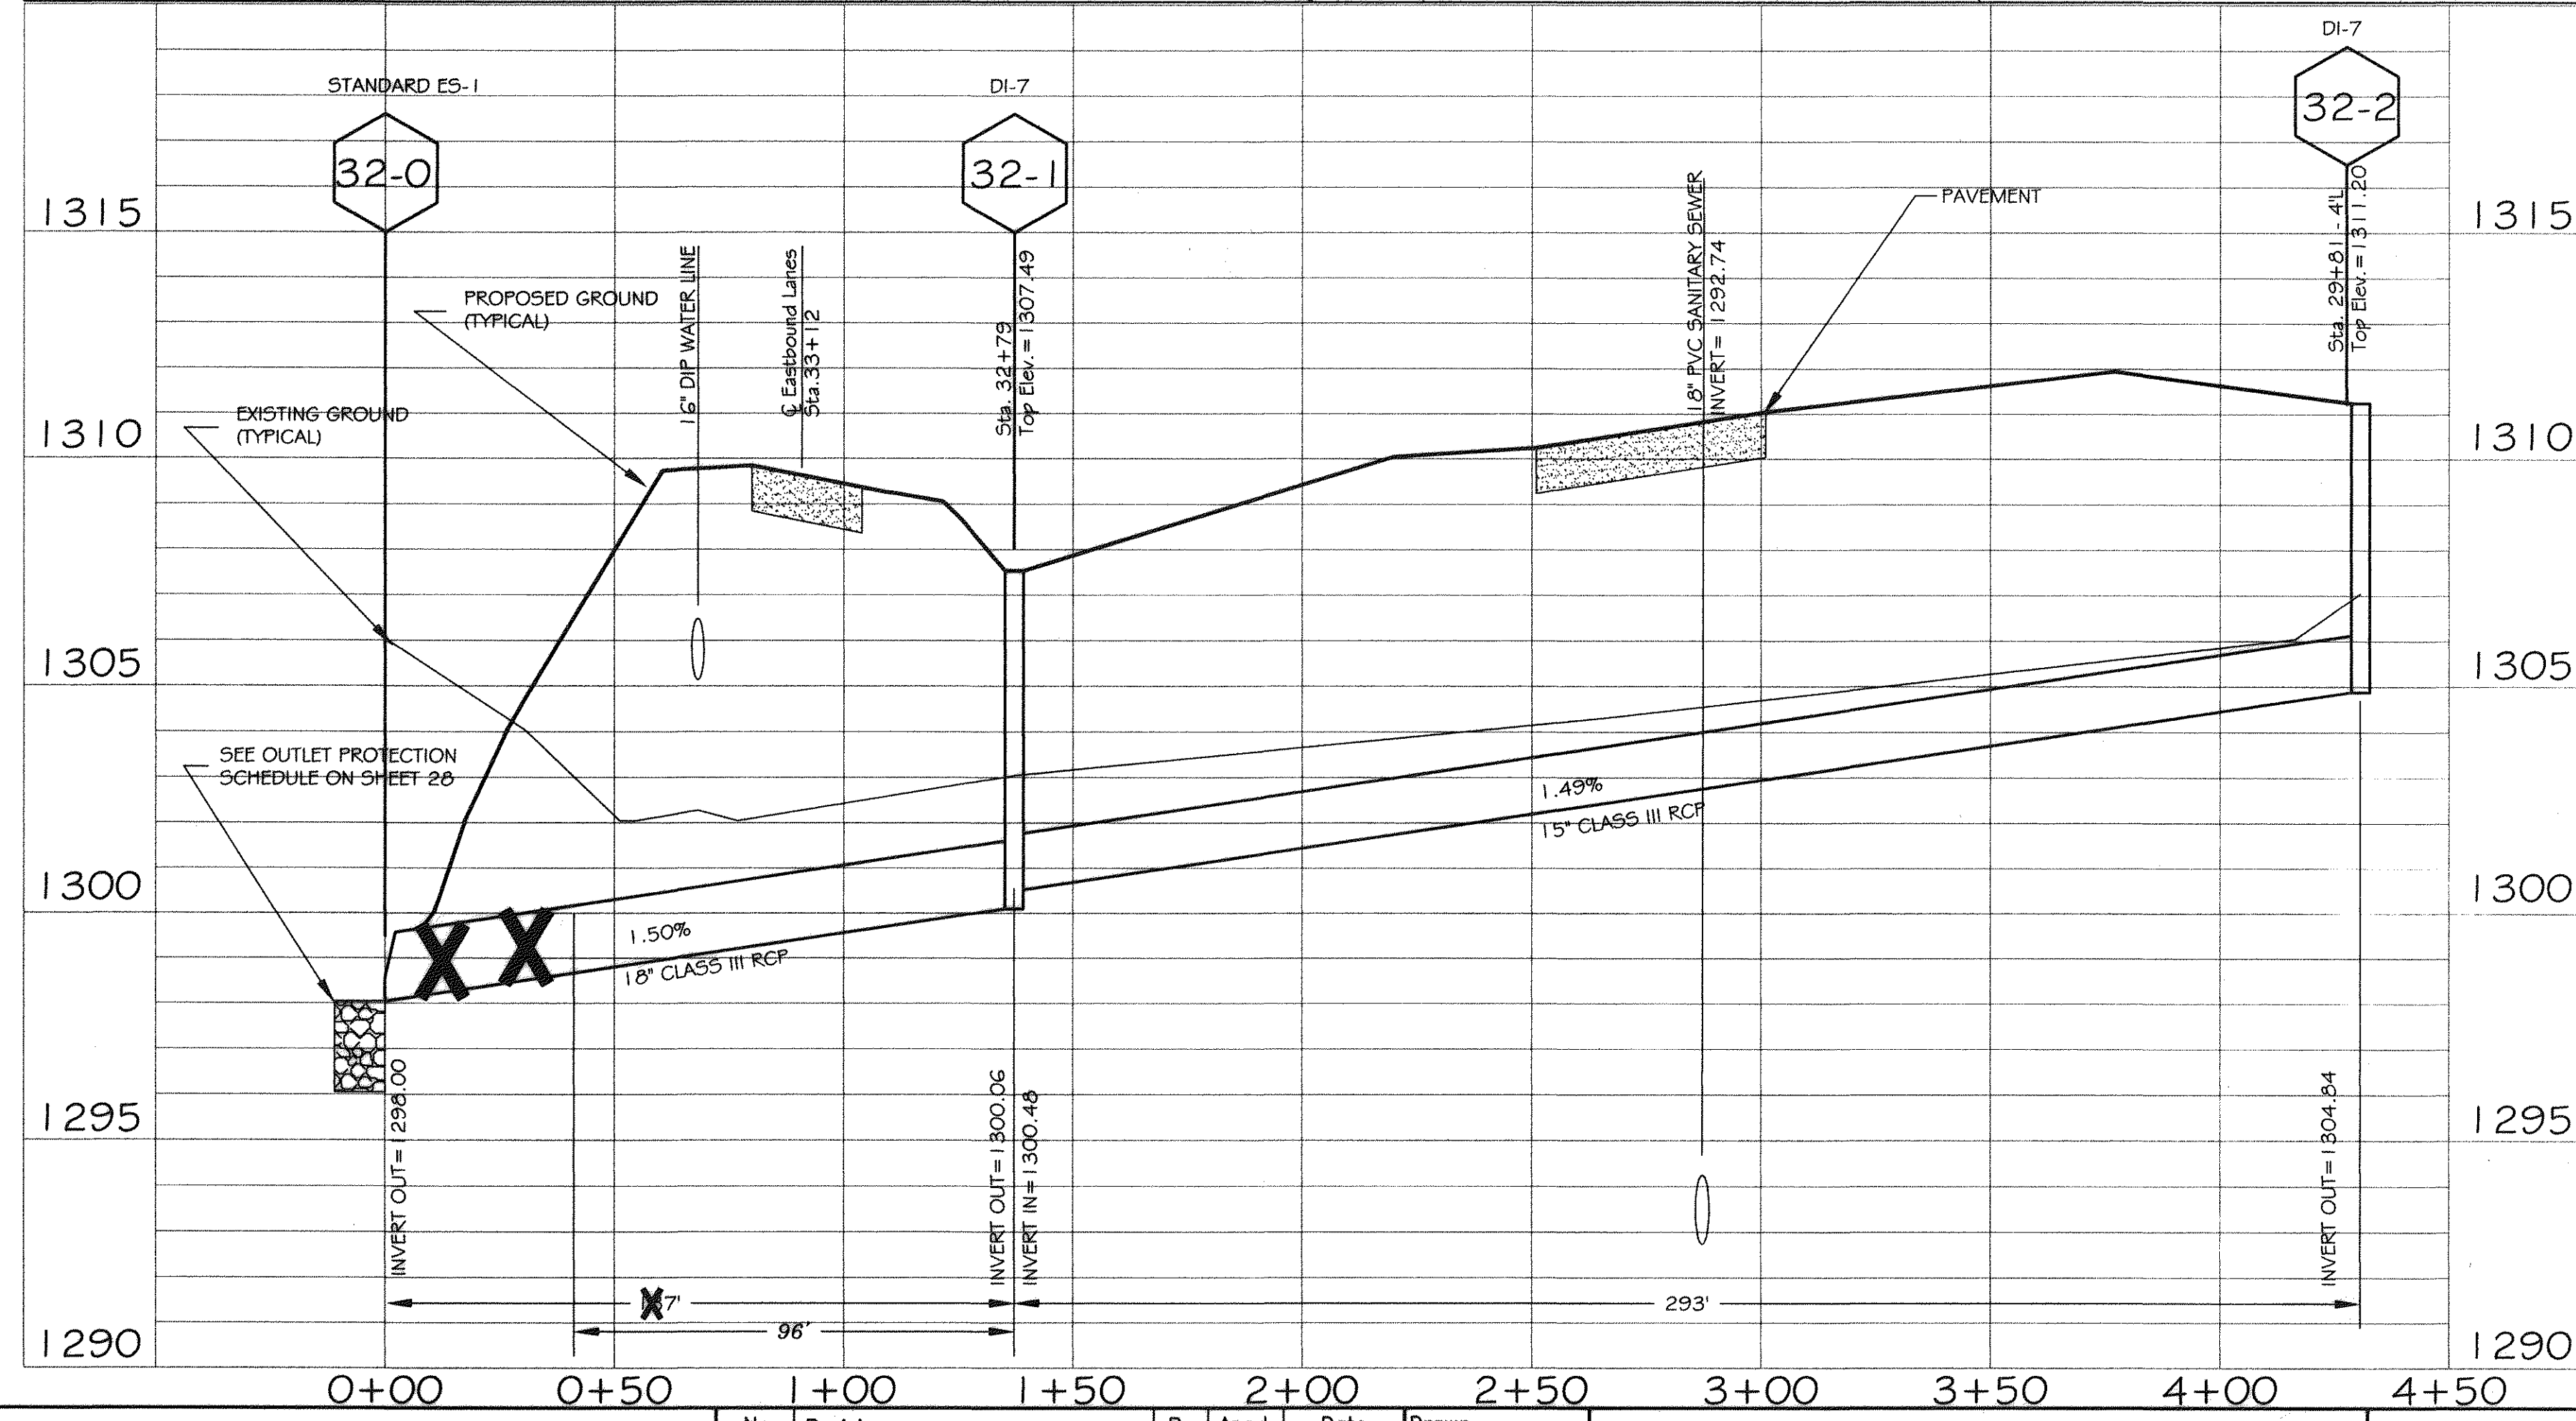
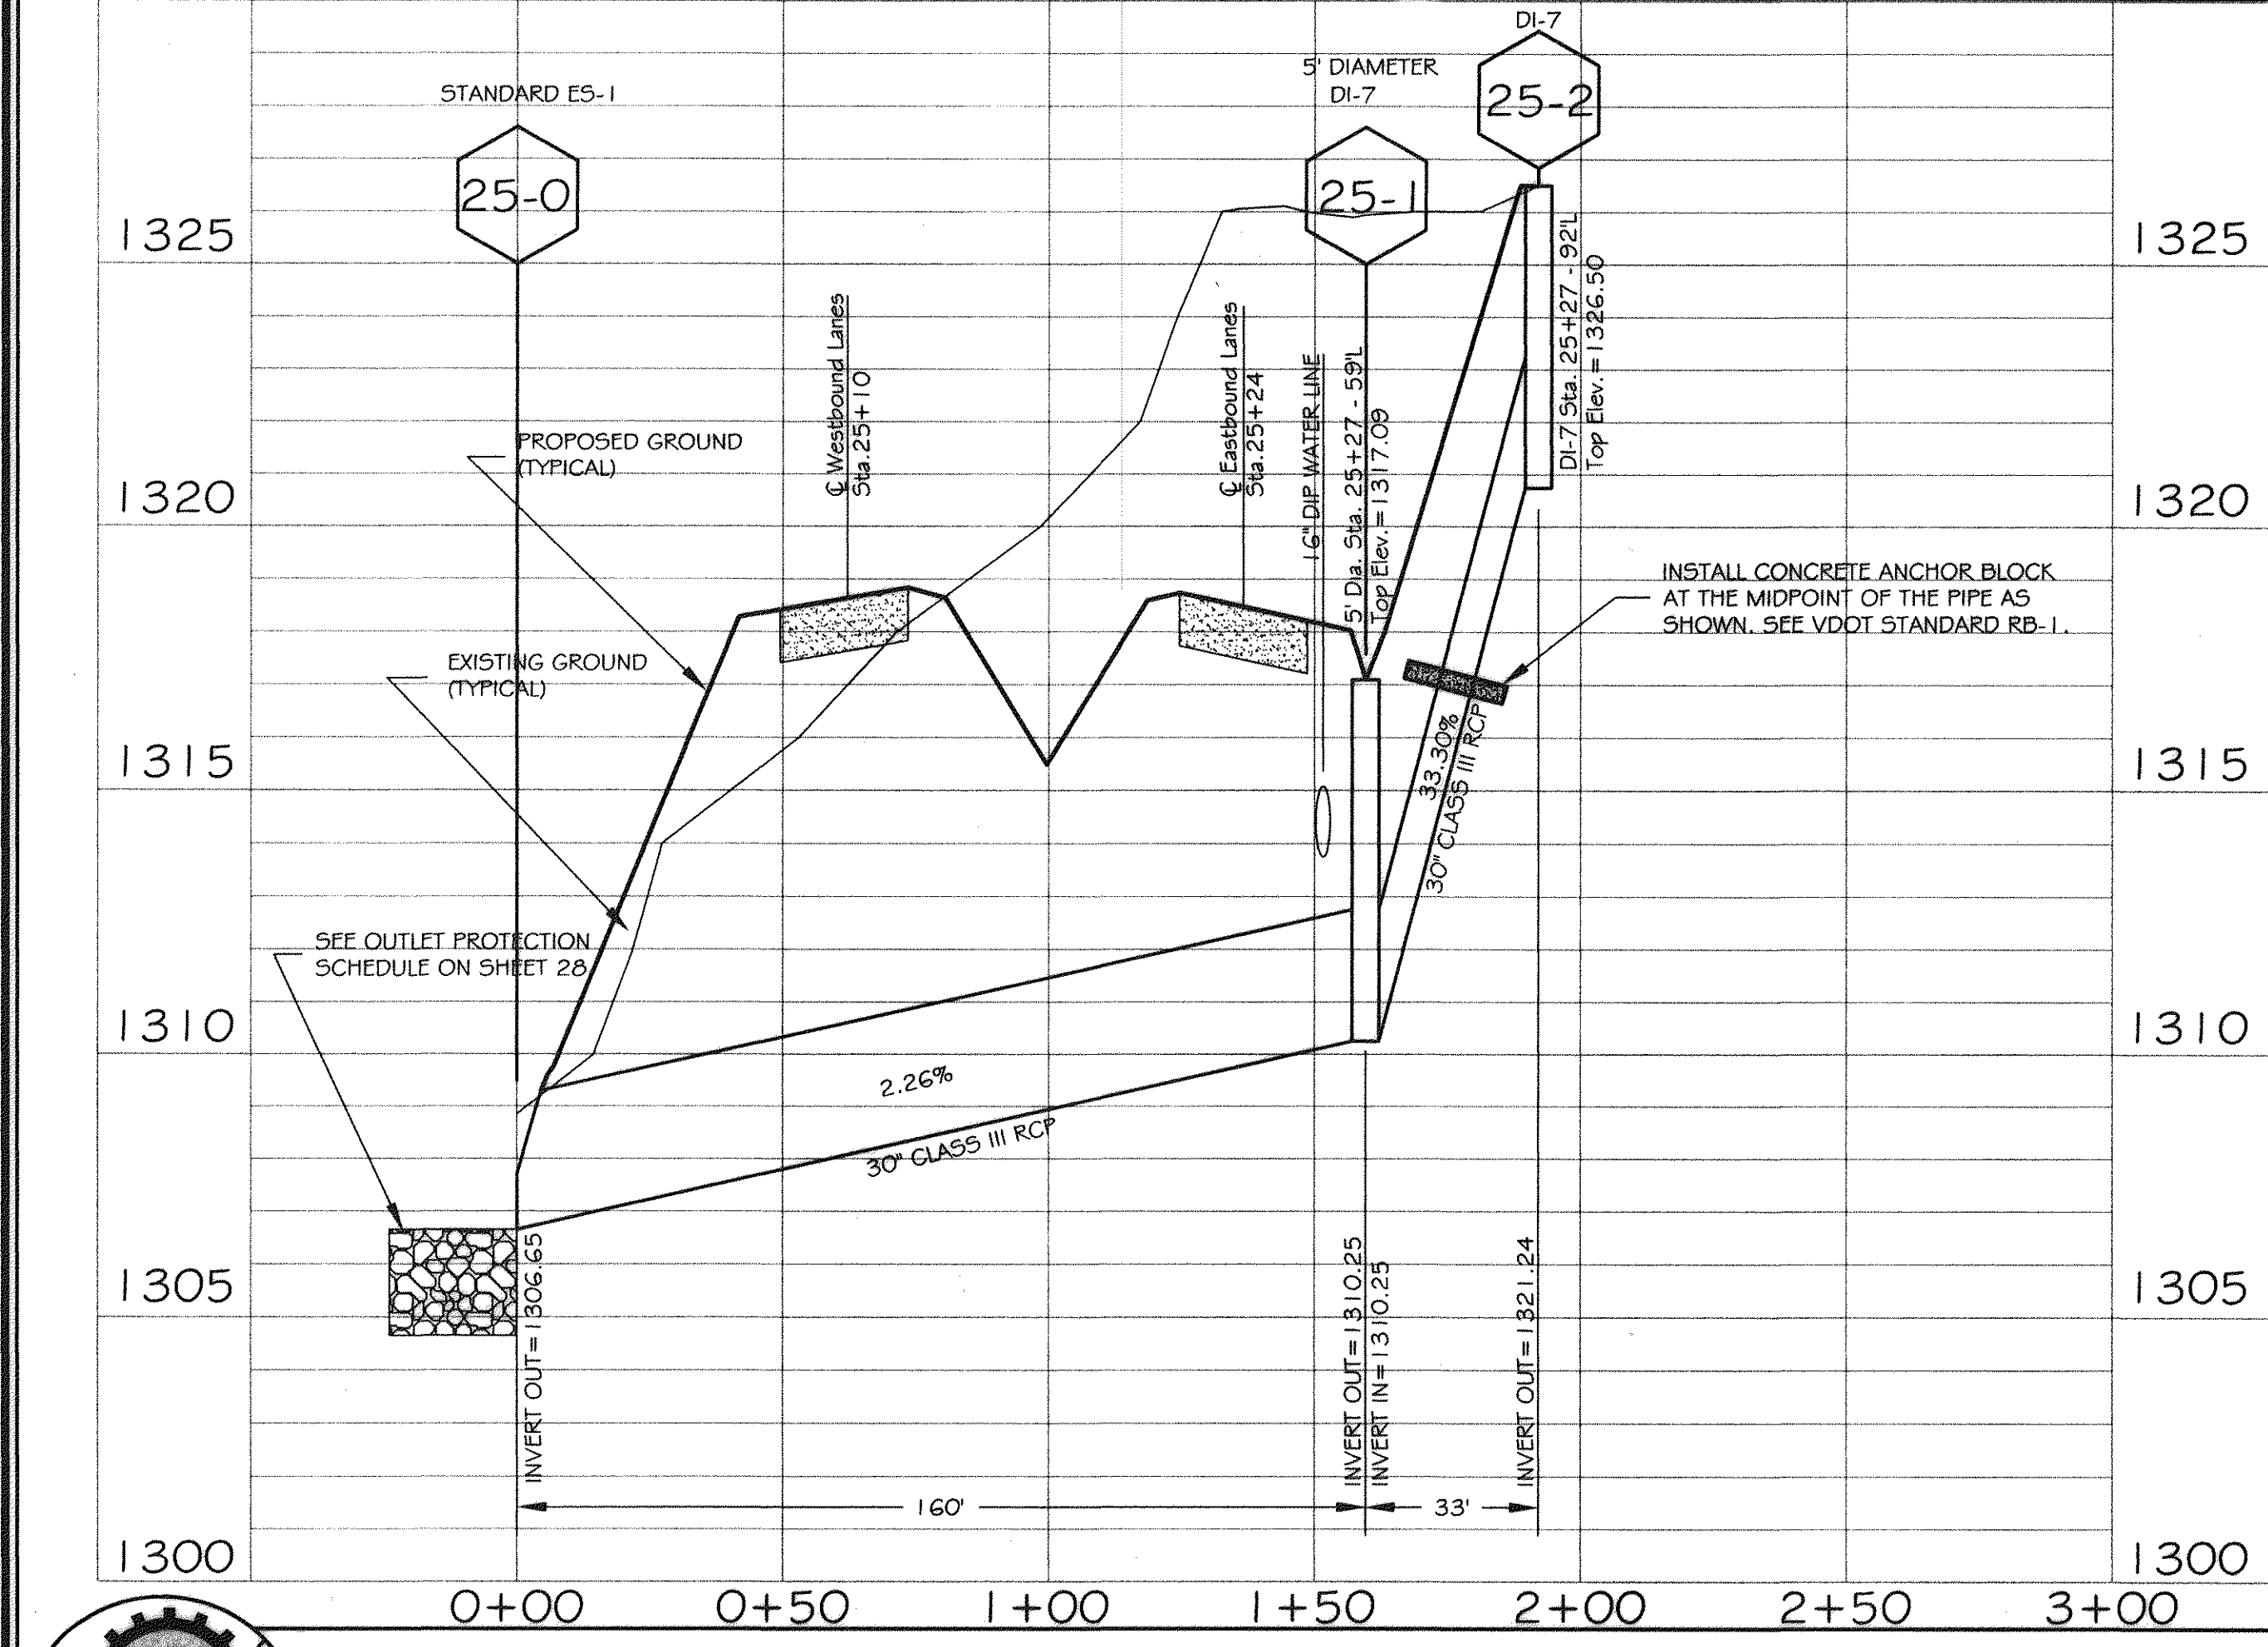
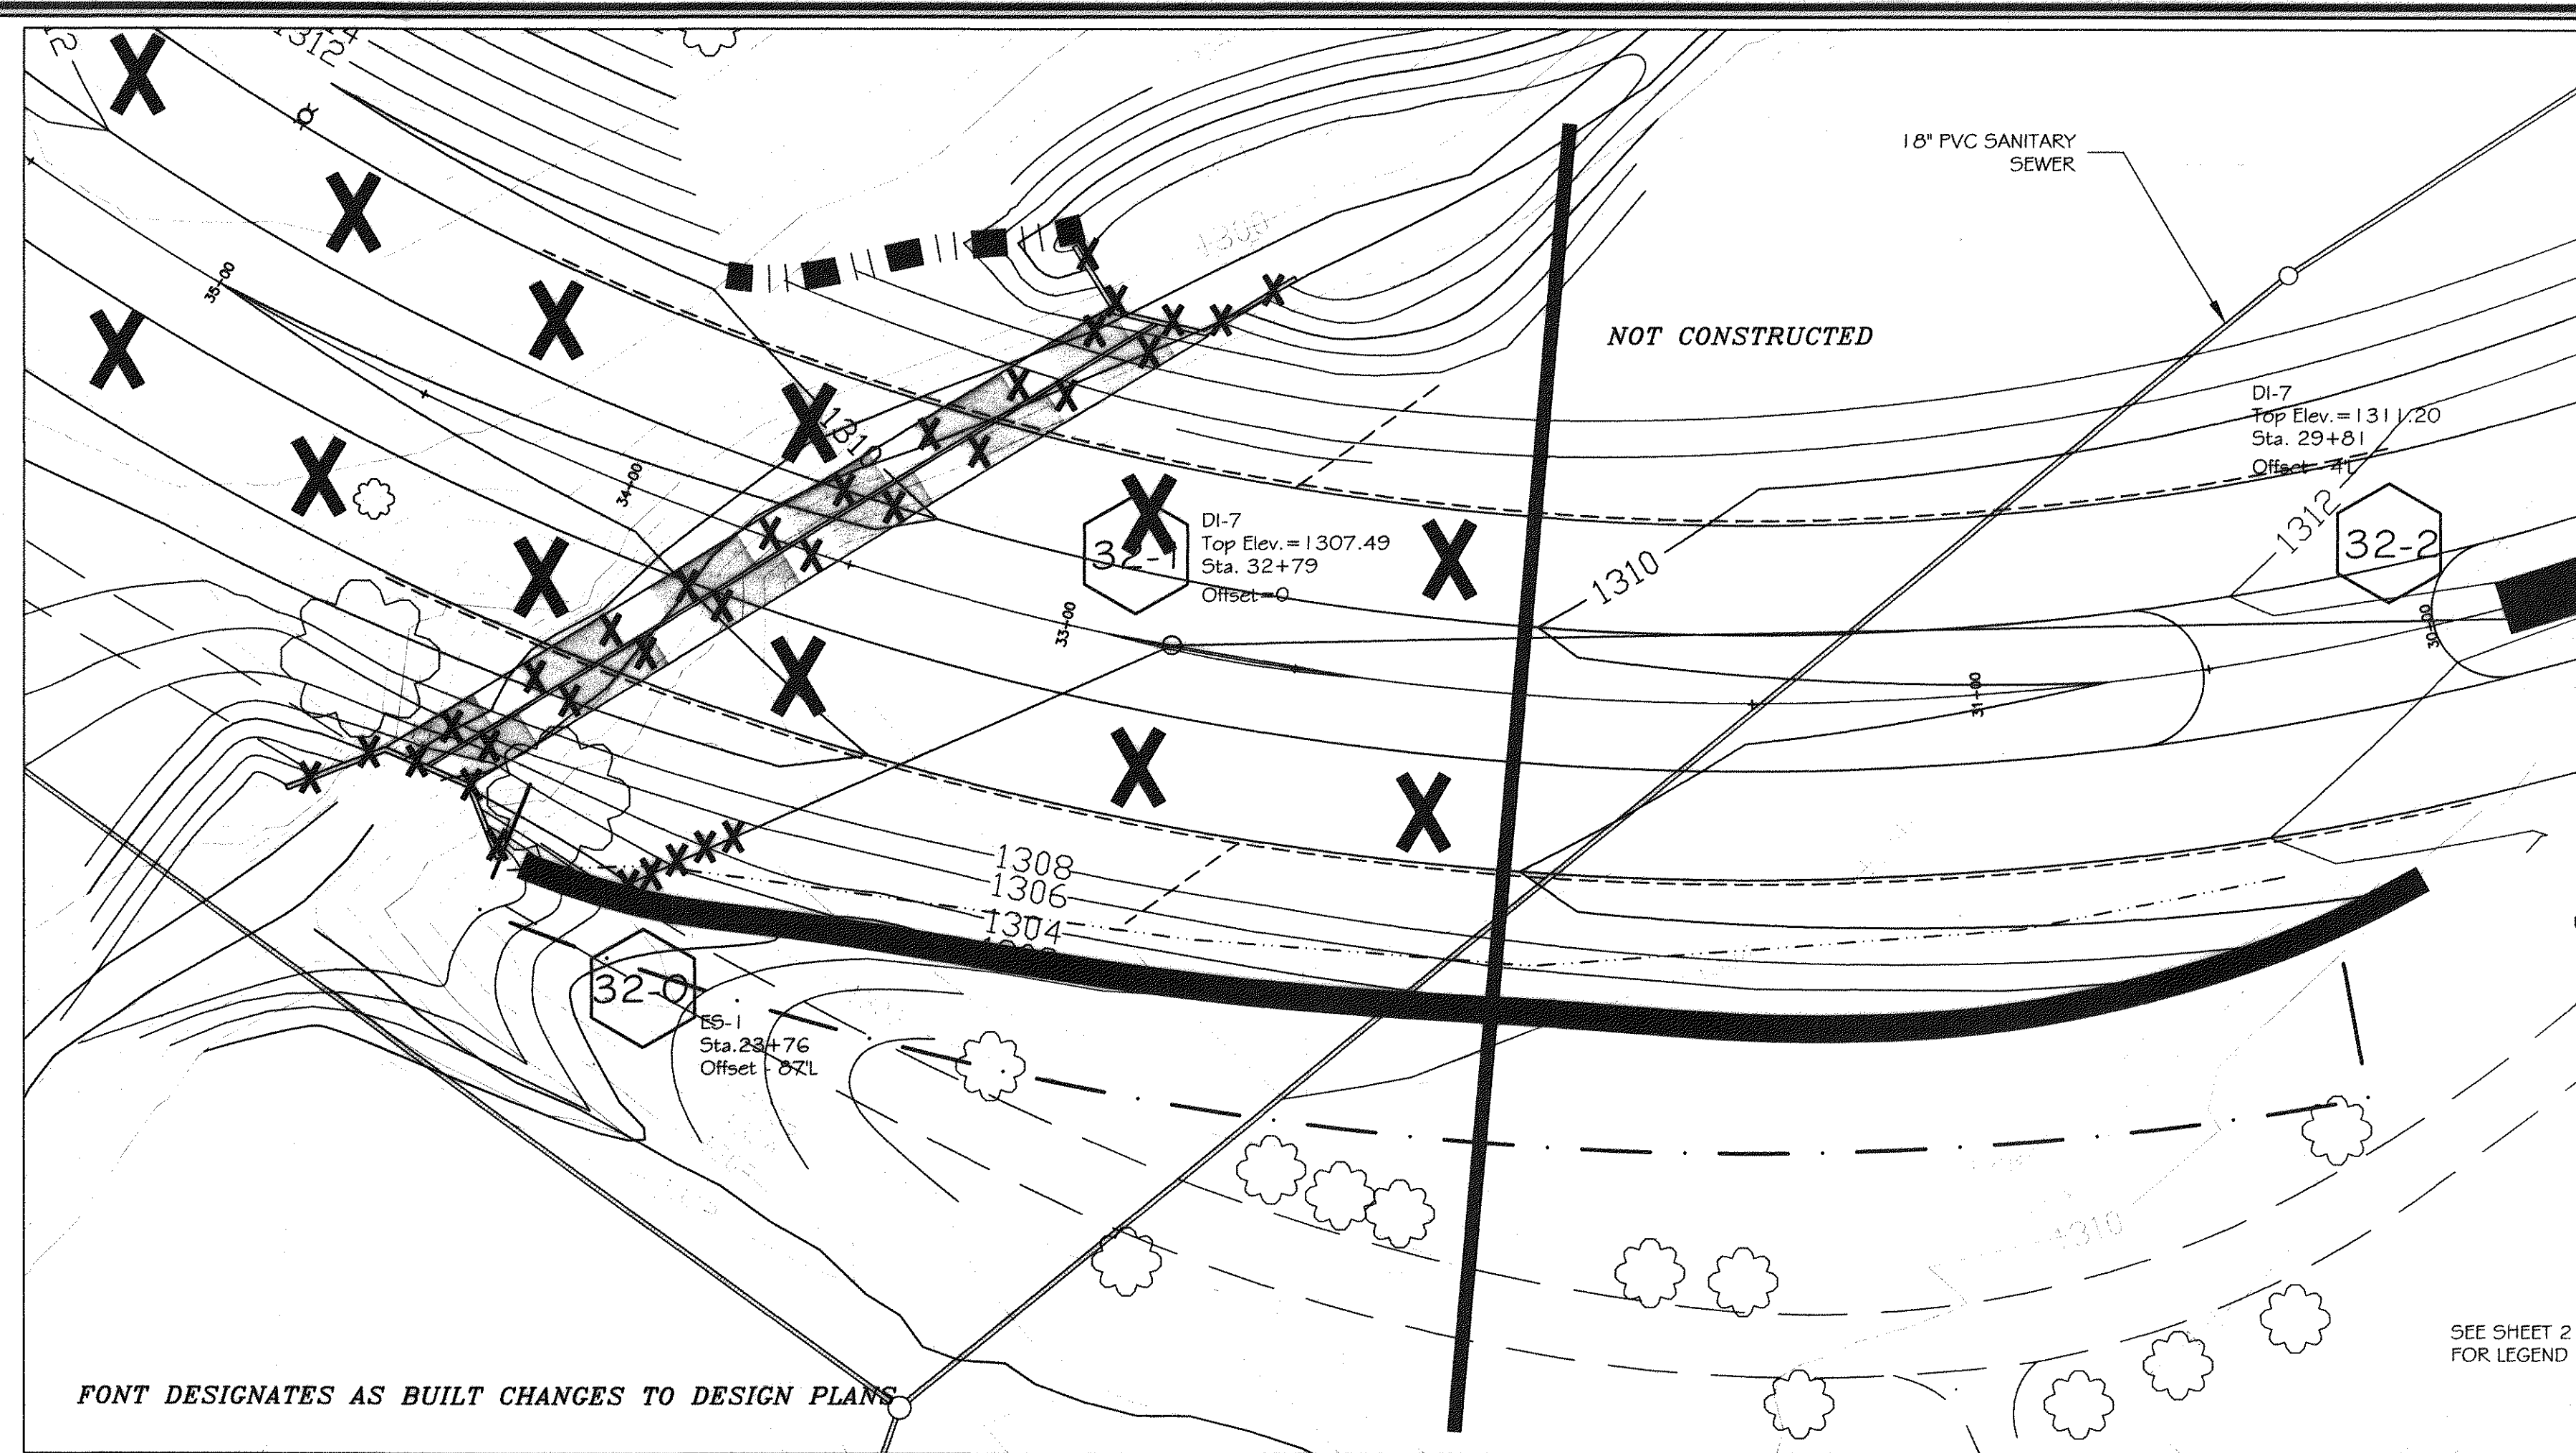


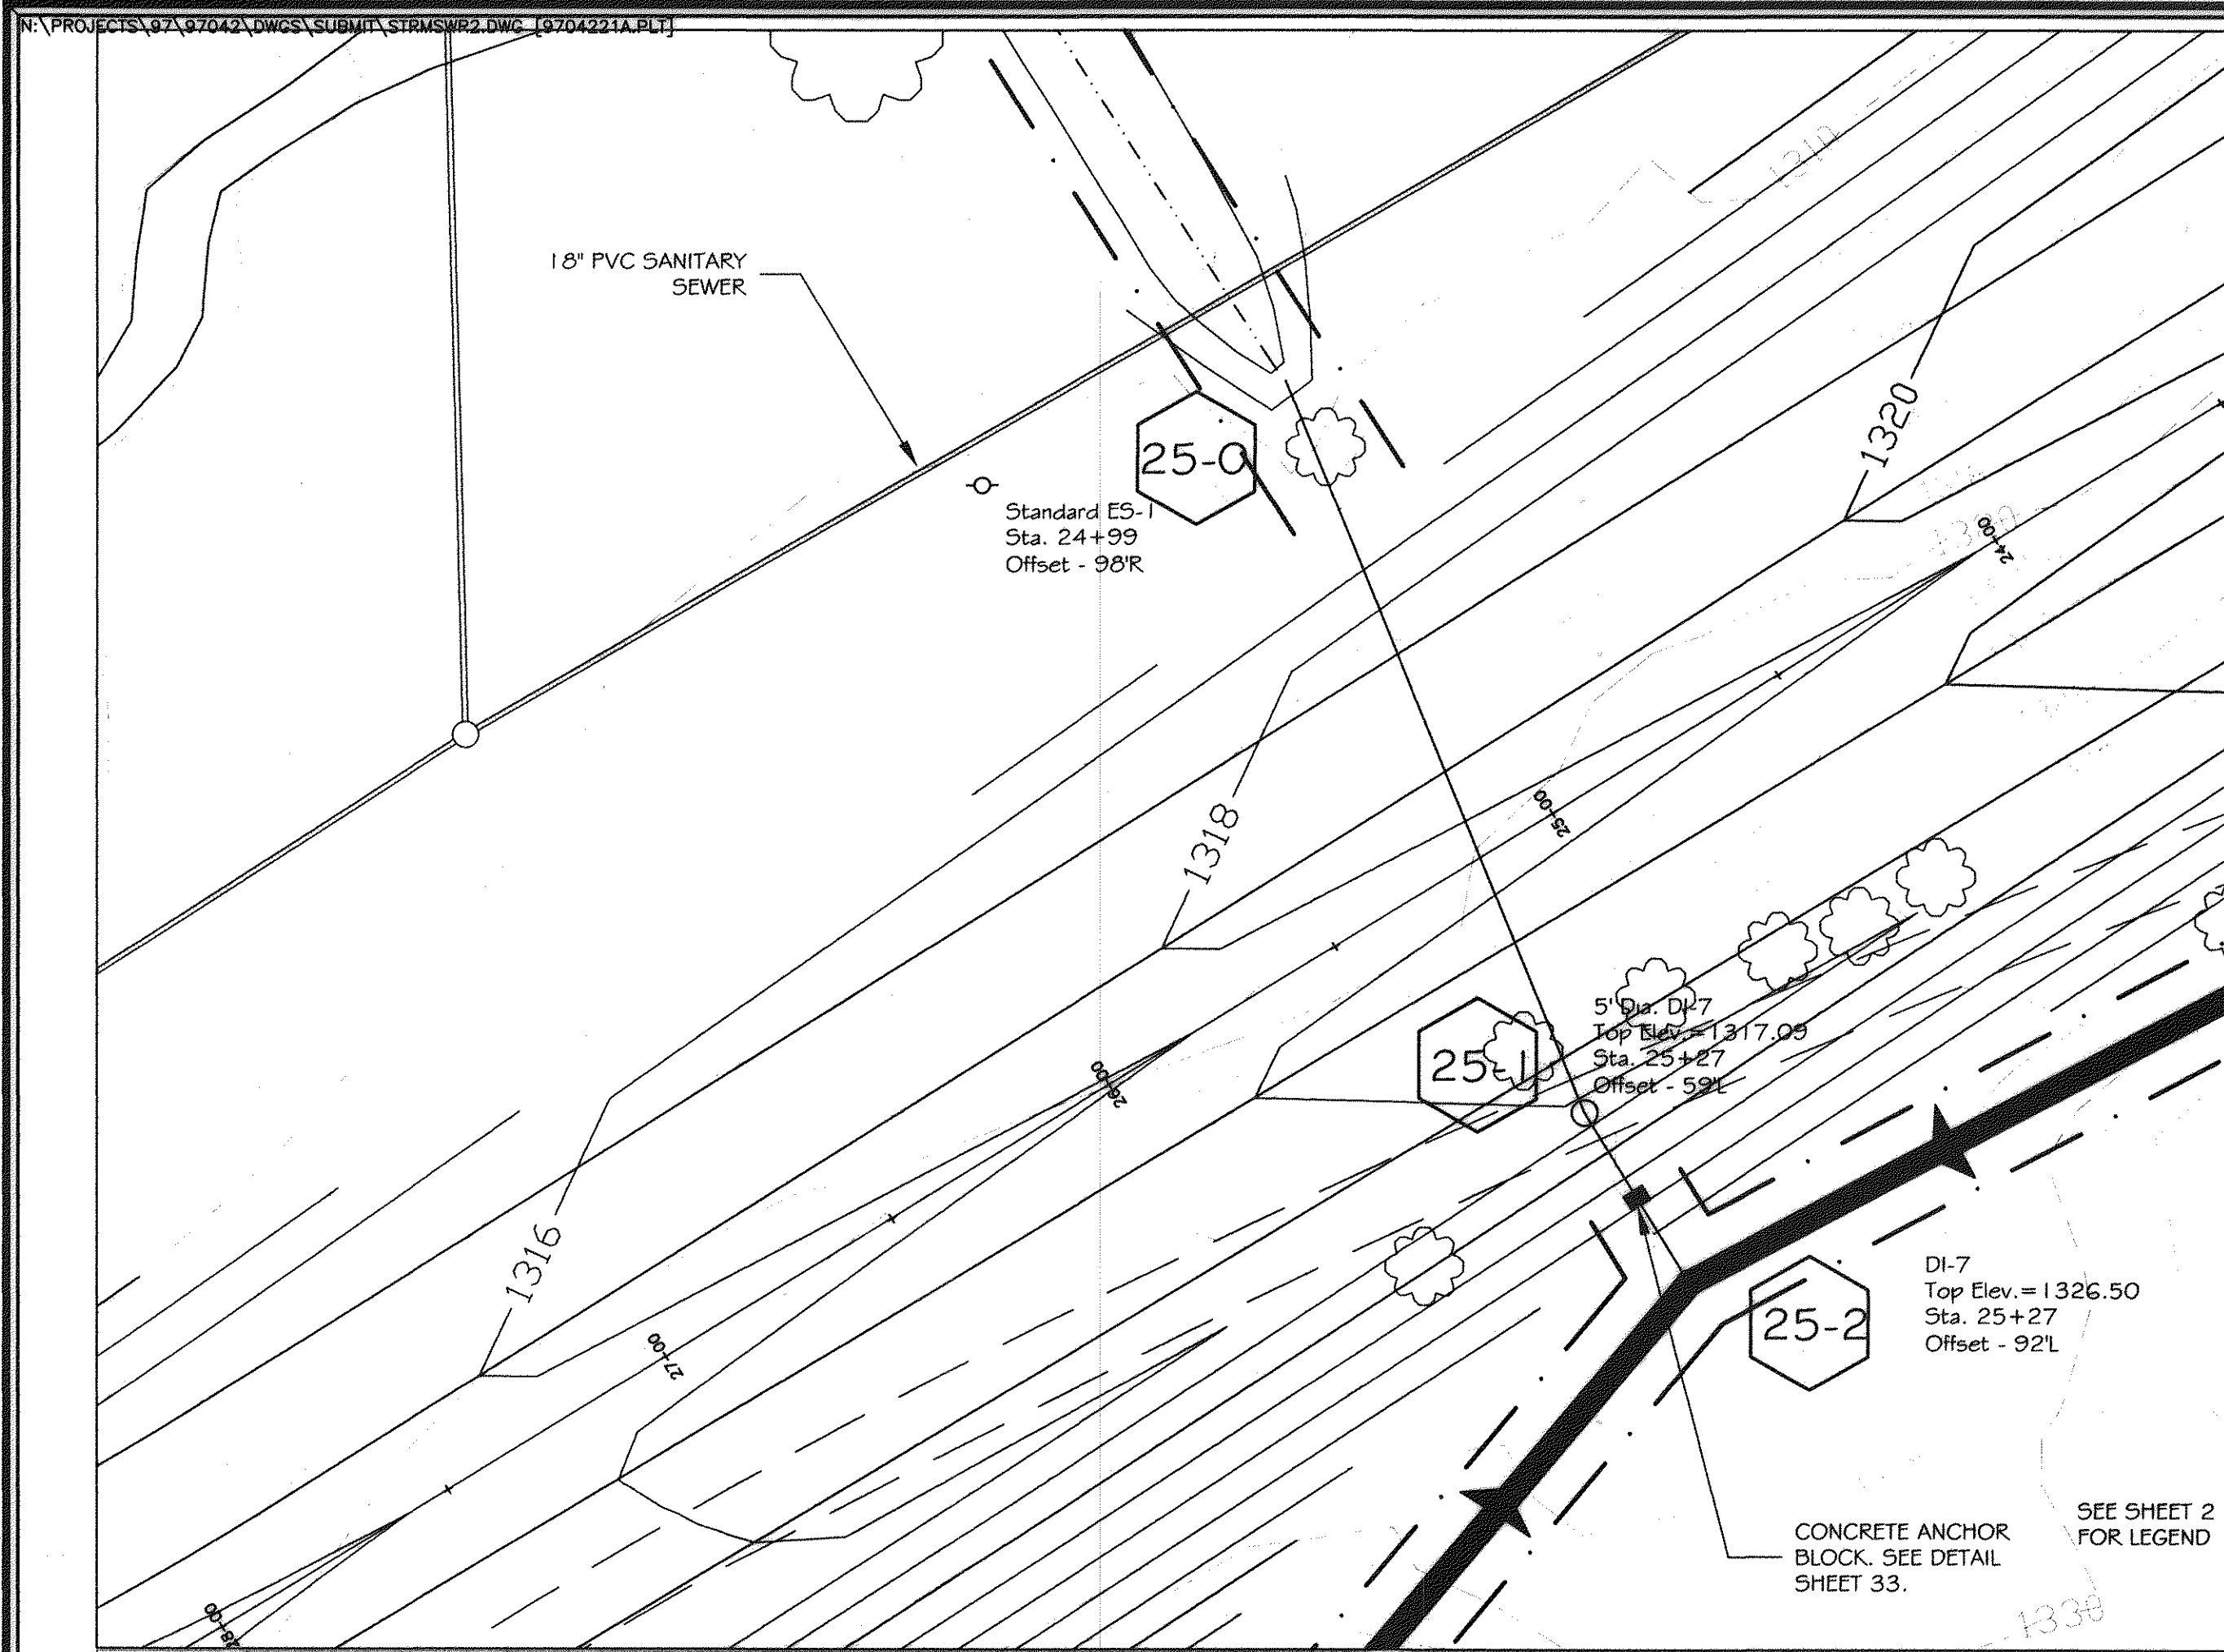

| No. | Revision               | By  | Appd. | Date     | Drawn    |
|-----|------------------------|-----|-------|----------|----------|
| 01  | ANCHOR BLOCK SYSTEM 25 | RHW | JST   | 02/13/98 | SCG/RHW  |
|     |                        |     |       |          | Designed |
|     |                        |     |       |          | SCG/RHW  |
|     |                        |     |       |          | Checked  |
|     |                        |     |       |          | WPJ      |
|     |                        |     |       |          | Approved |
|     |                        |     |       |          | JST      |