




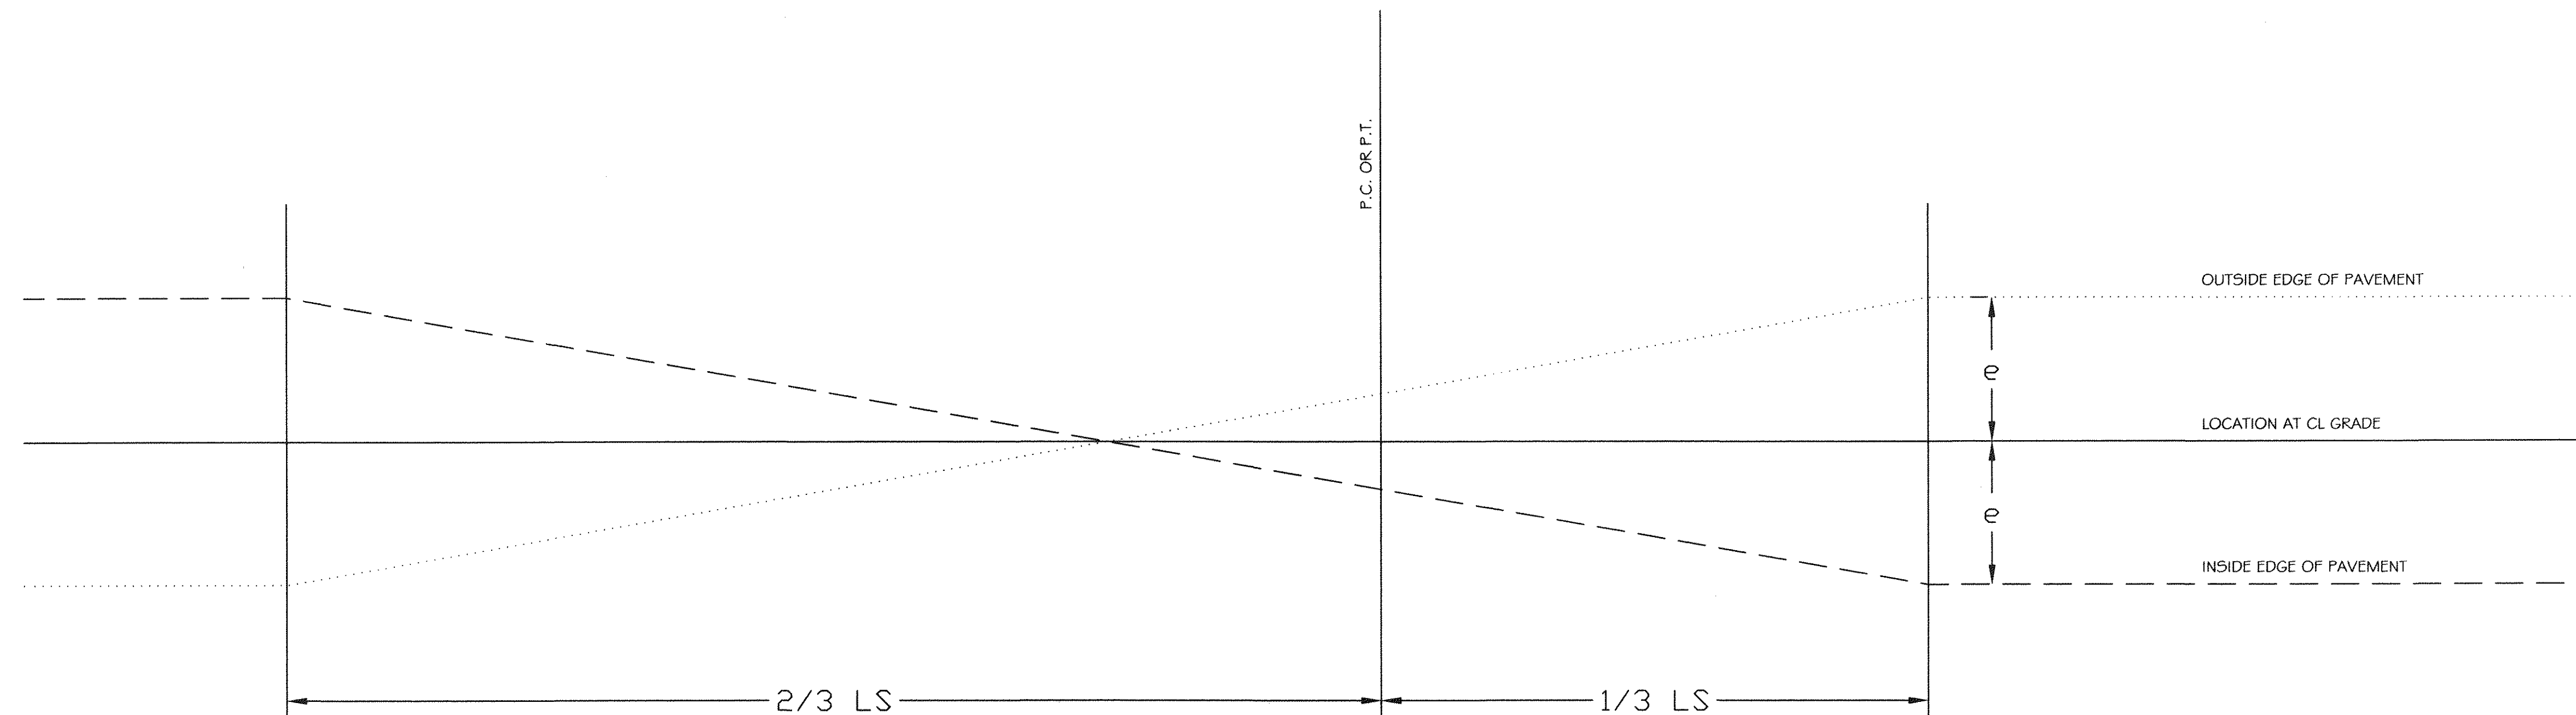

SUPERELEVATED BY AN AMOUNT EQUAL TO THE STANDARD PAVEMENT CROWN

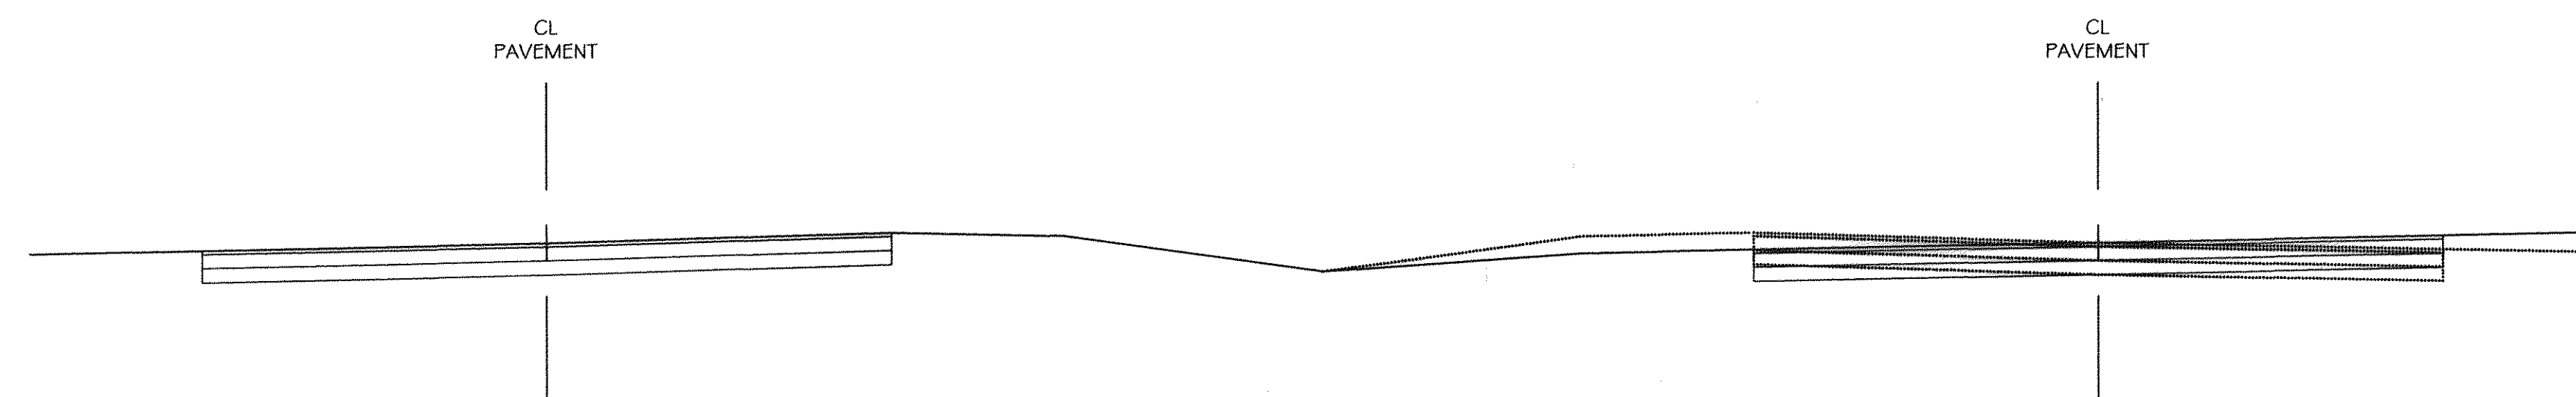

SUPERELEVATED ABOUT CENTERLINE OF PAVEMENT ON EACH SIDE

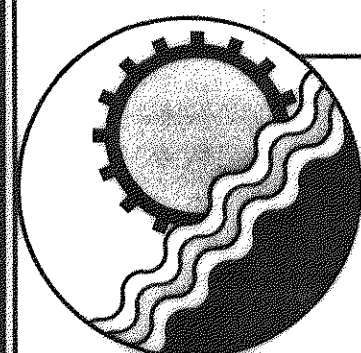

ENGINEERING CONCEPTS, INC.

20 S. ROANOKE ST., PO BOX 619
FINCASTLE, VIRGINIA 24090
540.473.1253 FAX: 540.473.1254

AS-BUILT

Drawn	RHW
Designed	RHW
Checked	WPJ
Approved	JST

GREENFIELD PARKWAY PHASE 1
TRANSITION AND SUPERELEVATION DETAIL

NOT TO SCALE
NOVEMBER 12, 1997
PROJECT: 97042
34 of 34