

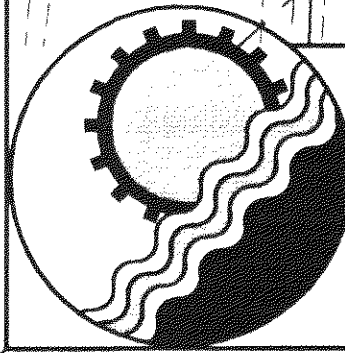
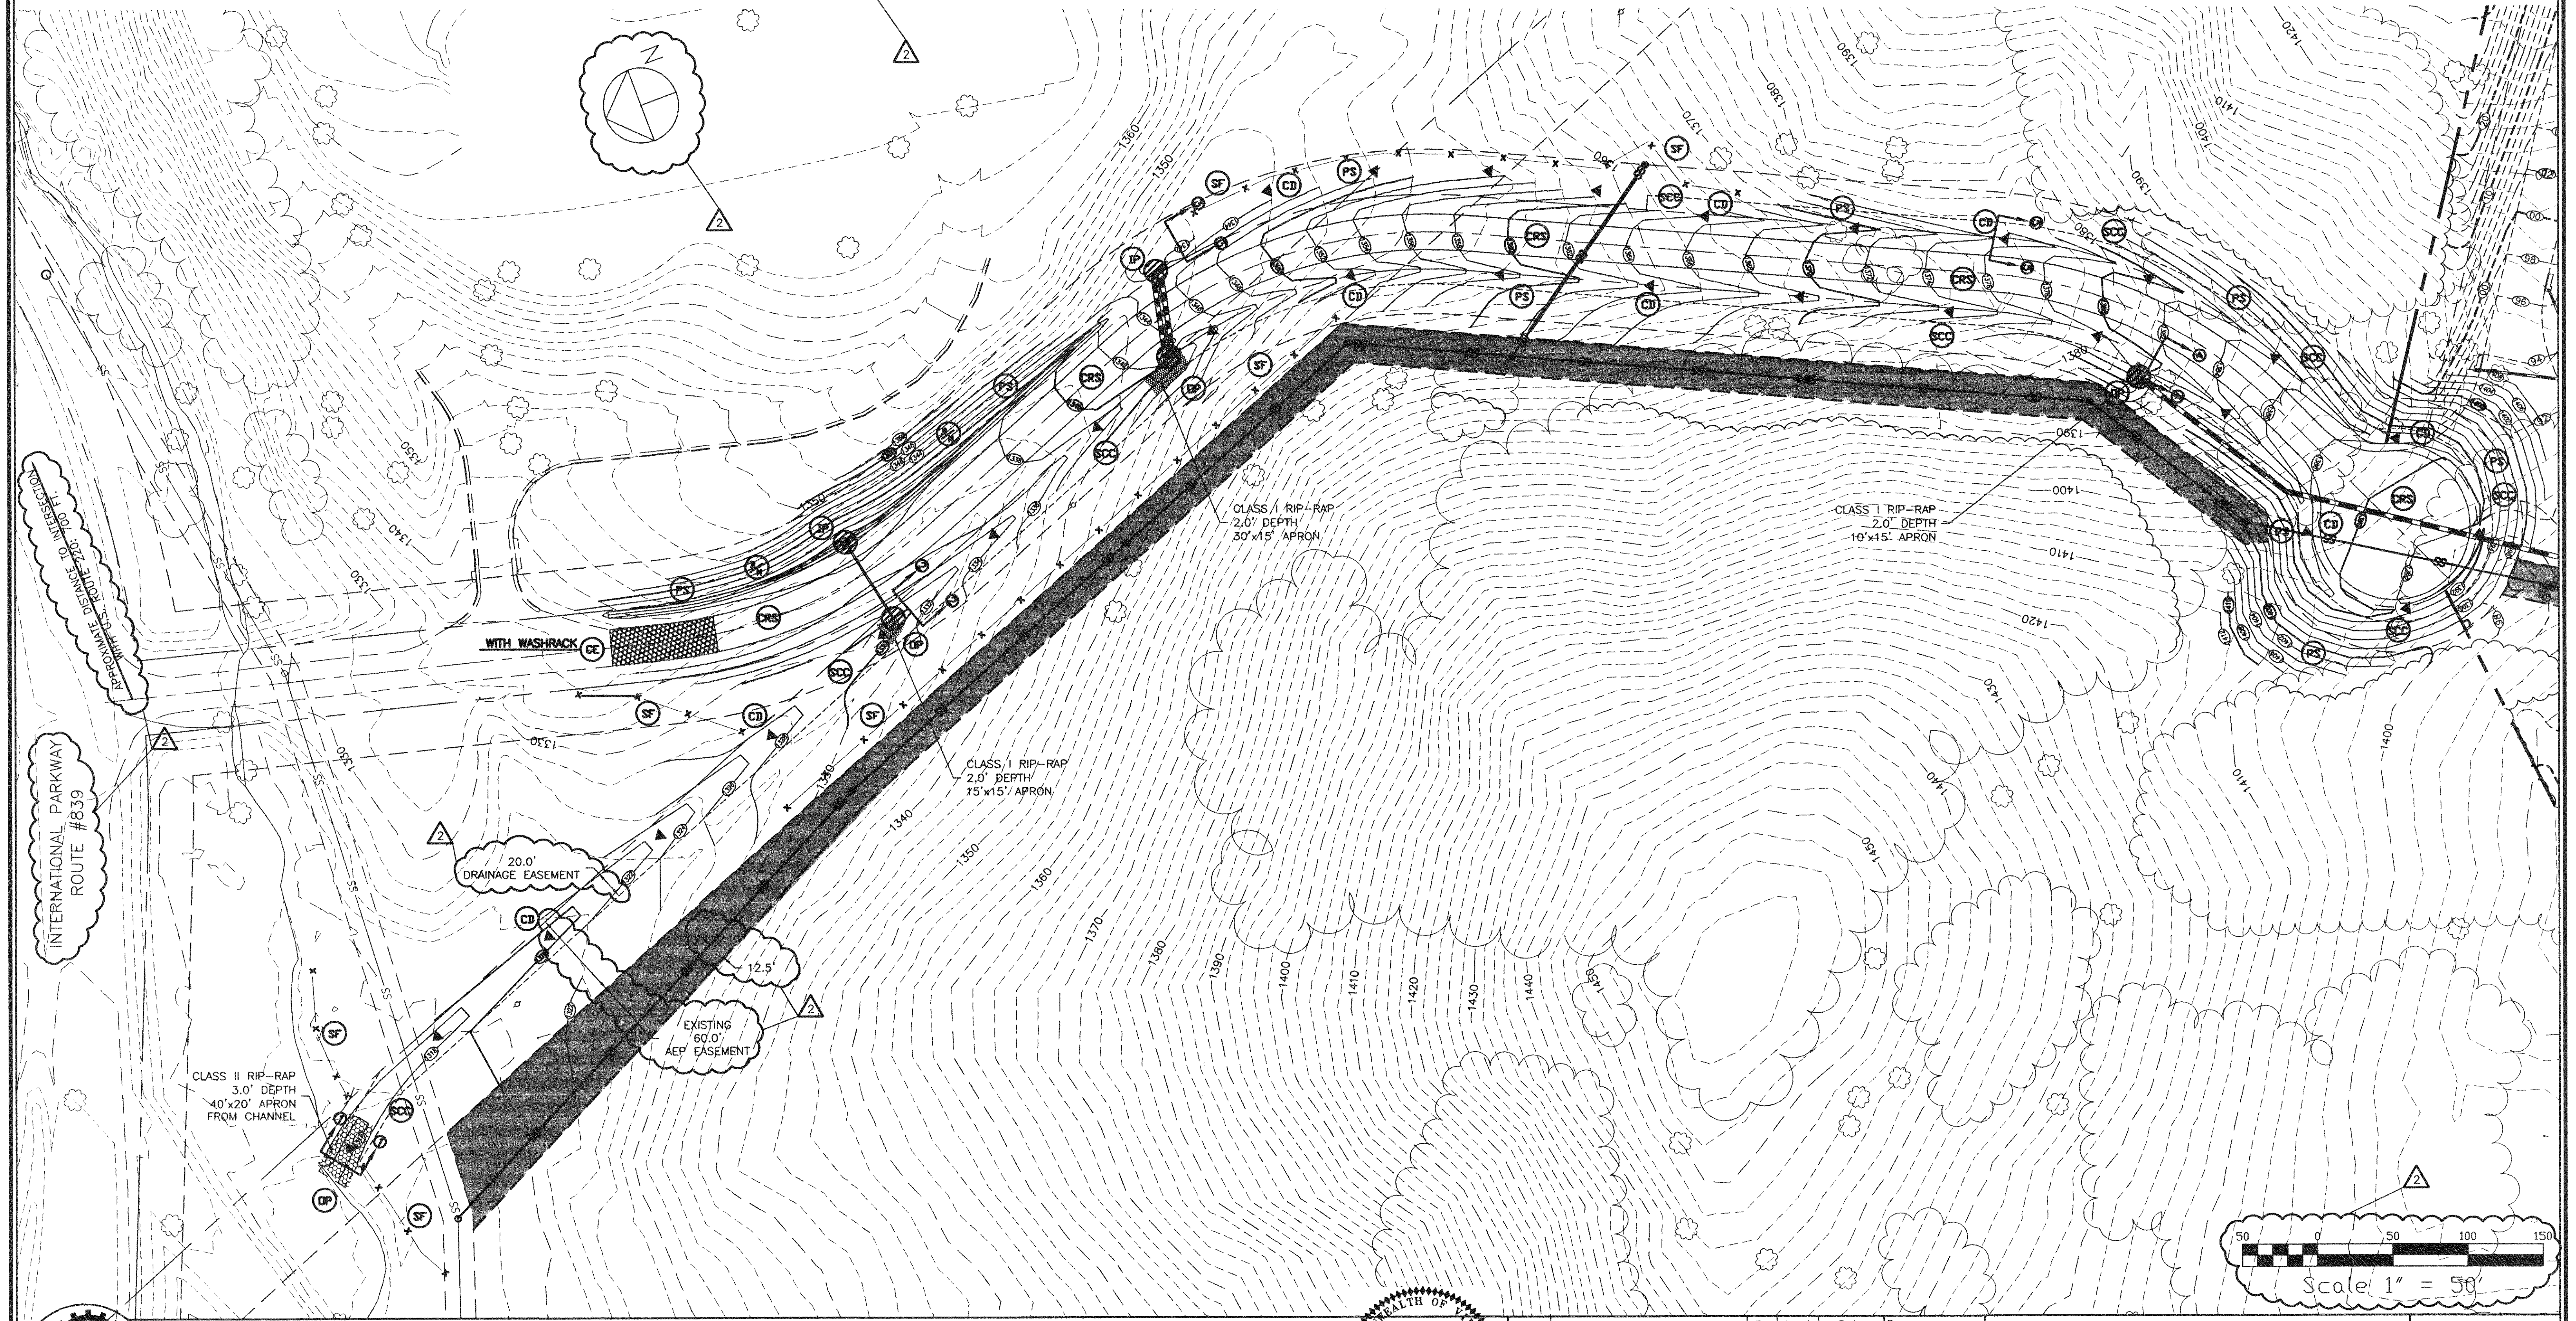


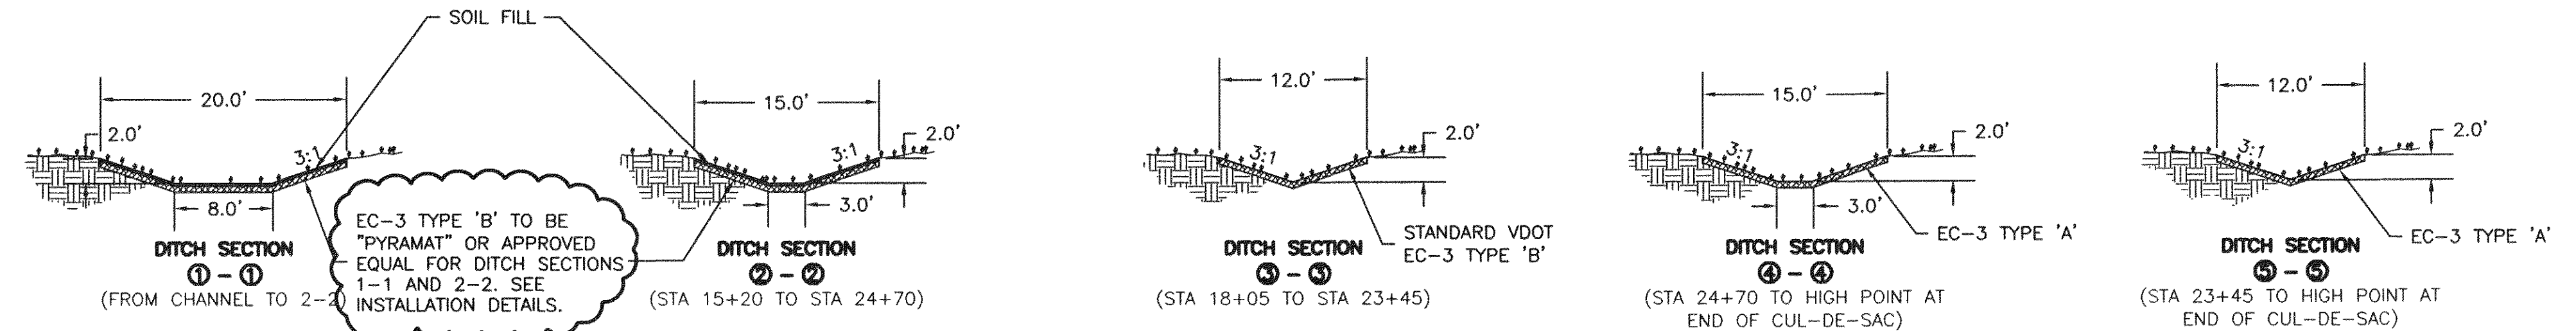

ENGINEERING CONCEPTS, INC.
 20 S. ROANOKE ST., PO BOX 619
 FINCASTLE, VIRGINIA 24090
 540.473.1253 FAX: 540.473.1254

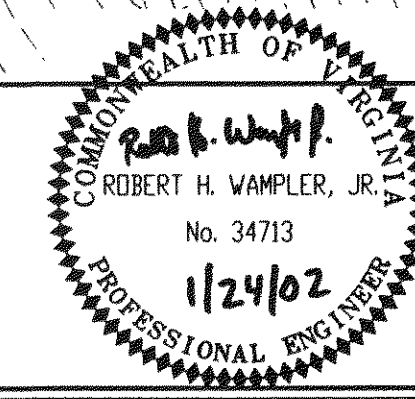

No.	Revision	By	Appd.	Date	Drawn	WTR
2	VDOT REVIEW COMMENTS	WTR	RHW	06/01/01	Designed	RHW
					Checked	
					Approved	

**SOUTH CENTER DRIVE
 AND SANITARY SEWER EXTENSION**
**EROSION & SEDIMENT
 CONTROL PLAN**

SCALE: 1"=50'
 FEBRUARY 2001
 PROJECT: 00144
 C3 of C10