
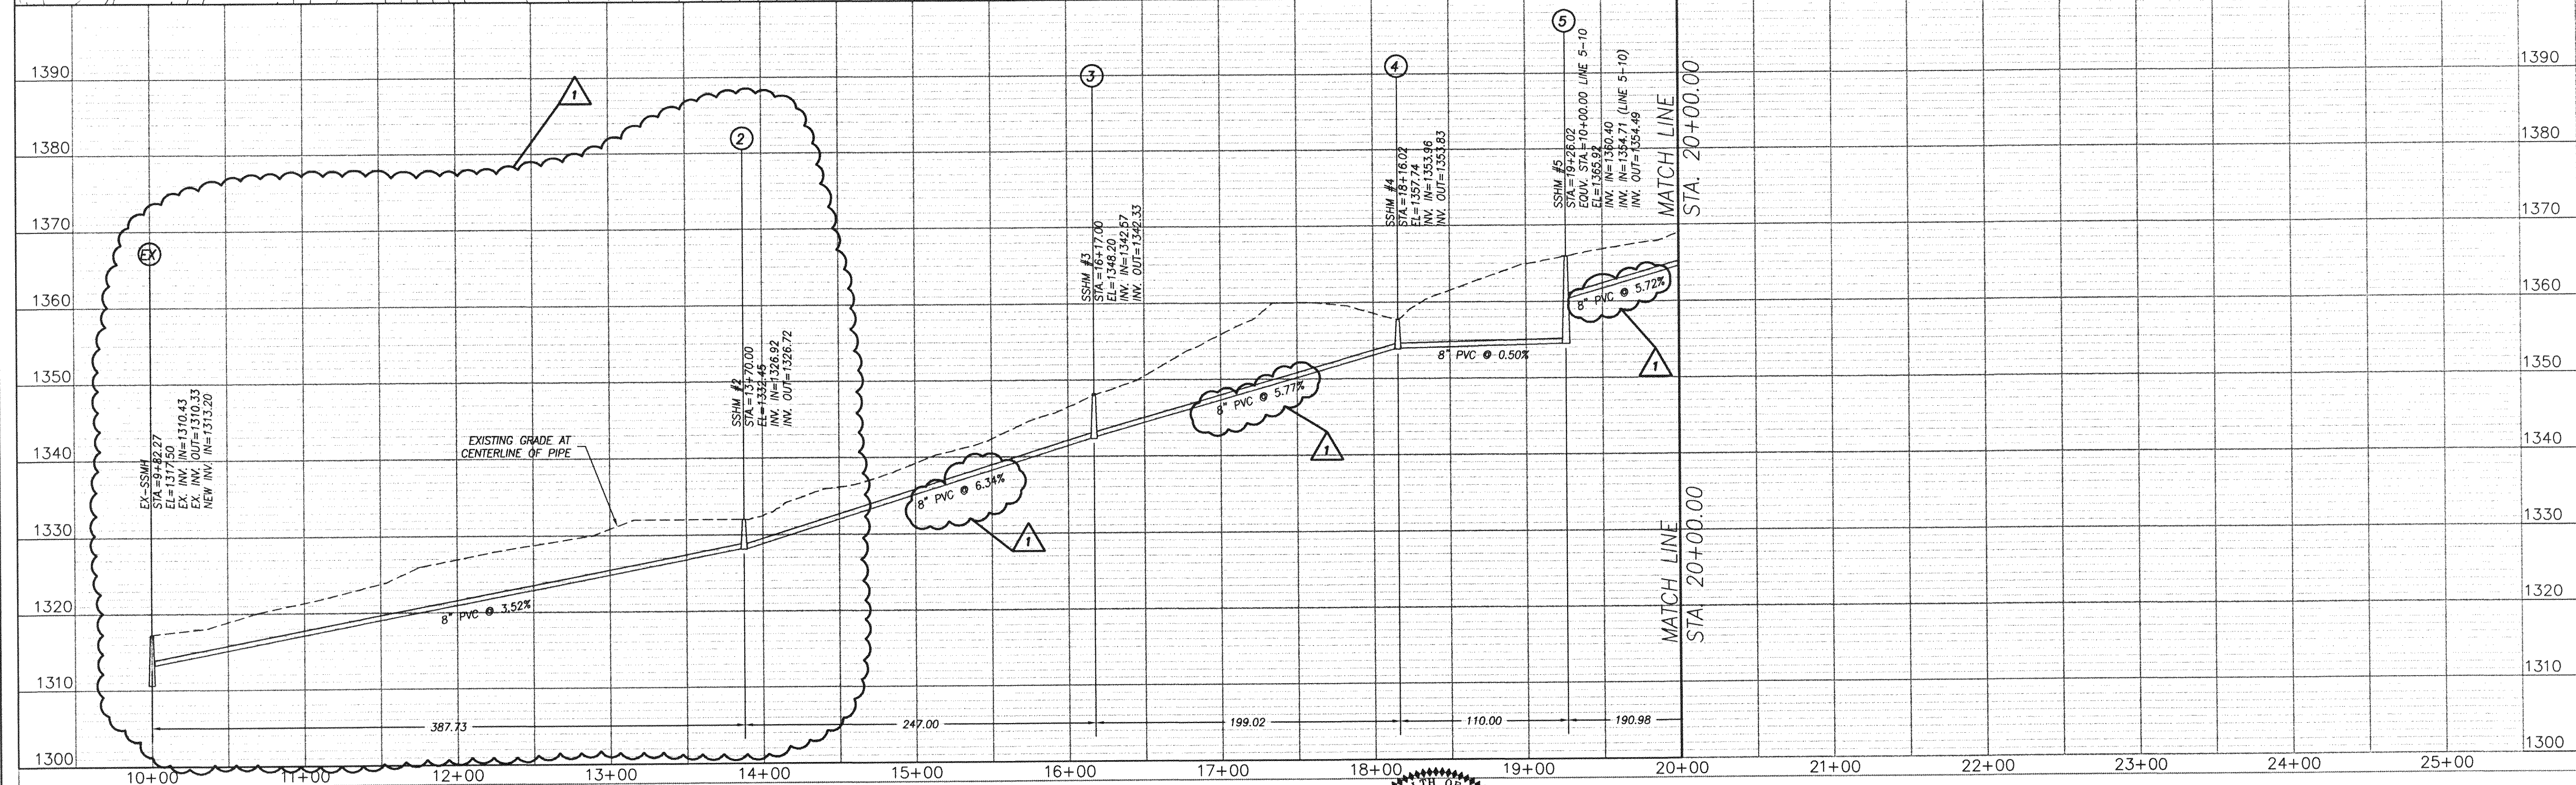


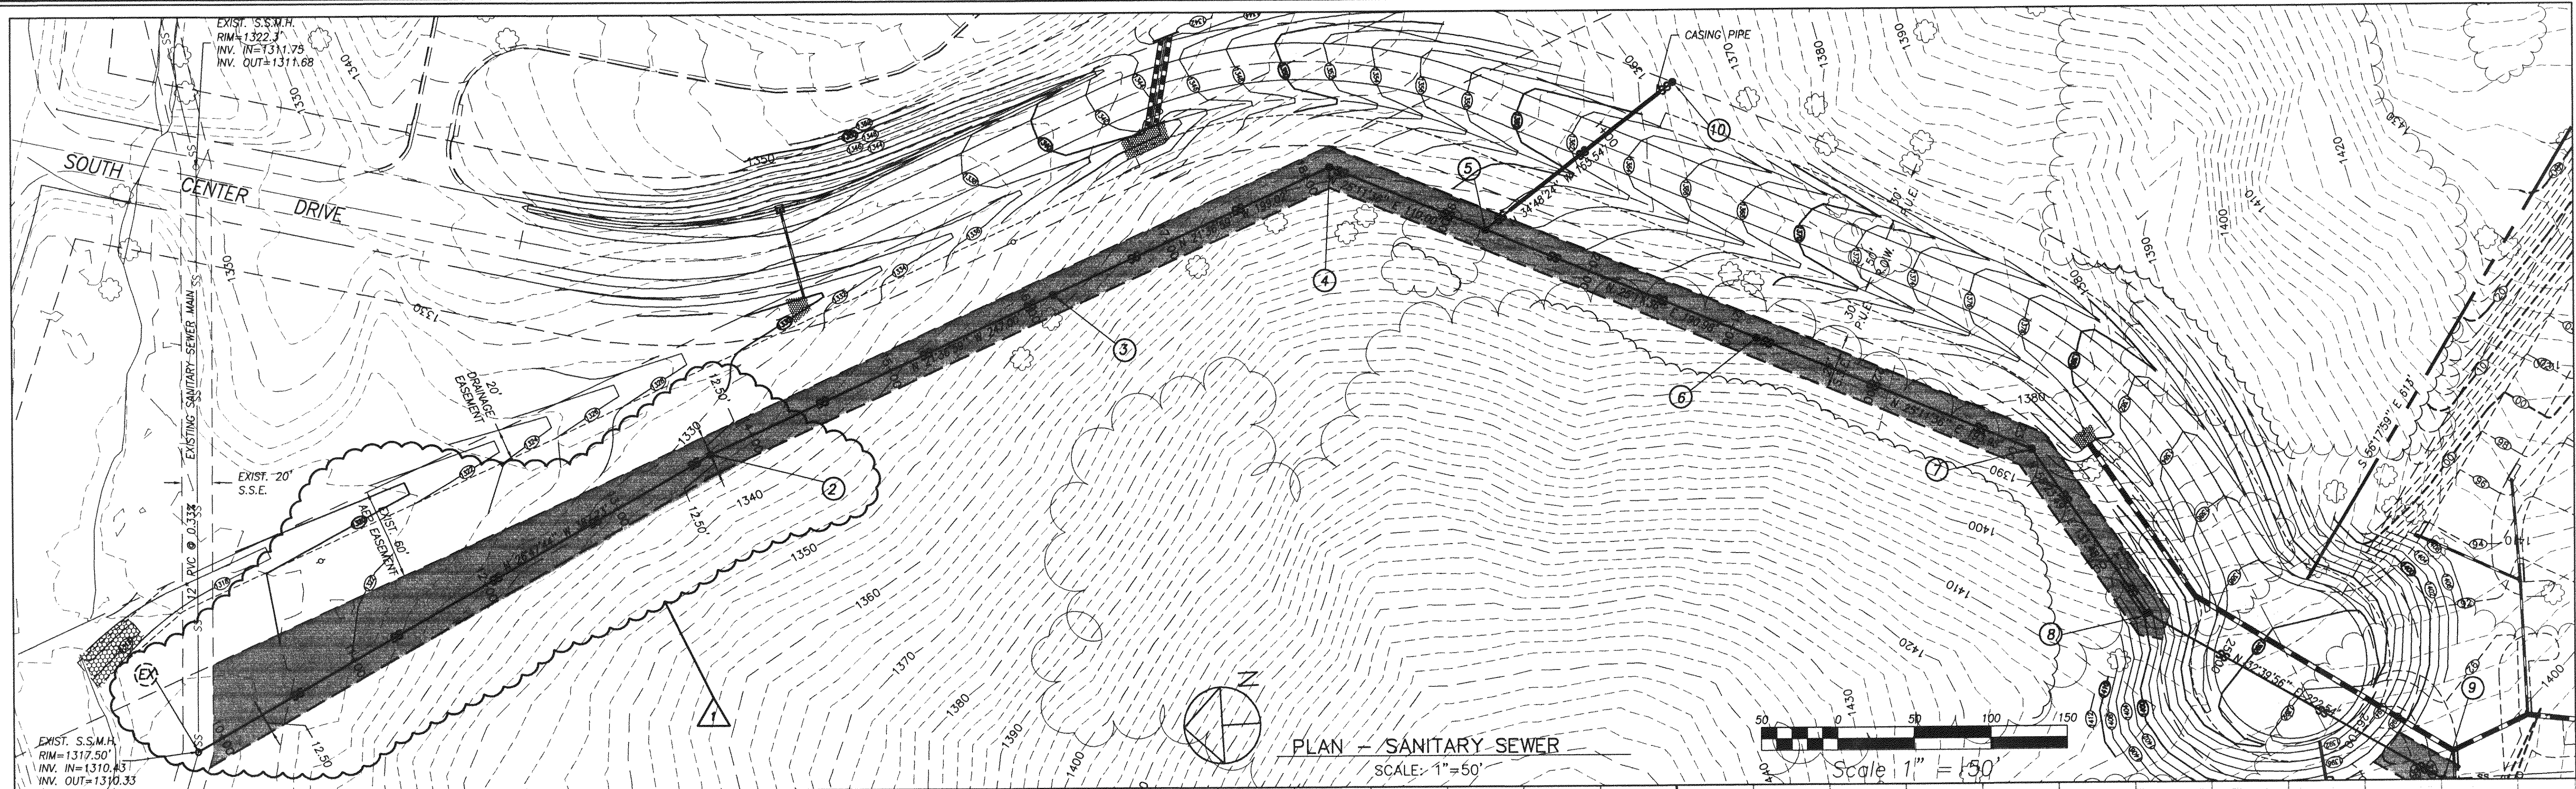

ENGINEERING CONCEPTS, INC.
20 S. ROANOKE ST., PO BOX 619
FINCASTLE, VIRGINIA 24090
540.473.1253 FAX: 540.473.1254

No.	Revision	By	Appd.	Date	Drawn	WTR
1	SS LINE REALIGNMENT	WTR	RHW	04-20-01	Designed	RHW
					Checked	RHW/JDE
					Approved	RHW

**SOUTH CENTER DRIVE
AND SANITARY SEWER EXTENSION**

SANITARY SEWER PLAN & PROFILE
STA 10+00 - STA 20+00

H:1"=50' V:1"=10'

FEBRUARY 2001

PROJECT: 00144

C7 of C10