



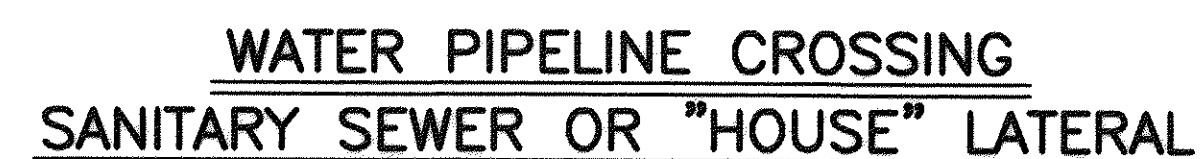

- PRESSURE = 200 psi
 BEARING = 2000 psf
 FACTOR OF SAFETY = 1.5

THRUST BLOCK CONSTRUCTION

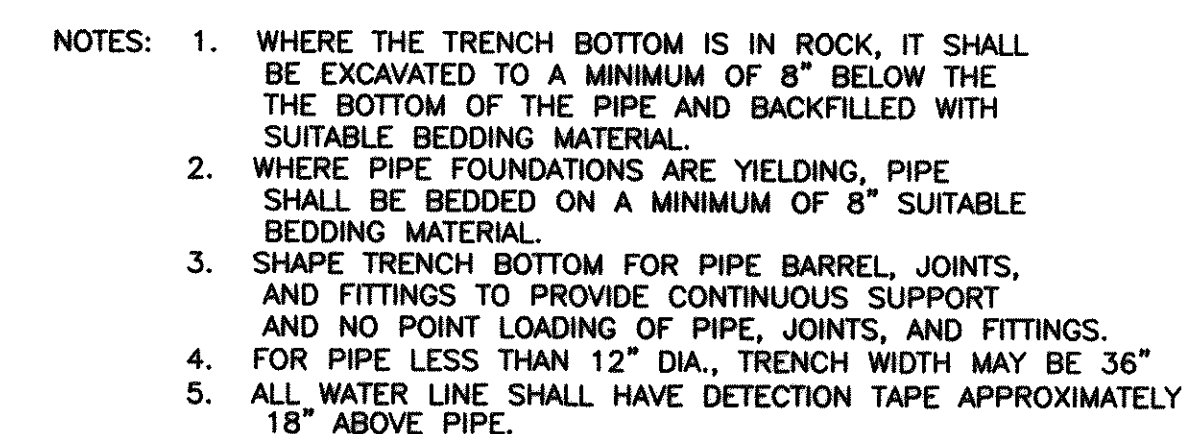

NOT TO SCALE



AS-BUILT