
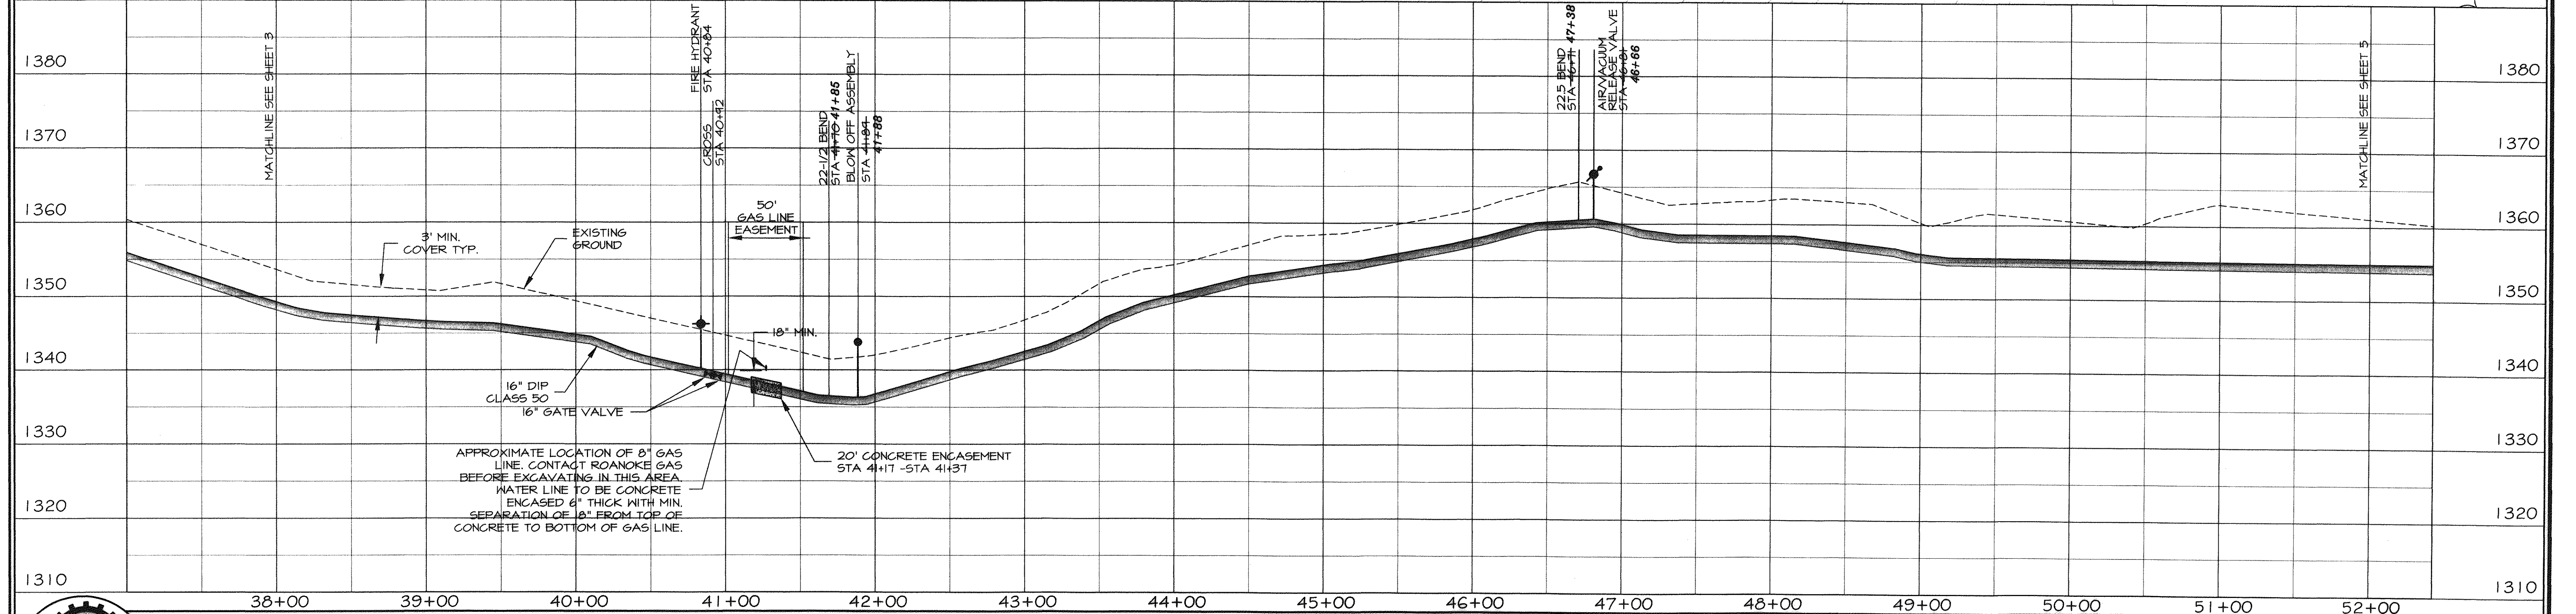


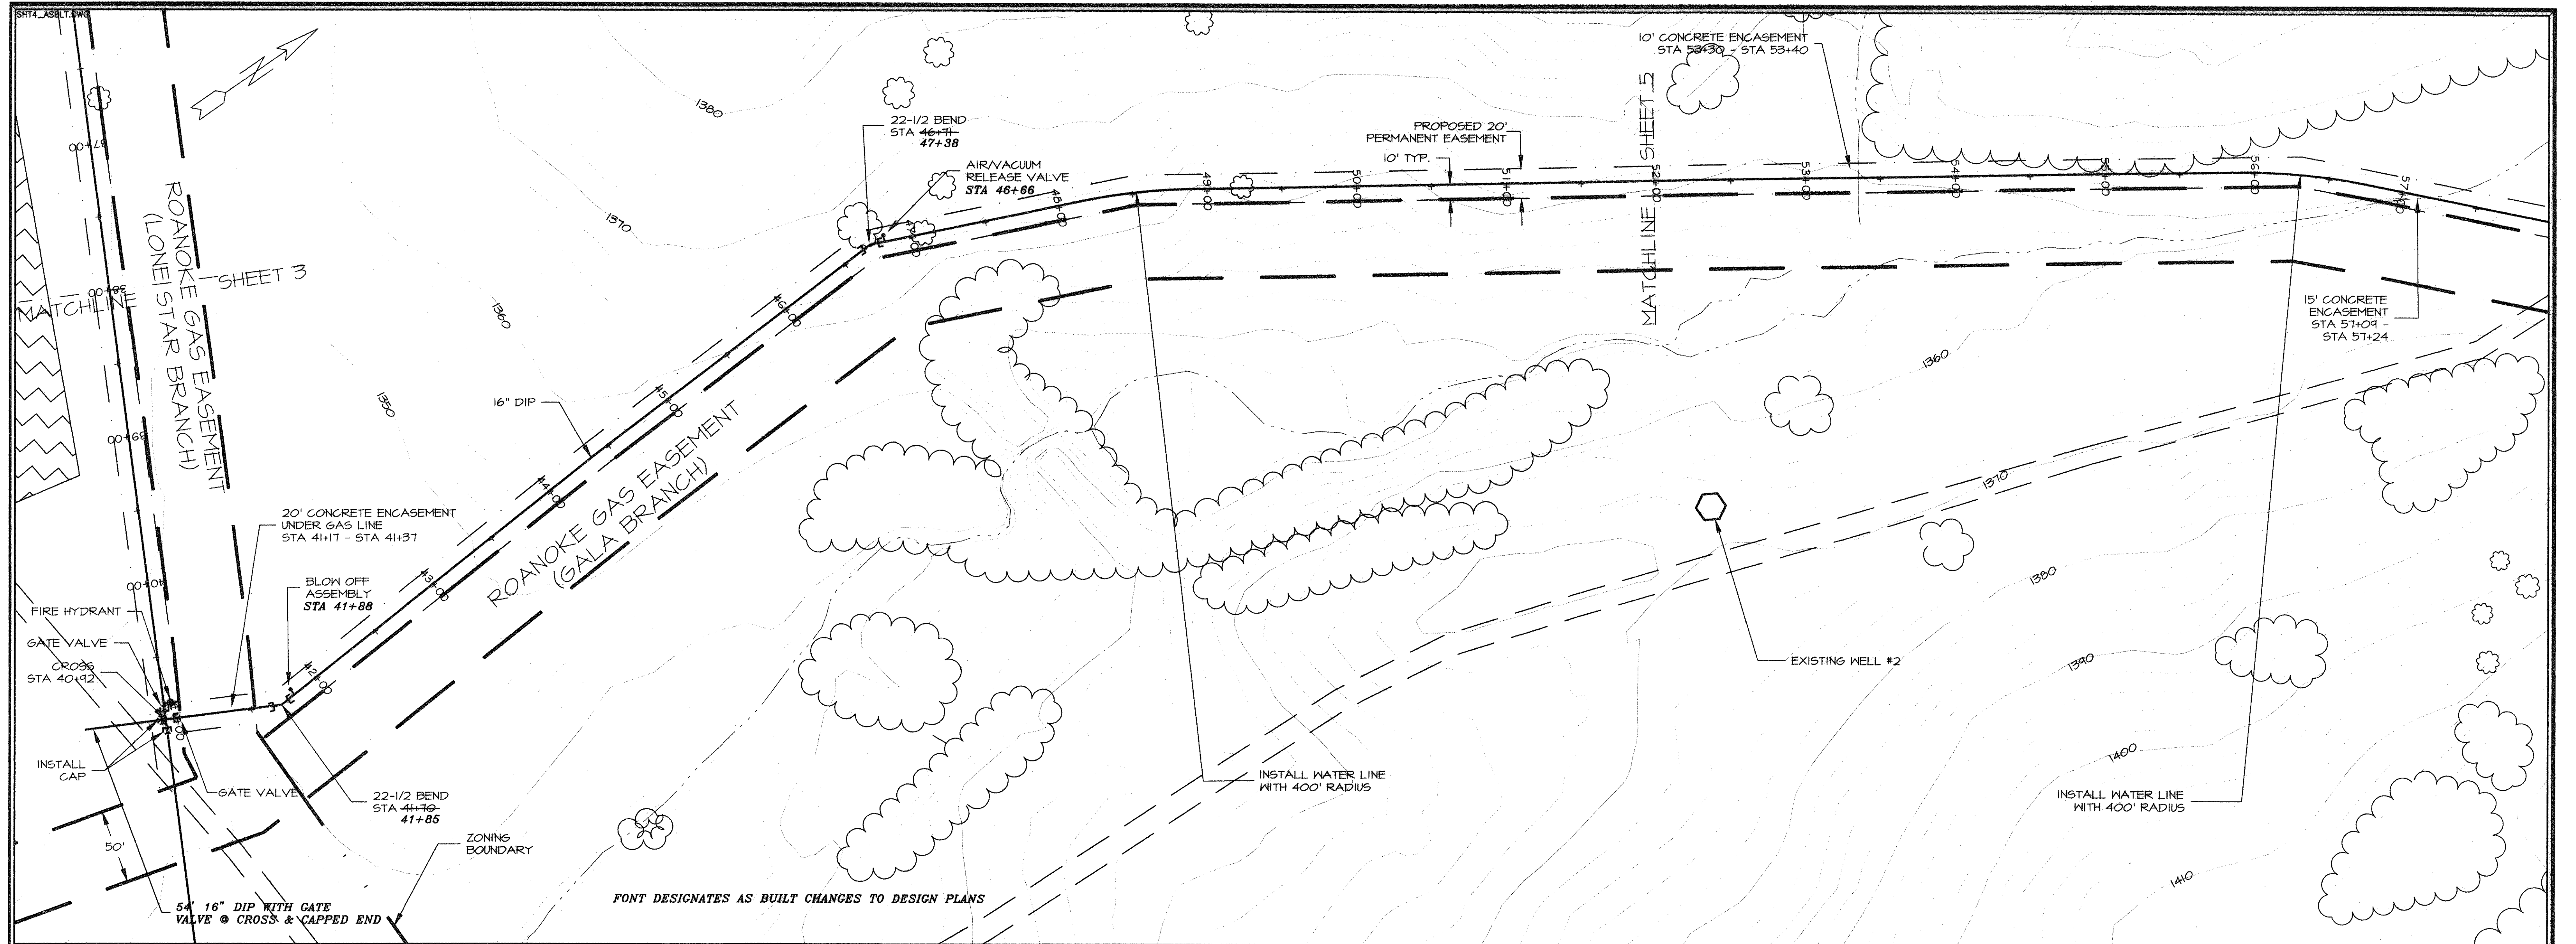

AS-BUILT