
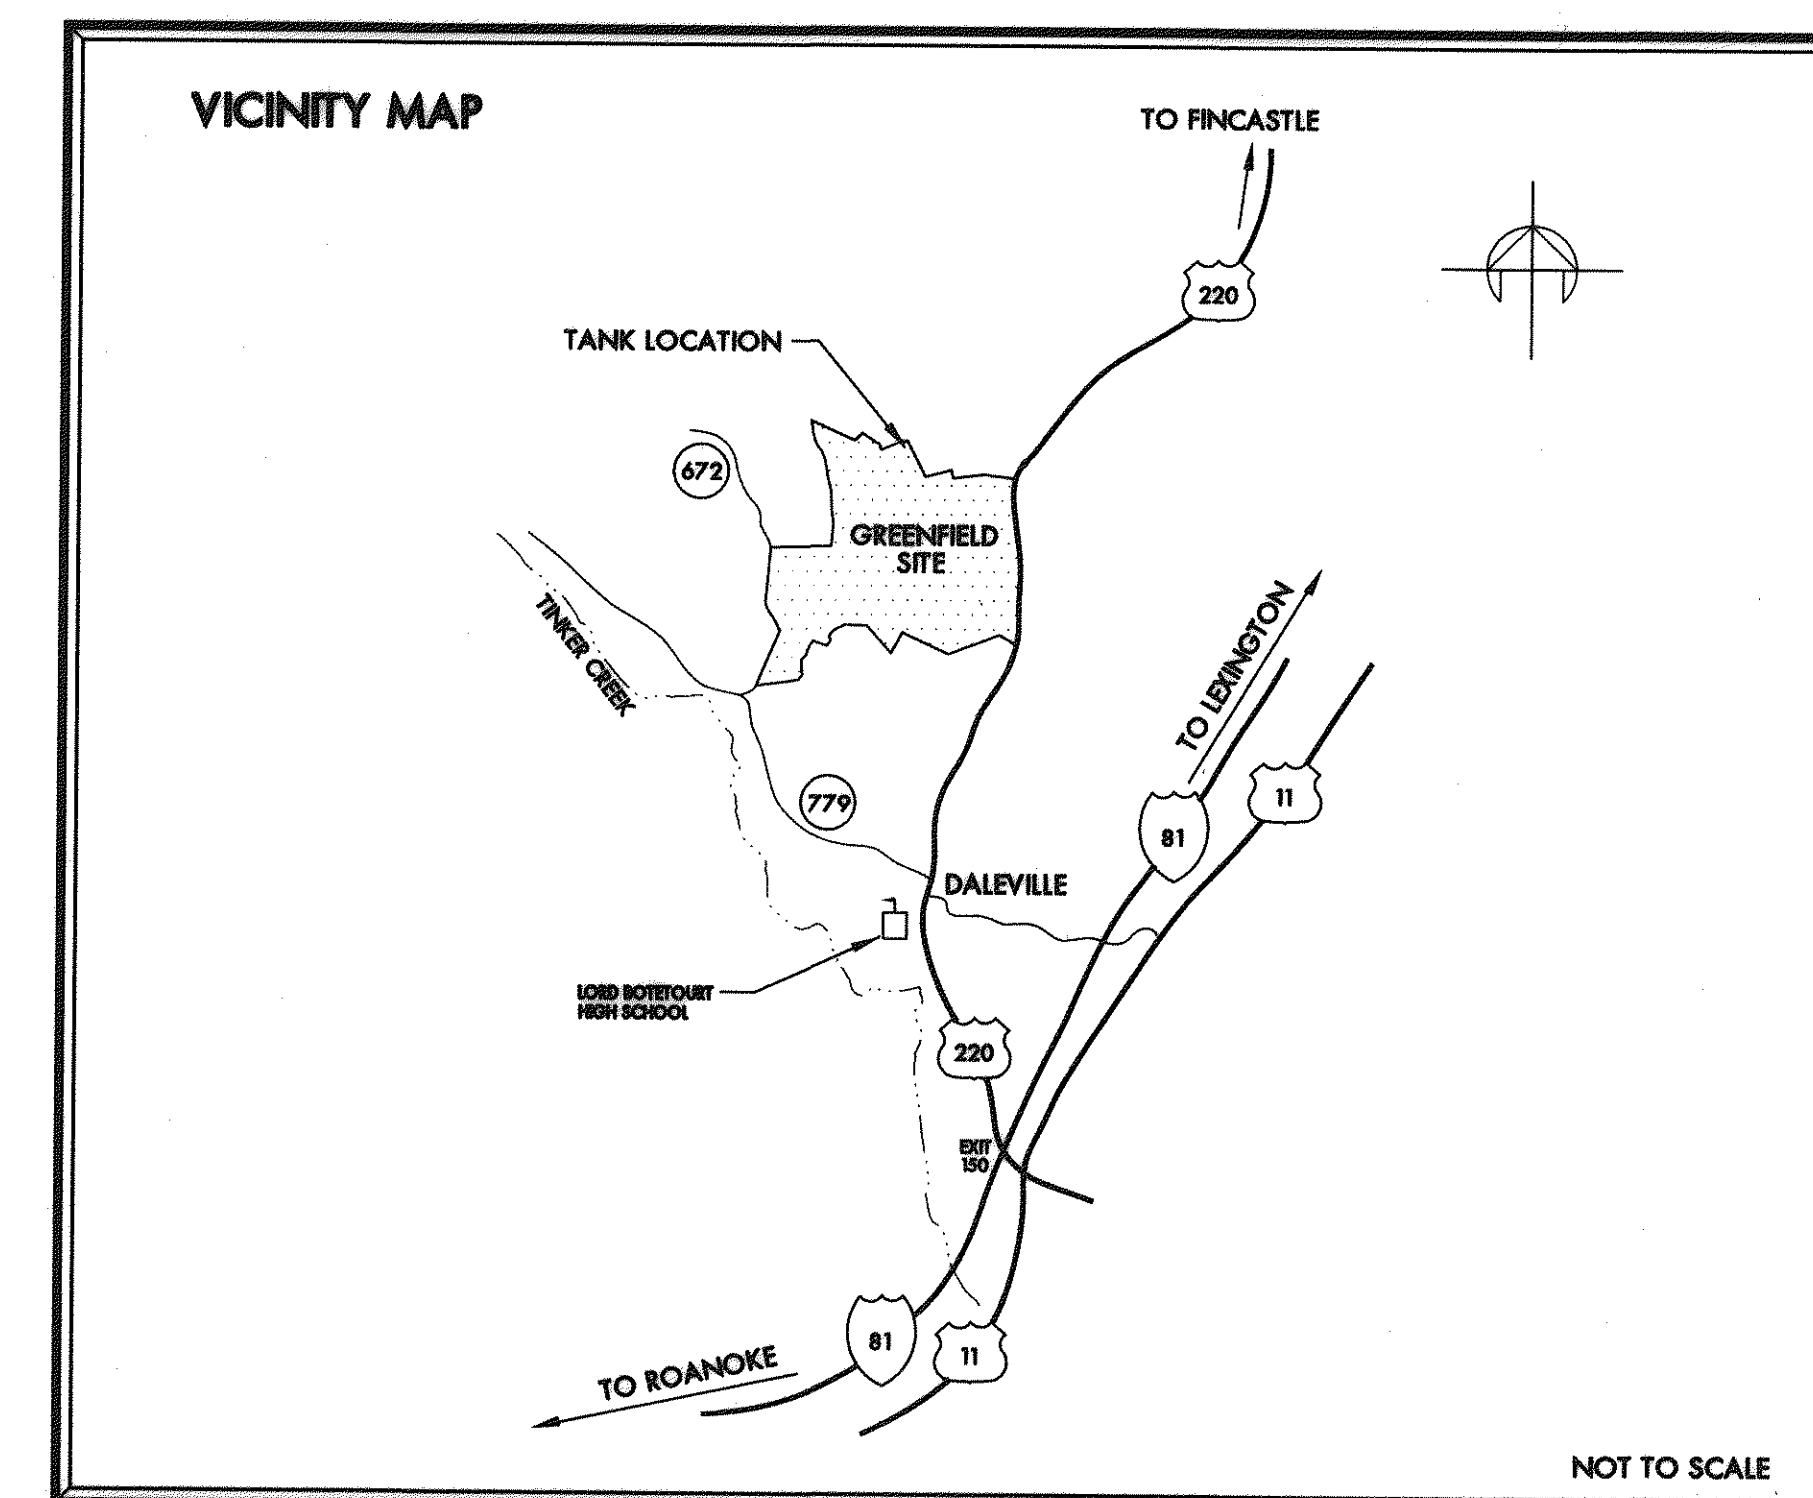


GREENFIELD WATER TANK

BOTETOURT COUNTY PUBLIC FACILITIES AND PROGRAMS

BOTETOURT COUNTY, VIRGINIA NOVEMBER, 1997

PROJECT NAME: GREENFIELD WATER TANK
 DATE: April 6, 2000
 TYPE: AS-BUILT
 LOCATION: Greenfield
 TOTAL # SHEETS: 4
 AE FIRM: ECI
 # OF SETS: 1

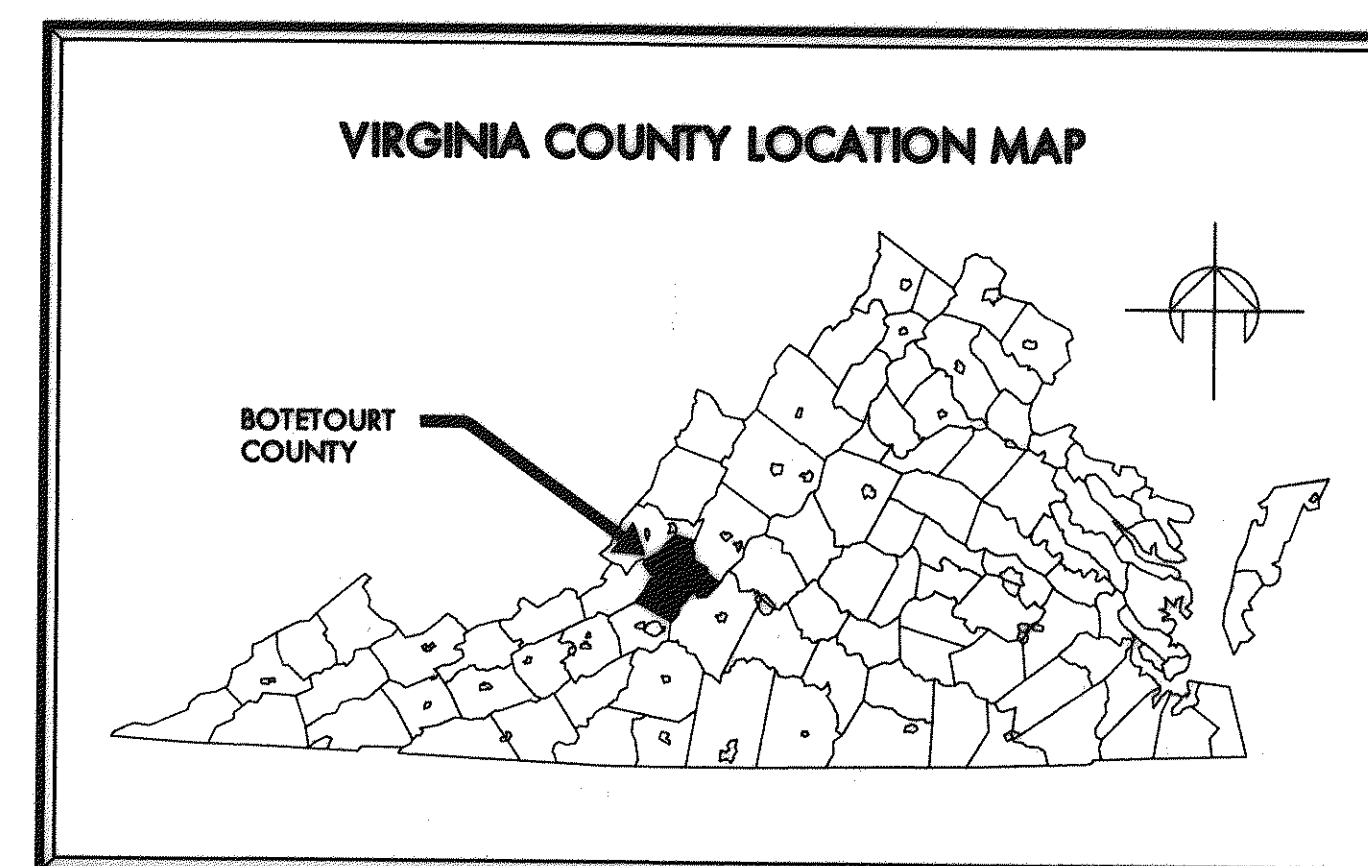

AS-BUILT
APRIL 6, 2000

