


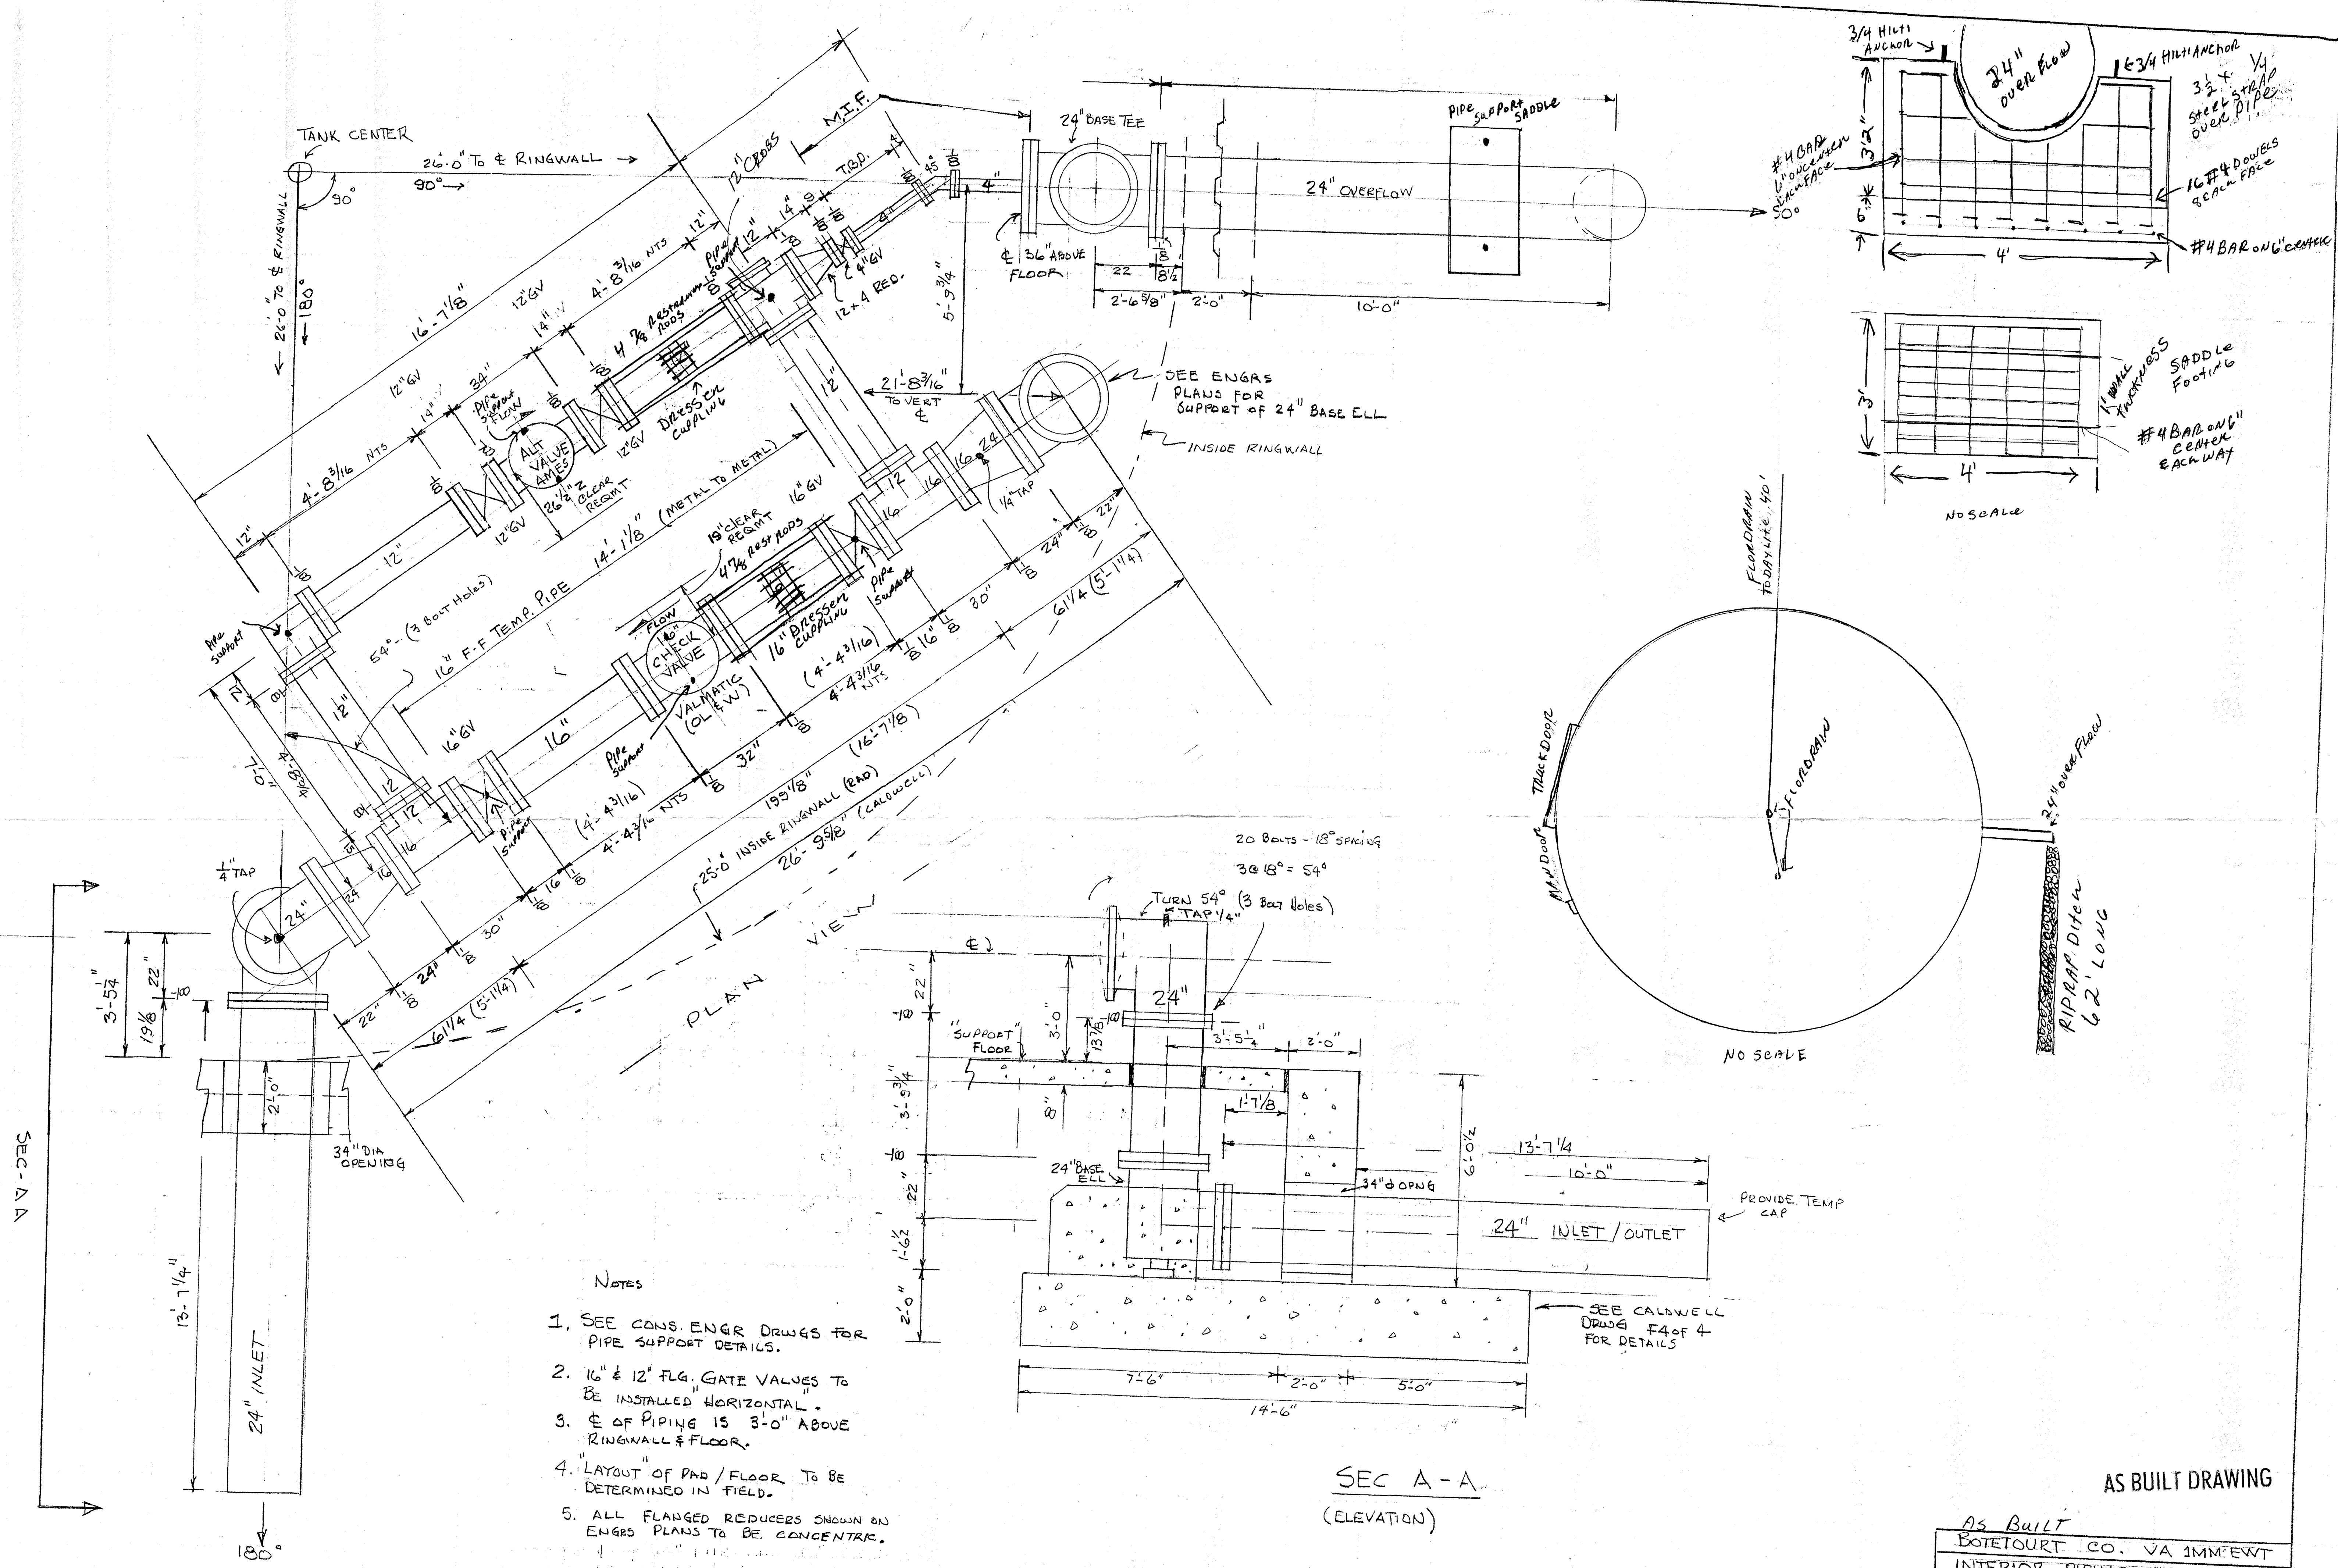

- NOTES
1. SEE CONS. ENGR. DRWS FOR PIPE SUPPORT DETAILS.
 2. 16" & 12" FLG. GATE VALVES TO BE INSTALLED HORIZONTAL.
 3. ϕ OF PIPING IS 3'-0" ABOVE RINGWALL & FLOOR.
 4. LAYOUT OF PAD / FLOOR TO BE DETERMINED IN FIELD.
 5. ALL FLANGED REDUCERS SHOWN ON ENGRS PLANS TO BE CONCENTRIC.

SEC A-A
(ELEVATION)

AS BUILT DRAWING

AS BUILT
BOTETOURT CO. VA IMM'EW
INTERIOR PIPING DETAILS
DRAWN BY PJB MAY-199
CONTRACTOR: CALDWELL TANKS INC
SCALE: 1/2" = 1'-0" OR AS NOTED