

PROJECT LOCATION MAP
N.T.S.



PROJECT AREA MAP
N.T.S.

HOLLYMEADE - GLEBE RD. GREENFIELDS TANK WATERLINE EXTENSION WATER DISTRIBUTION SYSTEM IMPROVEMENTS DALEVILLE, VIRGINIA

PREPARED FOR
WESTERN VIRGINIA WATER AUTHORITY



WESTERN VIRGINIA
WATER AUTHORITY

DESIGNED BY
HURT & PROFFITT, INC.
BLACKSBURG, VIRGINIA

FUNDED BY
WESTERN VIRGINIA WATER AUTHORITY


APPROVED FOR CONSTRUCTION

HURT & PROFFITT
1861 PRATT DRIVE, SUITE 1100
BLACKSBURG, VIRGINIA 24080
800.763.5598 TOLL FREE
540.552.5592 MAIN
540.552.5729 FAX
ENVIRONMENTAL
ENGINEERING • SURVEYING • LAND DEVELOPMENT • CONSTRUCTION TESTING & INSPECTION • CULTURAL RESOURCES
GEOTECHNICAL



HOLLYMEADE-GLEBE ROAD
GREENFIELDS TANK
WATERLINE EXTENSION
DALEVILLE, VA

PROJECT NO.	20190009
LAT.	37° 25' 10"
LONG.	79° 55' 15"
DATE:	5-31-19
DRAWN BY:	CBD
CHECKED BY:	DAA

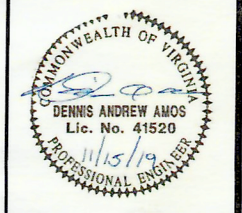

COVER

SHEET NO.
G001

CHARLIE CRUSH

Nov 14, 2019 - 2:42pm \\VA1A01\Projects\2019\20190009\Engineering\CAD\20190009_Cover_Notes.dwg