


- Temporary Construction Easement
- Air Release or Blow Off Valve
- ⊗ Gate Valve
- ⊕ Fire Hydrant
- ▬ Pavement Restoration - Patch Private Entrances, per Specifications

- NOTES:**
- CONTRACTOR SHALL CONFIRM EXISTING SERVICES MARKED FOR DEMOLITION ARE INACTIVE PRIOR TO DEMOLITION. OWNER WILL ASSIST CONTRACTOR WITH VERIFICATION.
 - CONTRACTOR SHALL PERFORM EXPLORATORY EXCAVATIONS AT UTILITY CROSSINGS TO VERIFY DEPTH PRIOR TO CONSTRUCTION AS DIRECTED BY PROJECT MANUAL.
 - CONTRACTOR SHALL COORDINATE SHUTDOWNS WITH OWNER TO MAINTAIN LOOPED FLOW TO EACH STREET DURING CONSTRUCTION.

PROPOSED WATER MAIN (1)

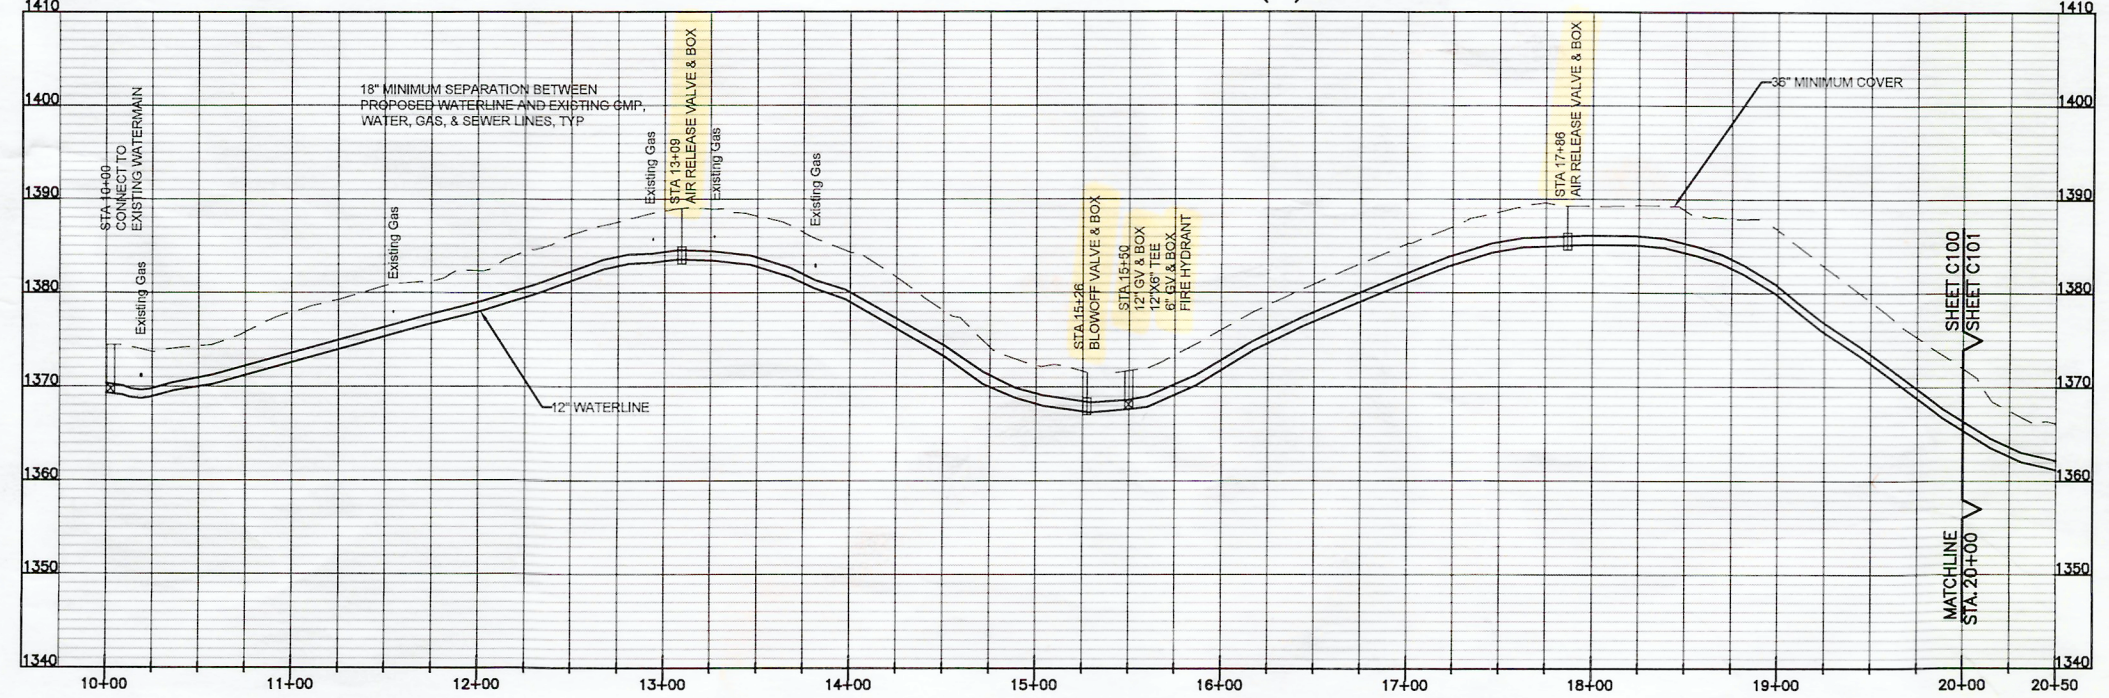

HURT & PROFFITT


1861 PRATT DRIVE, SUITE 1100
 BLACKSBURG, VIRGINIA 24060
 800.783.5596 TOLL FREE
 540.552.5992 MAIN
 540.552.5729 FAX

ENGINEERING • SURVEYING • LAND DEVELOPMENT • ENVIRONMENTAL
 GEOTECHNICAL • CONSTRUCTION TESTING & INSPECTION • CULTURAL RESOURCES

**HOLLYMEADE-GLEBE ROAD
 GREENFIELDS TANK
 WATERLINE EXTENSION**

DALEVILLE, VA

PROJECT NO.	20190009
LAT.	37° 25' 10"
LONG.	79° 55' 15"
DATE:	5-31-19
DRAWN BY:	CBD
CHECKED BY:	DAA

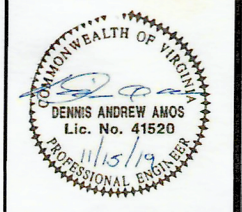

**PLAN &
 PROFILE**

SHEET NO.
 C100

Nov 15, 2019 - 10:14am \\DATAD\Projects\2019\20190009\Engineering\CAD\20190009_Design_Sheets.dwg