


- NOTES:
1. CONTRACTOR SHALL CONFIRM EXISTING SERVICES MARKED FOR DEMOLITION ARE INACTIVE PRIOR TO DEMOLITION. OWNER WILL ASSIST CONTRACTOR WITH VERIFICATION.
 2. CONTRACTOR SHALL PERFORM EXPLORATORY EXCAVATIONS AT UTILITY CROSSINGS TO VERIFY DEPTH PRIOR TO CONSTRUCTION AS DIRECTED BY PROJECT MANUAL.
 3. CONTRACTOR SHALL COORDINATE SHUTDOWNS WITH OWNER TO MAINTAIN LOOPED FLOW TO EACH STREET DURING CONSTRUCTION.

HURT & PROFFITT
 1861 PRATT DRIVE, SUITE 1100
 BLACKSBURG, VIRGINIA 24060
 800.763.5996 TOLL FREE
 540.552.5592 MAIN
 540.552.5729 FAX

ENGINEERING • SURVEYING • LAND DEVELOPMENT • ENVIRONMENTAL
 GEOTECHNICAL • CONSTRUCTION TESTING & INSPECTION • CULTURAL RESOURCES

**HOLLYMEADE-GLEBE ROAD
 GREENFIELDS TANK
 WATERLINE EXTENSION**
 DALEVILLE, VA

PROJECT NO.	20190009
LAT.	37° 25' 10"
LONG.	79° 55' 15"
DATE:	5-31-19
DRAWN BY:	CBD
CHECKED BY:	DAA

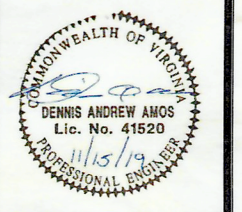

**PLAN &
 PROFILE**

SHEET NO.
C101

Nov 15, 2019 10:14am \\DATA\Projects\2019\20190009\Engineering\CAD\20190009_Design_Sheets.dwg