


- NOTES:**
1. CONTRACTOR SHALL CONFIRM EXISTING SERVICES MARKED FOR DEMOLITION ARE INACTIVE PRIOR TO DEMOLITION. OWNER WILL ASSIST CONTRACTOR WITH VERIFICATION.
  2. CONTRACTOR SHALL PERFORM EXPLORATORY EXCAVATIONS AT UTILITY CROSSINGS TO VERIFY DEPTH PRIOR TO CONSTRUCTION AS DIRECTED BY PROJECT MANUAL.
  3. CONTRACTOR SHALL COORDINATE SHUTDOWNS WITH OWNER TO MAINTAIN LOOPED FLOW TO EACH STREET DURING CONSTRUCTION.

- Temporary Construction Easement
- Air Release or Blow Off Valve
- Gate Valve
- Fire Hydrant
- Pavement Restoration - Patch Private
- Entrances, per Specifications
- Culvert Inlet Protection
- Culvert Outlet Protection

PROPOSED WATER MAIN (4)

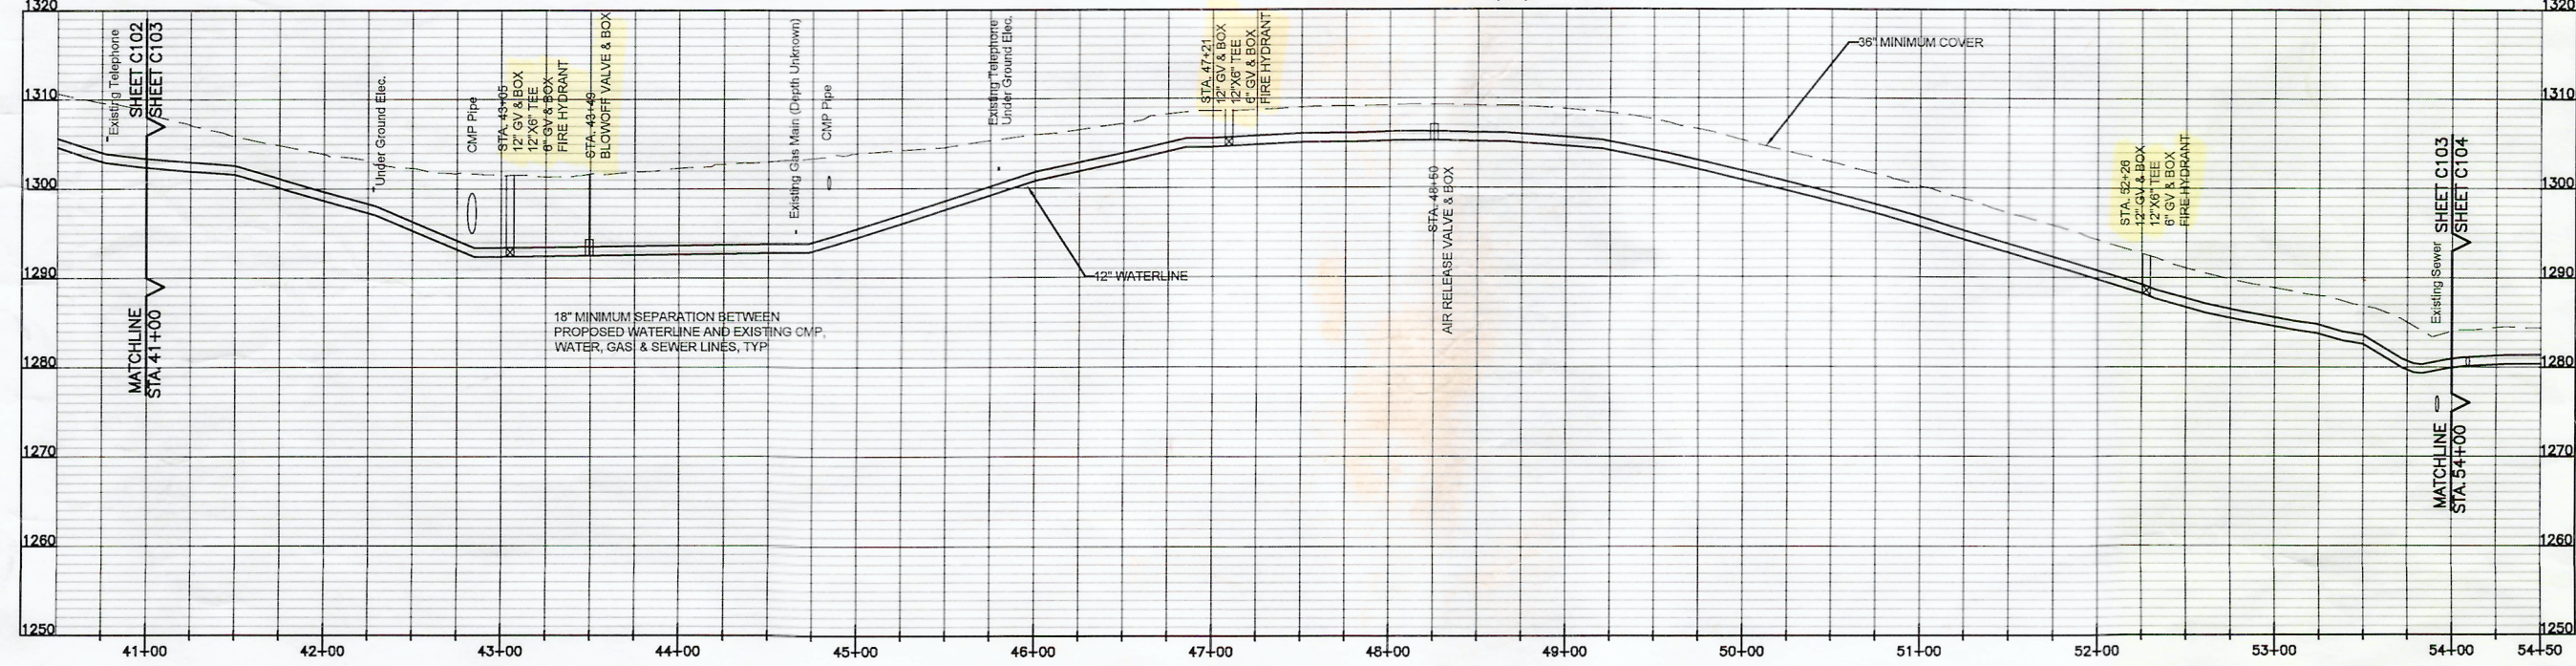

**HURT & PROFFITT**


1861 PRATT DRIVE, SUITE 1100  
 BLACKSBURG, VIRGINIA 24060  
 800.783.5596 TOLL FREE  
 540.552.5729 MAIN  
 540.552.5729 FAX

ENGINEERING • SURVEYING • LAND DEVELOPMENT • ENVIRONMENTAL  
 GEOTECHNICAL • CONSTRUCTION TESTING & INSPECTION • CULTURAL RESOURCES

**HOLLYMEADE-GLEBE ROAD  
 GREENFIELDS TANK  
 WATERLINE EXTENSION**

DALEVILLE, VA

PROJECT NO.	20190009
LAT.	37° 25' 10"
LONG.	79° 55' 15"
DATE:	5-31-19
DRAWN BY:	CBD
CHECKED BY:	DAA

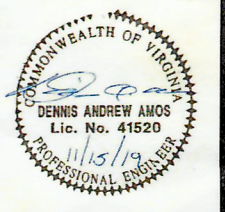

**PLAN &  
 PROFILE**

SHEET NO.  
 C103

Nov 15, 2019 - 10:15am \\DATA01\Projects\2019\20190009\Engineering\CAD\20190009\_Design\_Sheets.dwg