


- Temporary Construction Easement
- ⊕ Air Release or Blow Off Valve
- ⊕ Gate Valve
- ⊕ Fire Hydrant
- ▬ Pavement Restoration - Patch Private Entrance, per Specifications
- ▬ Culvert Inlet Protection
- ▬ Culvert Outlet Protection

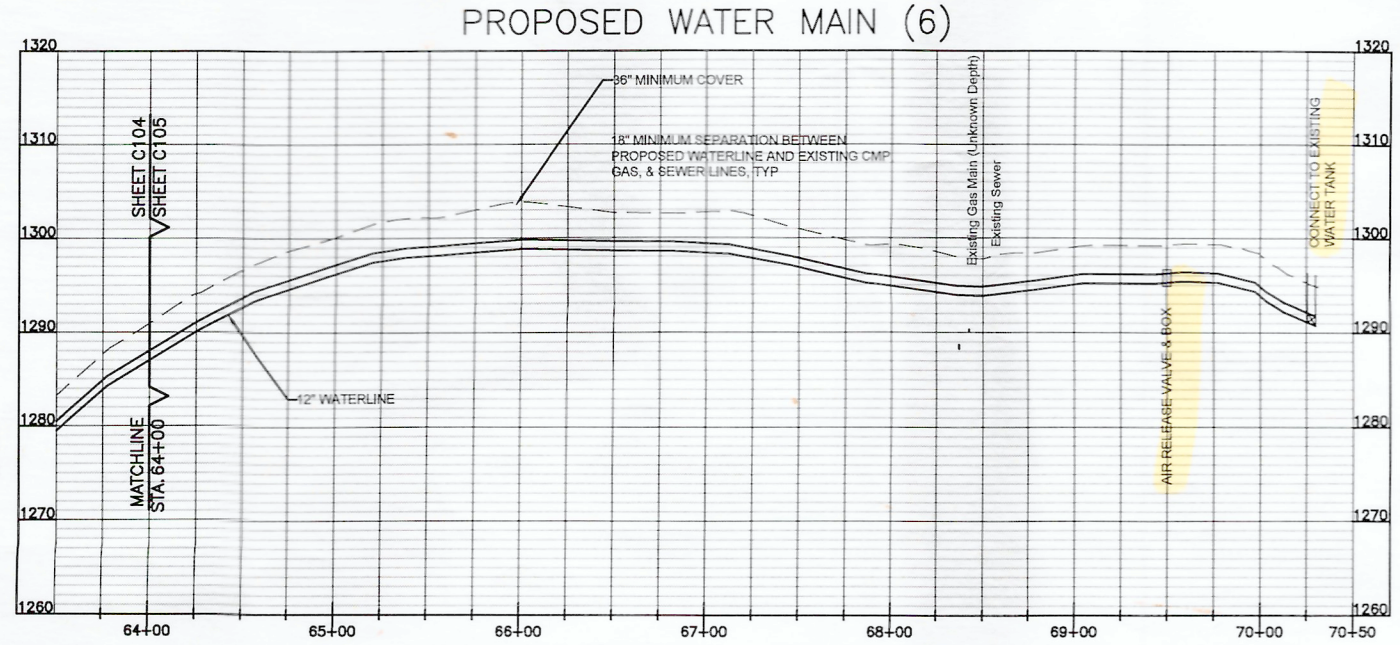

- NOTES:**
- CONTRACTOR SHALL CONFIRM EXISTING SERVICES MARKED FOR DEMOLITION ARE INACTIVE PRIOR TO DEMOLITION. OWNER WILL ASSIST CONTRACTOR WITH VERIFICATION.
 - CONTRACTOR SHALL PERFORM EXPLORATORY EXCAVATIONS AT UTILITY CROSSINGS TO VERIFY DEPTH PRIOR TO CONSTRUCTION AS DIRECTED BY PROJECT MANUAL.
 - CONTRACTOR SHALL COORDINATE SHUTDOWNS WITH OWNER TO MAINTAIN LOOPED FLOW TO EACH STREET DURING CONSTRUCTION.

HURT & PROFFITT


1881 PRATT DRIVE SUITE 1100
 BLACKSBURG, VIRGINIA 24060
 800.763.5599 TOLL FREE
 540.552.5592 MAIN
 540.552.5729 FAX

ENVIRONMENTAL
 ENGINEERING • SURVEYING • LAND DEVELOPMENT • CONSTRUCTION TESTING & INSPECTION • CULTURAL RESOURCES

**HOLLYMEADE-GLEBE ROAD
 GREENFIELDS TANK
 WATERLINE EXTENSION**

DALEVILLE, VA

PROJECT NO. 20190009
 LAT. 37° 25' 10"
 LONG. 79° 55' 15"
 DATE: 5-31-19
 DRAWN BY: CBD
 CHECKED BY: DAA

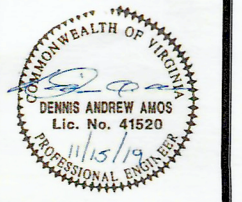

**PLAN &
 PROFILE**

SHEET NO.
 C105

Nov 15, 2019 10:16am \\DATA\All\Projects\2019\20190009\Engineering\CAD\20190009_Design_Sheets.dwg