
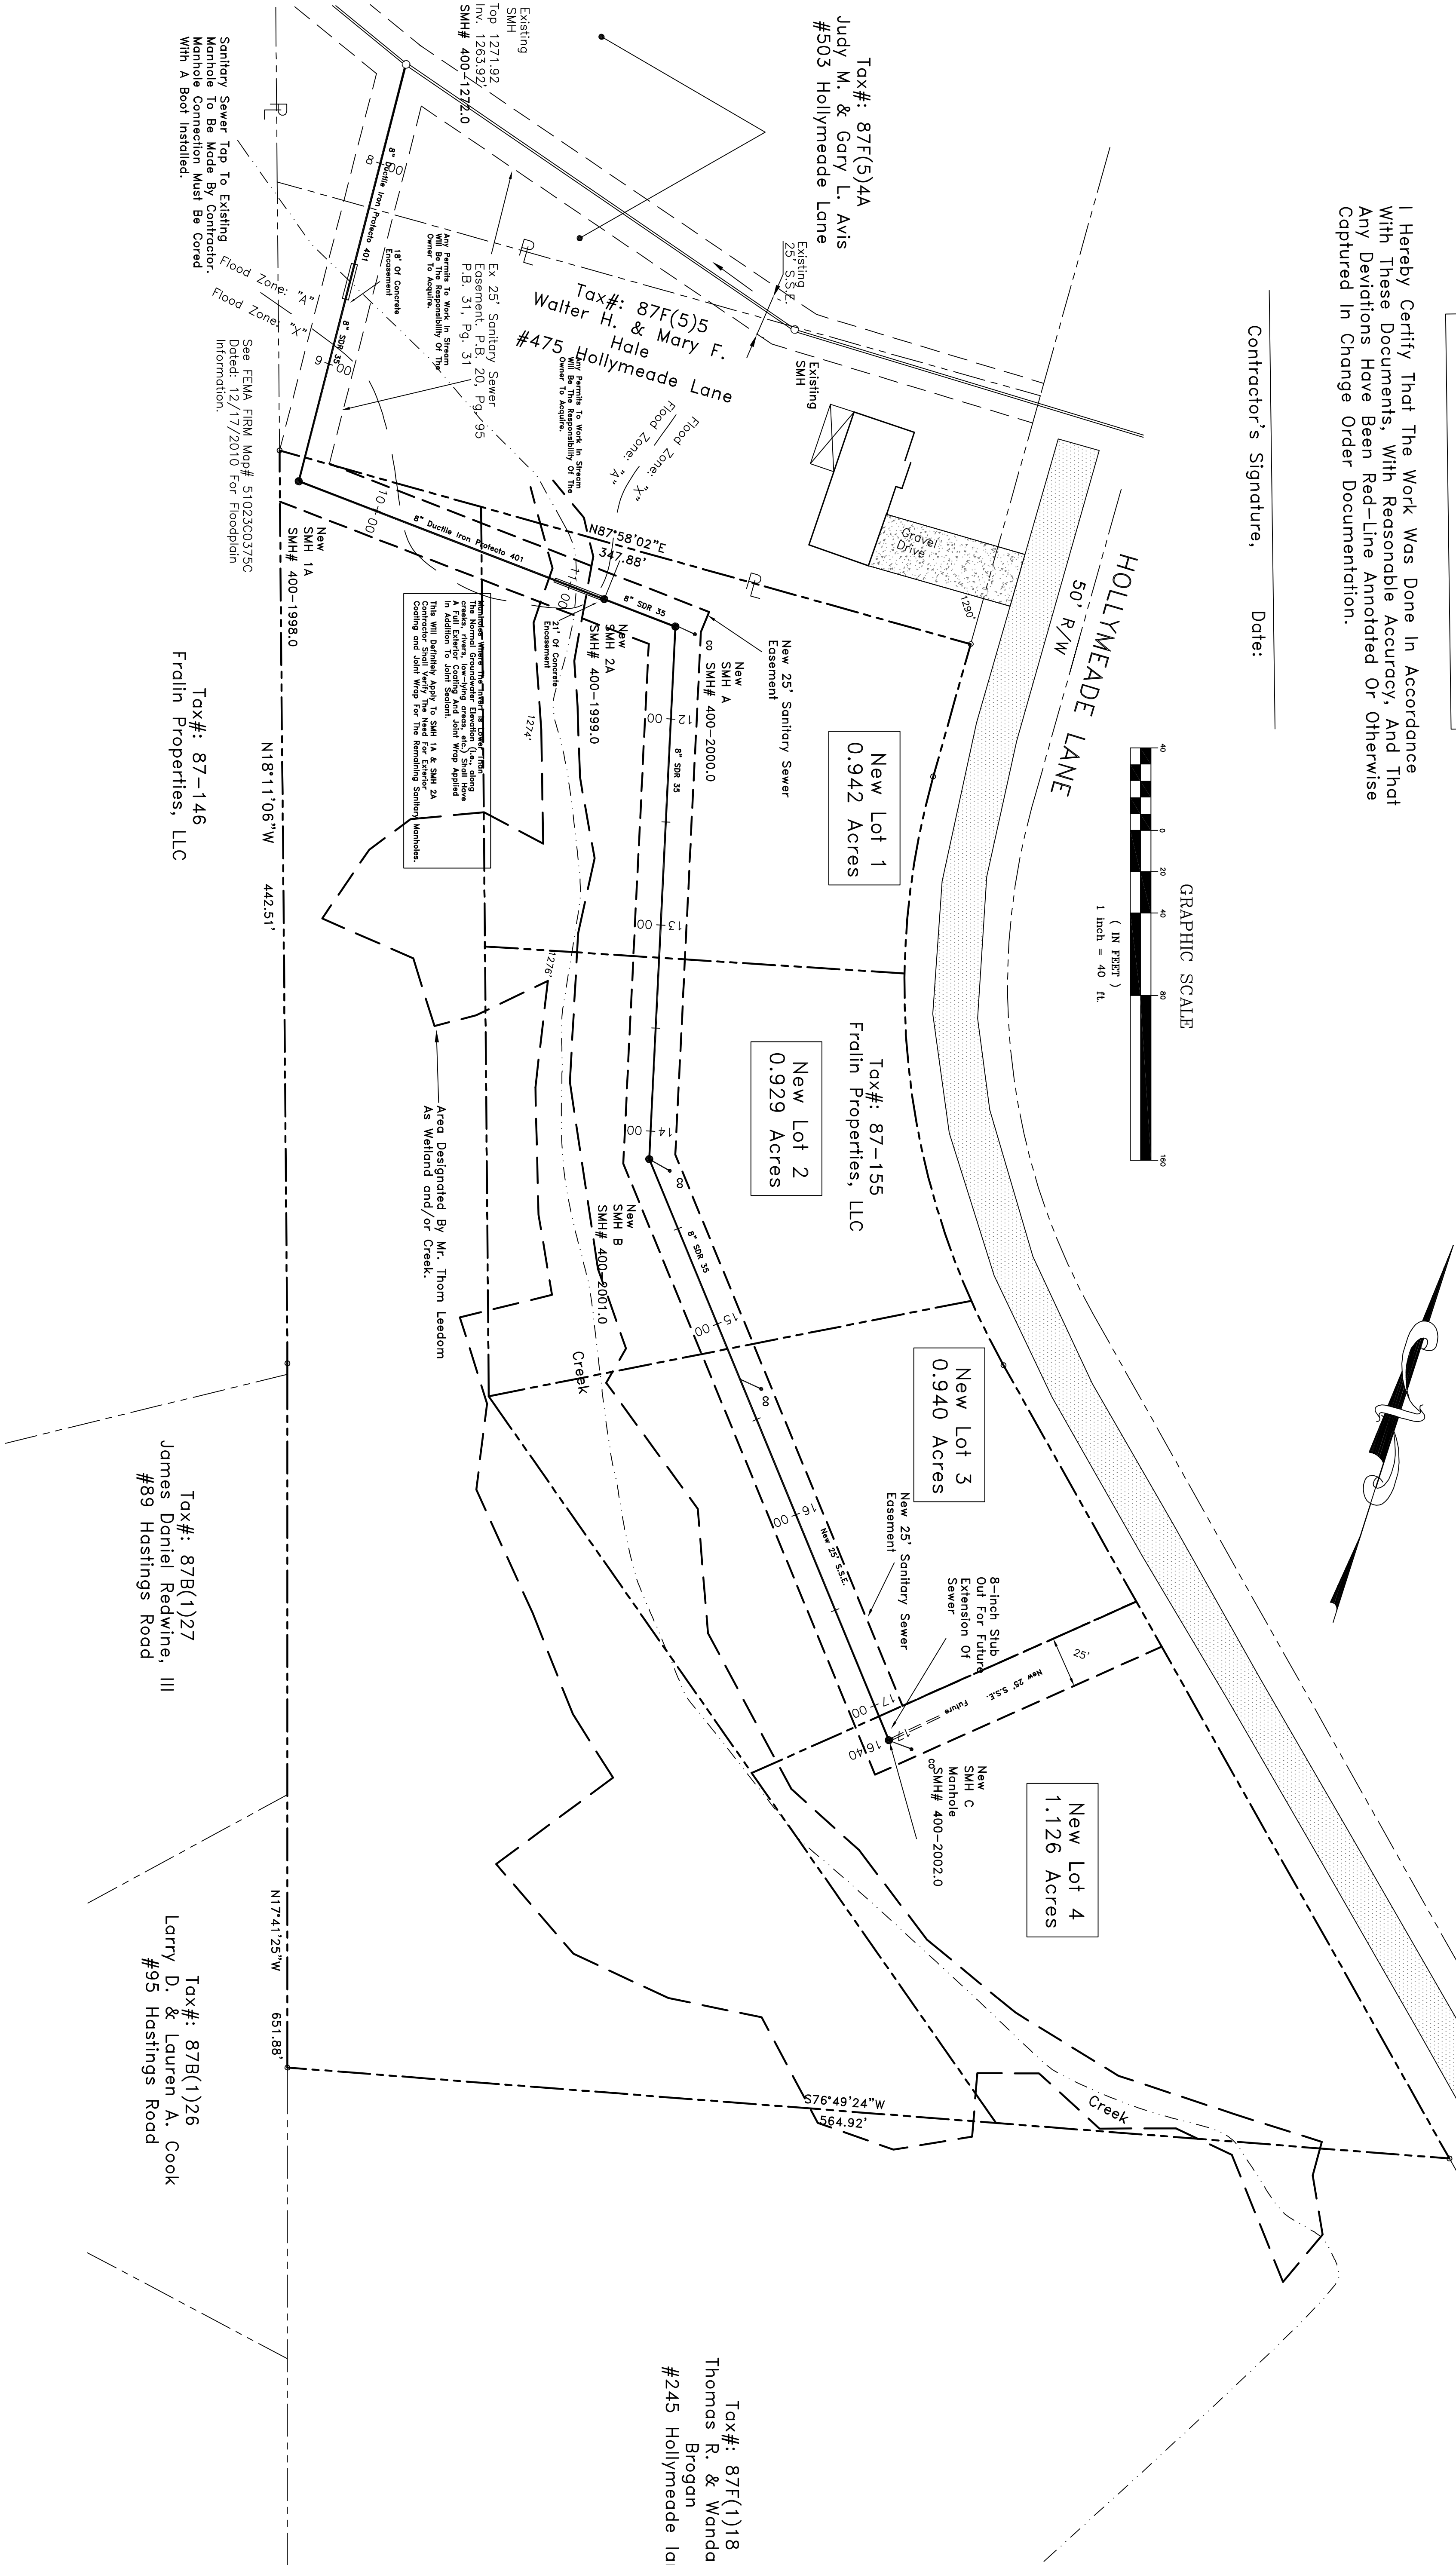
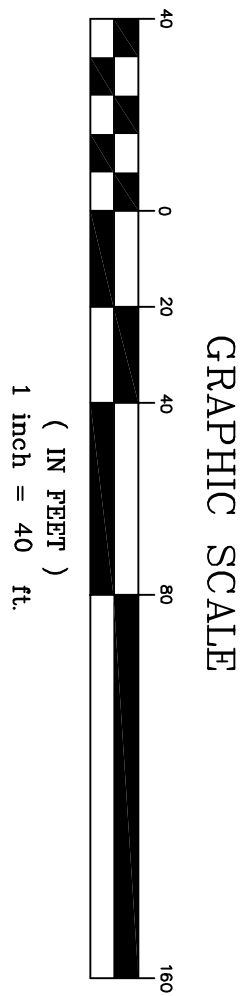


Asbuilt: 01/03/2022

I Hereby Certify That The Work Was Done In Accordance
With These Documents, With Reasonable Accuracy, And That
Any Deviations Have Been Red-Line Annotated Or Otherwise
Captured In Change Order Documentation.

Contractor's Signature, Date:

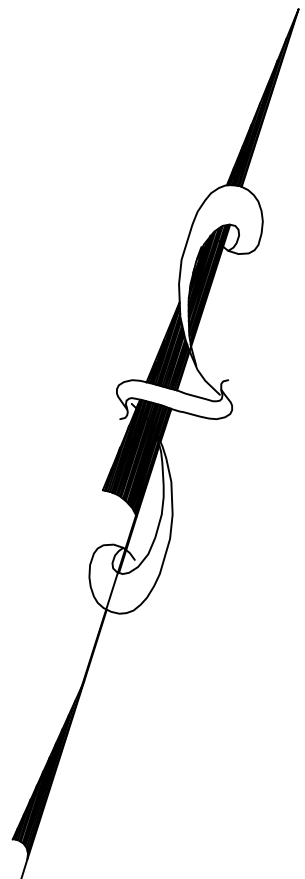

PIERSON
ENGINEERING
&
SURVEYING

P.O. BOX 311
44 CATAWBA ROAD
DALEVILLE, VA 24083

(540) 966-3027 TEL
(540) 966-5906 FAX
e-mail: rpierson@bnet.com

E AND S and Utility Plan
Tax#: 87-155
BOTETOURT COUNTY, VIRGINIA

Asbuilts



SHEET
C1