
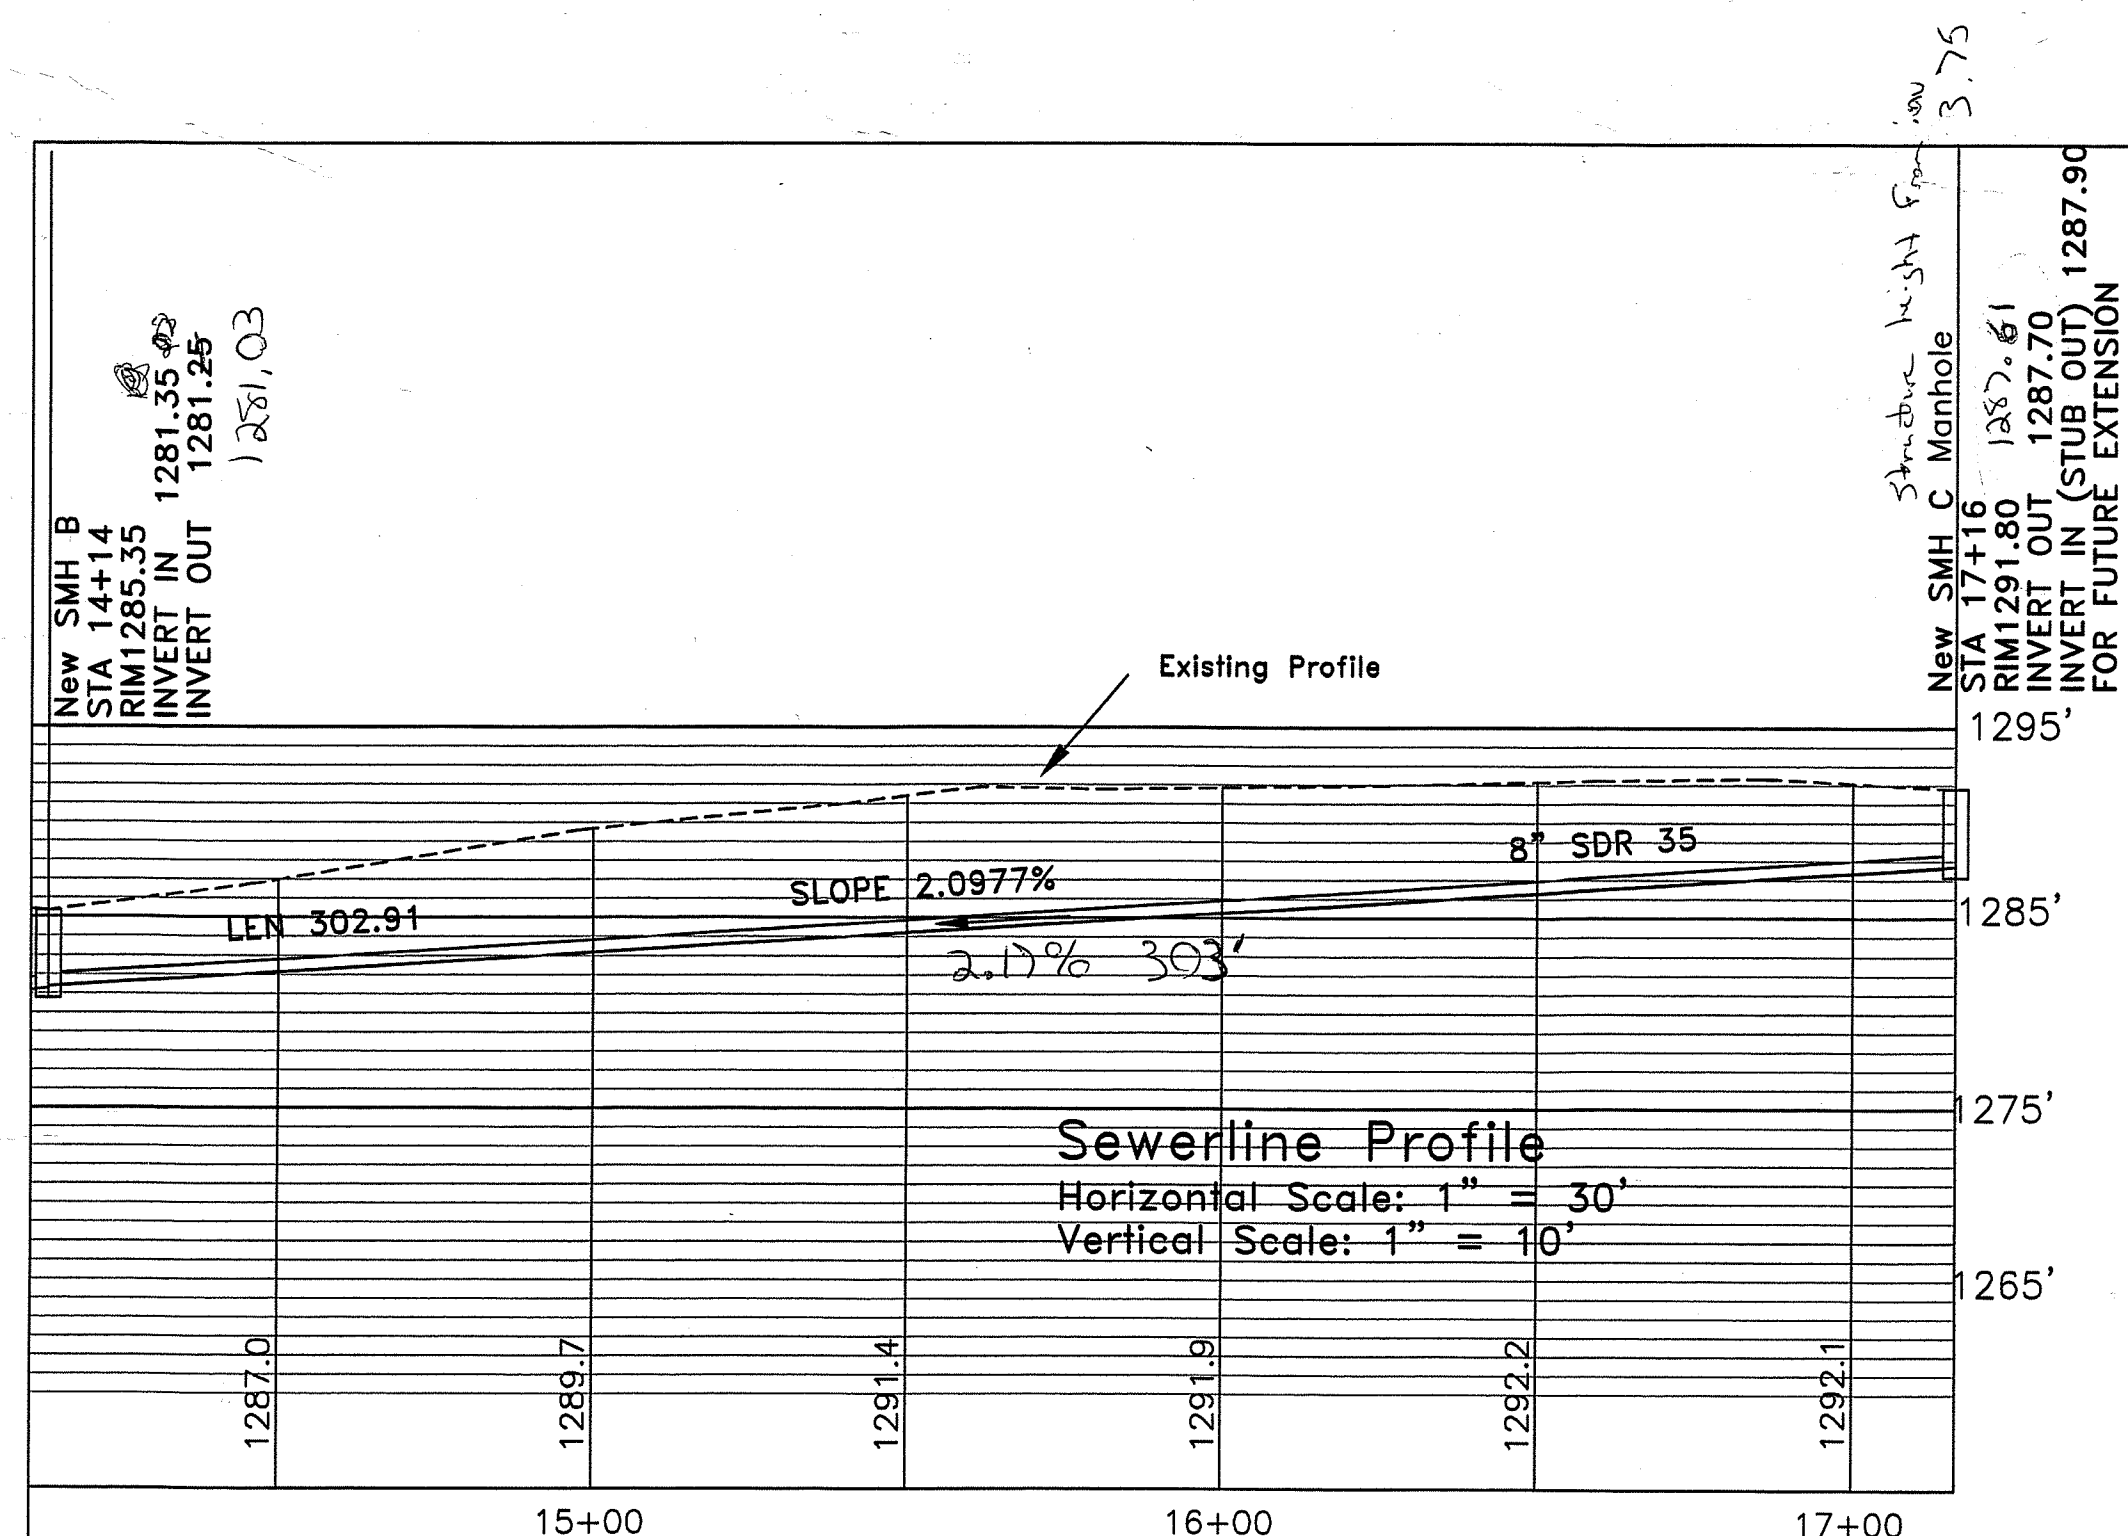


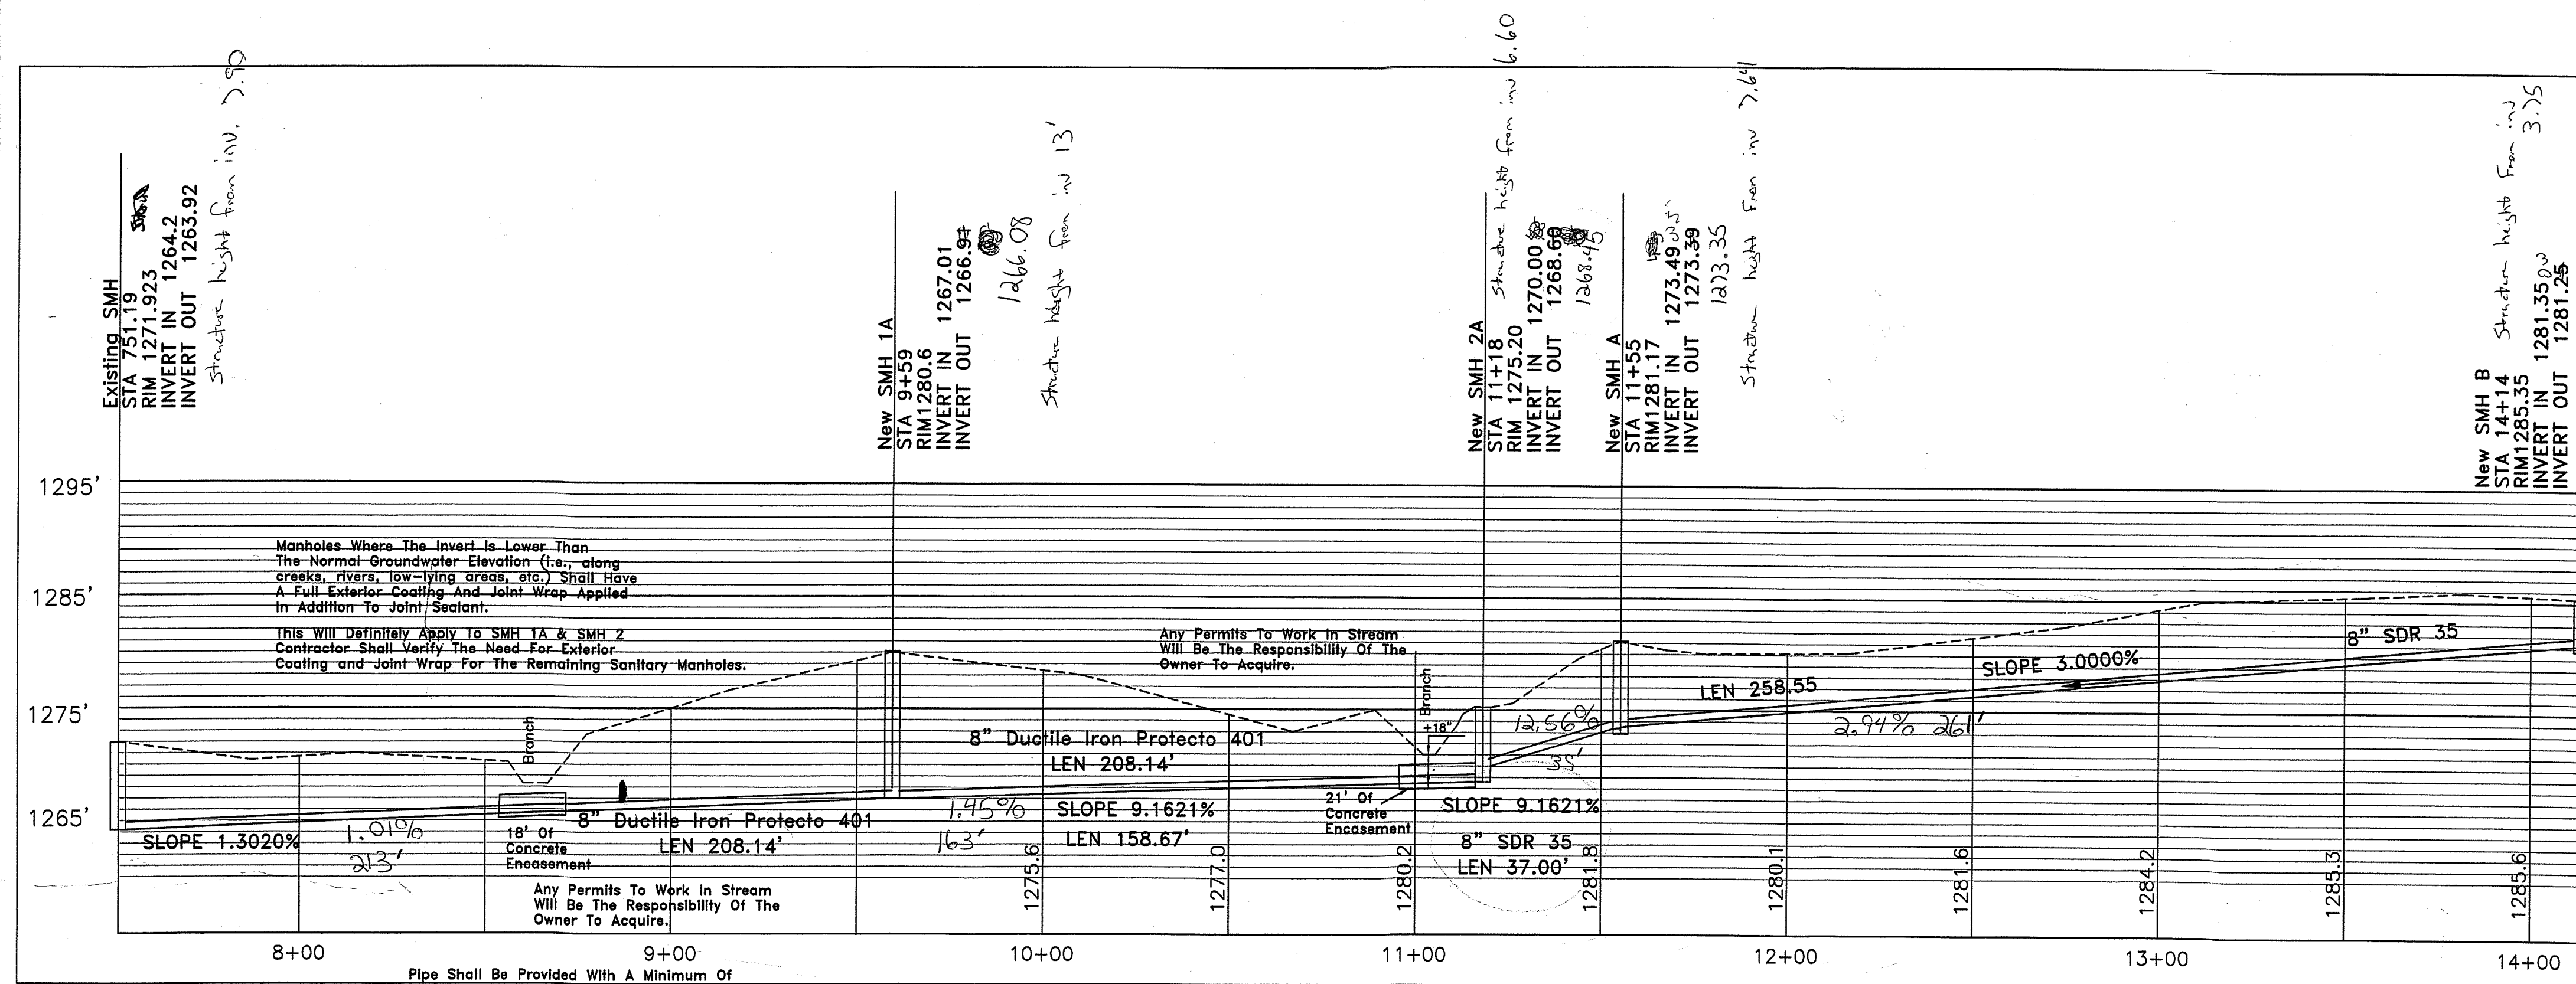

Sewer Notes:

1. All sanitary sewer connections to existing lines shall be coordinated with and performed by the Western Virginia Water Authority.
2. All water and sanitary sewer facilities are to be installed according to the Western Virginia Water Authority Design and Construction Standards.

DATE: 06/25/2014

REVISIONS

△

△

PIERSON
ENGINEERING
&
SURVEYING

P.O. BOX 311
 44 CATAWBA ROAD
 DALEVILLE, VA 24083

(540) 966-3027 TEL
 (540) 966-5906 FAX
 e-mail: rpierson@rlnet.com

E AND S and Utility Plan
HOLLYMEAD VI
BOTETOURT COUNTY, VIRGINIA


PROFILES

General Notes:

1. All construction methods and materials shall conform to the latest WWA Design and Construction Standards.
2. The contractor or developer is required to notify the Western Virginia Water Authority in writing at least three (3) days prior to any construction. Please contact Mark Sink at 537-6430.
3. All work shall be subject to inspection by the Western Virginia Water Authority.
4. Field corrections shall be approved by the Western Virginia Water Authority prior to such construction.
5. The contractor shall maintain a minimum of 18" clearance vertically and 2' minimum horizontally from outside of pipe to outside of pipe at all water, sanitary sewer crossings of any other utilities. Where this cannot be achieved additional measures in accordance with WWA standards shall be enforced.
6. Any existing appurtenances should be adjusted to grade and new frame and covers installed where required.

ave all existing utilities
 This plan review does
 / to relocated any existing

7. It is the contractor's responsibility to locate and potholed to verify locations. not remove the contractor's responsibility conflicts found during construction.

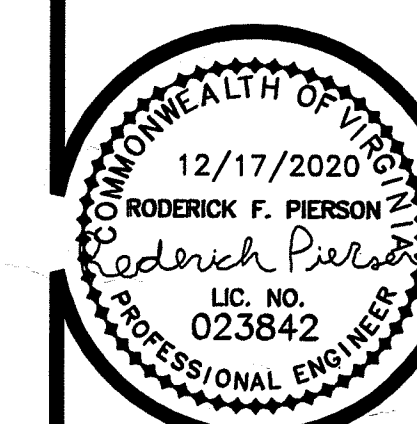

SHEET
 C4

Randall
Woods
SDO 355 66666

14.3)

6.36 rim diff
 B to C

6.62 rev
 plan

91123
 11430
 5.93
 6.36 in diff