


R:\10340462-Curbank-Daleville\DWG\Sheet\CD\WATER PROFILES.dwg | Plotted on 6/6/2018 4:10 PM | by John Wilson

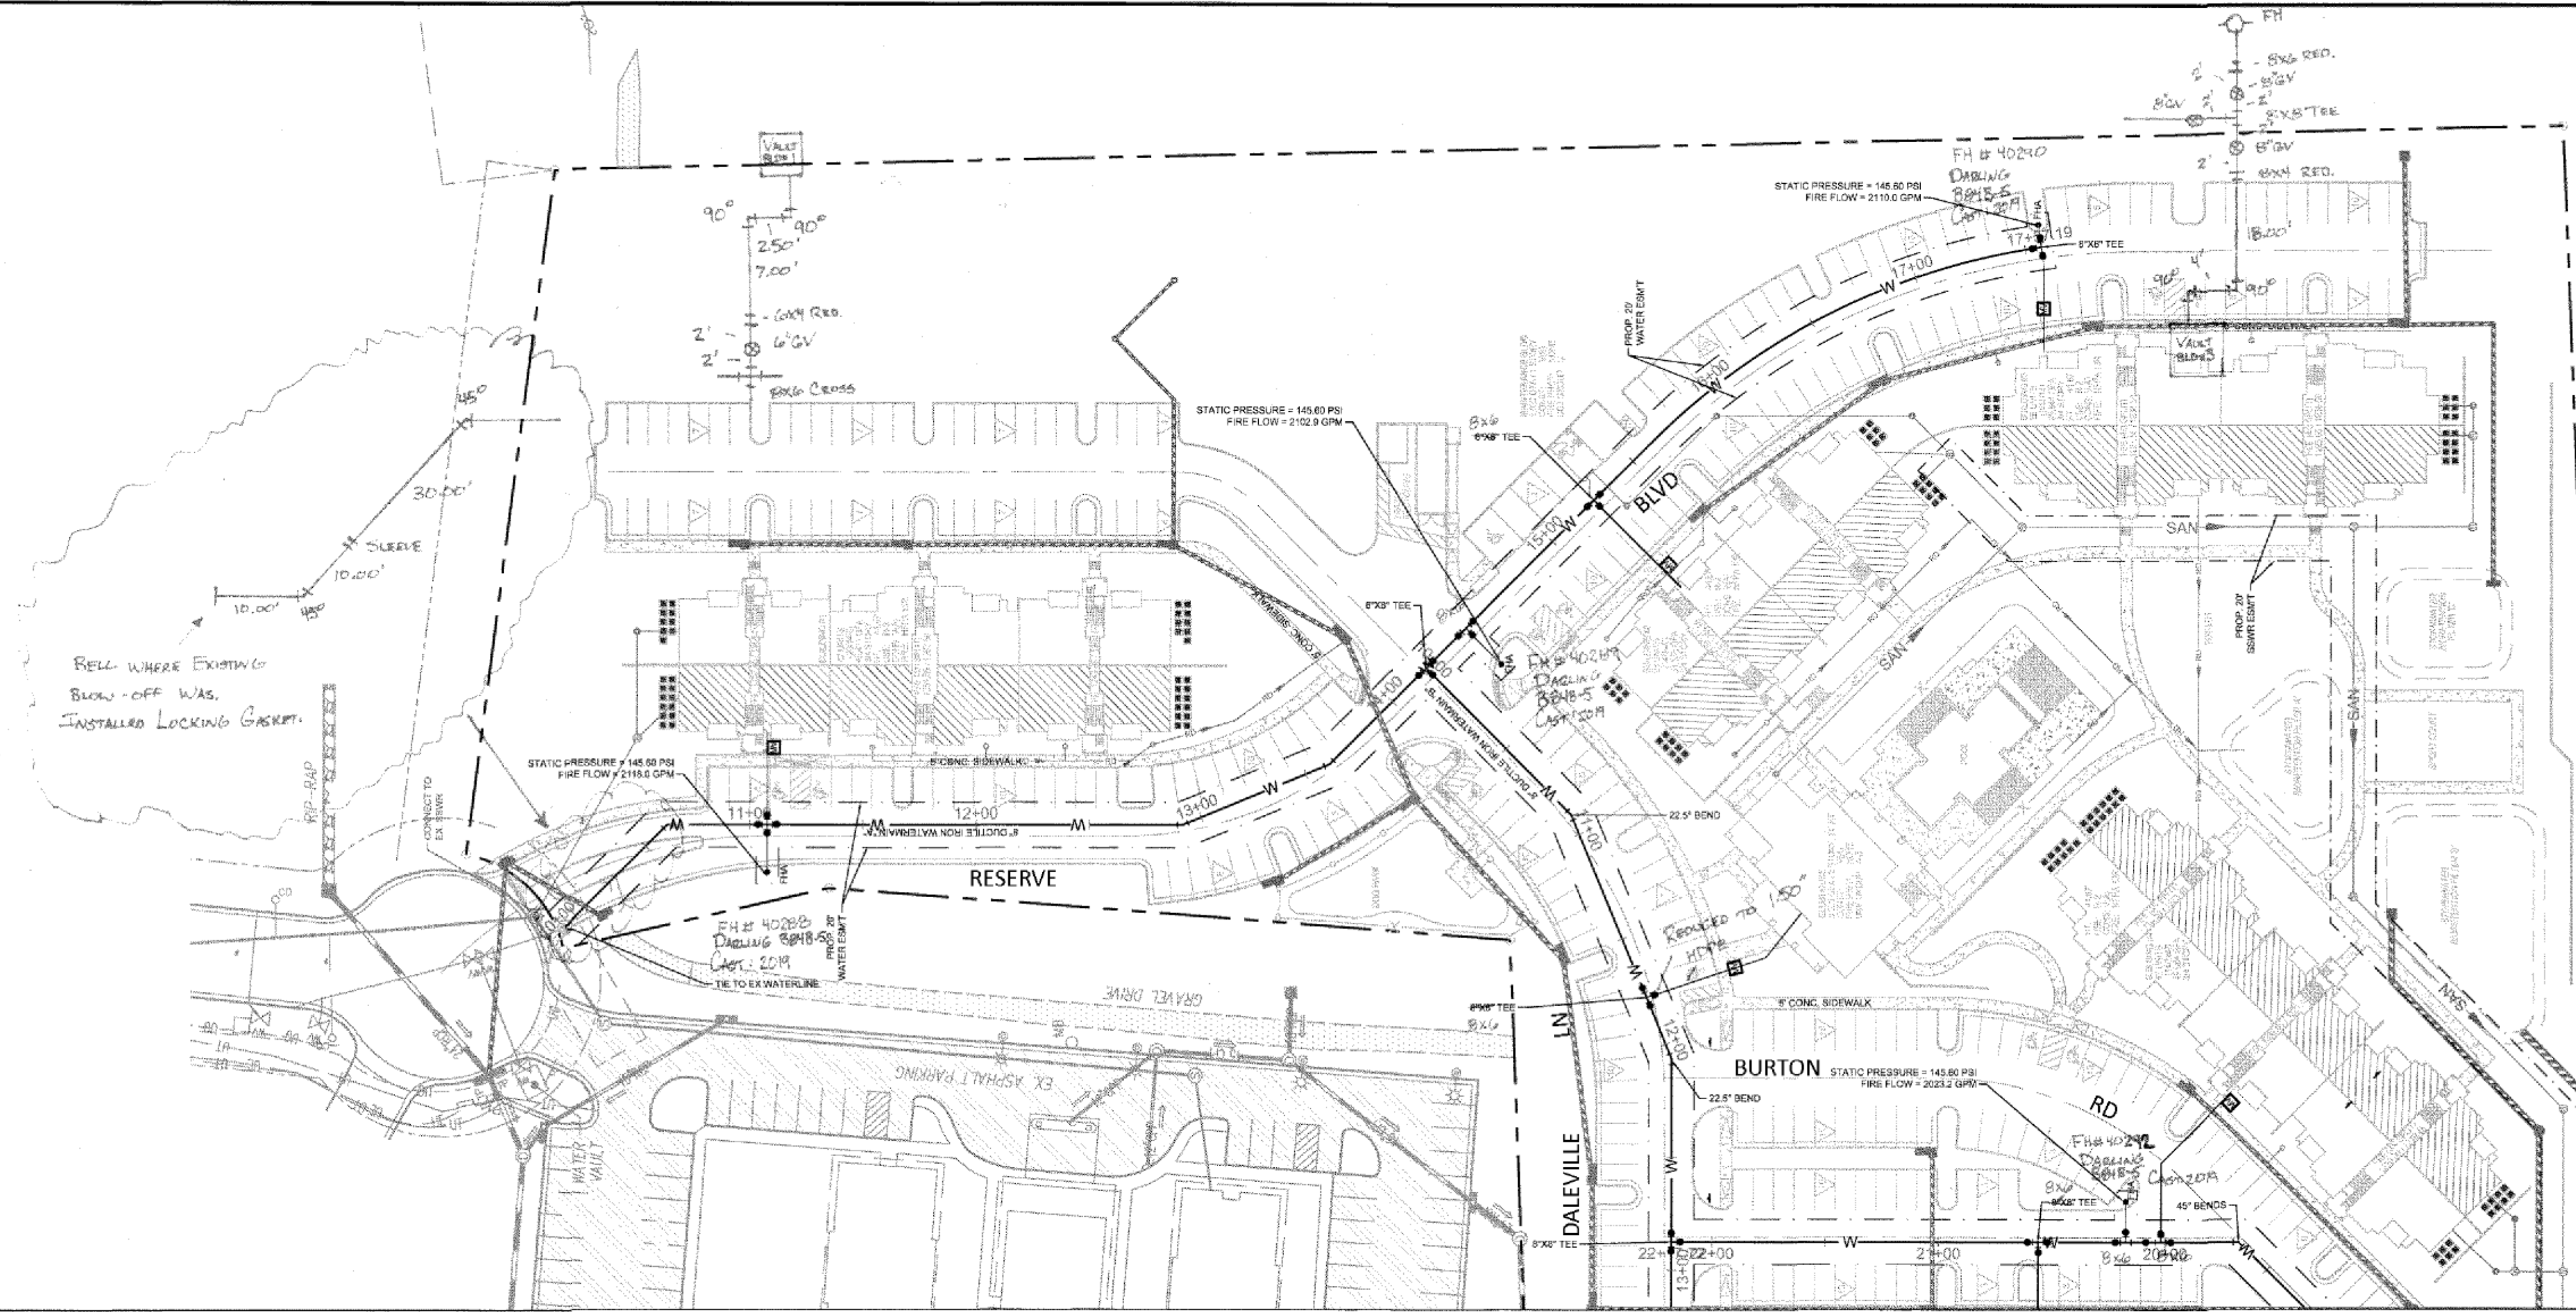

NOTES:

1. THESE SHEETS ARE PROVIDED FOR WATER PROFILE INFORMATION ONLY.



WESTERN VIRGINIA WATER AUTHORITY (WVWA) NOTES:

- ALL CONSTRUCTION METHODS AND MATERIALS SHALL CONFORM TO THE LATEST WVWA DESIGN AND CONSTRUCTION STANDARDS.
- THE CONTRACTOR OR DEVELOPER IS REQUIRED TO NOTIFY THE WVWA IN WRITING AT LEAST THREE (3) DAYS PRIOR TO ANY CONSTRUCTION. PLEASE CONTACT MARK SINK AT 537-3460.
- ALL WORK SHALL BE SUBJECT TO INSPECTION BY THE WVWA PRIOR TO SUCH CONSTRUCTION.
- THE CONTRACTOR SHALL MAINTAIN A MINIMUM OF 18" CLEARANCE VERTICALLY AND 2' MINIMUM HORIZONTALLY FROM OUTSIDE OF PIPE TO OUTSIDE OF PIPE AT ALL WATER, SANITARY SEWER CROSSINGS OF ANY OTHER UTILITIES, WHERE THIS CANNOT BE ACHIEVED ADDITIONAL MEASURES IN ACCORDANCE WITH WVWA STANDARDS SHALL BE ENFORCED.
- ANY EXISTING APPURTENANCES SHOULD BE ADJUSTED TO GRADE AND NEW FRAME AND COVERS INSTALLED WHERE REQUIRED.
- IT IS THE CONTRACTOR'S RESPONSIBILITY TO HAVE ALL EXISTING UTILITIES LOCATED AND POTHOLED TO VERIFY LOCATIONS. THIS PLAN REVIEW DOES NOT REMOVE THE CONTRACTOR'S RESPONSIBILITY TO RELOCATE ANY EXISTING CONFLICTS FOUND DURING CONSTRUCTION.

WATER NOTES:

- ALL WATER CONNECTIONS TO EXISTING LINES SHALL BE COORDINATED WITH AN PERFORMED BY THE WVWA.
- ALL WATER AND FACILITIES ARE TO BE INSTALLED ACCORDING TO THE WVWA DESIGN AND CONSTRUCTION STANDARDS.
- THE WATER SERVICE FOR THIS PROJECT WILL REQUIRE A CONCRETE VAULT. PLEASE CONTACT CLEAR FLOW AT (540) 942-3300 TO ORDER THE VAULT. THE APPLICANT IS RESPONSIBLE FOR PAYMENT, DELIVERY AND COORDINATION OF THE VAULT, AND INSTALLATION OF THE WATER SERVICE BETWEEN THE AUTHORITY MAIN AND THE VAULT INCLUDING THE TAPPING SLEEVE AND VALVE. CONTRACTOR TO EXCAVATE AND INSTALL TAPPING SLEEVE AND VALVE. THE WET TAP WILL BE MADE BY THE AUTHORITY UPON PAYMENT AND SCHEDULING.

AVAILABILITY # 18-269

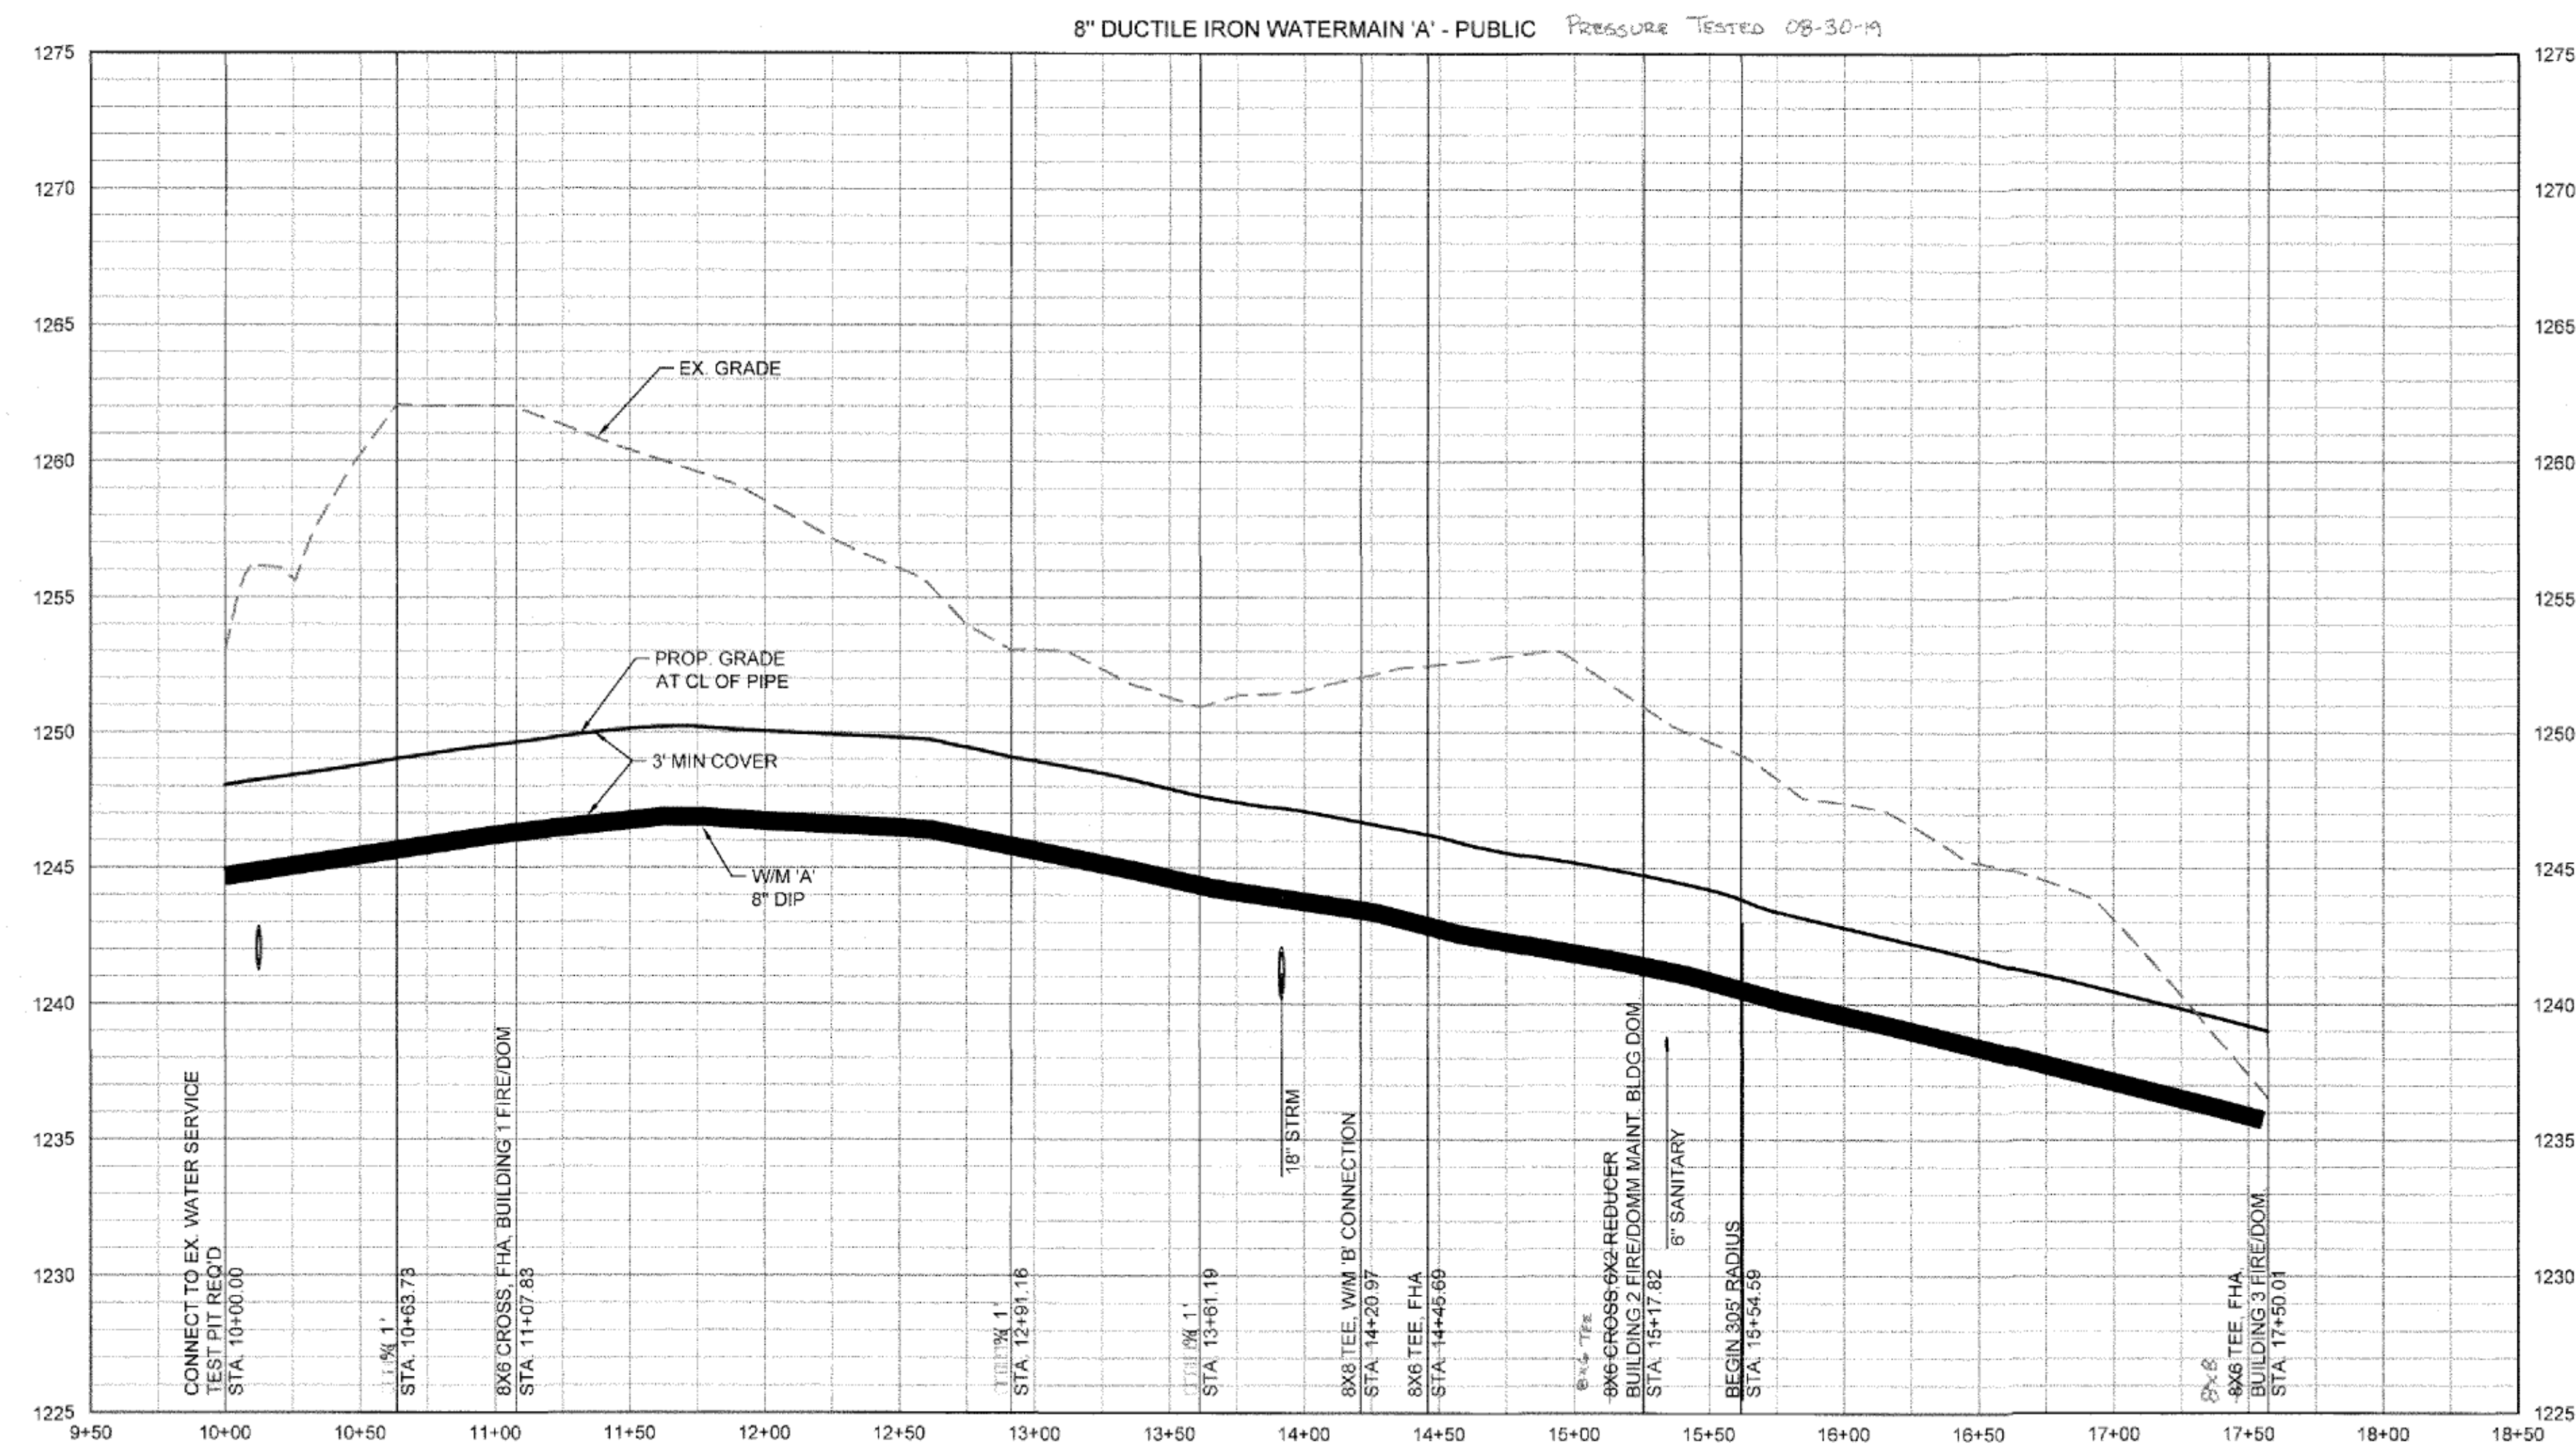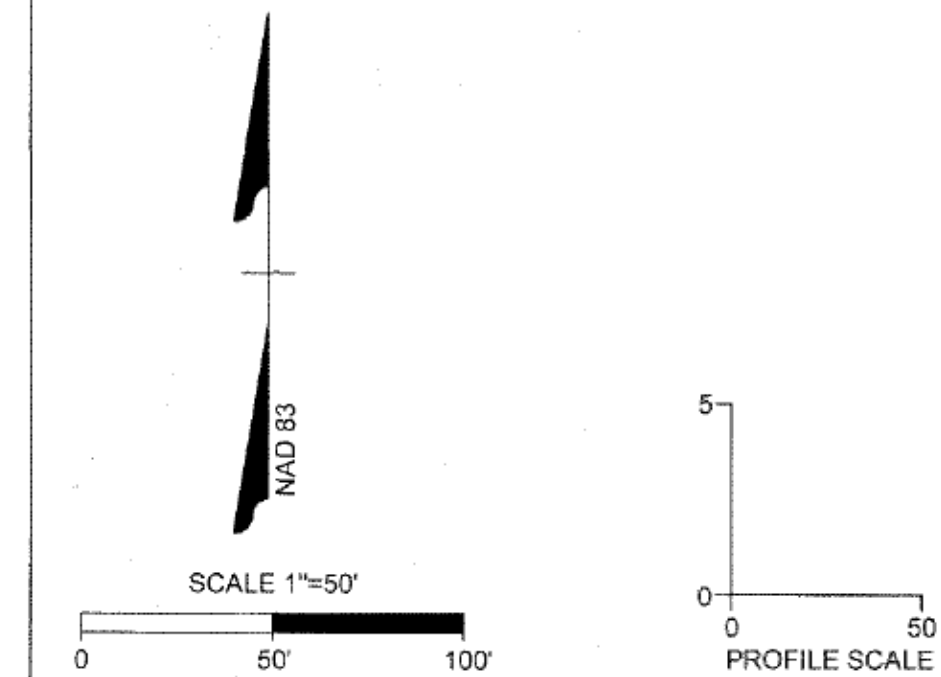

MATERIALS

- WATER: U.S. PIPE CLASS 350 DIP 8", 6", 4"
AFC GATE VALVES 8" & 6"
DARLING MODEL 8248-5 FIRE HYDRANTS
ADS POLYFLEX HDPE 150"



THIS DRAWING PREPARED AT THE
CHARLOTTSVILLE OFFICE
608 Preston Avenue, Suite 200 | Charlottesville, VA 22903
TEL 434-295-5624 FAX 434-295-8317 www.timmons.com

YOUR VISION ACHIEVED THROUGH OURS.

DATE
2018-09-07
REVISION DESCRIPTION
REVISED PER COMMENTS
DATE
2018-05-23
DRAWN BY
J WILSON
DESIGNED BY
J WILSON
CHECKED BY
C SHIFFLETT
SCALE
AS SHOWN

TIMMONS GROUP
THE RESERVE AT DALEVILLE
BOTHECOURT COUNTY, VA
WATER PROFILES
JOB NO.
40062
SHEET NO.
C8.1

These plans and associated documents are the exclusive property of TIMMONS GROUP and may not be reproduced in whole or in part and shall not be used for any purpose whatsoever, inclusive, but not limited to construction, bidding, and/or construction staking without the express written consent of TIMMONS GROUP.