

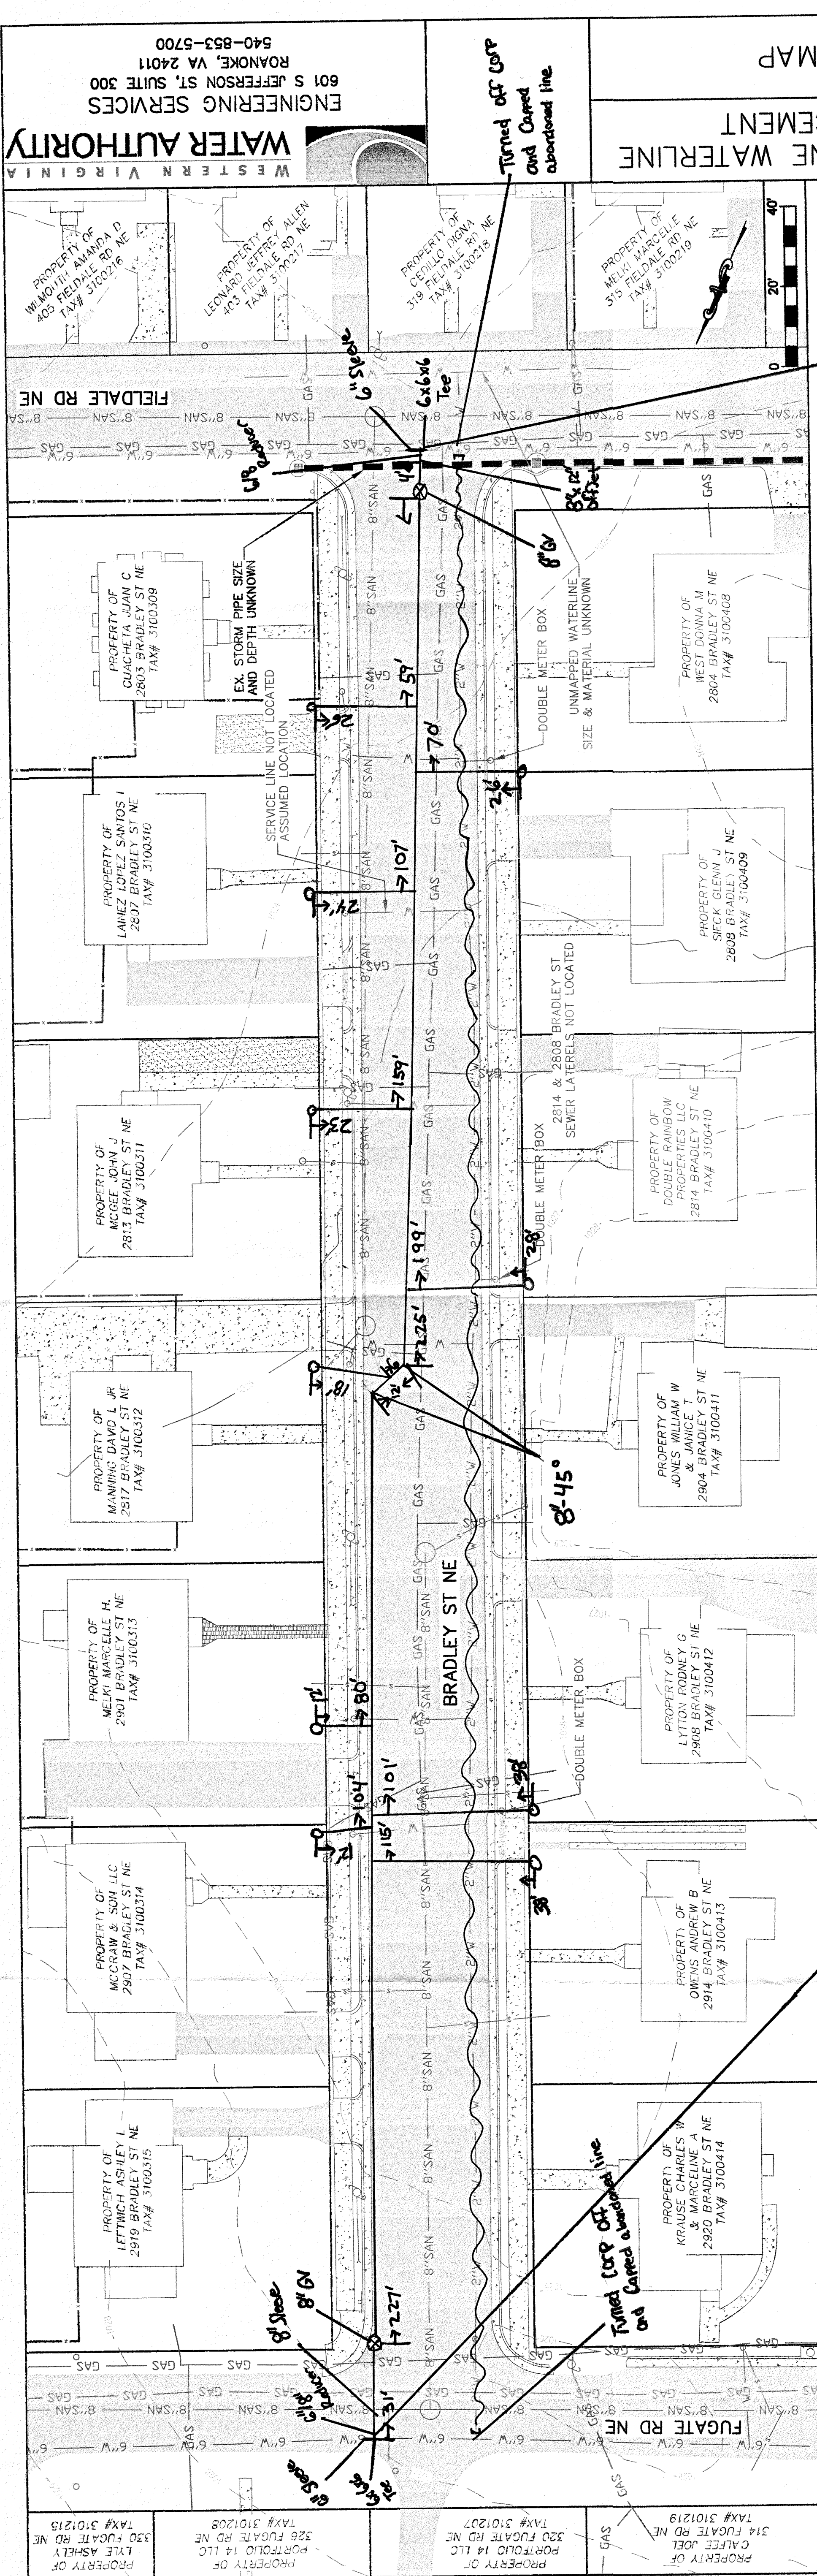


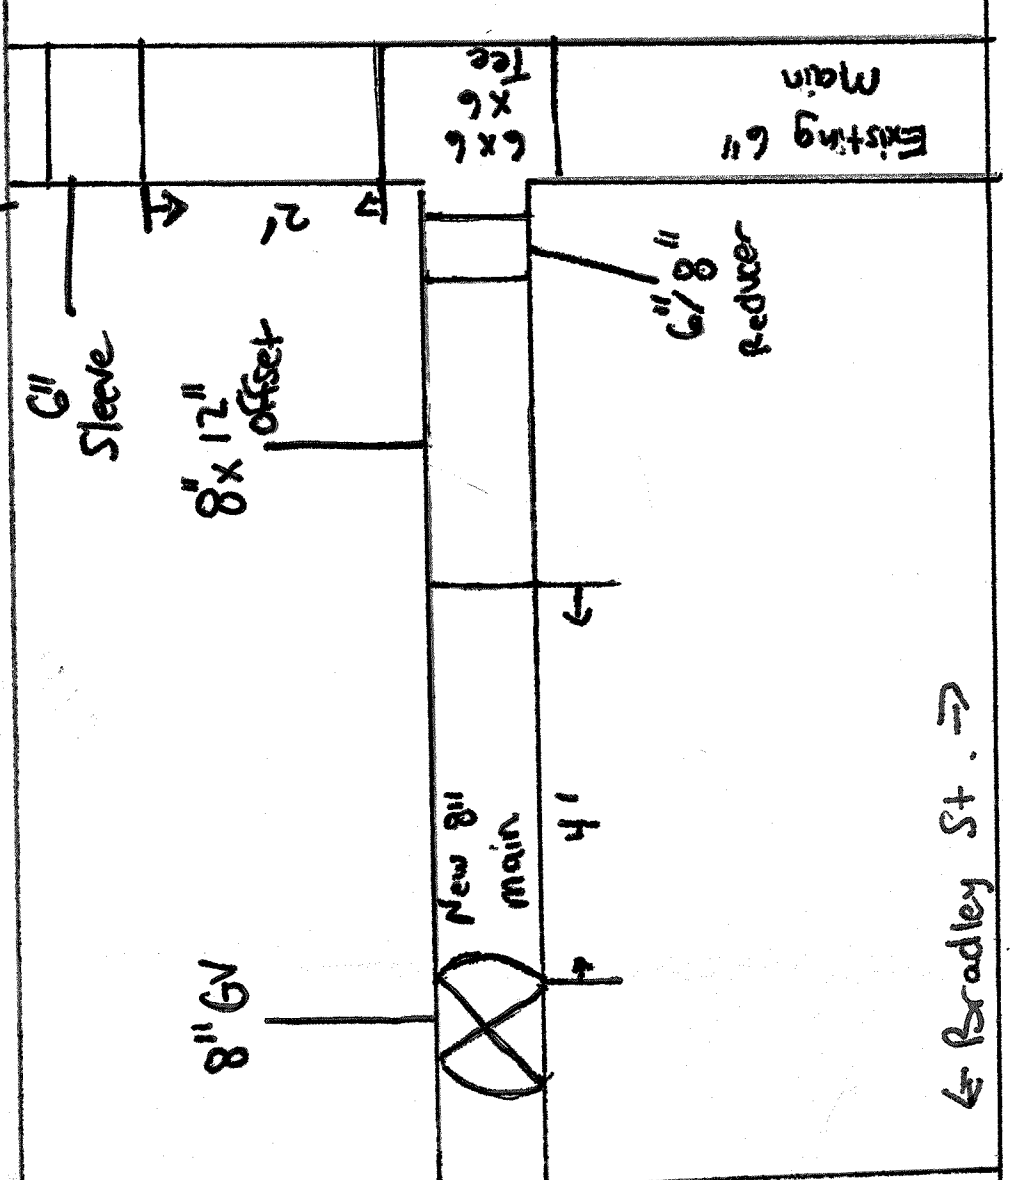

GENERAL NOTES:
SEWER LATERALS SHOWN ARE BASED ON CCTV FOOTAGE
1. PROVIDED BY PARKER DESIGN GROUP. ADDITIONAL LATERALS & CONFLICTS SHALL BE INVESTIGATED PRIOR TO EXCAVATION.
2. PROPERTY LINES SHOWN ON THIS PAGE ARE BASED ON GIS DATA AND HAVE NOT BEEN FIELD SURVEYED.

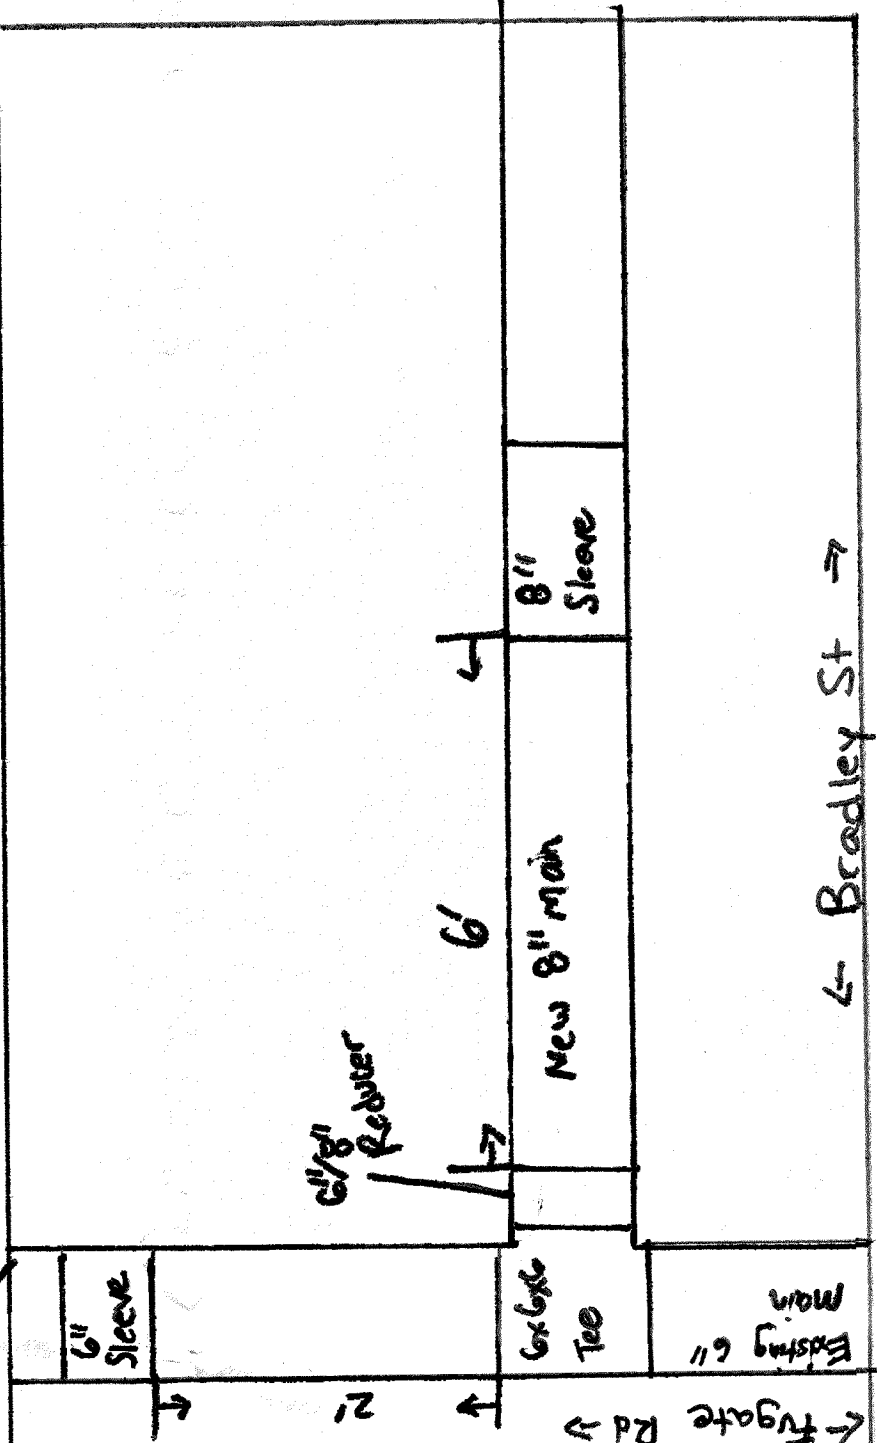

Install Contractor		Water Main(s)		Water Valve(s) 1	Water Valve(s) 2
Construction Start Date					
Completion Date					
Manufacturer					
Diameter					
Pipe Class					
Material					
Comments					
Manufacturer		Water Service(s)			
Diameter					
Pipe Class					
Material					
Comments					
Manufacturer					
Valve Type					
Diameter					
Direction to Open / Turns to Close					
Comments		Water Valve (s) 3	Water Valve (s) 4		
Manufacturer					
Valve Type					
Diameter					
Direction to Close / Turns to Close					
Comments					
Authority ID #		Hydrant(s)			
Manufacturer					
Model					
Cast Date					
Static Pressure					
Comments					

ENGINEERING SERVICES
601 S JEFFERSON ST, SUITE 300
ROANOKE, VA 24011
540-853-5700
WATER AUTHORITY
WESTERN VIRGINIA

BRADLEY ST NE WATERLINE REPLACEMENT
BASEMAP

Rev Description Date By
As builds
05/11/24 M.C.

Designed: WWA
Drawn: NSS
Checked: ARR
Approved:
Date: FEB 2024
Project: WCIP-444
1
Sheet 1 of 1