



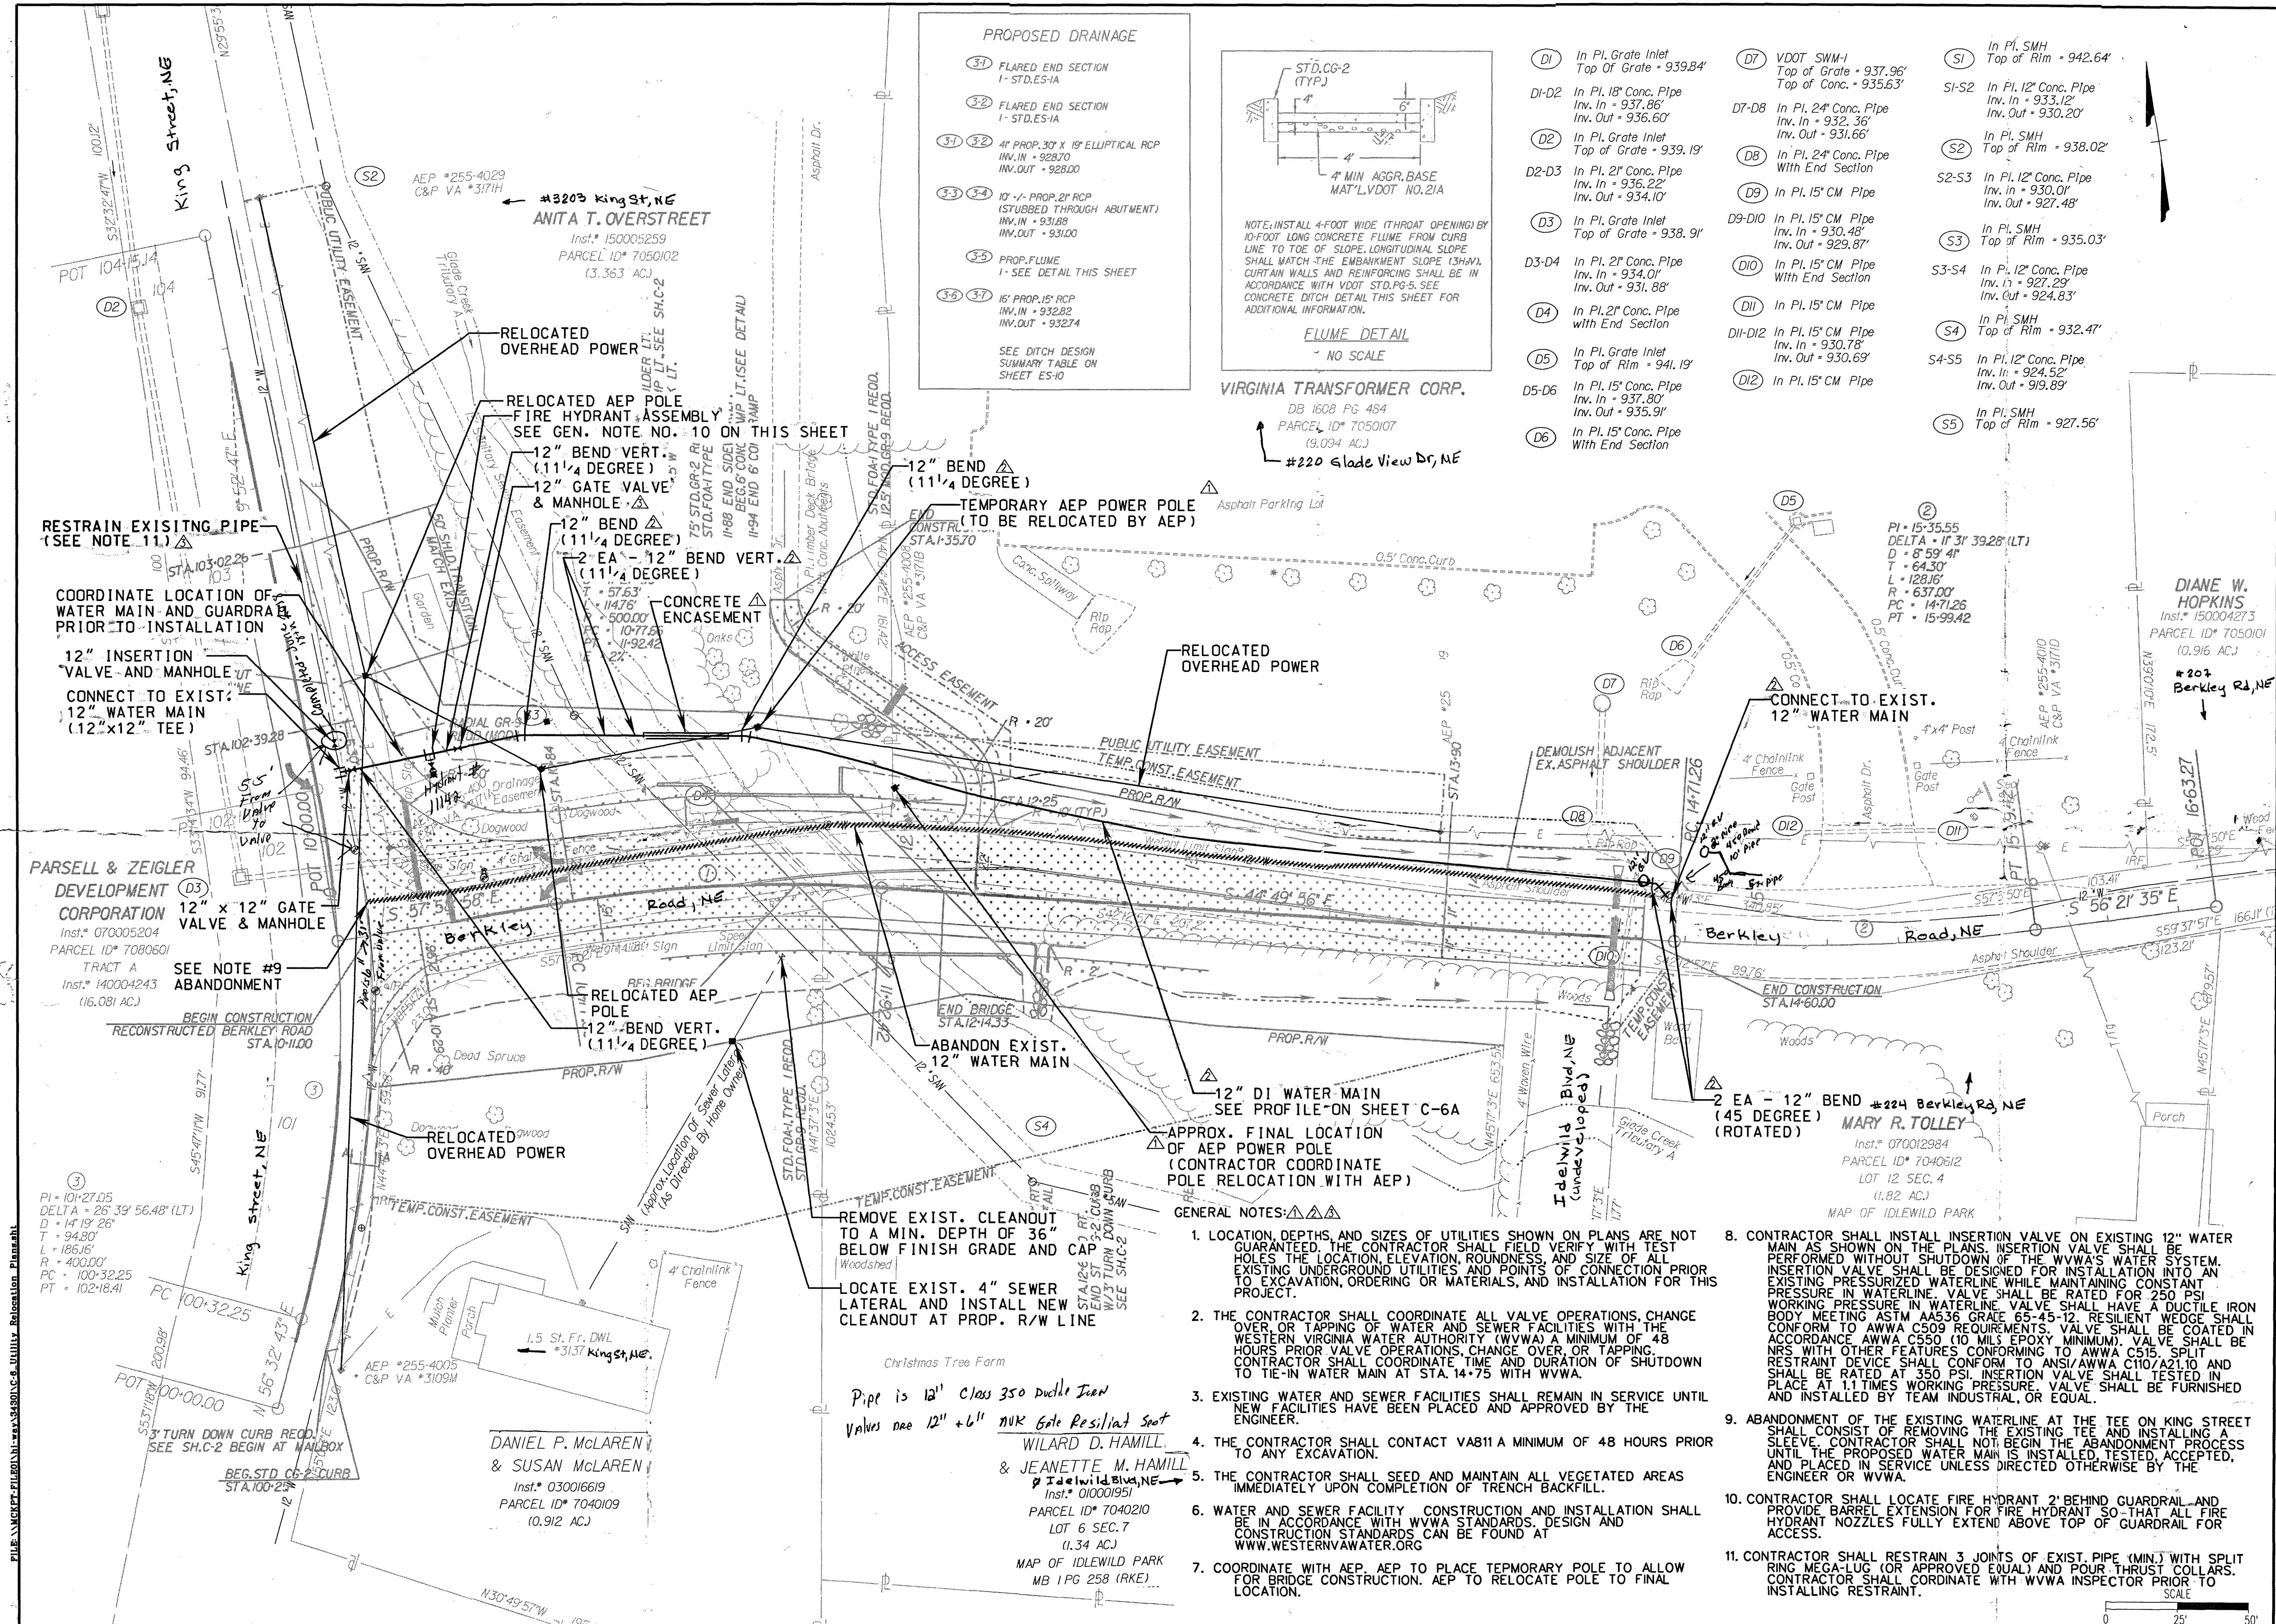

- PROPOSED DRAINAGE**
- (31) FLARED END SECTION 1- STD.E5-1A
 - (32) FLARED END SECTION 1- STD.E5-1A
 - (31) (32) 4\"/>
 - (33) (34) 10\"/>
 - (35) PROP.FLUME 1- SEE DETAIL THIS SHEET
 - (36) (37) 15\"/>
- SEE DITCH DESIGN SUMMARY TABLE ON SHEET ES-10

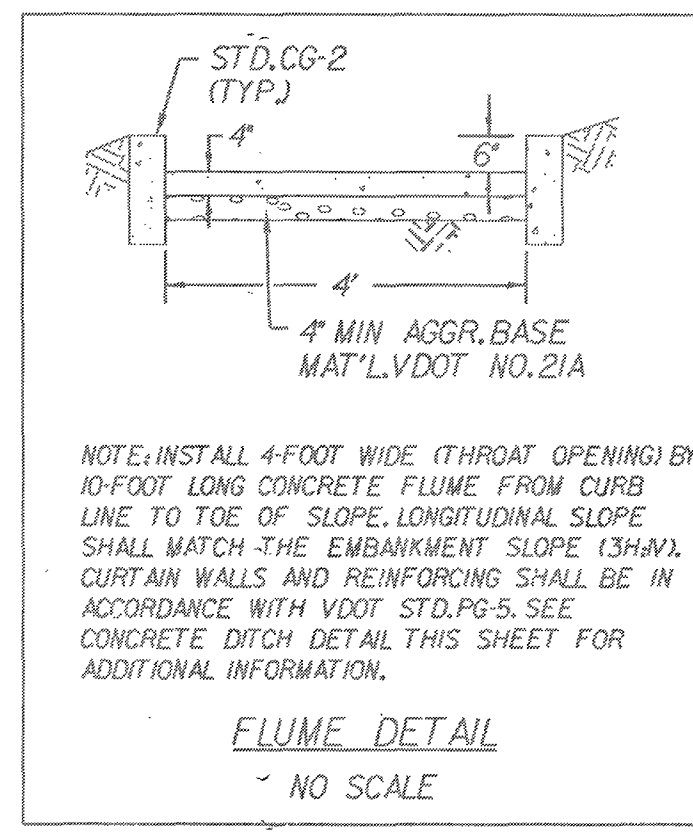

VIRGINIA TRANSFORMER CORP.
DB 1608 PG 484
PARCEL ID# 7050107
(9.094 AC.)
#220 Glade View Dr, NE

- (D1) In Pl. Grate Inlet Top Of Grate = 939.84'
- (D1-D2) In Pl. 18\"/>
- (D2) In Pl. Grate Inlet Top Of Grate = 939.19'
- (D2-D3) In Pl. 2\"/>
- (D3) In Pl. Grate Inlet Top Of Grate = 938.91'
- (D3-D4) In Pl. 2\"/>
- (D4) In Pl. 2\"/>
- (D5) In Pl. Grate Inlet Top Of Rlm = 941.19'
- (D5-D6) In Pl. 15\"/>
- (D6) In Pl. 15\"/>
- (D7) VDOT SWM-1 Top Of Grate = 937.96' Top Of Conc. = 935.63'
- (D7-D8) In Pl. 24\"/>
- (D8) In Pl. 24\"/>
- (D9) In Pl. 15\"/>
- (D9-D10) In Pl. 15\"/>
- (D10) In Pl. 15\"/>
- (D11) In Pl. 15\"/>
- (D11-D12) In Pl. 15\"/>
- (D12) In Pl. 15\"/>
- (S1) In Pl. SMH Top Of Rlm = 942.64'
- (S1-S2) In Pl. 12\"/>
- (S2) In Pl. SMH Top Of Rlm = 938.02'
- (S2-S3) In Pl. 12\"/>
- (S3) In Pl. SMH Top Of Rlm = 935.03'
- (S3-S4) In Pl. 12\"/>
- (S4) In Pl. SMH Top Of Rlm = 932.47'
- (S4-S5) In Pl. 12\"/>
- (S5) In Pl. SMH Top Of Rlm = 927.56'

COMMONWEALTH OF VIRGINIA
BRADLEY C. GREGG
L.C. No. 023879
5/8/2017
PROFESSIONAL

Revisions	Date	By	Check
1	2/12/18	RPK	RPK
2	5/25/18	RPK	RPK
3	5/31/18	RPK	RPK

Issue Date: 05/08/17

Drawn By: RPK

Designed By: RPK

Checked By: BCC

Date: 05/08/17

Matthew & Craig
ENGINEERS - SURVEYORS
701 FIRST STREET, S.W.
ROANOKE, VIRGINIA 24006
(540) 345-3542
FAX (540) 345-1651

UTILITY RELOCATION PLANS

BERKLEY-ROAD OVER GLADE CREEK TRIBUTARY A

CITY OF ROANOKE, VA

Vertical Scale: N/A

Horizontal Scale: 1" = 25'

Commission Number: 34301

Sheet No: **C-6**

Hyd #11142
year 2017
American Darling
54 B8HB-5
As-Built 02/26/2017
Contractor: Allegheny Construction