

Tax# 77-19-01-20


# DEVELOPMENT PLAN FOR CNS MEDICAL OFFICE BUILDING

SITUATED IN  
CAVE SPRING MAGISTERIAL DISTRICT  
ROANOKE COUNTY, VIRGINIA

DATE: NOVEMBER 18, 2004

PREPARED FOR  
STRUCTURES DESIGN/BUILD, LLC

DEVELOPMENT PLAN APPROVED FOR CONSTRUCTION BY ROANOKE COUNTY	
Department	Date
Development Review	EB 2/11/05
Engineering	WLS 2/7/05
Water & Sewer	RRB 2/11/05
Planning & Zoning	JM 2/11/05

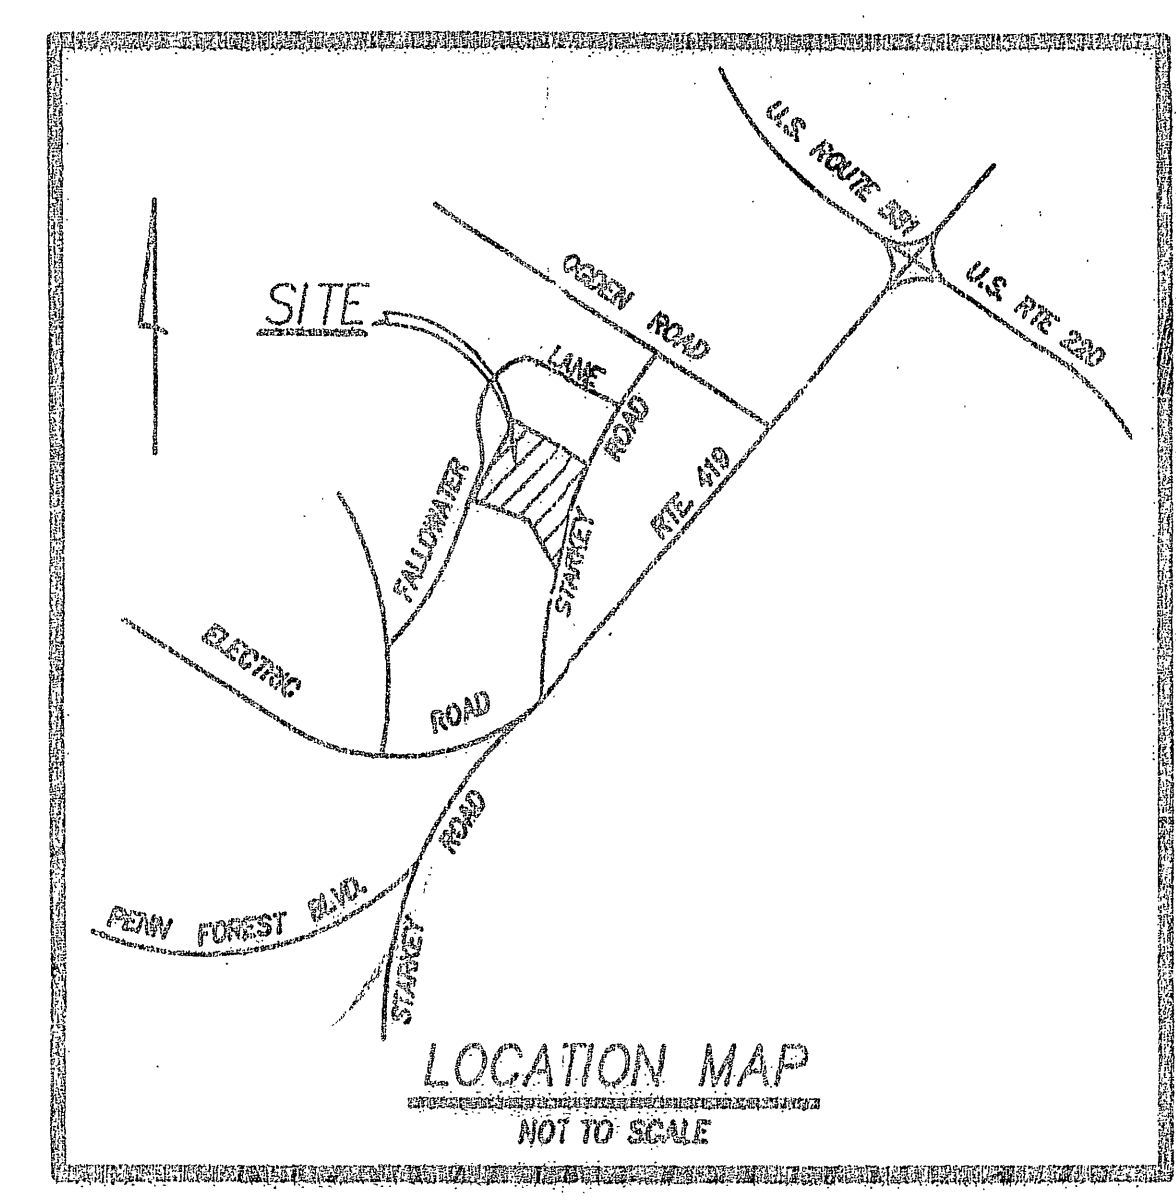


--INDEX OF DRAWINGS--


SHEET No.	DESCRIPTION
1	LUMSDEN ASSOCIATES COVER SHEET
2	ROANOKE COUNTY STANDARD COVER SHEET
3	NOTES AND DETAILS
4	DIMENSIONAL LAYOUT
5	GRADING PLAN
6	PROFILES
7	LANDSCAPE PLAN
8	EROSION AND SEDIMENT CONTROL PLAN
9	EROSION AND SEDIMENT CONTROL NOTES AND DETAILS

I AM CERTIFIED BY THE STATE OF VIRGINIA AS A "RESPONSIBLE LAND DISTURBER". I SHALL BE RESPONSIBLE FOR THE IMPLEMENTATION OF THE EROSION AND SEDIMENT CONTROL PLAN AS SHOWN.

SIGNATURE: \_\_\_\_\_  
 PRINTED NAME: \_\_\_\_\_  
 CERTIFICATE No.: \_\_\_\_\_  
 EXPIRATION DATE: \_\_\_\_\_  
 TELEPHONE No.: \_\_\_\_\_  
 ADDRESS: \_\_\_\_\_

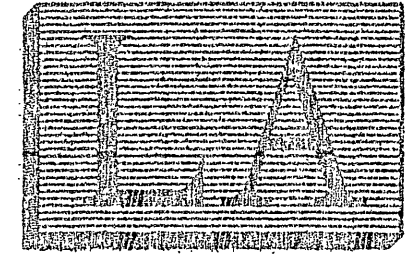 **LUMSDEN ASSOCIATES, P.C.**  
**ENGINEERS-SURVEYORS-PLANNERS**

4664 BRAMBLETON AVENUE, SW      PHONE: (540) 774-4411  
 P.O. BOX 20669      FAX: (540) 772-9445  
 ROANOKE, VIRGINIA 24018      E-MAIL: MAIL@LUMSDENPC.COM

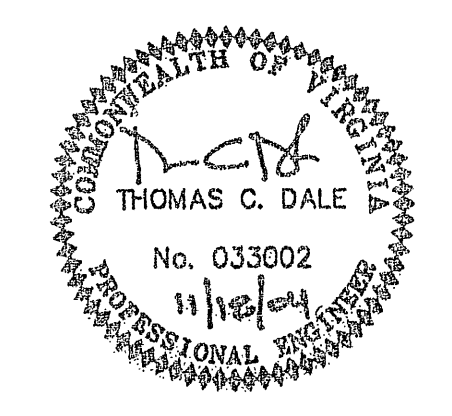

AS-BUILT

COMMISSION NO. 2002-283S

WWW.ID# 6REH55

12/18/05 received by Insp. Office

REVISIONS	
DATE	SHEETS

COMMISSION NO. 2002-283S  
 SHEET 1 OF 9

CNS/MEDICAL AS BUILT