



PLAN	SHEET	NO.
	DATE	
NOTE BOOK	NOTED	BY
	REVISIONS	BY

PROFILE	SHEET	NO.
	DATE	
NOTE BOOK	NOTED	BY
	REVISIONS	BY

CENTERLINE CURVE DATA

CURVE "A" (TOTAL)		CURVE "B"		CURVE "C-1"		CURVE "C-2"	
Δ	61° 42' 21"	Δ	59° 18' 31"	Δ	12° 50' 31"	Δ	4° 34' 15"
T	191.42'	T	157.98'	T	77.65'	T	28.27'
R	220.00'	R	295.00'	R	680.00'	R	800.00'
A	236.93'	A	305.26'	A	154.65'	A	116.38'
CH	226.65'	CH	291.91'	CH	154.65'	CH	116.13'
CH.B	N 35° 43' 56" W	CH.B	N 34° 22' 01" W	CH.B	N 88° 05' 58" W	CH.B	S 15° 46' 07" W

(NOTE: SUPERELEVATE CURVE "B" AS PER V.O.H. & T. SPEC'S.)

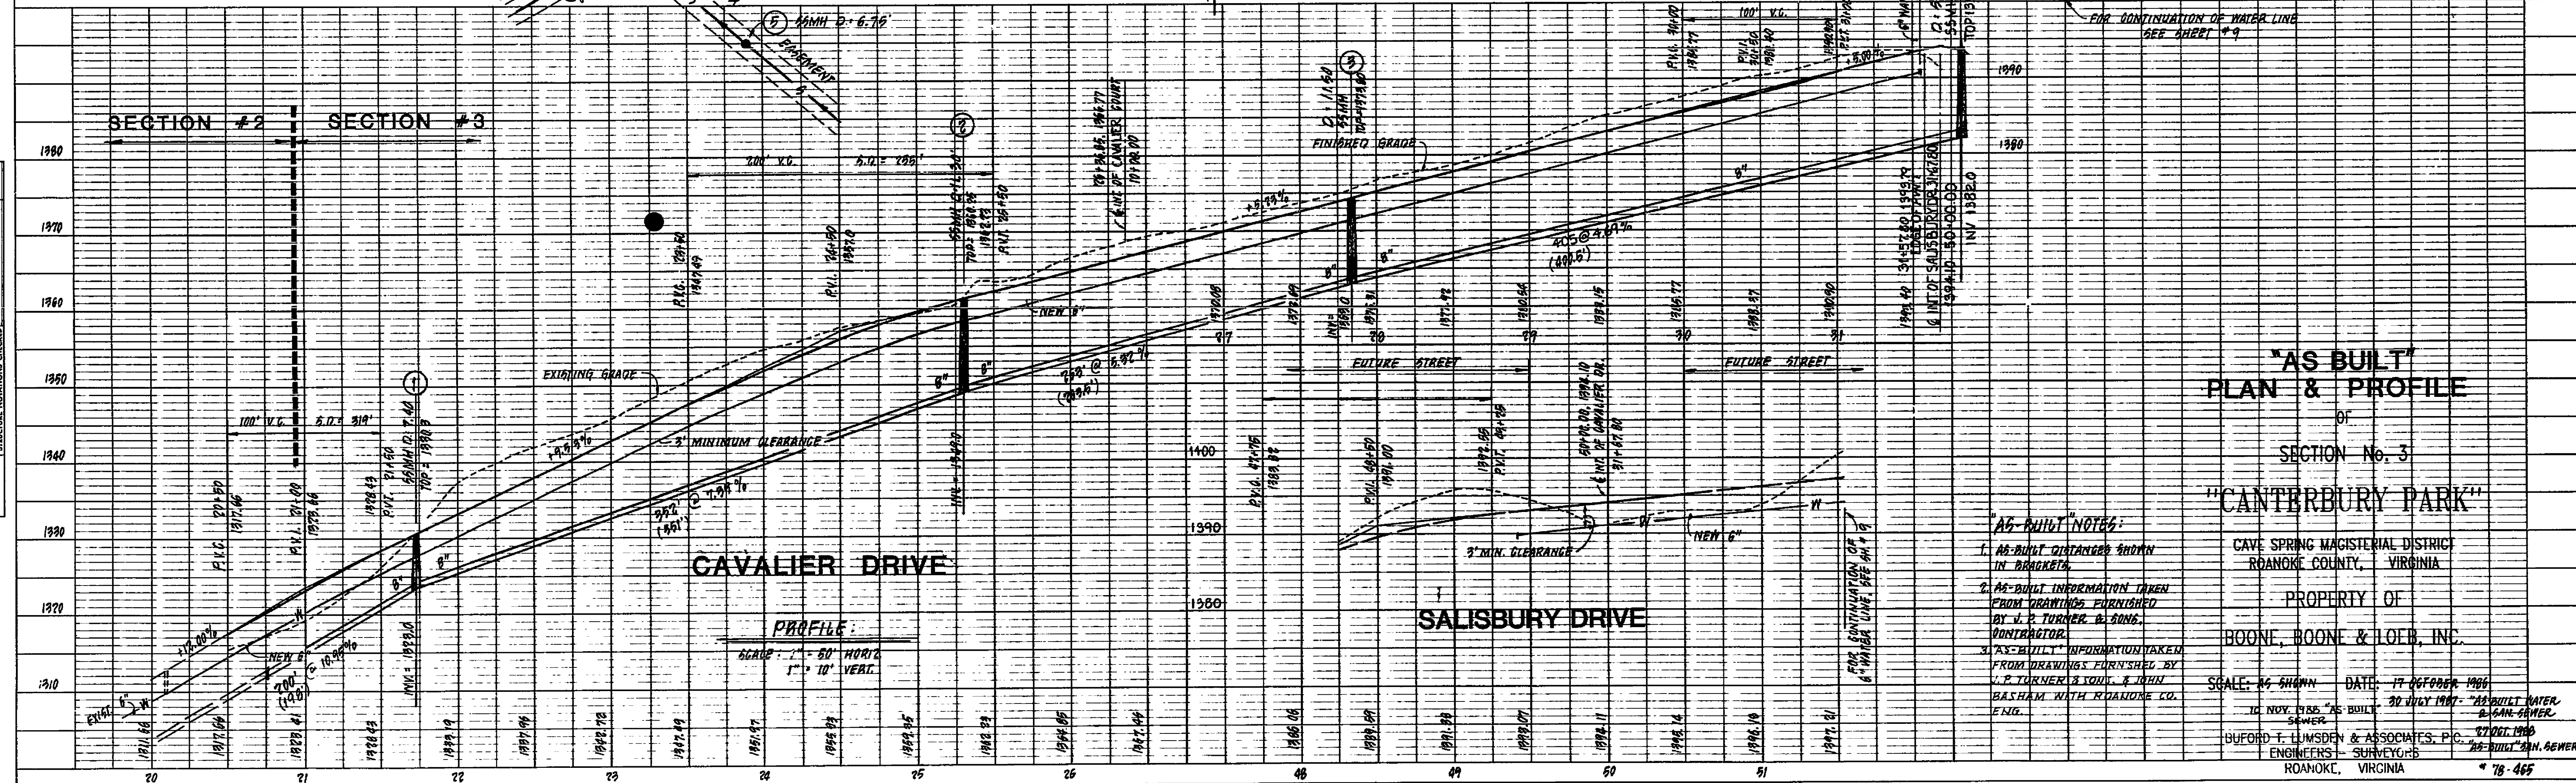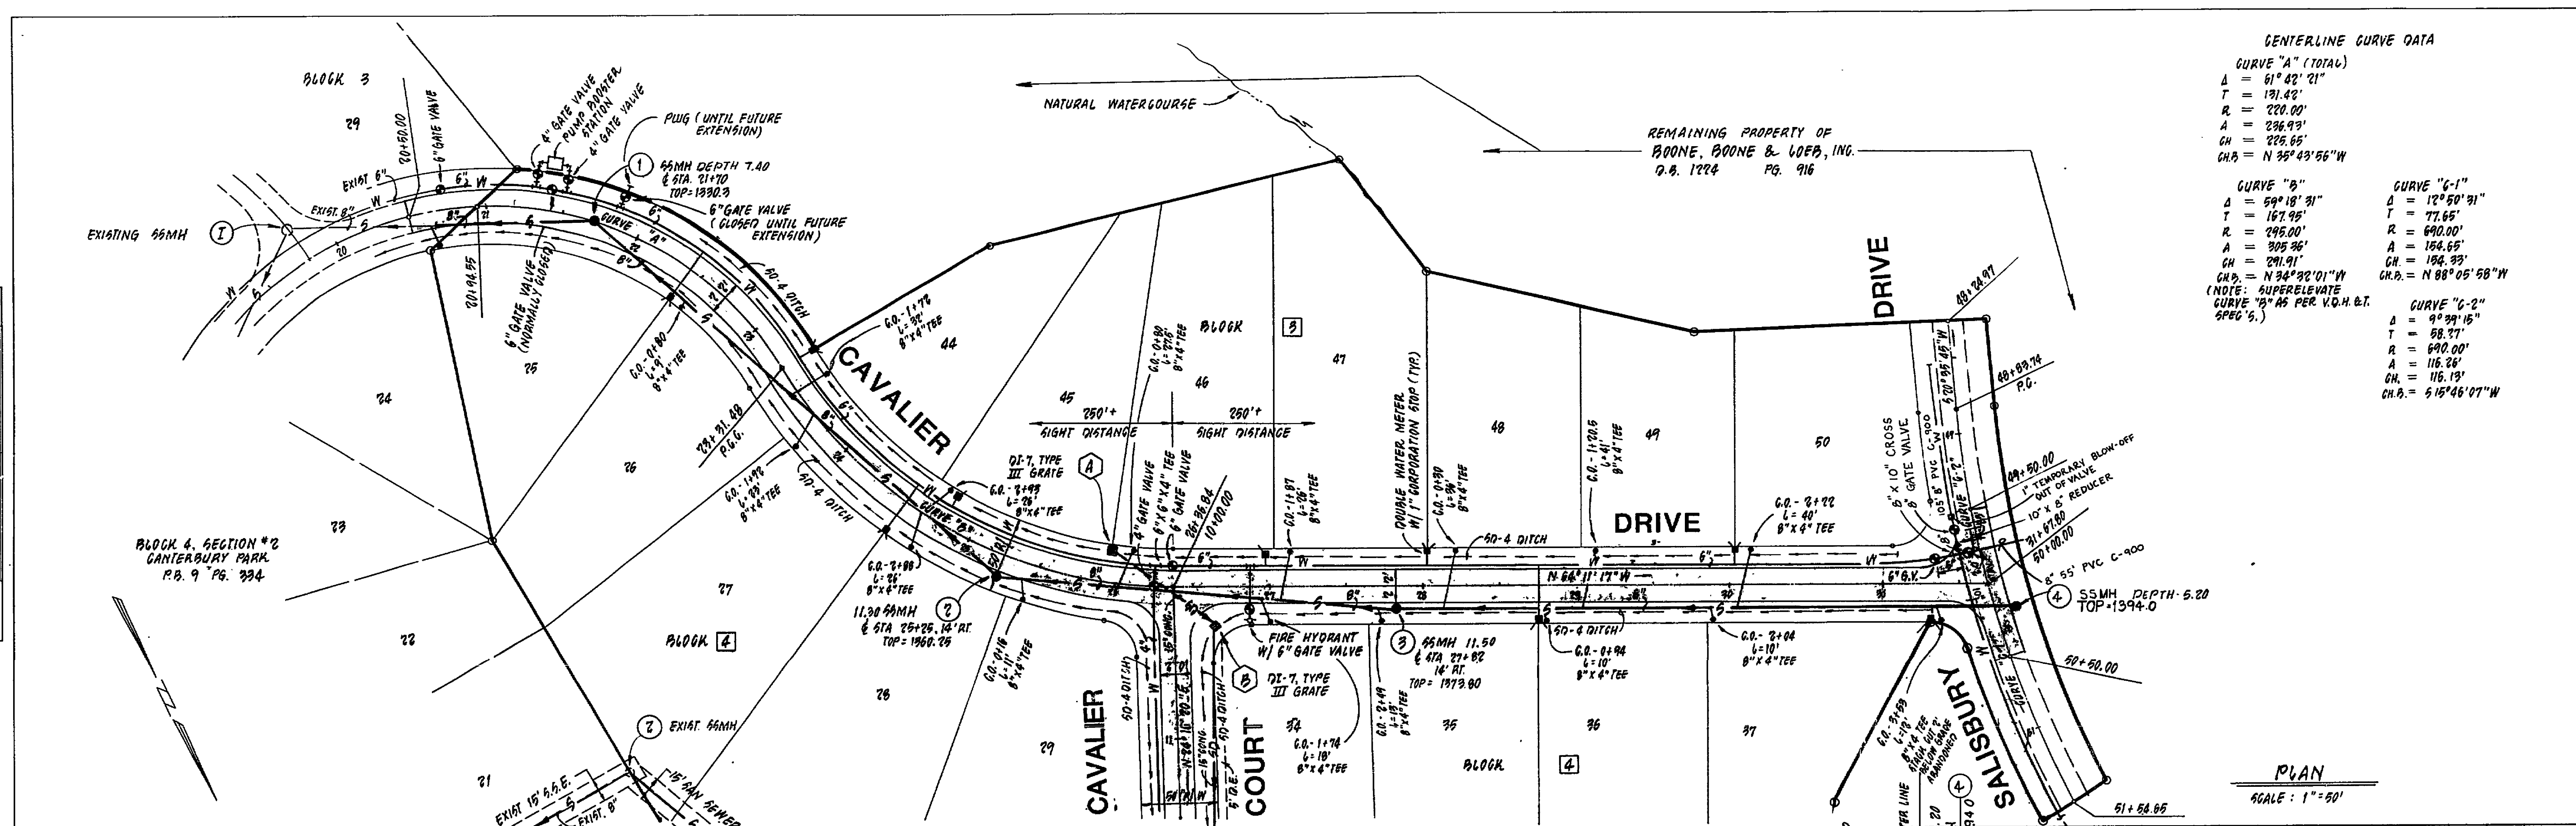

"AS BUILT" PLAN & PROFILE
OF
SECTION No. 3
"CANTERBURY PARK"

CAVE SPRING MAGISTERIAL DISTRICT
ROANOKE COUNTY, VIRGINIA

PROPERTY OF
BOONE, BOONE & LOEB, INC.

SCALE: AS SHOWN DATE: 17-SEP-1980

BY: J. L. LUMSDEN & ASSOCIATES, P.C.
ENGINEERS - SURVEYORS
ROANOKE, VIRGINIA

78-465

PLATE 1-SINGLE PLAN AND PROFILE-FULL LINE
PRINTED IN U.S.A.

RC-1246 SHEET #7 OF 14