


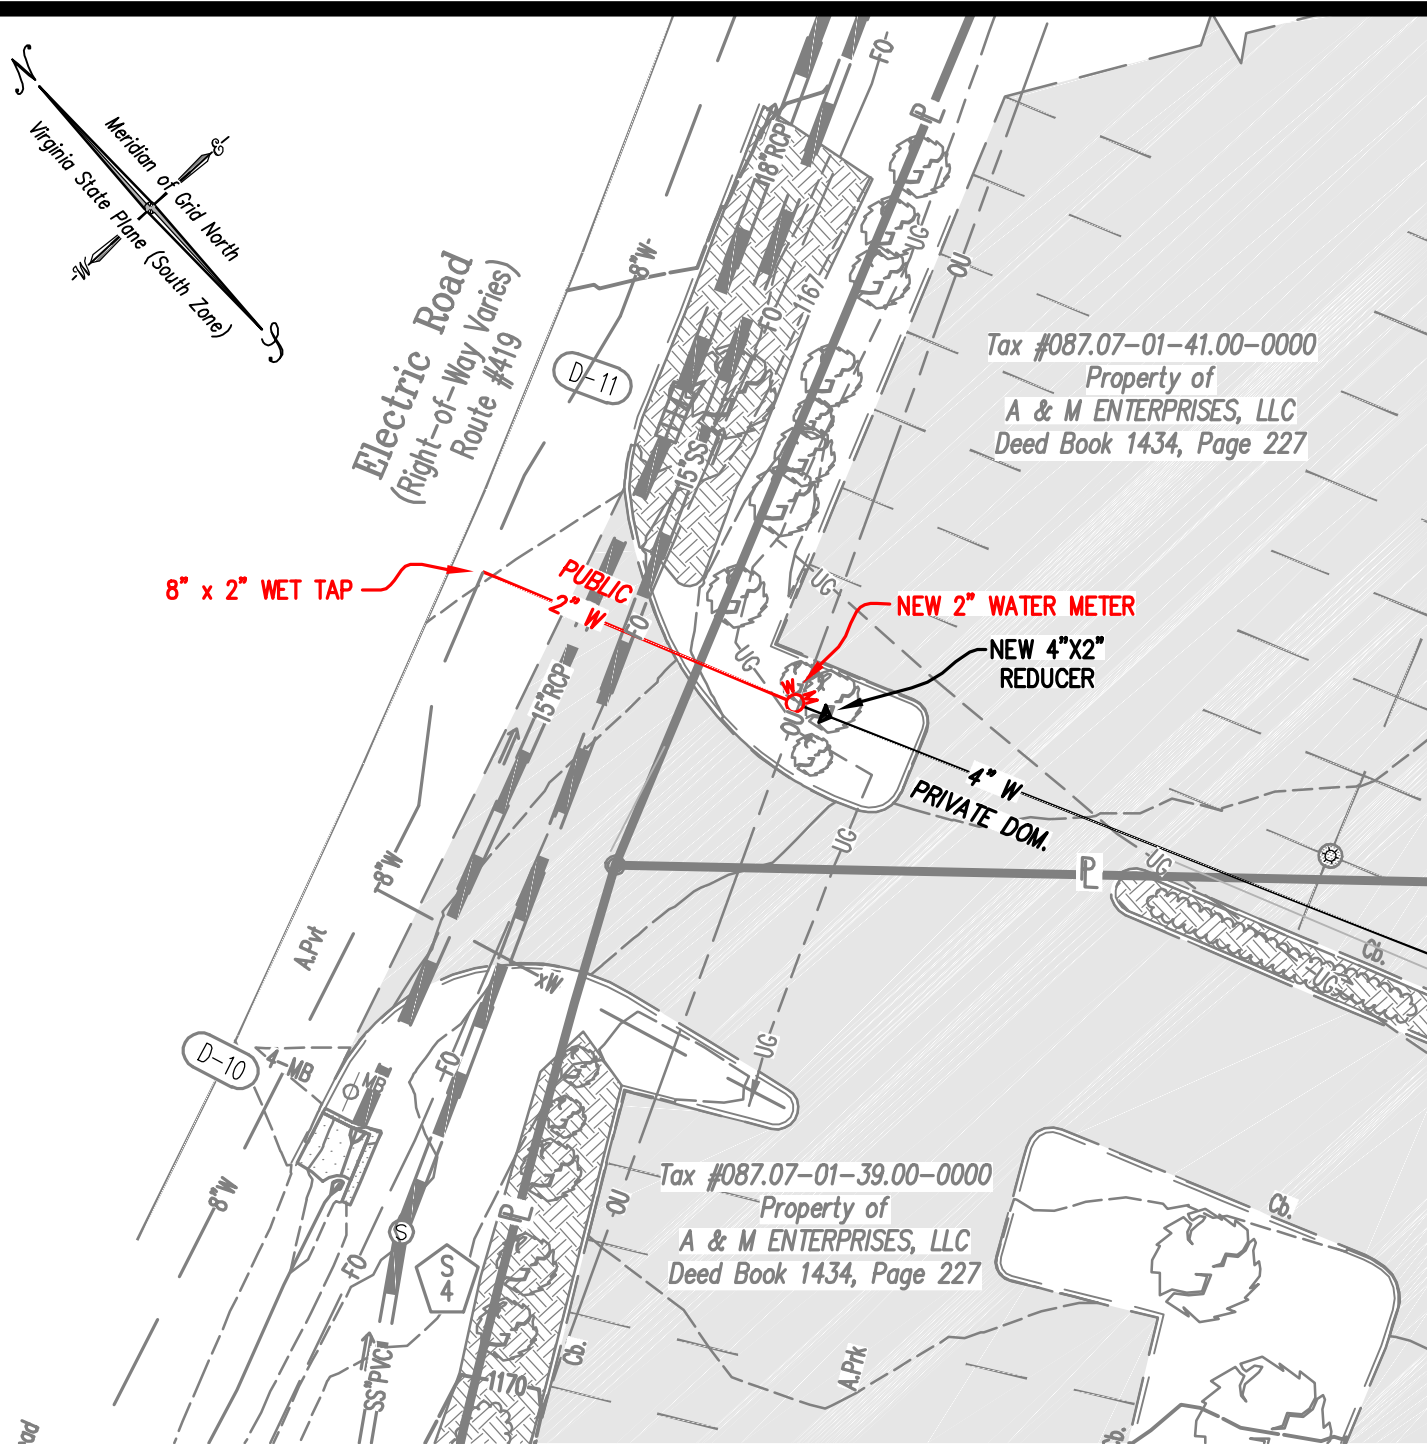

NEW WATER METER
NORTHING: 3608498.45
EASTING: 11051033.54
ELEVATION: 1168.49 (METER TOP)

NEW WATER CONNECTION / TAP
NORTHING: 3608530.43
EASTING: 11051018.79
ELEVATION: 1165.88 (GROUND ELEV)
ELEVATION: 1159.38 (TAP ELEV)


SURVEY CONTROL PROVIDED / UTILIZED:

△ **CONTROL POINT No. 10000**
NORTHING: 3608372.26
EASTING: 11050806.36
ELEVATION: 1182.66


△ **CONTROL POINT No. 10001**
NORTHING: 3608575.58
EASTING: 11051214.31
ELEVATION: 1163.02

AS-BUILT

AS-BUILT INFORMATION SHOWN ON THIS PLAN IS THE RESULT OF A FIELD SURVEY PERFORMED BY LUMSDEN ASSOCIATES, P.C. OR AS SUPPLIED BY SITEPRO, INC (CONTRACTOR) FIELD MARKUPS.

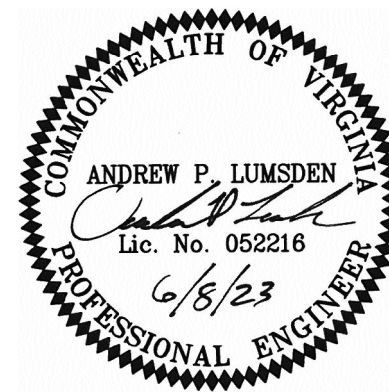

WWWA
AS-BUILT PLAN
"CARILION VELOCITY CARE"
4037 ELECTRIC ROAD
ROANOKE COUNTY, VIRGINIA

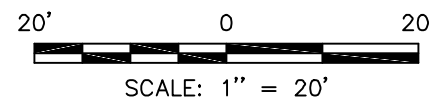

Lumsden Associates, P.C.
ENGINEERS | SURVEYORS | PLANNERS

4664 BRAMBLETON AVENUE
P.O. BOX 20669
ROANOKE, VIRGINIA 24018

PHONE: (540) 774-4411
FAX: (540) 772-9445
WWW.LUMSDENPC.COM

DATE:	June 8, 2023
COMM. NO.:	22-257 & 23-112
SCALE:	1" = 20'