



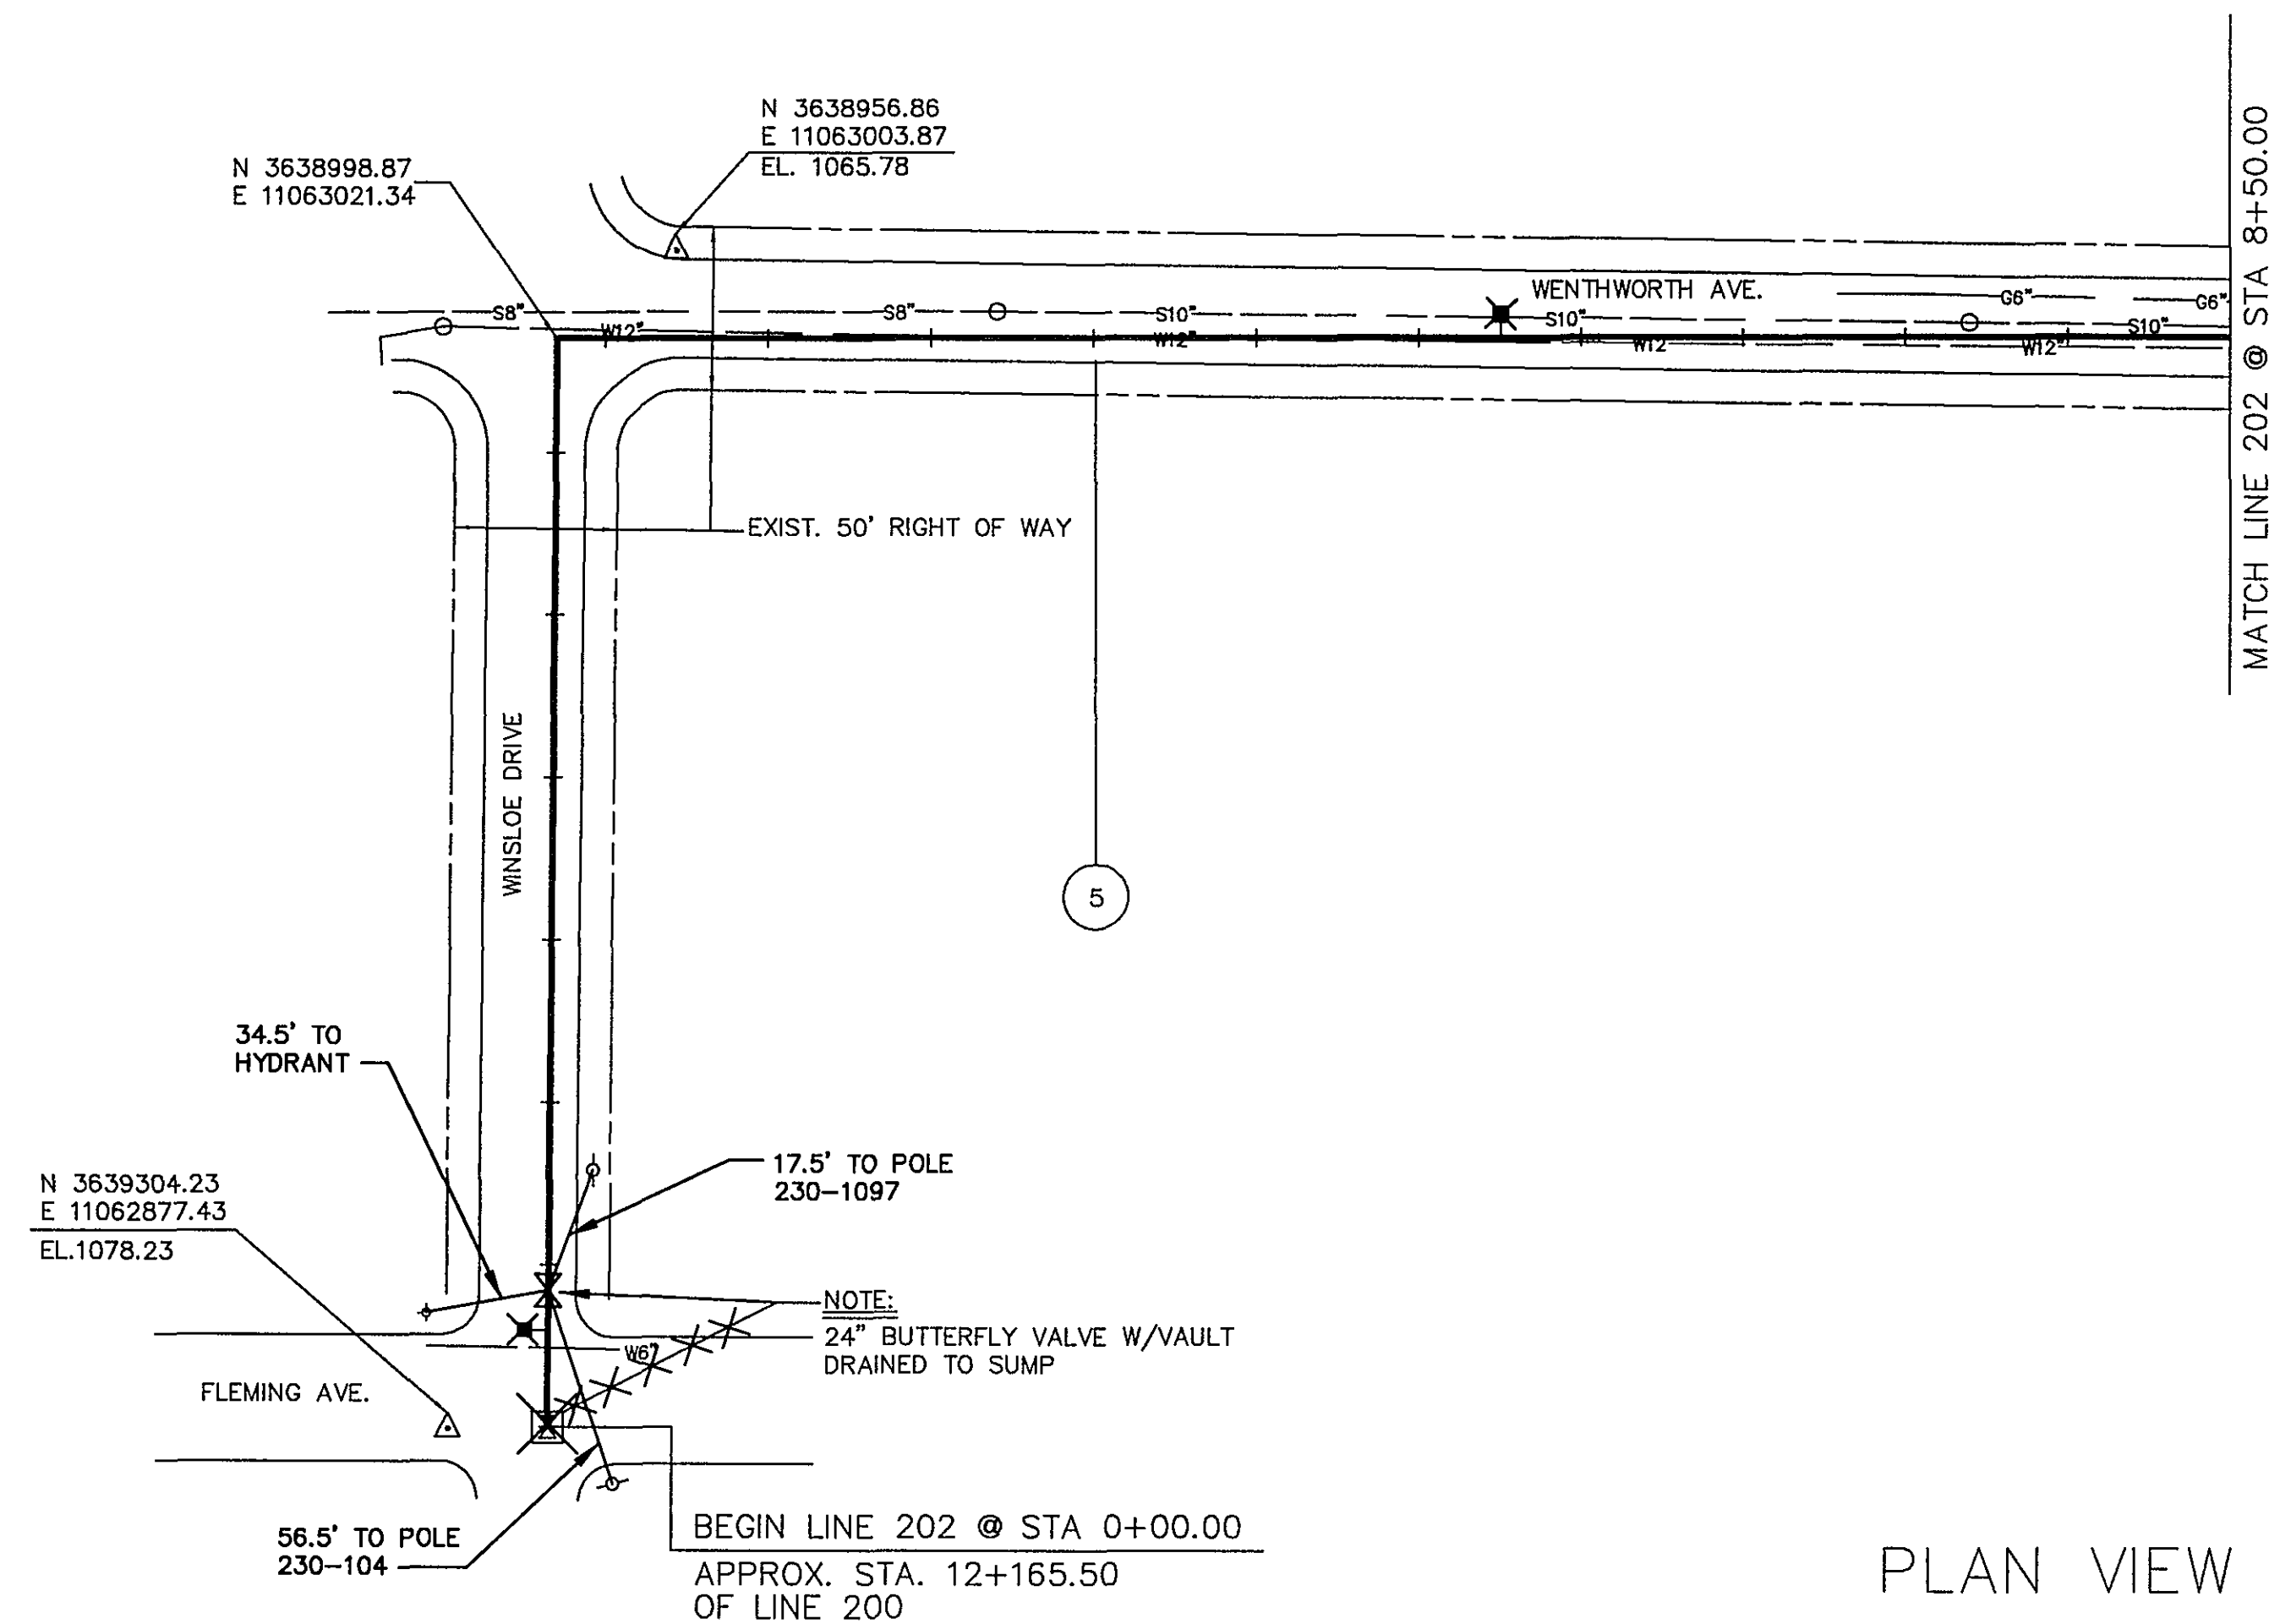

PLAN VIEW LINE 202

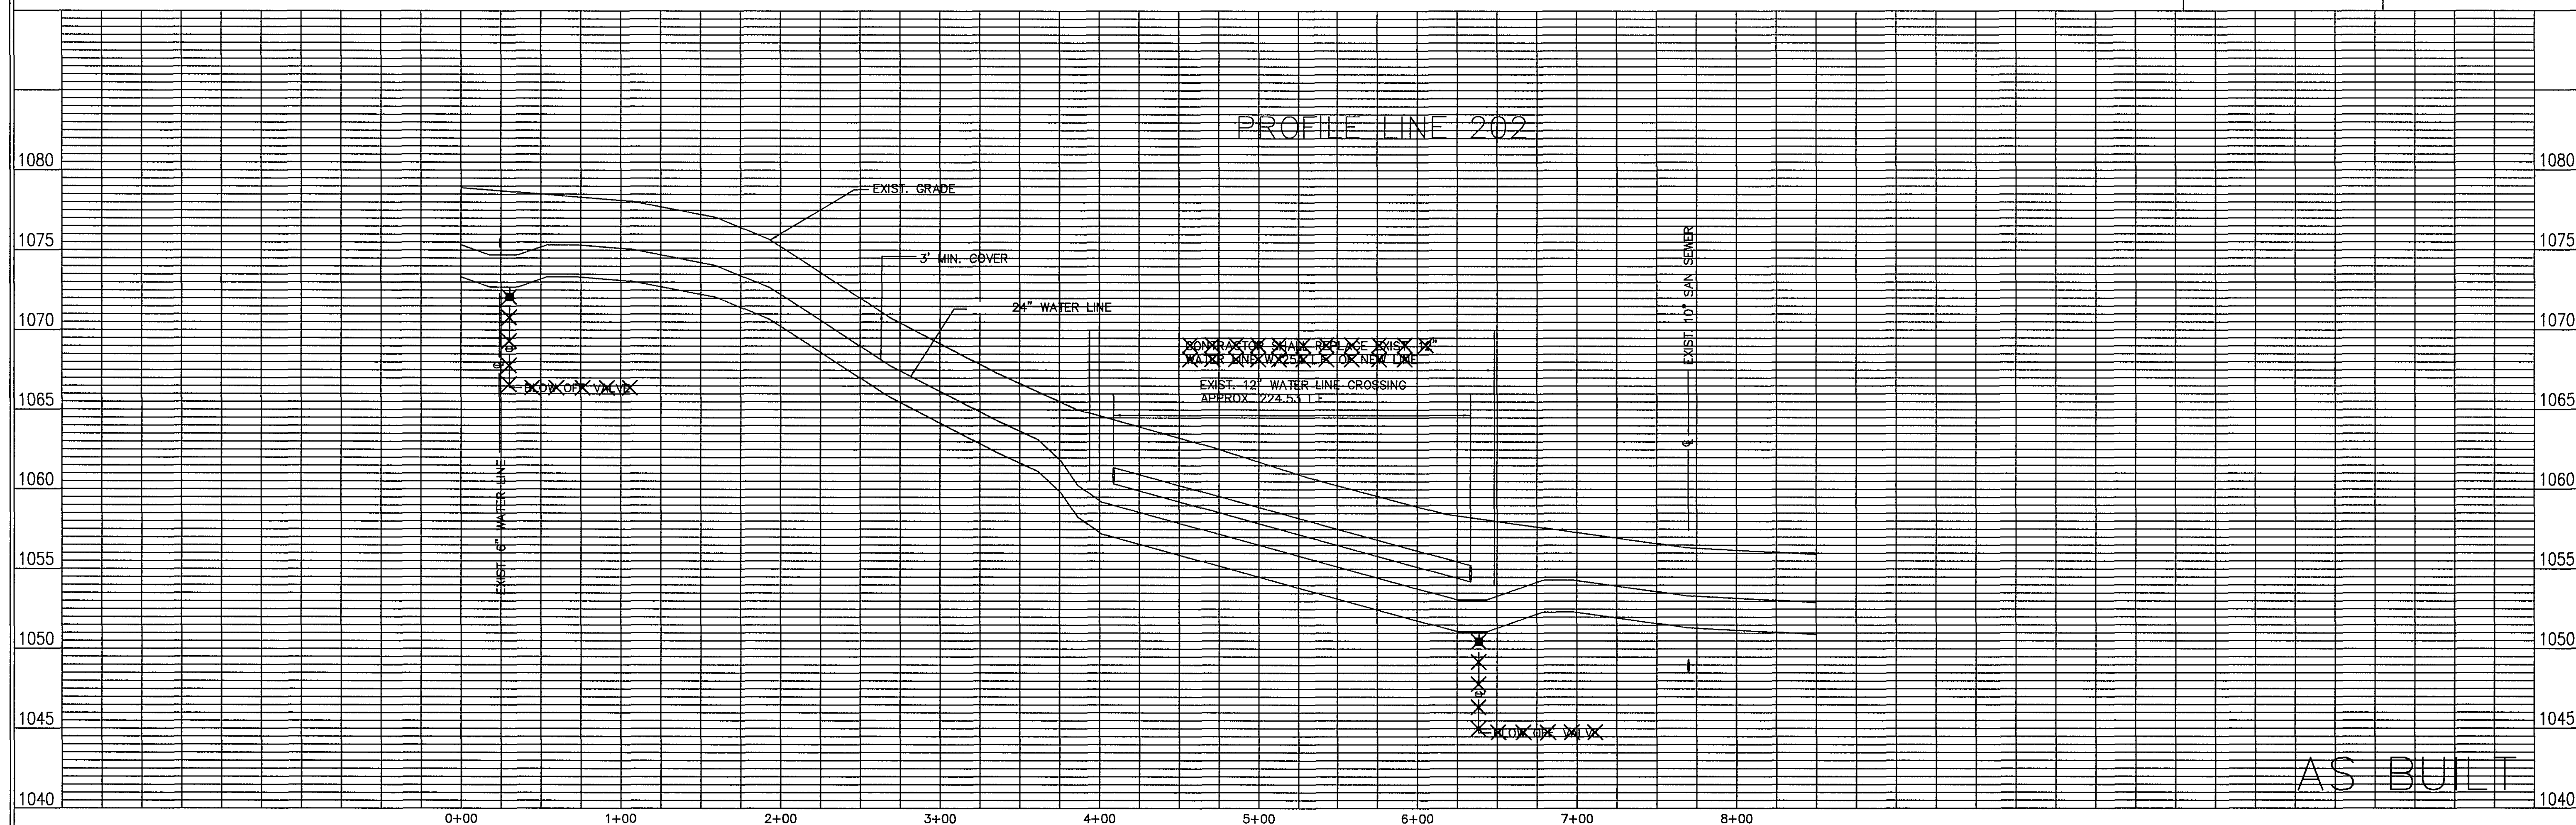

THIS SHEET
850 LF 24" WATERMAIN
1 EA. 24" BUTTERFLY VALVE

 ENGINEER'S SEAL	 ENGINEER'S SEAL
---------------------	---------------------

 Architects Engineers Planners Surveyors 5238 Valleypointe Parkway, Suite One-B Roanoke, Virginia 24019 ☎ 703 562-7725	Carvins Cove, Phase II City of Roanoke Roanoke, Virginia	CONTRACT "B1" LINE 202 STA 0+00.00 - 8+50.00
	Drawn By REH/ACF Designed By RBS Checked By SEH Date MAY 93 Scale V: 1" = 5' H: 1" = 50' Plan Number A2A Zoned NONE Sheet 21 of 25 File Number C1160	