




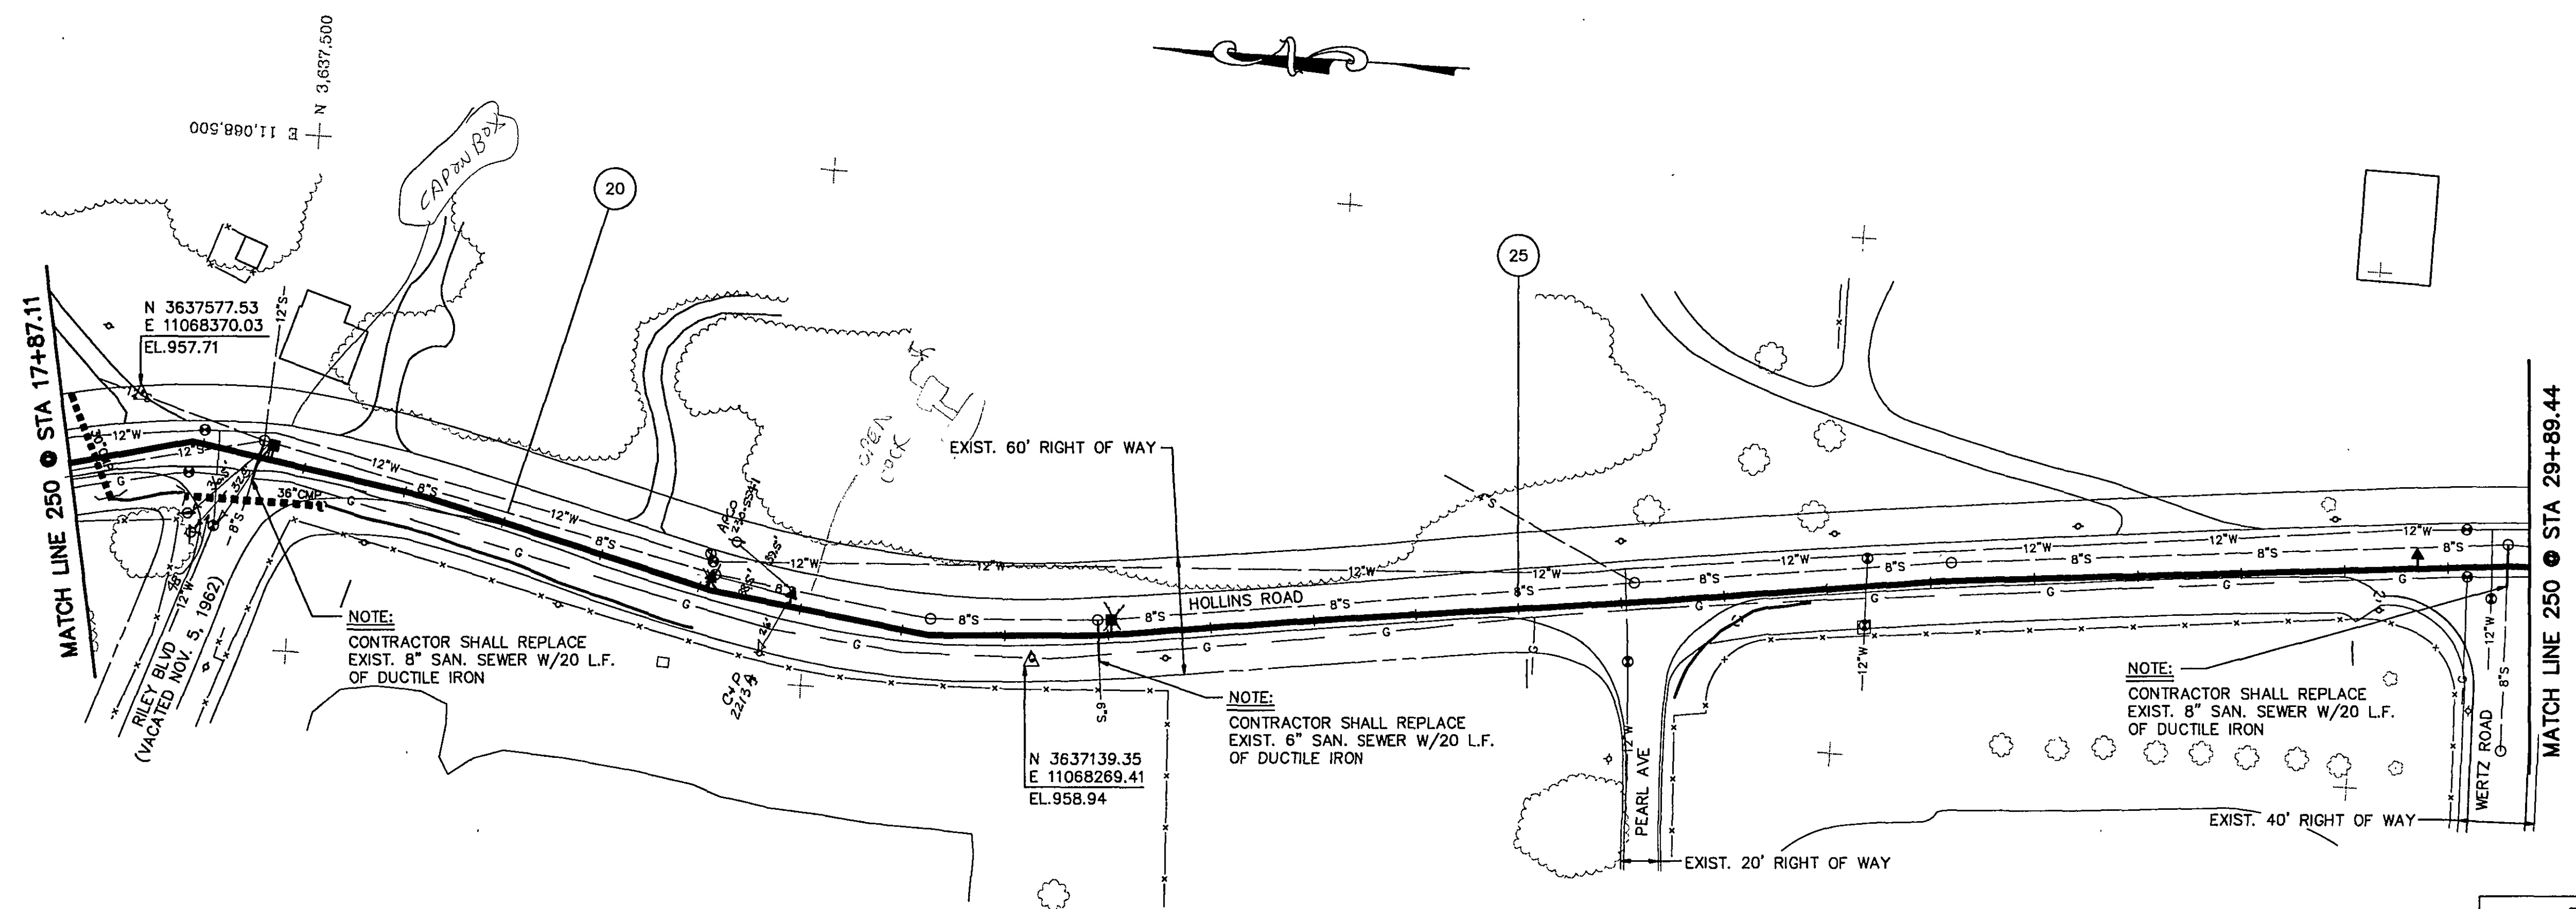

PLAN VIEW LINE 250

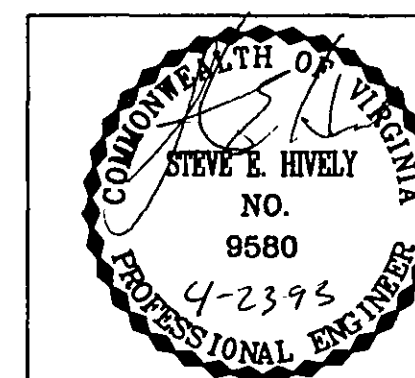


ENGINEER'S SEAL

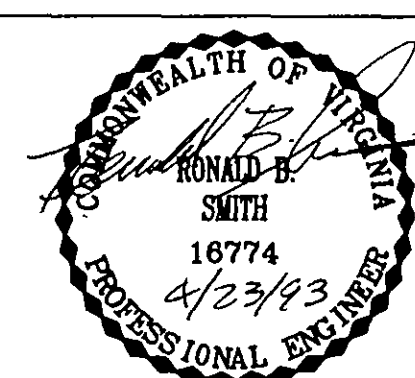

ENGINEER'S SEAL

1202 LF 24" WATER MAIN
1 EA 6" BLOW OFF
1 EA ARV

PROFILE LINE 250

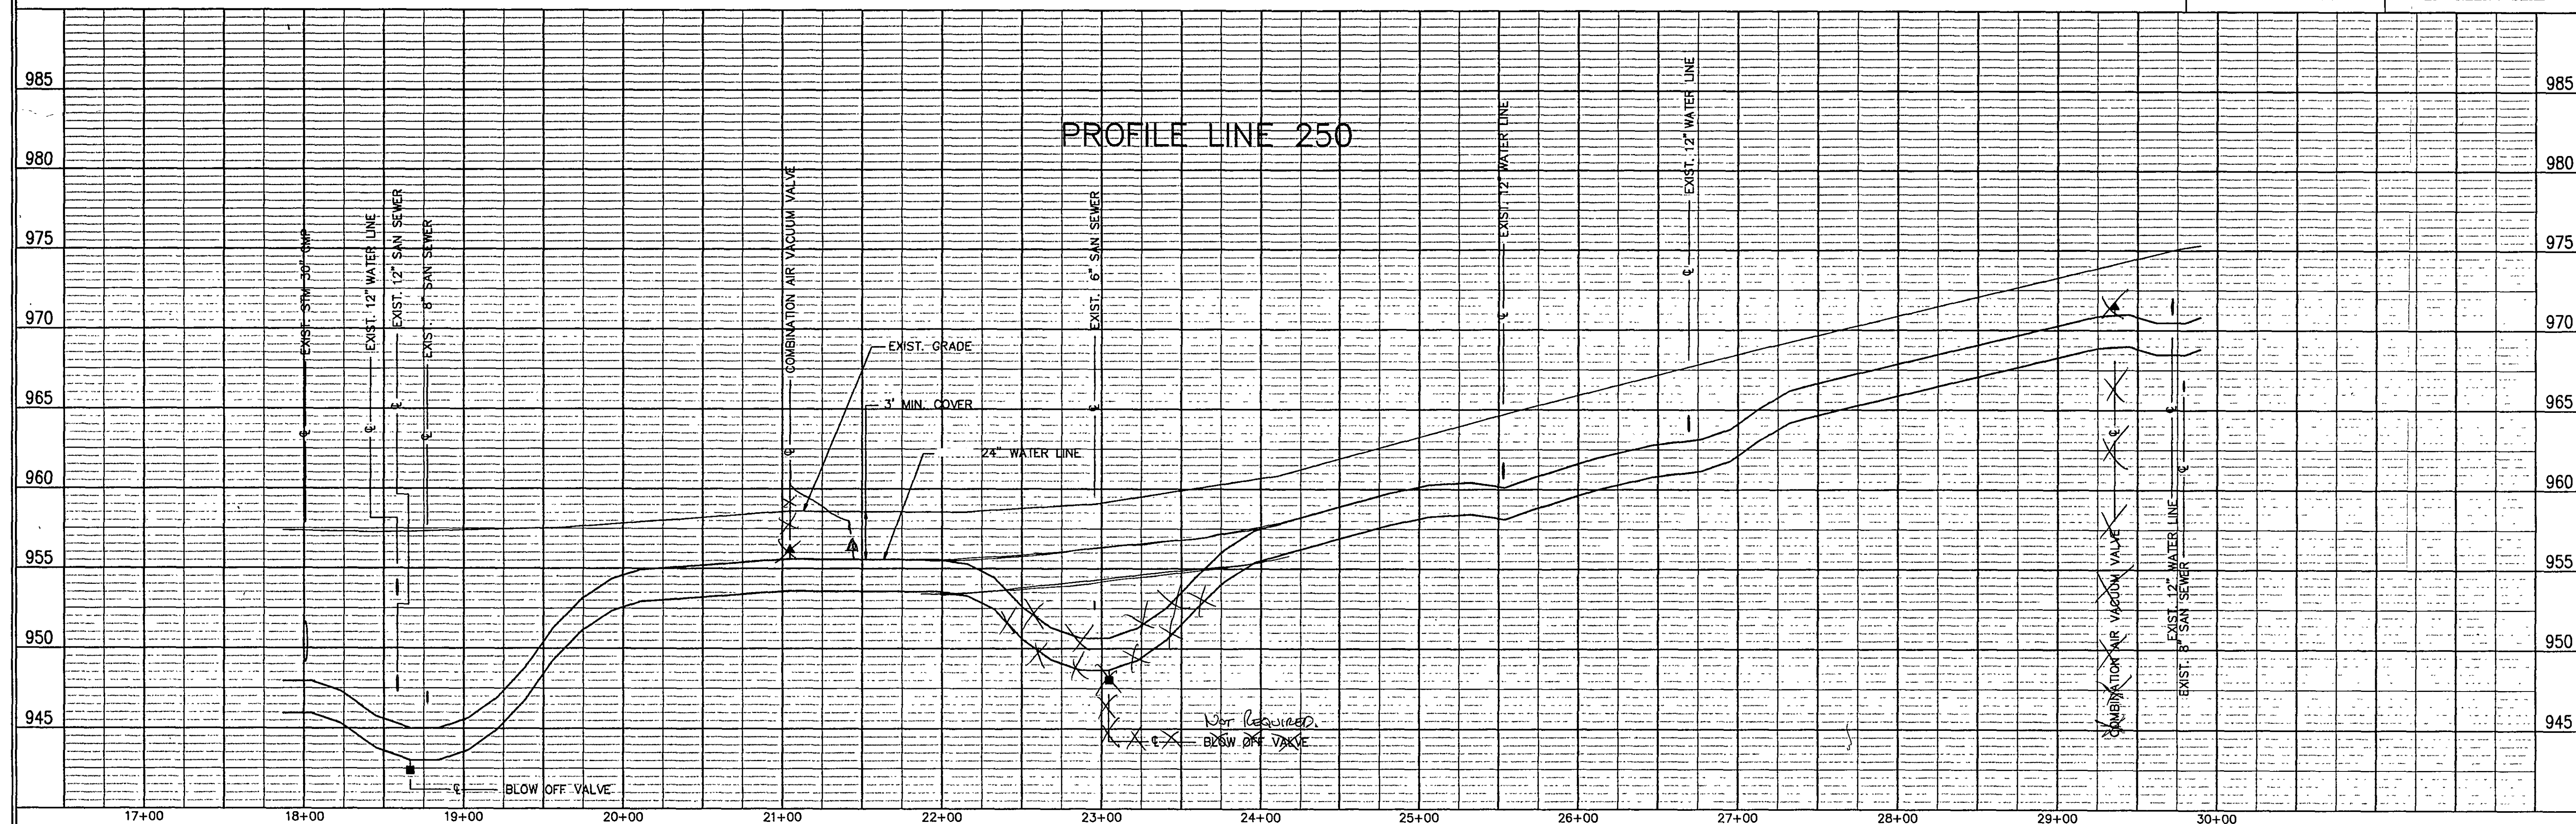

Architects
Engineers
Planners
Surveyors

Dewberry & Davis

5238 Valleypointe Parkway, Suite One-B
Roanoke, Virginia 24019
703 362-7725

Carvins Cove, Phase II

City of Roanoke
Roanoke, Virginia

CONTRACT "B2"
LINE 250
STA 17+87.11 - 29+89.44

Drawn By REH/ACF
Designed By RBS
Checked By SEH
Date APRIL 93
Scale
V: 1" = 5'
H: 1" = 50'
Plan Number A9
Zoned NONE
Sheet 3 of 22
File Number C1160