
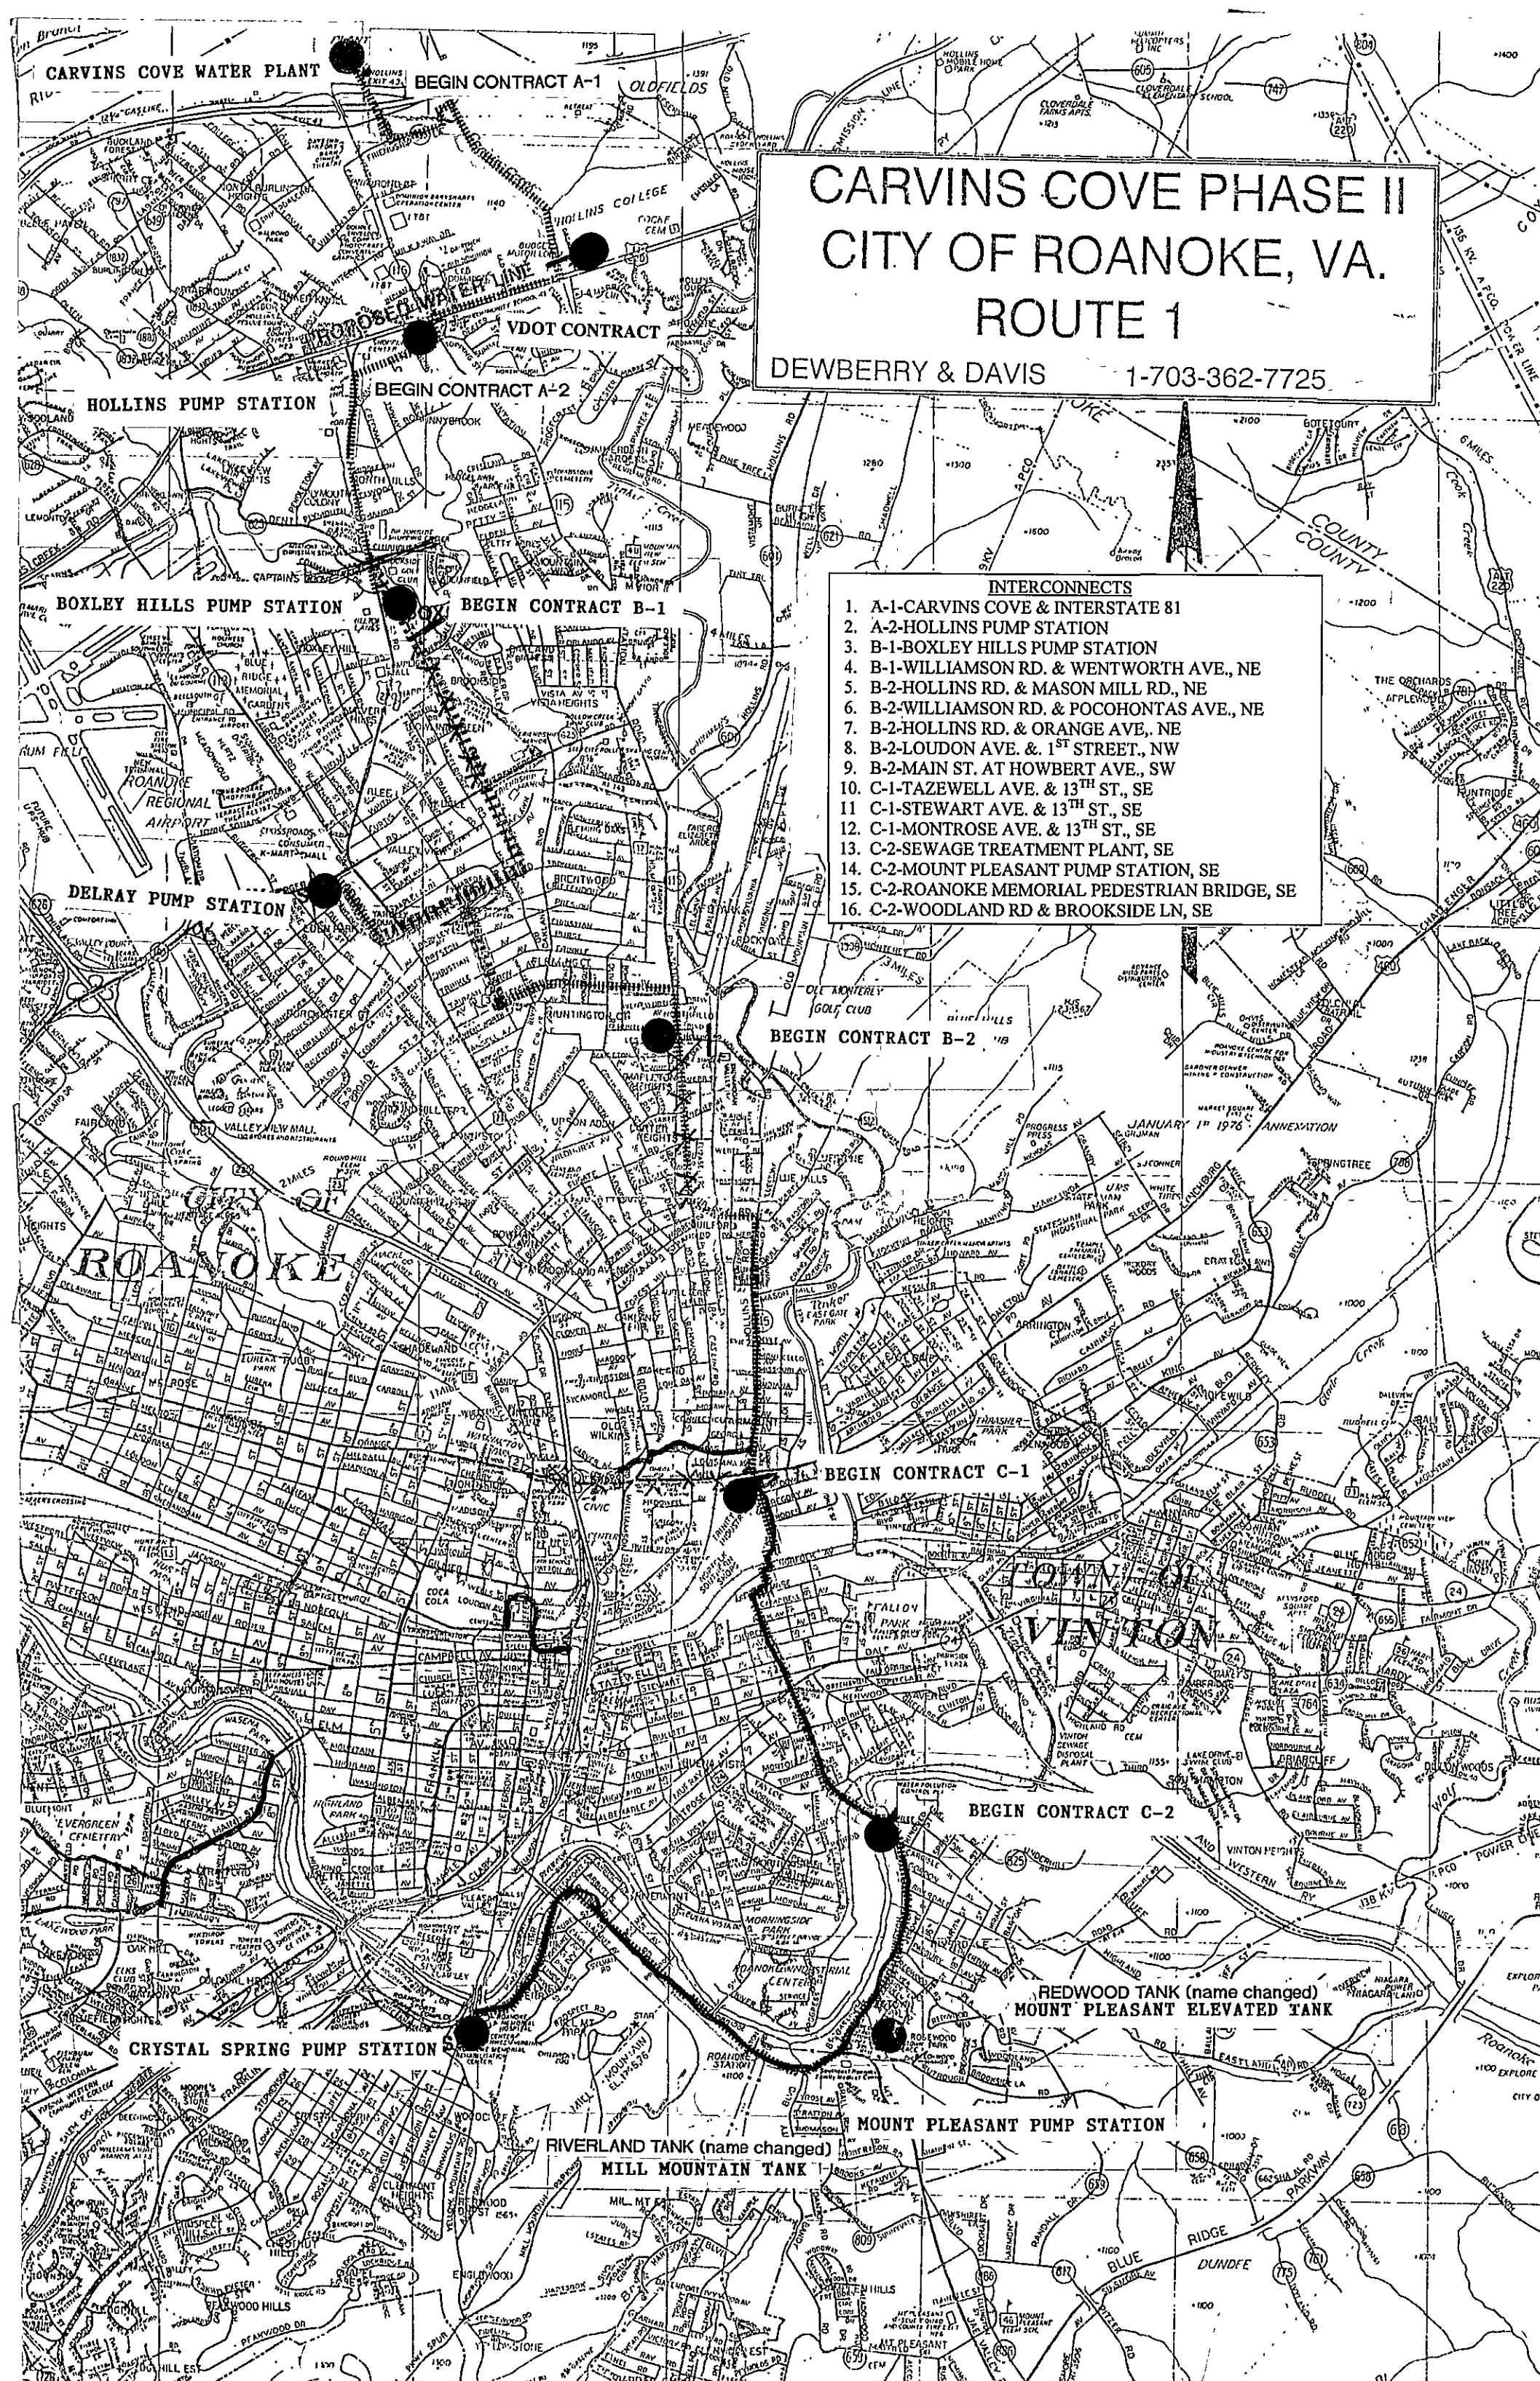


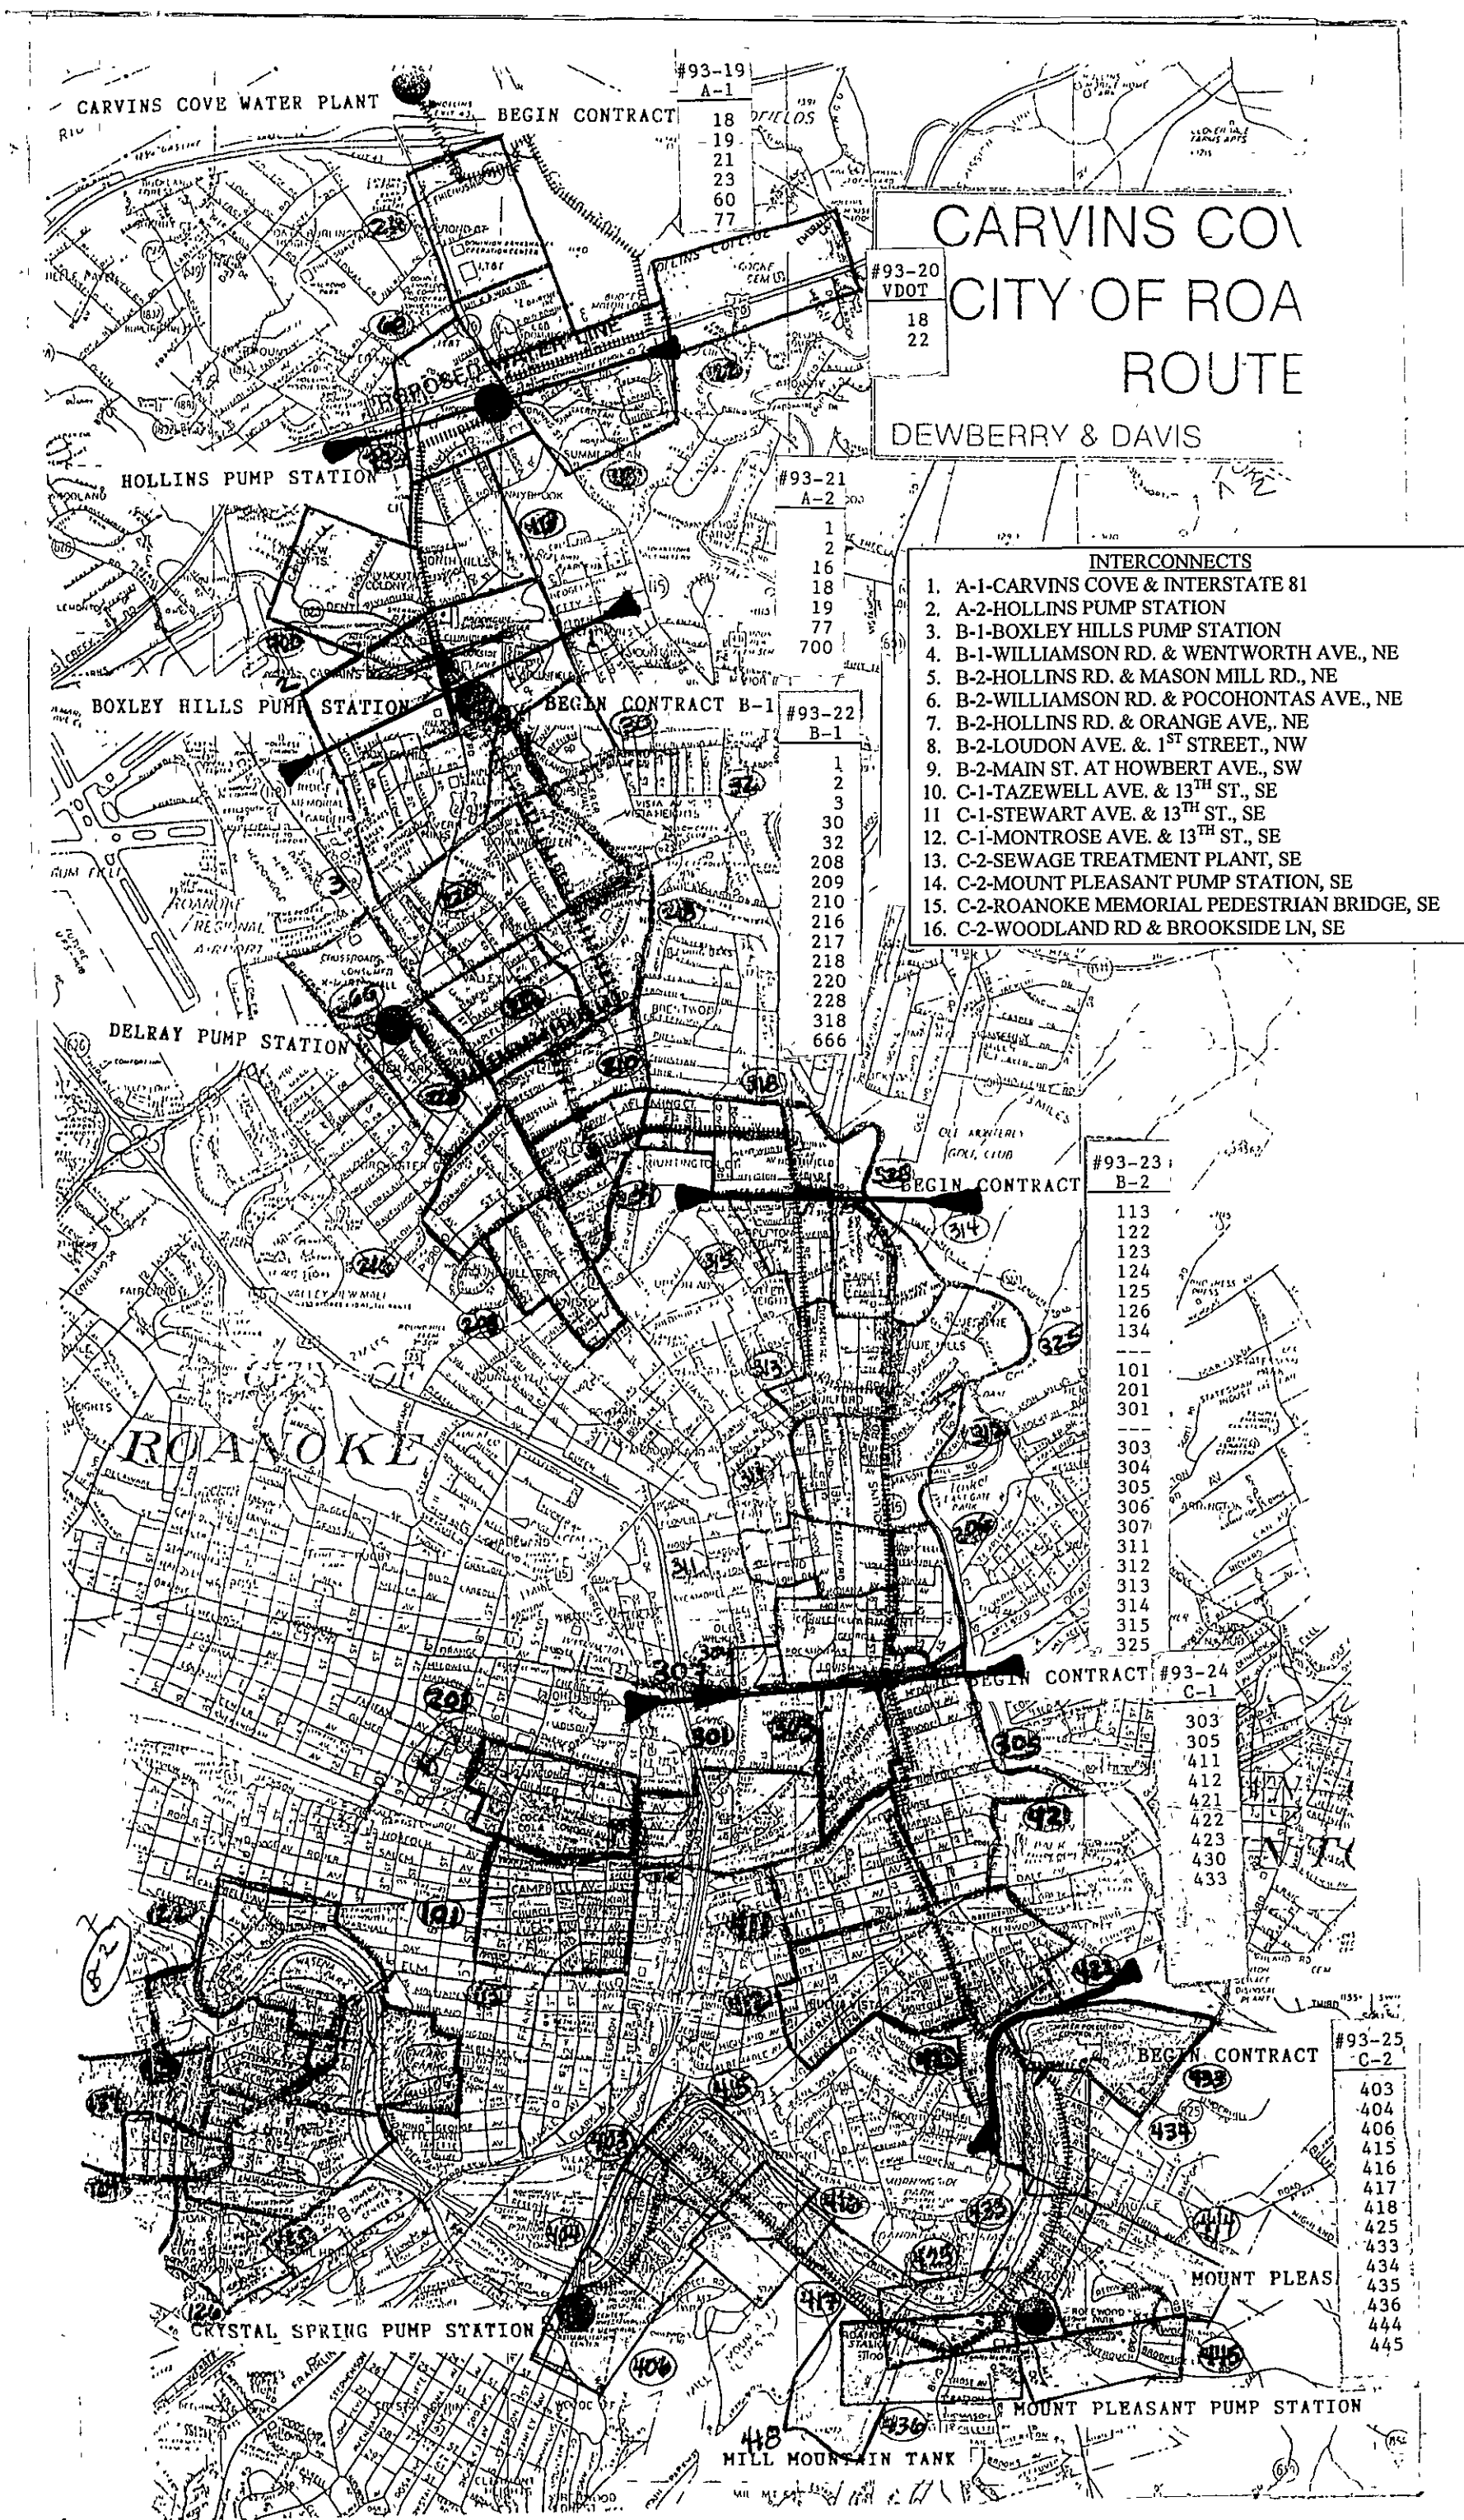

CO: = completed project

CARVINS COVE PROJECT 1995 Drawn: 1993				
(CO:4/28/95) #93-19 (A-1) RO.CO.18.00	(CO: 1/95) #93-20 (VDOT) RO.CO.27.07	(CO:5/24/96) #93-21 (A-2) RO.CO.27.11	(CO:4/30/95) #93-22 (B-1) 1	(CO:5/10/95) #93-23 (B-2) 113
" 18.18	" 27.08	1	2	122
" 18.19	" 27.11	2	3	123
" 27.06	" 27.12	16	30	124
" 27.07	18	18	32	125
" 27.10		19	208	126
18		77	209	134
19		700	210	---
23			216	101
			217	201
			218	301
			220	---
			228	303
			318	304
			666	305
				306
				307
				311
				312
				313
				314
				315
				325

(CO:4/24/95) #93-24 (C-1) 303	(CO:1/31/95) #93-25 (C-2) 403
305	404
411	406
412	415
421	416
422	417
423	418
430	425
433	433
	434
	435
	436
	444
	445

E.C. PALE
(Contractor)

Hammer Gage
(Contractor)

VDOT
(Contractor)

(Boxley to B-1)
Hammer Gage
(Contractor)

(not to Boxley)
Karamore
(Contractor)

Hammer Gage
(Contractor)

Aaron J. Connor
General Contractor, Inc.
(Contractor)