




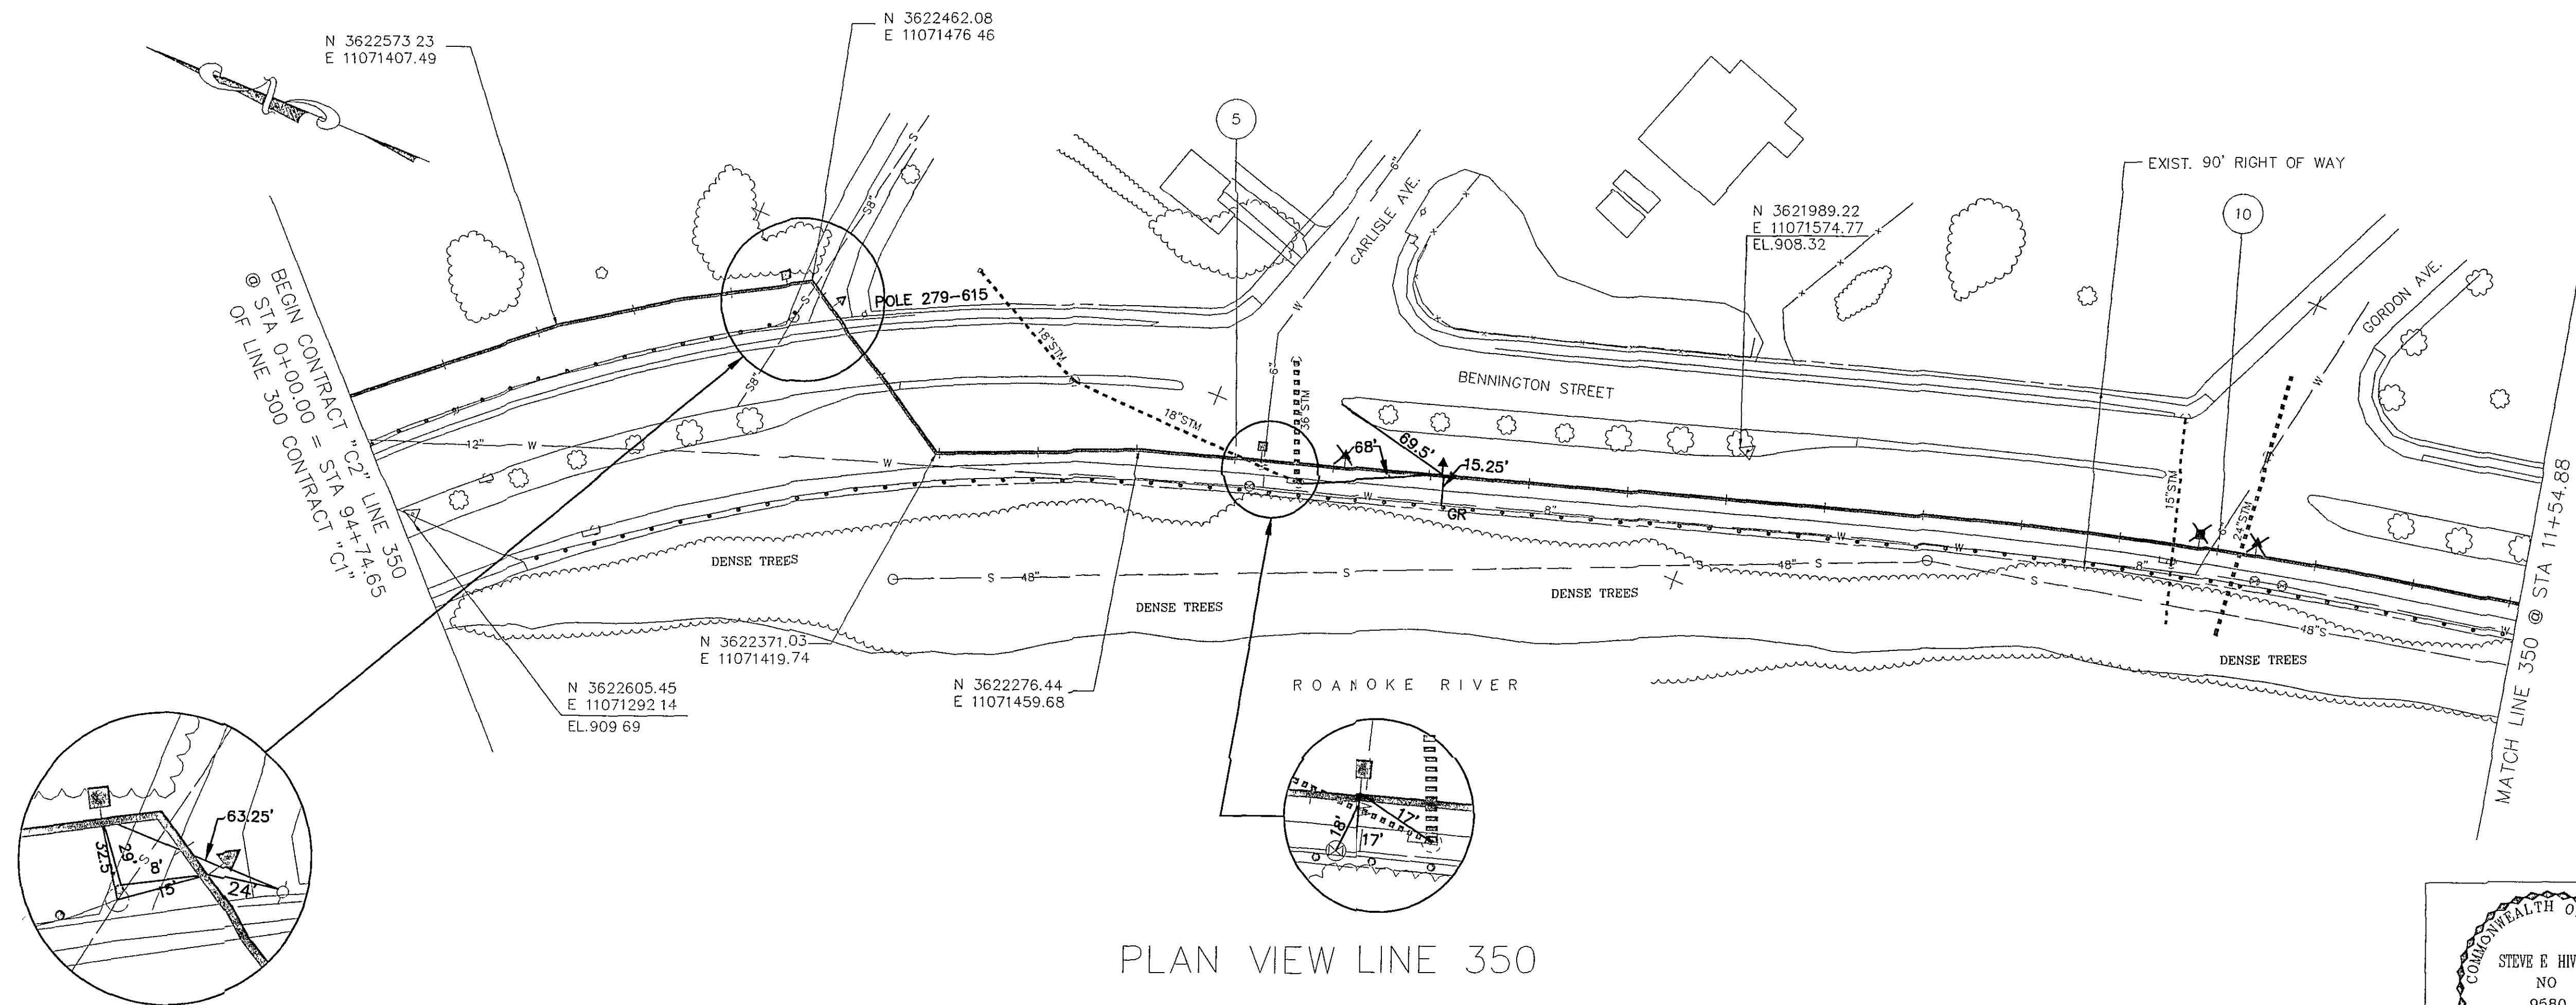


PLAN VIEW LINE 350

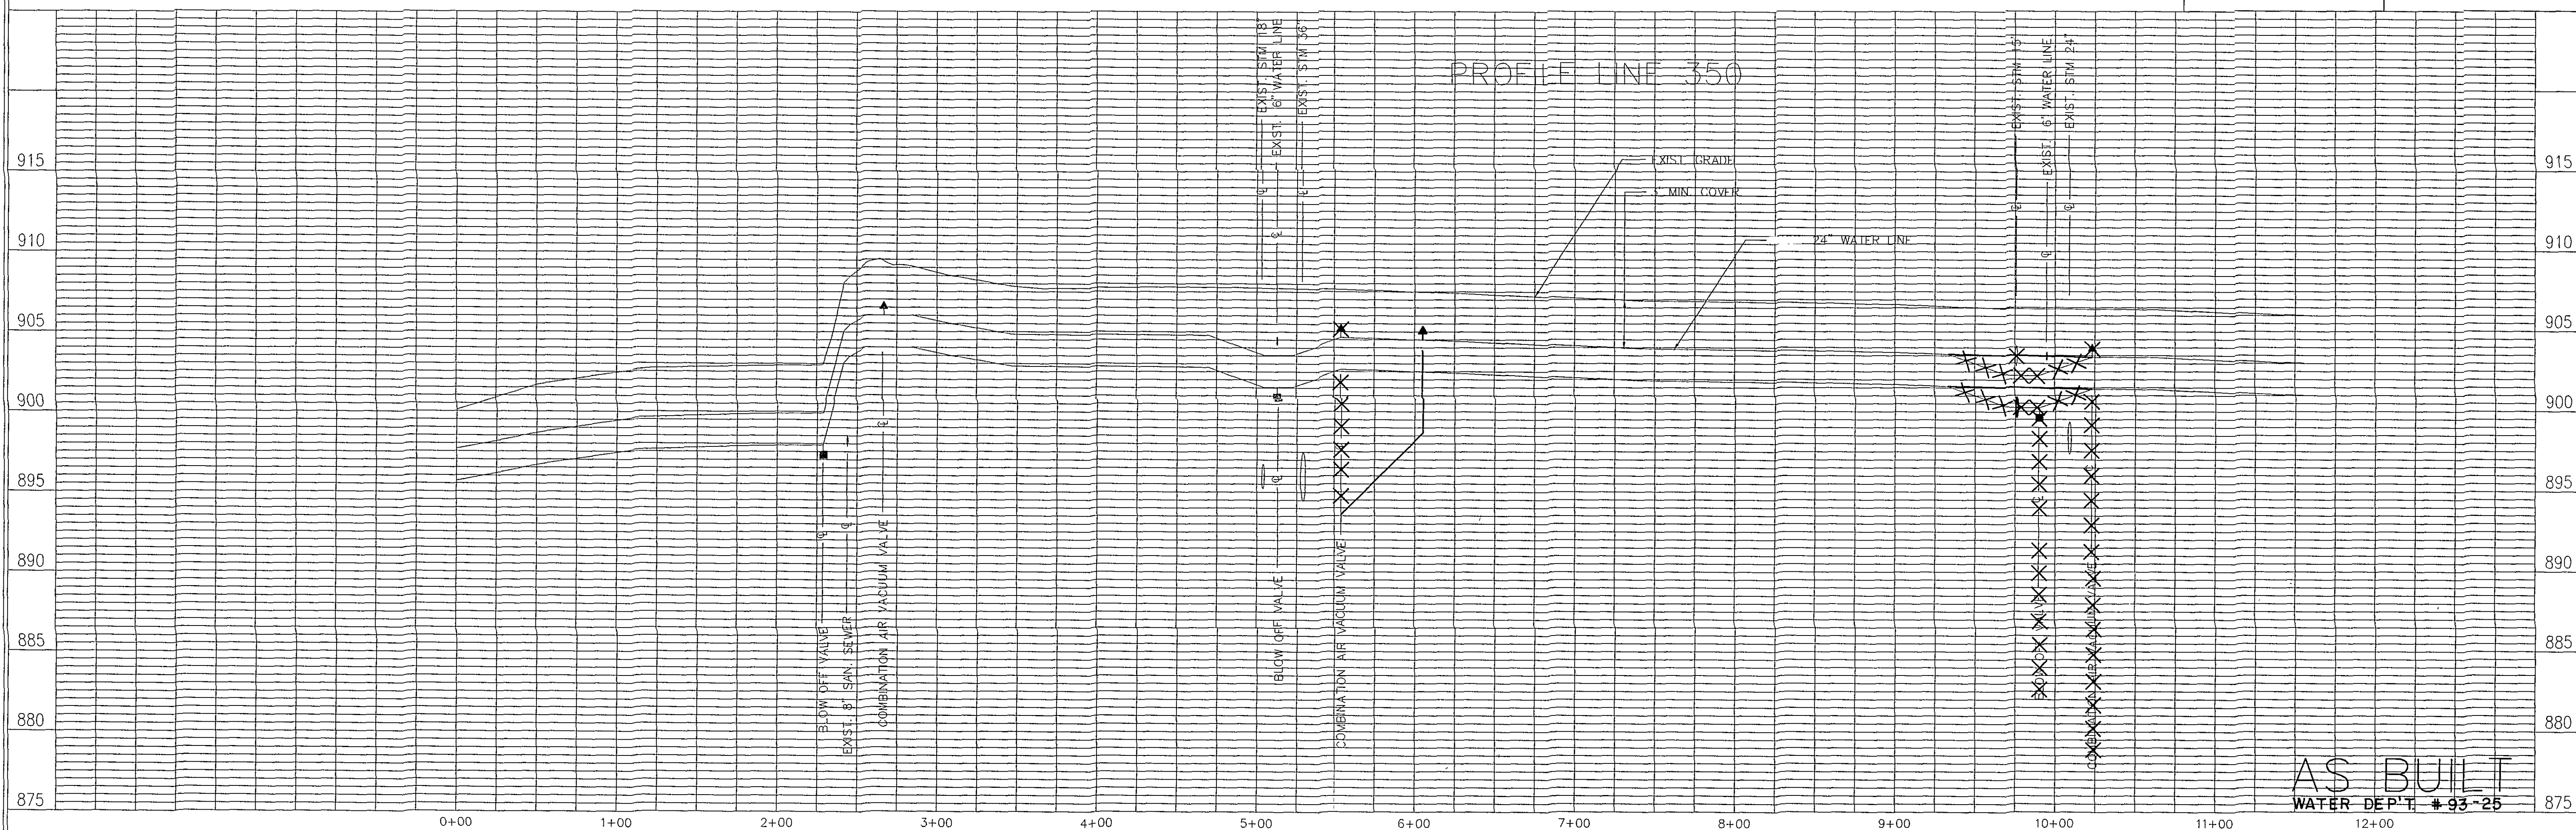

THIS SHEET
1155 LF 24" WATERMAIN
2 EA. 6" BLOWOFF
1 EA. 1" A.R.V.

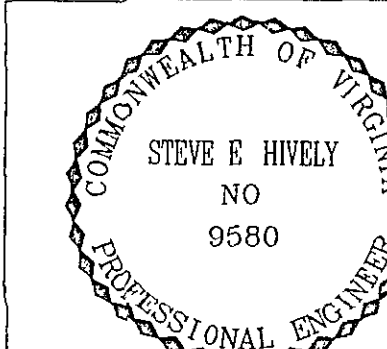

ENGINEER'S SEAL

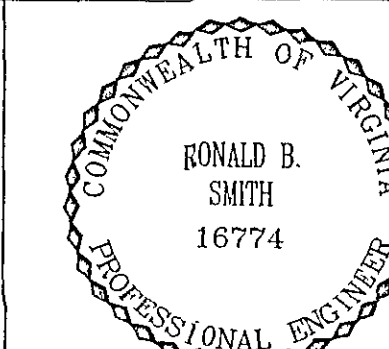

ENGINEER'S SEAL

Architects
Engineers
Planners
Surveyors

Dewberry & Davis

5238 Valleypointe Parkway, Suite One-B
Roanoke, Virginia 24019
703 362-7725

Carvins Cove, Phase II
City of Roanoke
Roanoke, Virginia

BEGIN CONTRACT "C2"
BEGIN LINE 350
STA 0+00.00 - 11+54.88

Drawn By ACF/REH
Designed By RBS
Checked By SEH
Date MARCH 93
Scale
V: 1" = 5'
H: 1" = 50'
Plan Number D4
Zoned NONE
Sheet 1 of 25
File Number C1160