



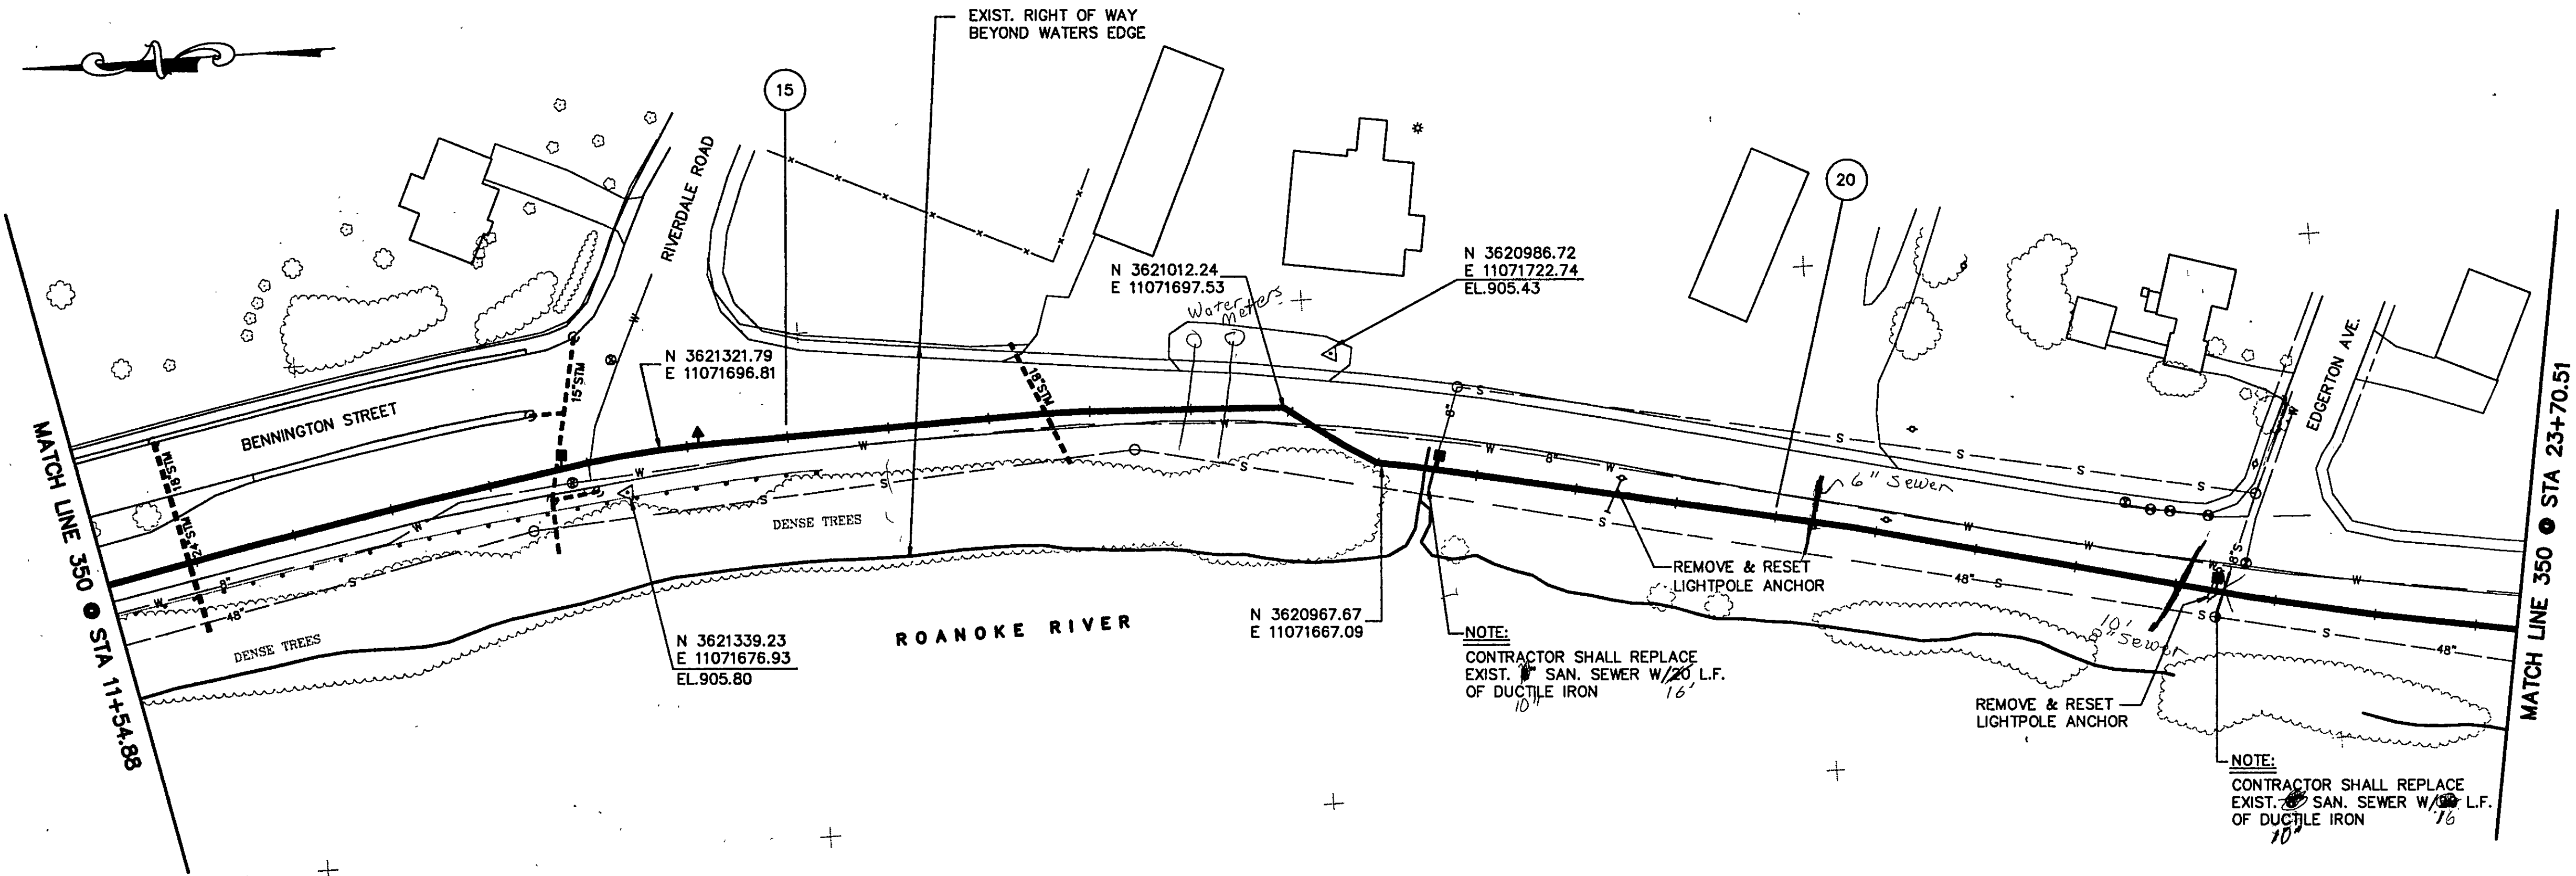

PLAN VIEW LINE 350

ENGINEER'S SEAL	ENGINEER'S SEAL

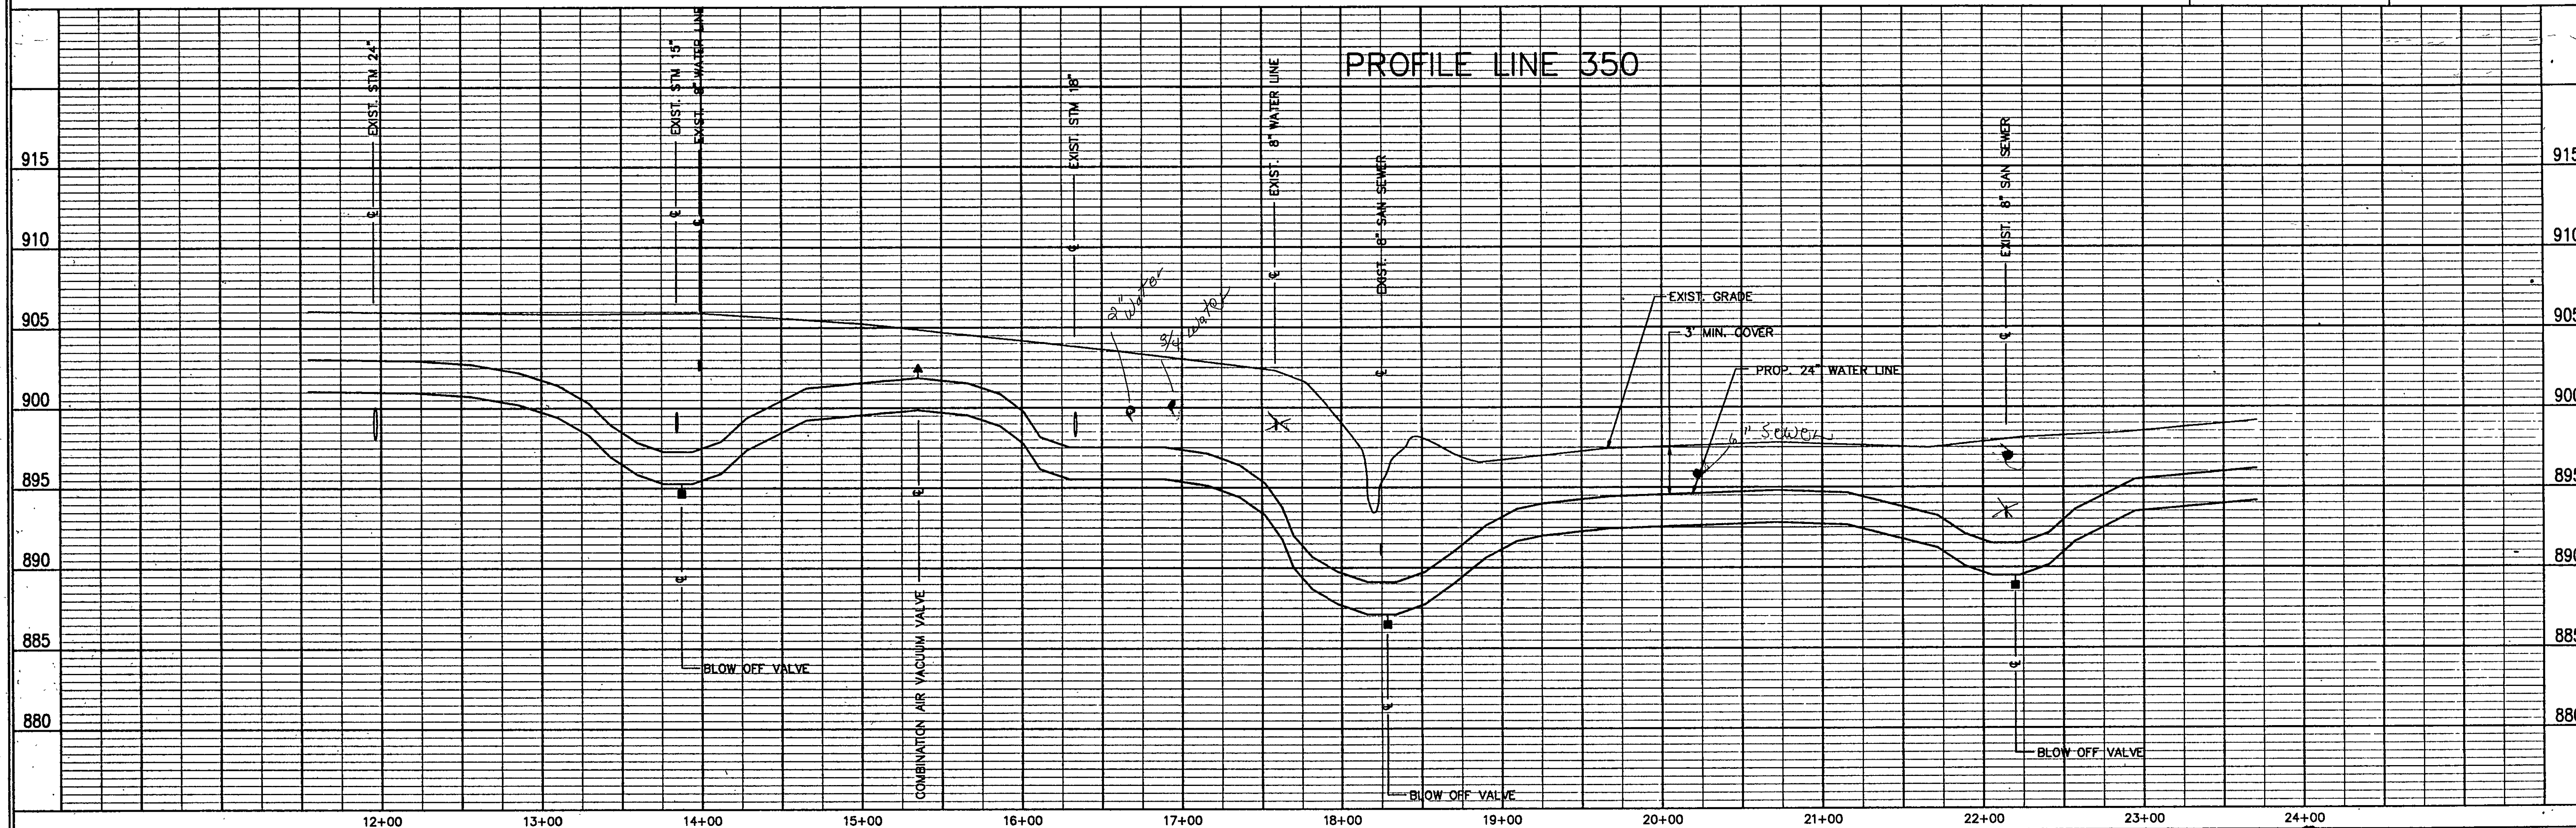

PROFILE LINE 350

Dewberry & Davis
Architects
Engineers
Planners
Surveyors
5238 Valleypointe Parkway, Suite One-B
Roanoke, Virginia 24019
703 362-7725

Carvins Cove, Phase II
City of Roanoke
Roanoke, Virginia

CONTRACT "C2"
LINE 350
STA 11+54.86 ≈ 23+70.51

Drawn By	ACF/REH
Designed By	RBS
Checked By	SEH
Date	MARCH 93
Scale	V: 1" = 5' H: 1" = 50'
Plan Number	D5
Zoned	NONE
Sheet	2 of 25
File Number	C1160