



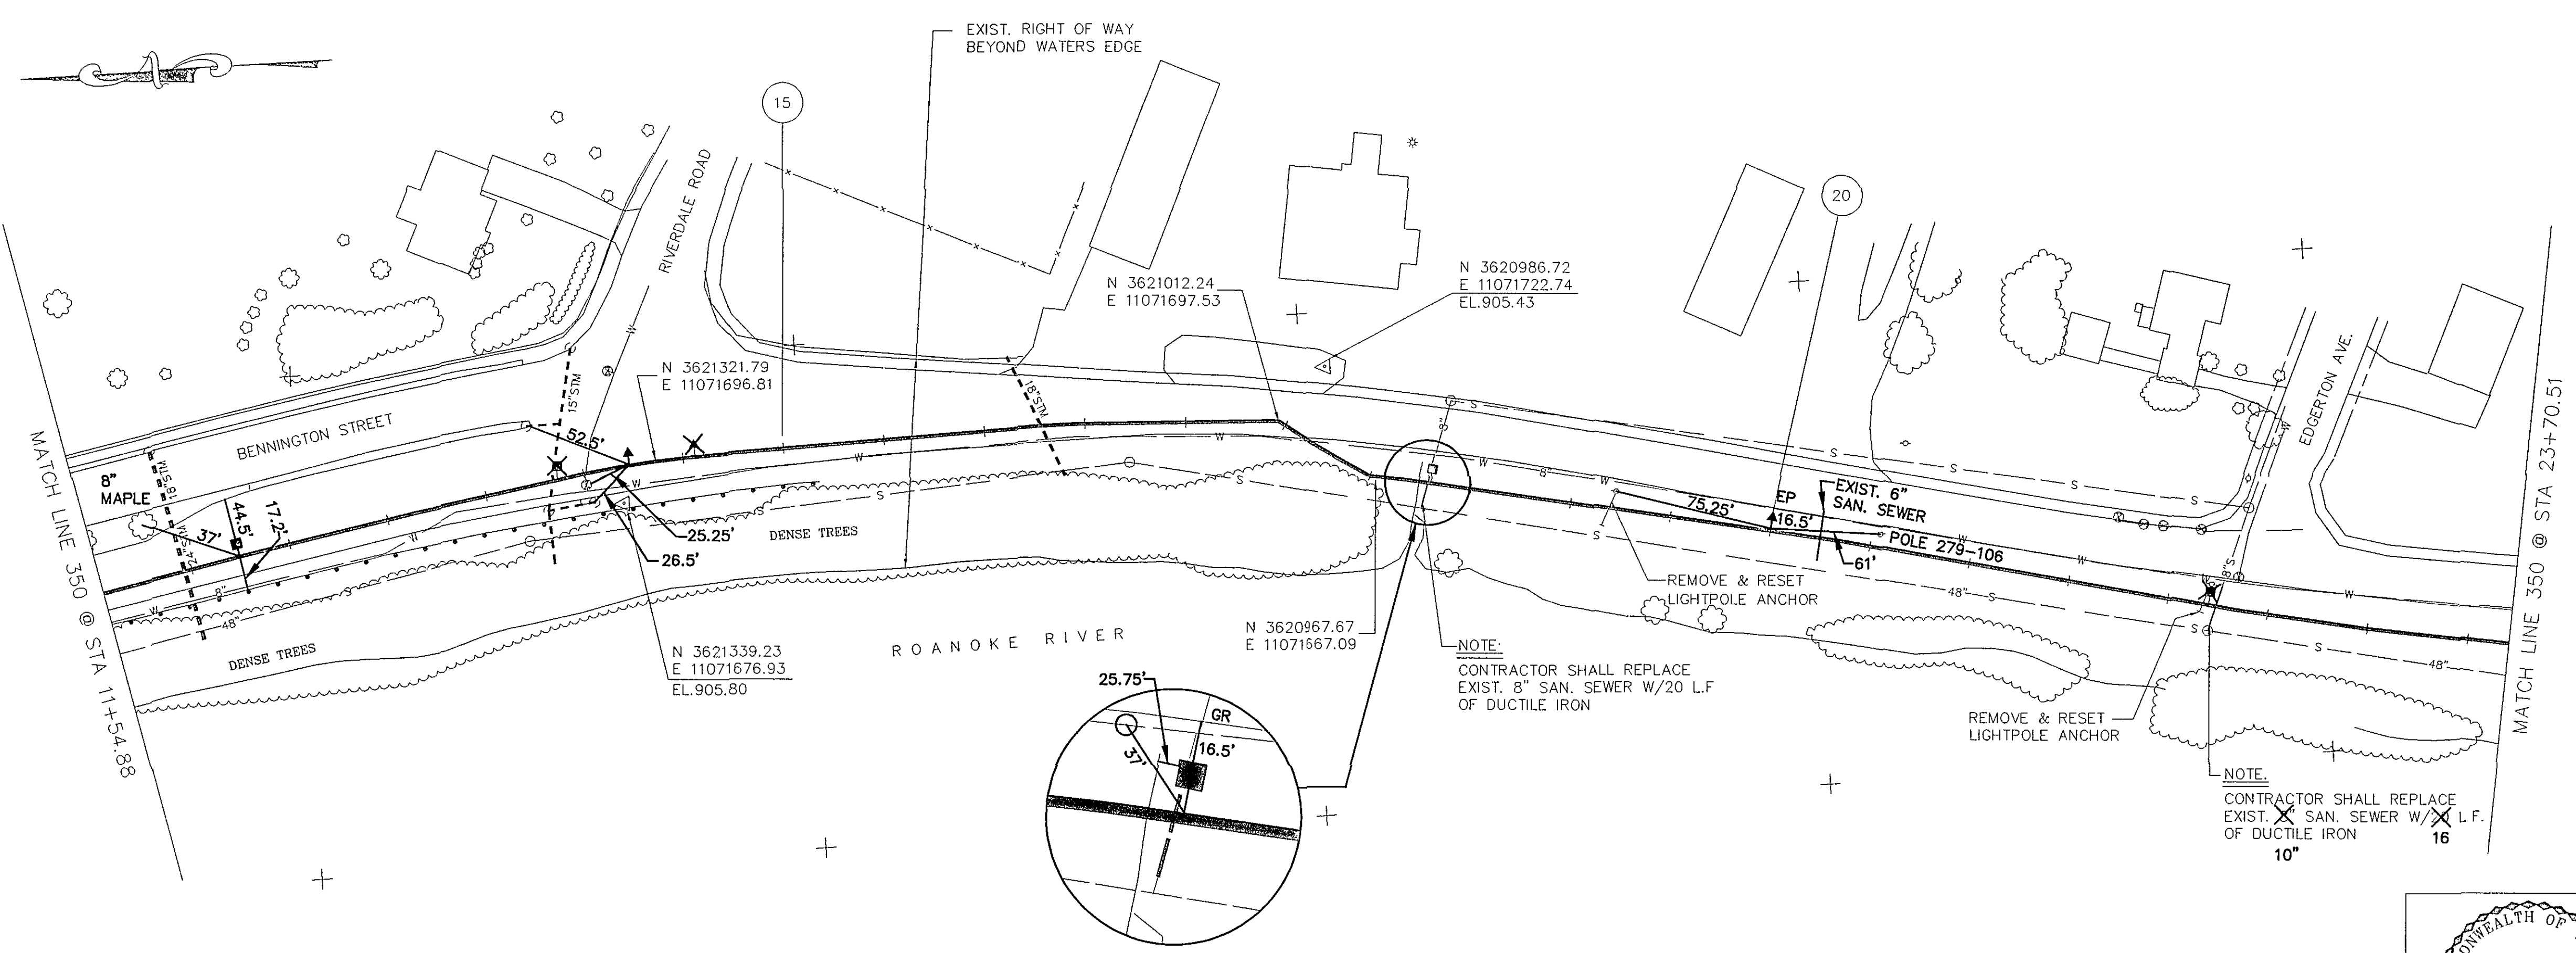


PLAN VIEW LINE 350


THIS SHEET
1216 LF 24" WATERMAIN
2 EA. 6" BLOWOFF
2 EA. 1" A.R.V.

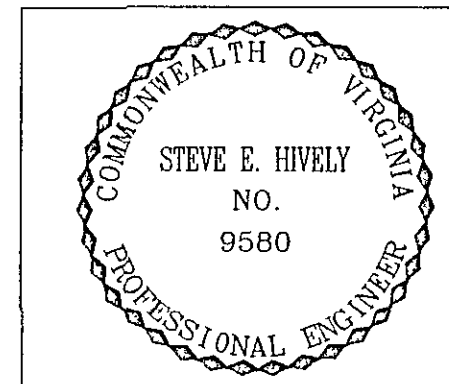

ENGINEER'S SEAL

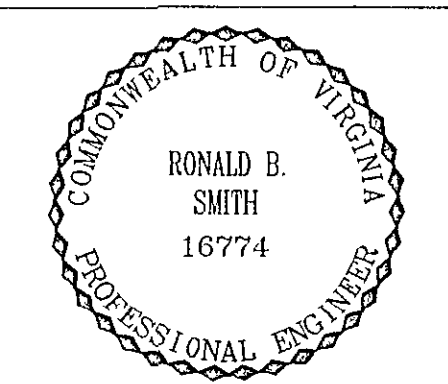

ENGINEER'S SEAL

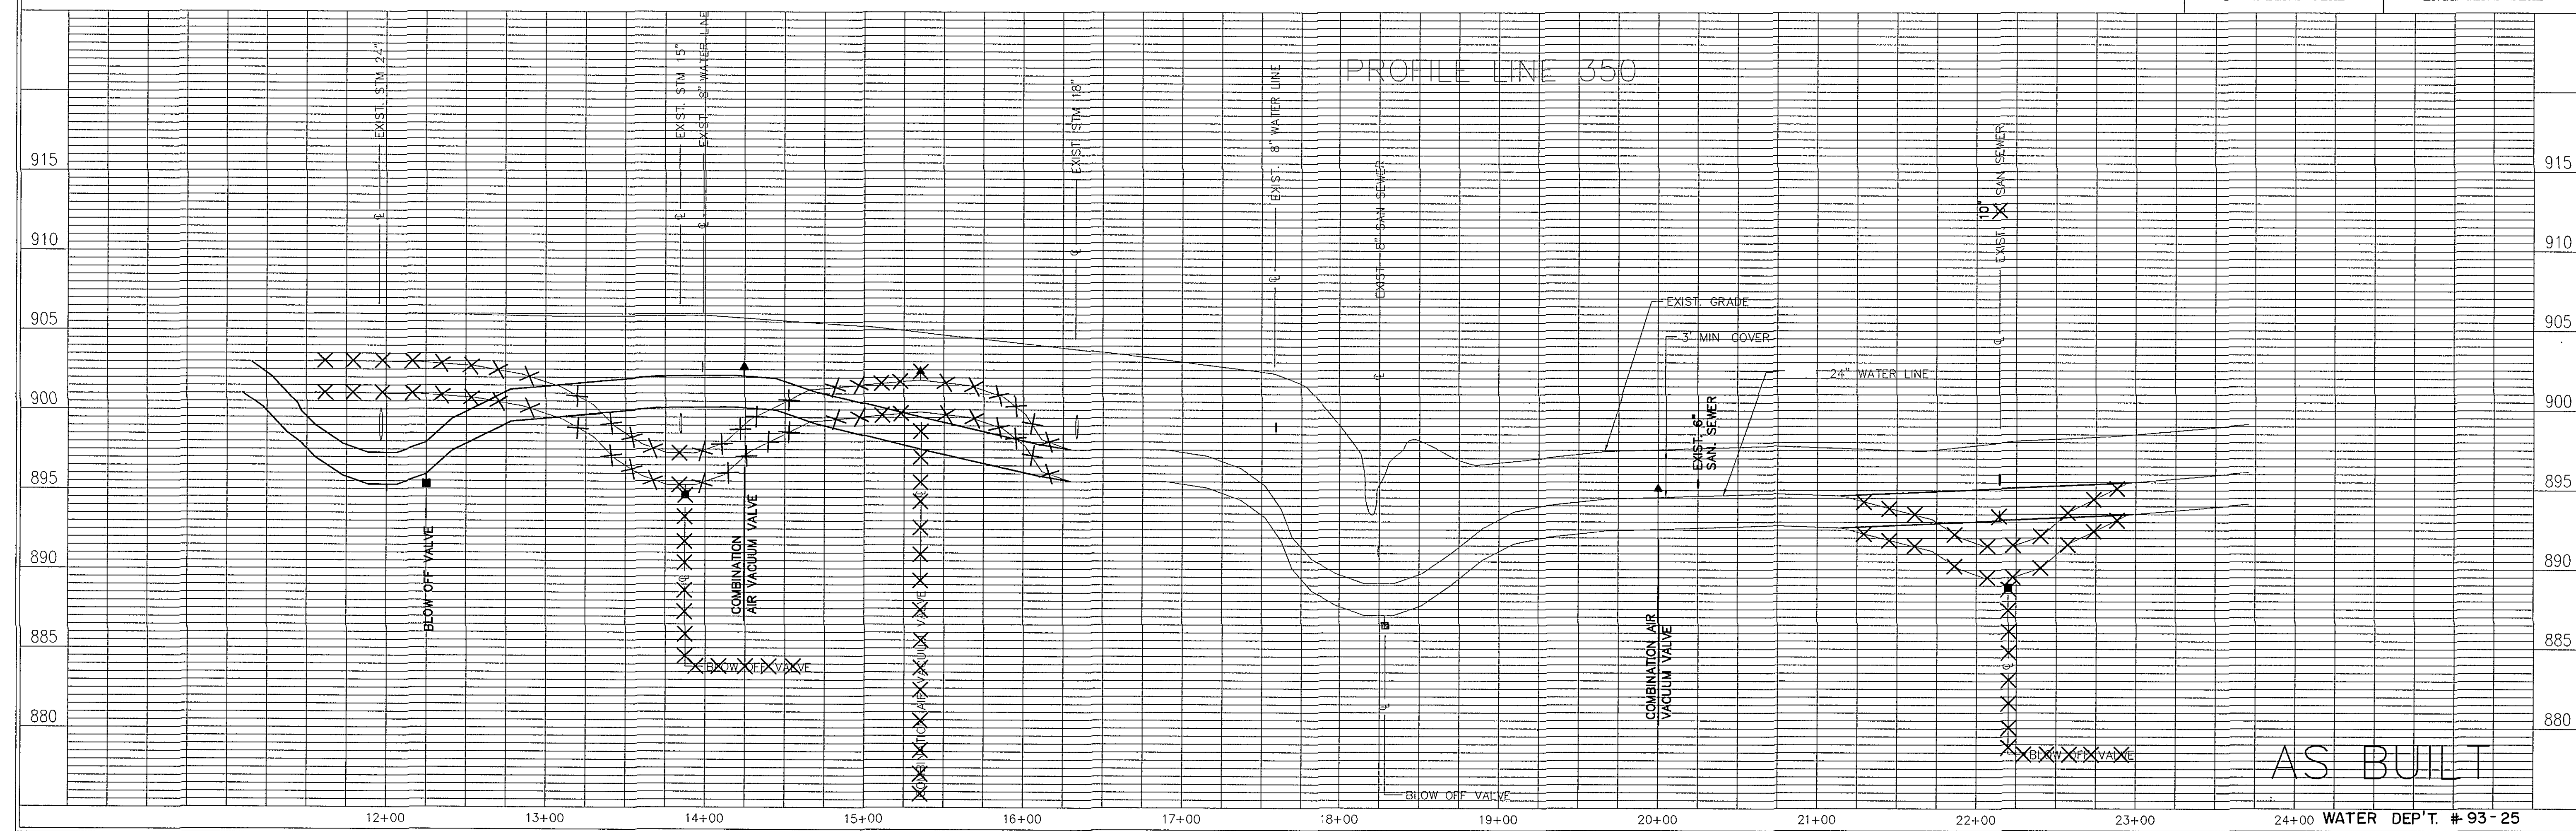

AS BUILT

Dewberry & Davis
Architects
Engineers
Planners
Surveyors
5238 Valleypointe Parkway, Suite One-B
Roanoke, Virginia 24019
703 362-7725

Carvins Cove, Phase II
City of Roanoke
Roanoke, Virginia

CONTRACT "C2"
LINE 350
STA 11+54.88 - 23+70.51

Drawn By ACF/REH
Designed By RBS
Checked By SEH
Date MARCH 93
Scale V: 1" = 5'
H: 1" = 50'
Plan Number D5
Zoned NONE
Sheet 2 of 25
File Number C1160