


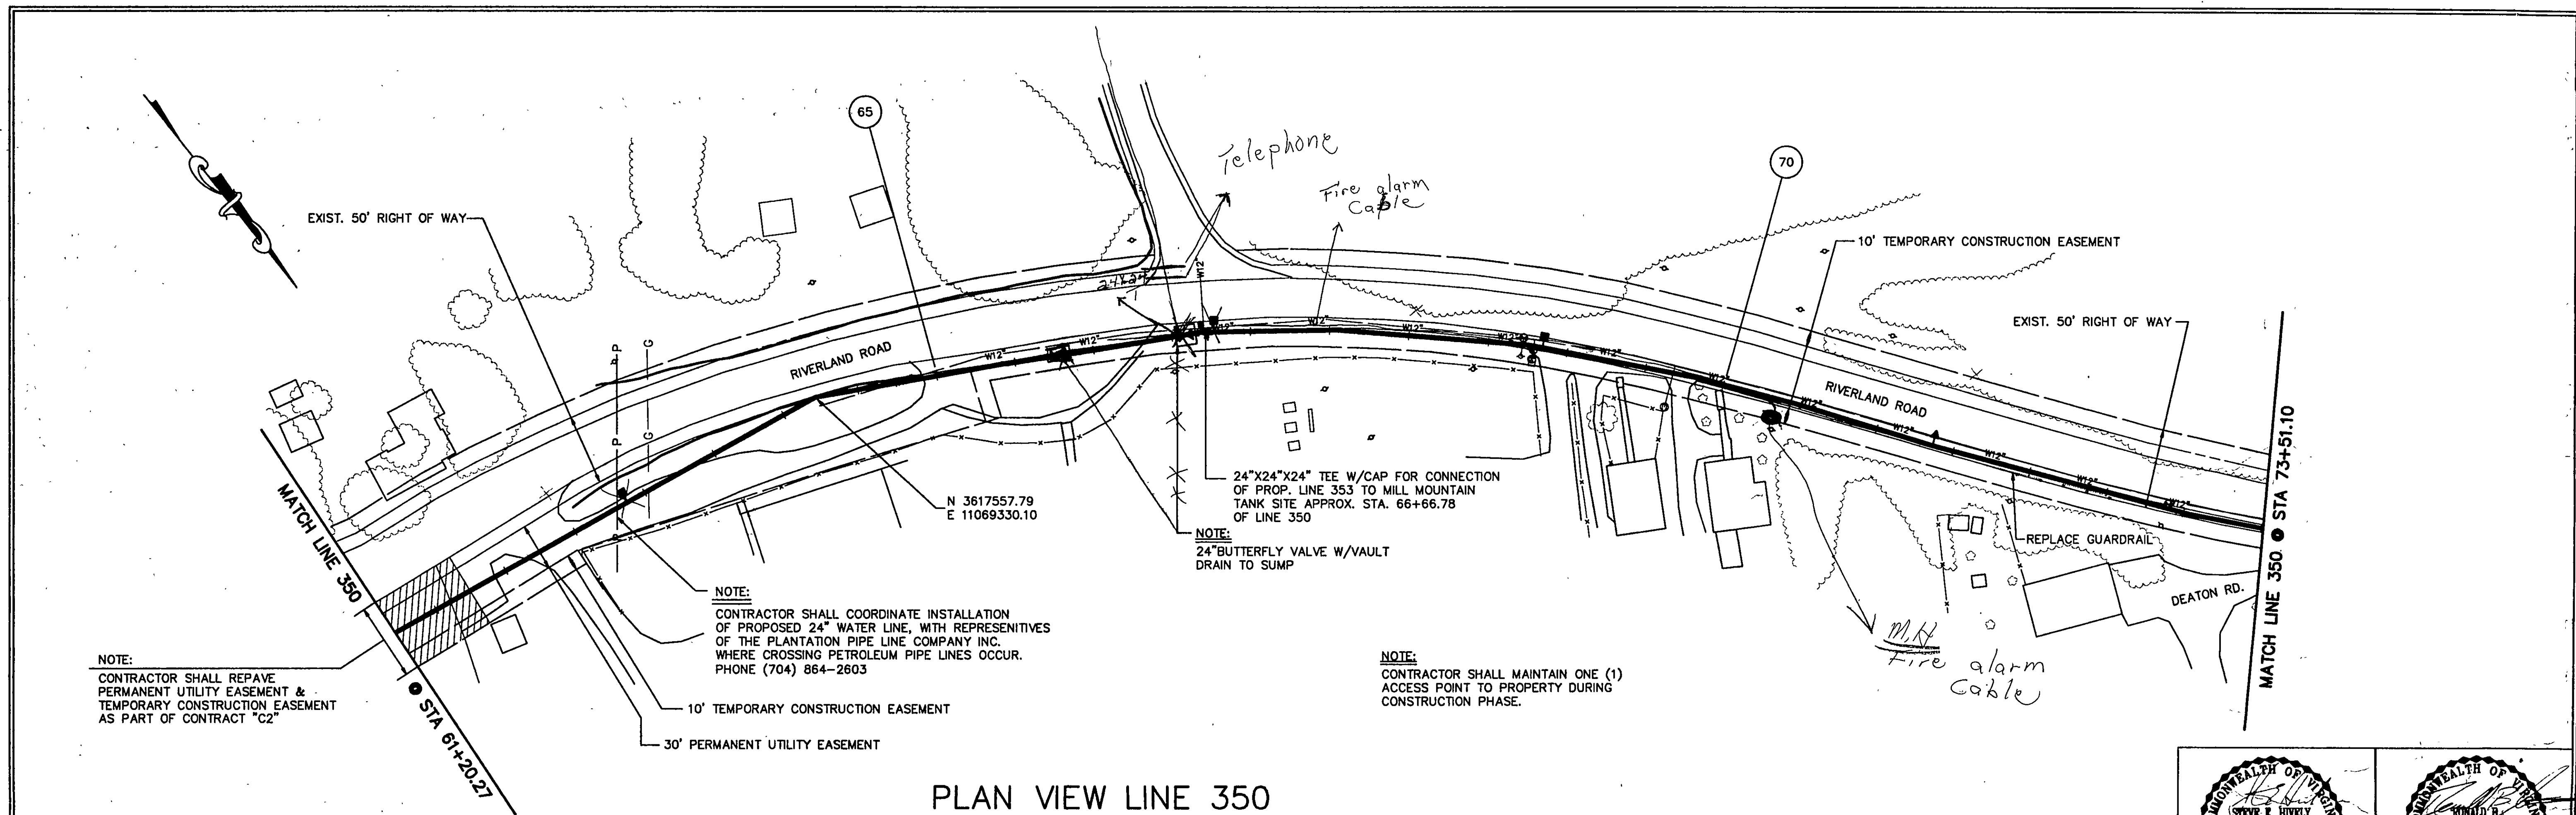


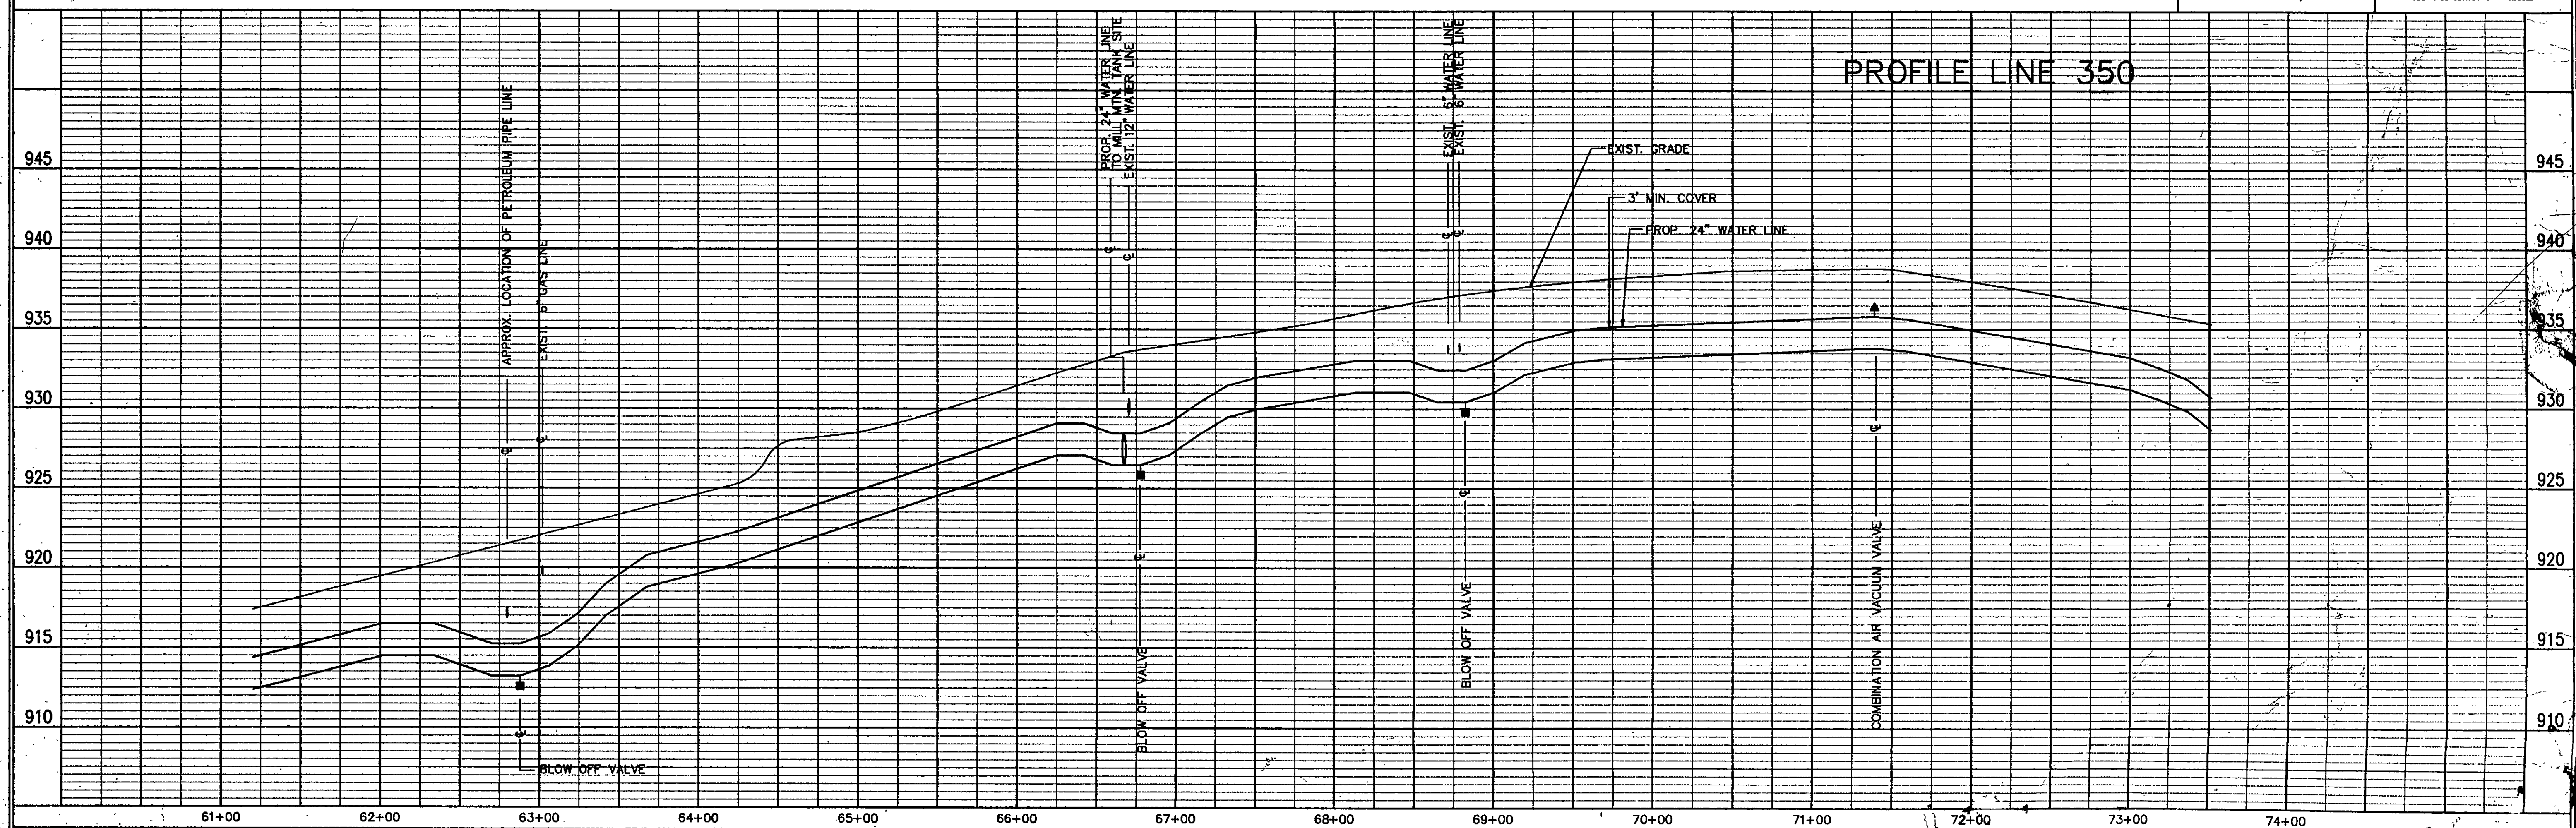

PLAN VIEW LINE 350

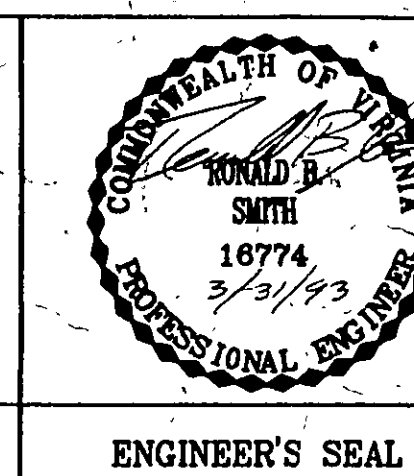

PROFILE LINE 350

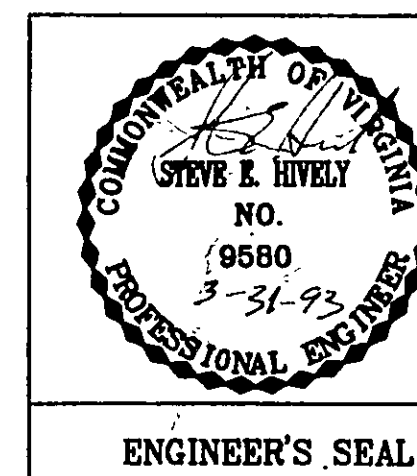

Carvins Cove, Phase II
City of Roanoke
Roanoke, Virginia

CONTRACT "C2"
LINE 350
STA 61+20.27 - 73+51.10

Drawn By: ACF/RE
Designed By: RE
Checked By: RE
Date: MARCH 9
Scale: V. 1" = 100'
H. 1" = 10'
Plan Number: 100
Zone: 100
Sheet: 100
File: 100

Dewberry & Davis
Architects
Engineers
Planners
Surveyors
5238 Valleypointe Parkway, Suite One-B
Roanoke, Virginia 24019
703 382-7725