

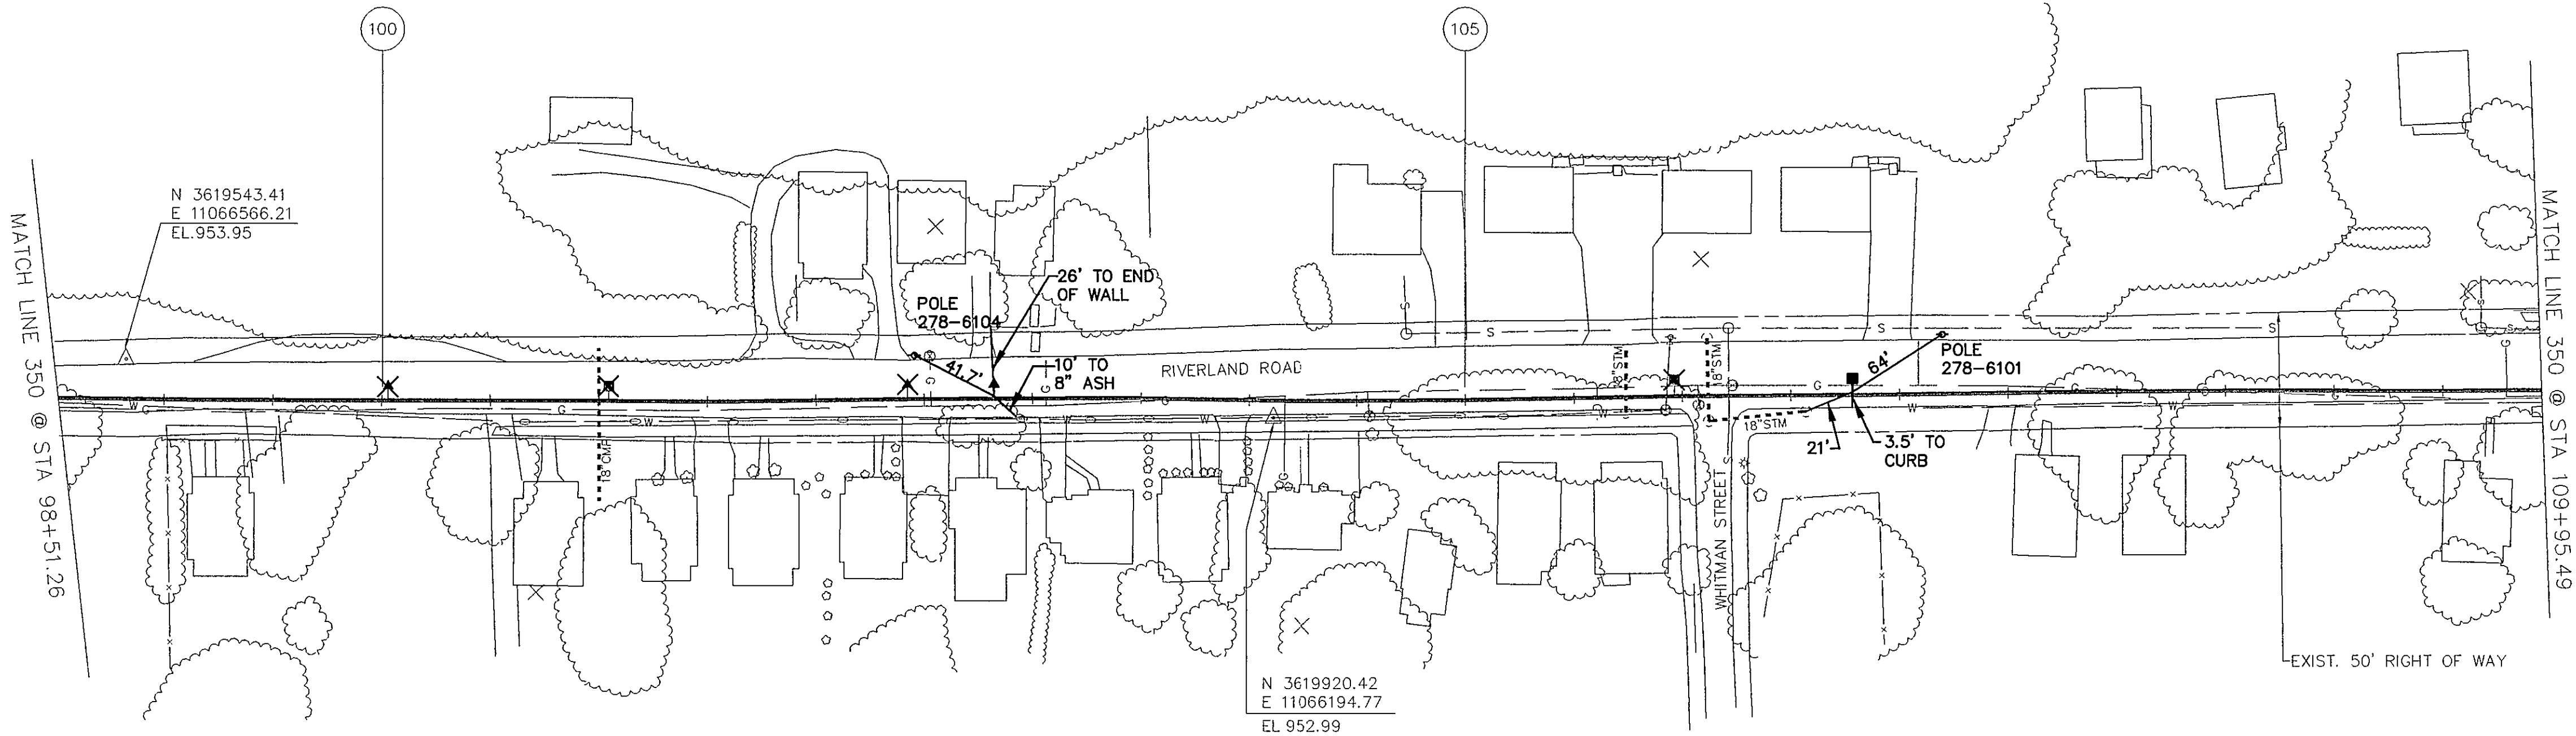
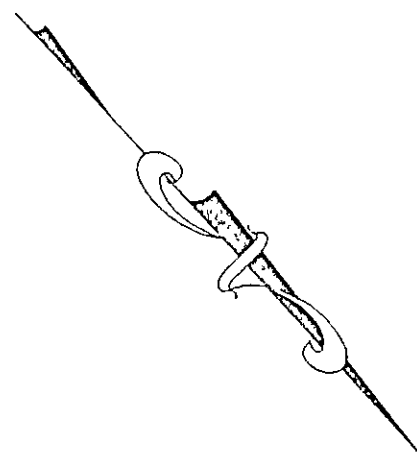
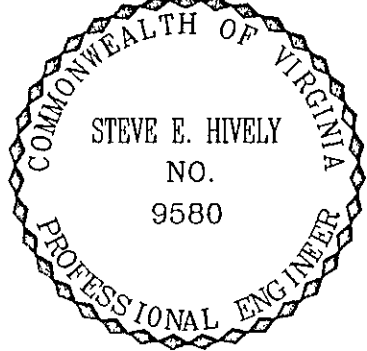


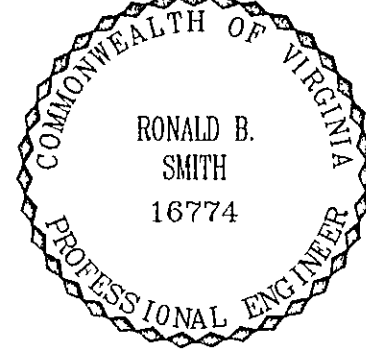


PLAN VIEW LINE 350

THIS SHEET
1144 LF 24" WATERMAIN
1 EA. 6" BLOWOFF
1 EA. 1" A.R.V.

 ENGINEER'S SEAL	 ENGINEER'S SEAL
---	---

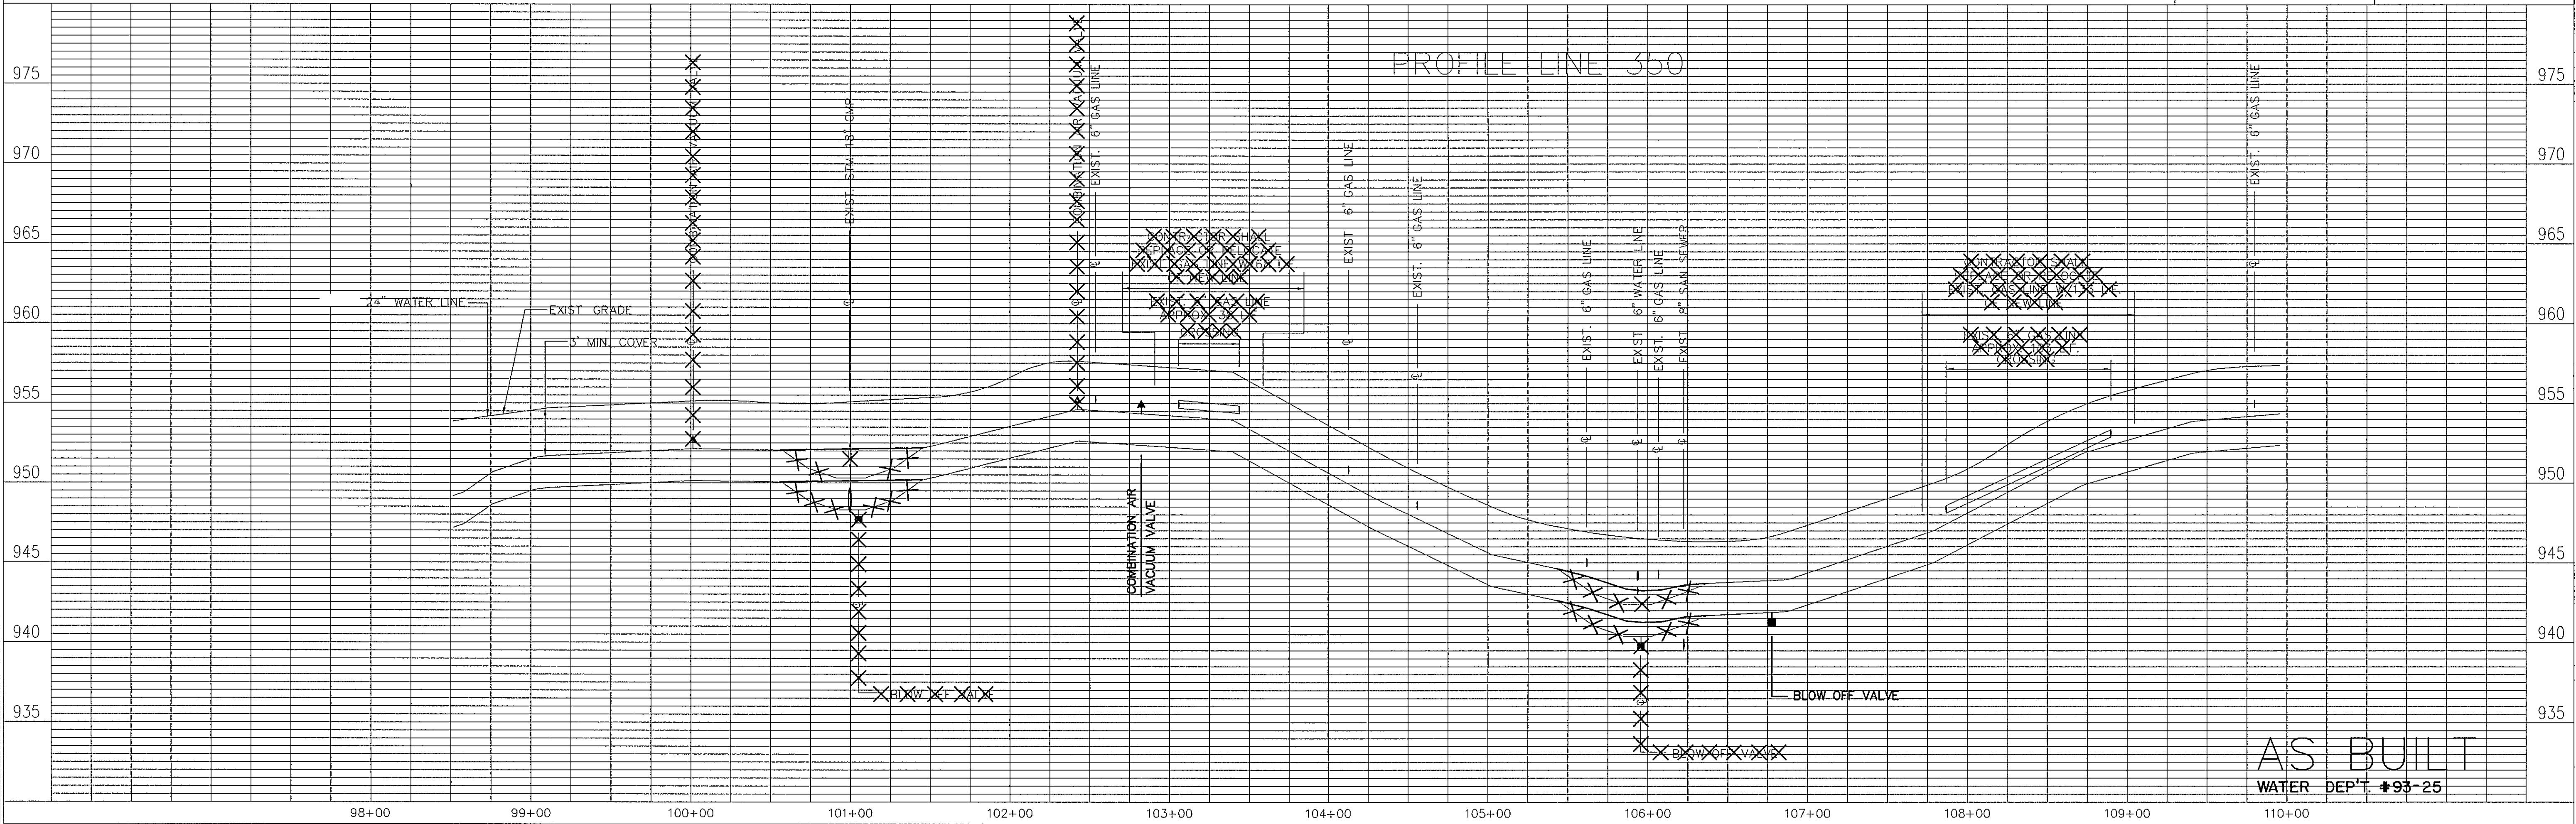

AS BUILT
WATER DEPT. #93-25

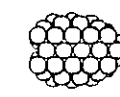 Dewberry & Davis Architects Engineers Planners Surveyors 5238 Valleypointe Parkway, Suite One-B Roanoke, Virginia 24019 703 362-7725	Carvins Cove, Phase II City of Roanoke Roanoke, Virginia
	CONTRACT "C2" LINE 350 STA 98+51.26 - 109+95.49
	Drawn By ACF/REH Designed By RBS Checked By SEH Date MARCH 93 Scale V: 1" = 5' H: 1" = 50' Plan Number D12 Zoned NONE Sheet 9 of 25 File Number C1160