

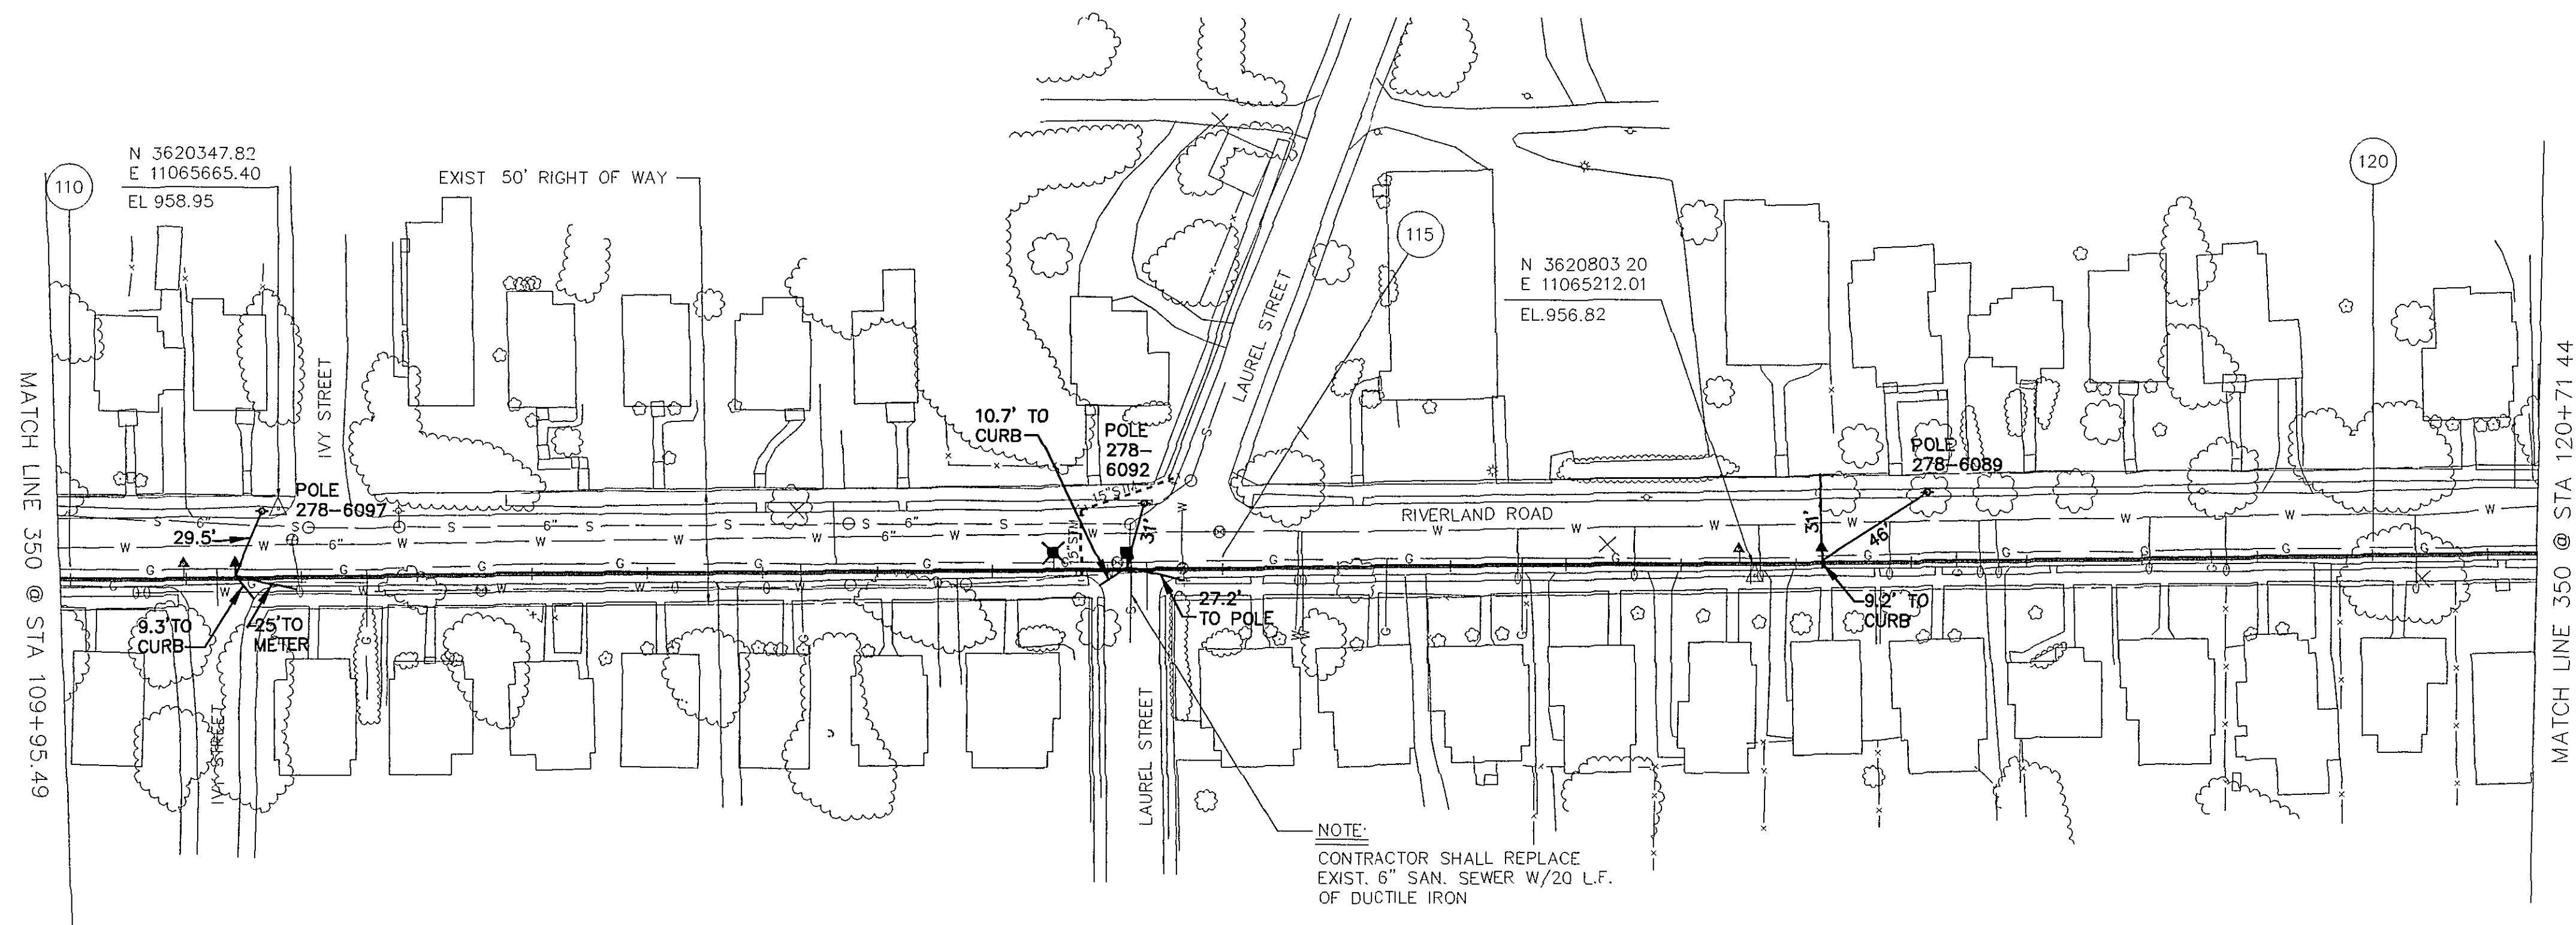


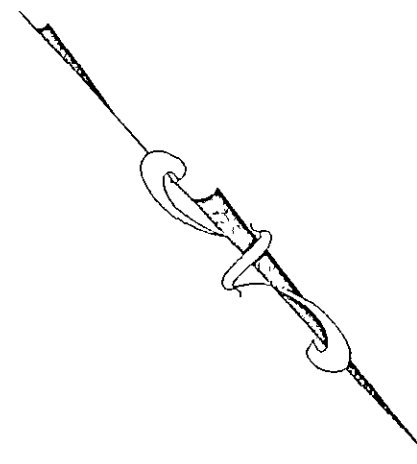

PLAN VIEW LINE 350

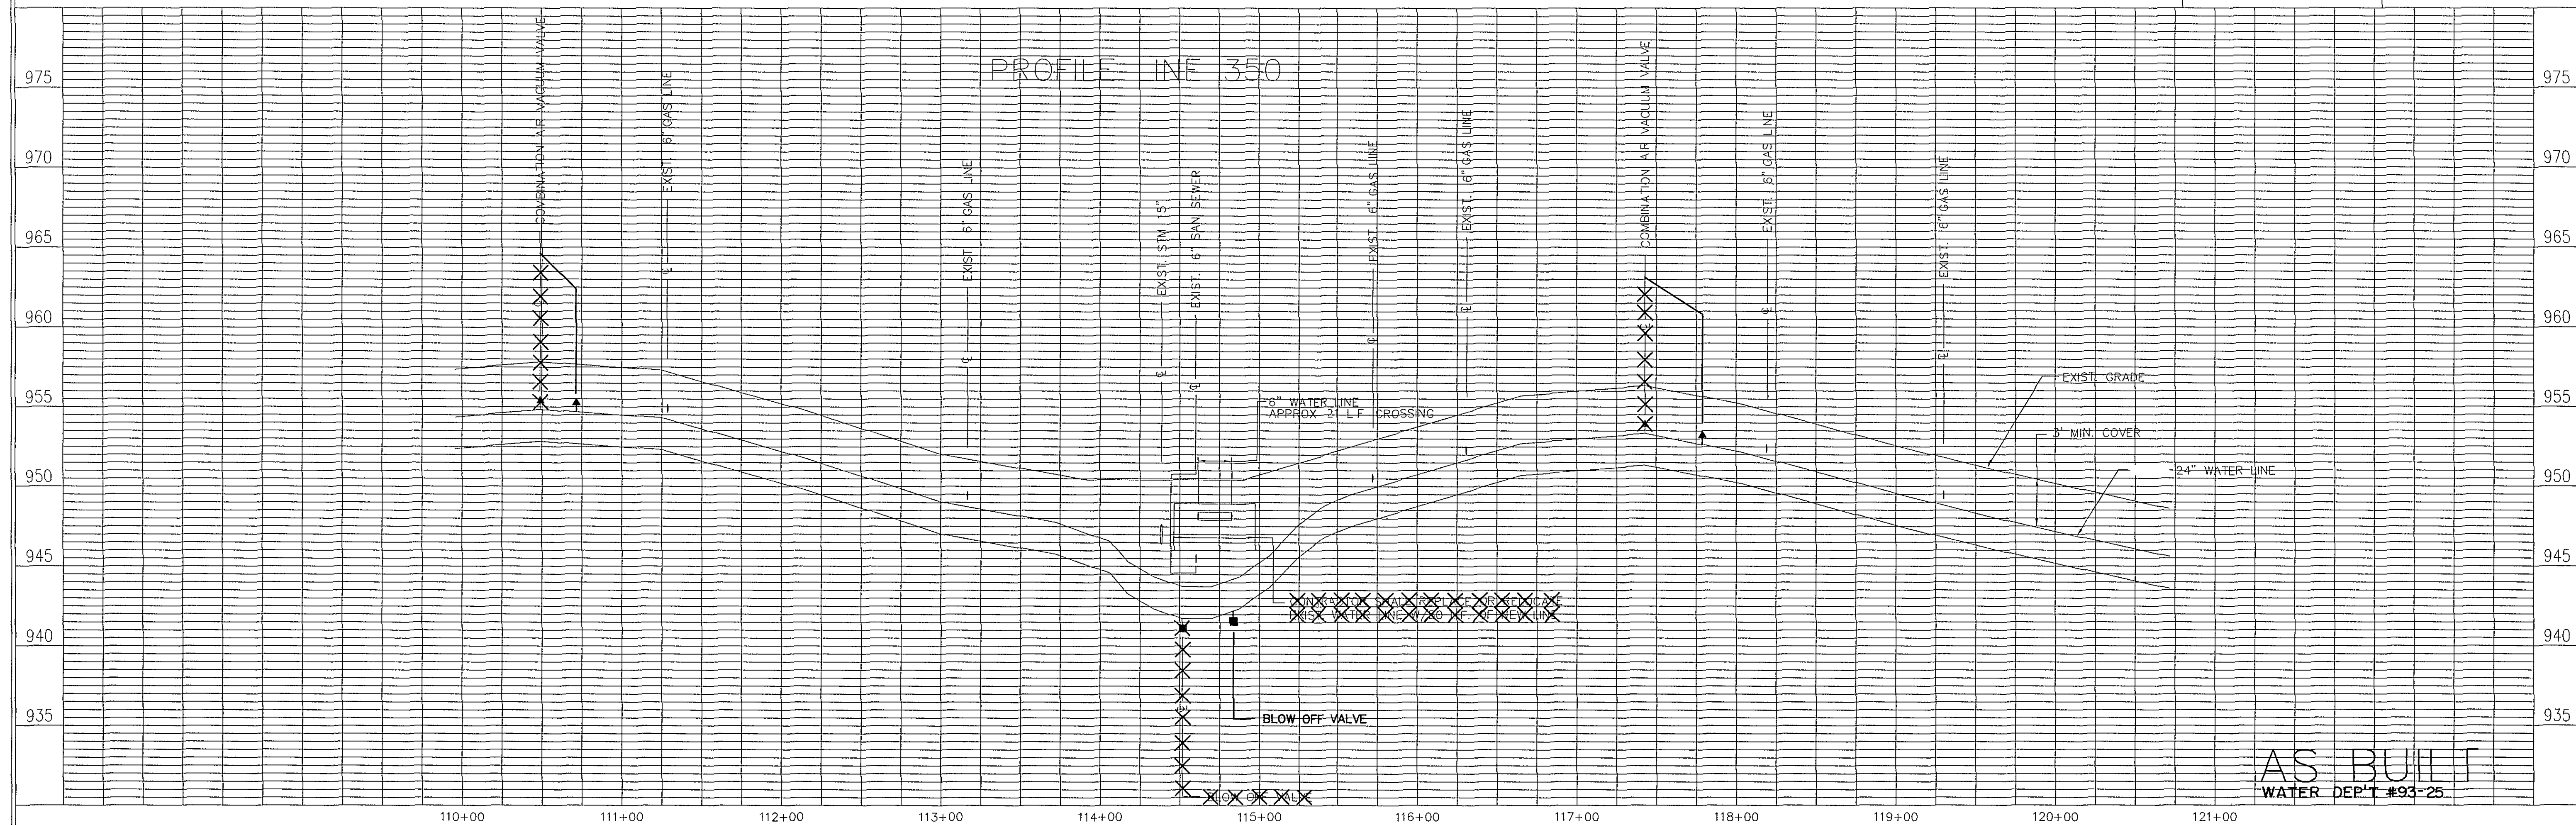

AS BUILT
WATER DEPT #93-25

THIS SHEET
1076 LF 24" WATERMAIN
1 EA. 6" BLOWOFF
2 EA. 1" A.R.V.

 ENGINEER'S SEAL	 ENGINEER'S SEAL
---------------------	---------------------

Dewberry & Davis Architects Engineers Planners Surveyors 5238 Valleypointe Parkway, Suite One-B Roanoke, Virginia 24019 ☎ 703 362-7725	Carvins Cove, Phase II City of Roanoke Roanoke, Virginia
	CONTRACT "C2" LINE 350 STA 109+95.49 - 120+71.44
	Drawn By REH/ACF Designed By RBS Checked By SEH Date MARCH 93 Scale V. 1" = 5' H. 1" = 50' Plan Number D13 Zoned NONE Sheet 10 of 25 File Number C1160