


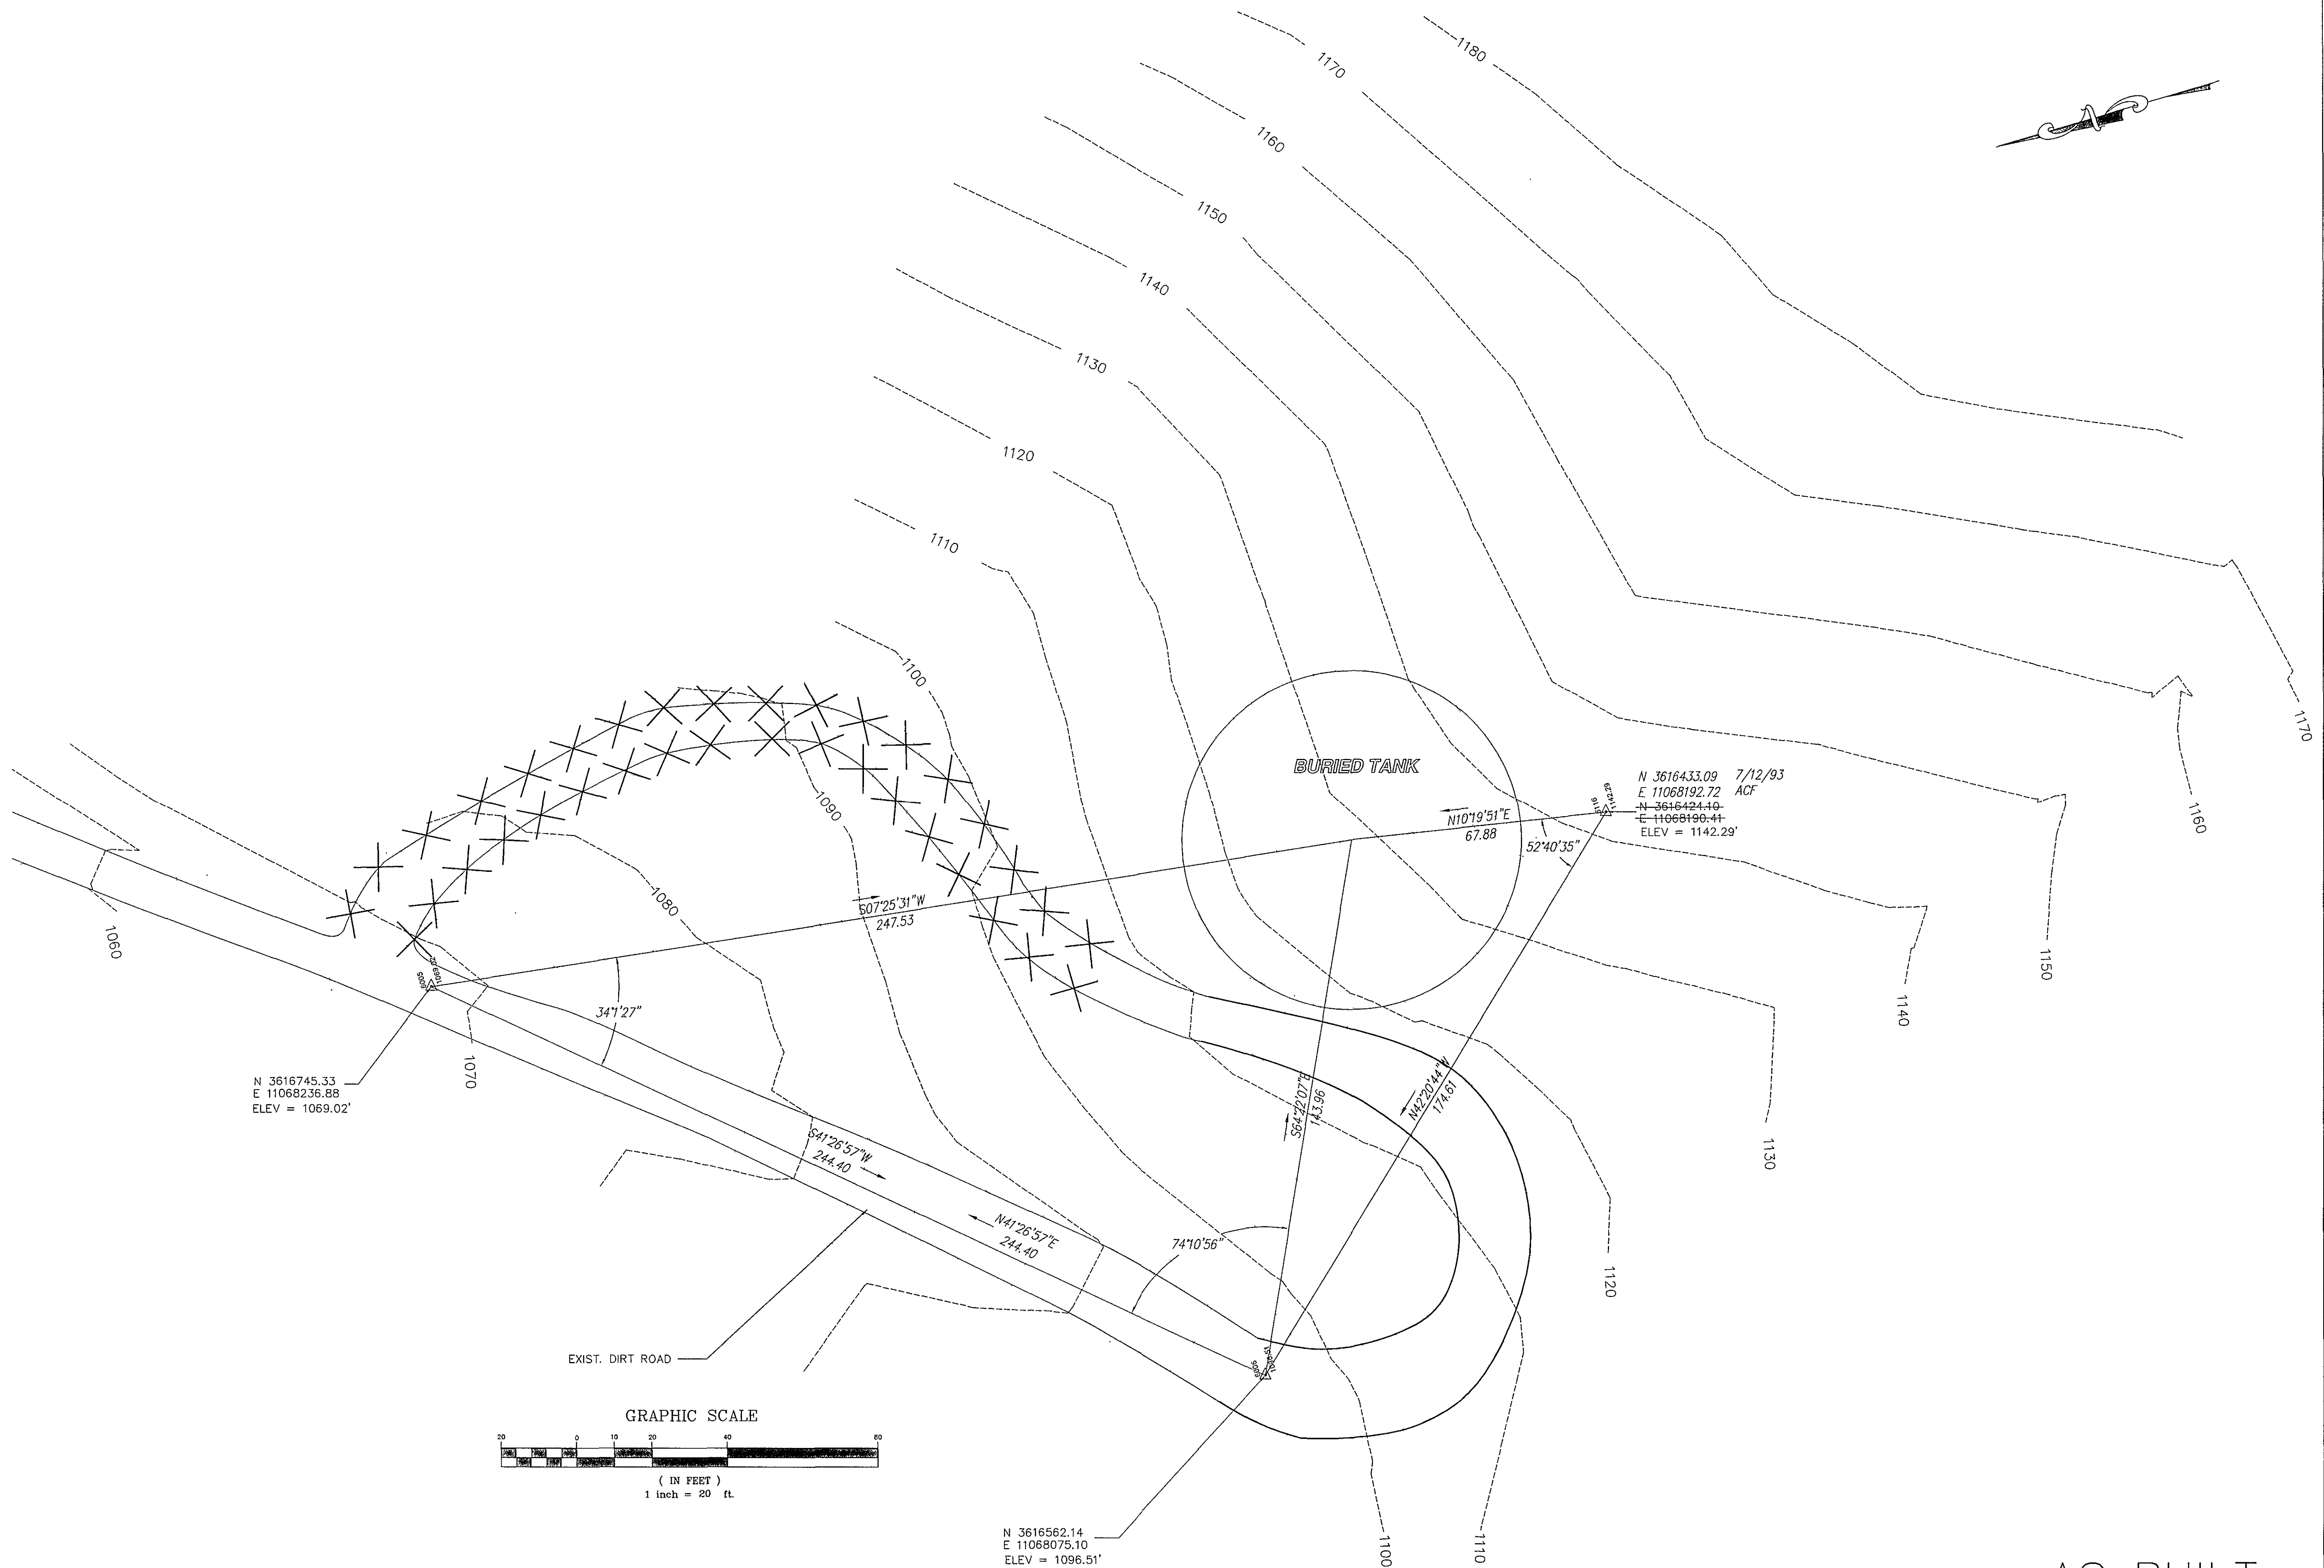

AS BUILT

WATER DEP'T. #93-25