


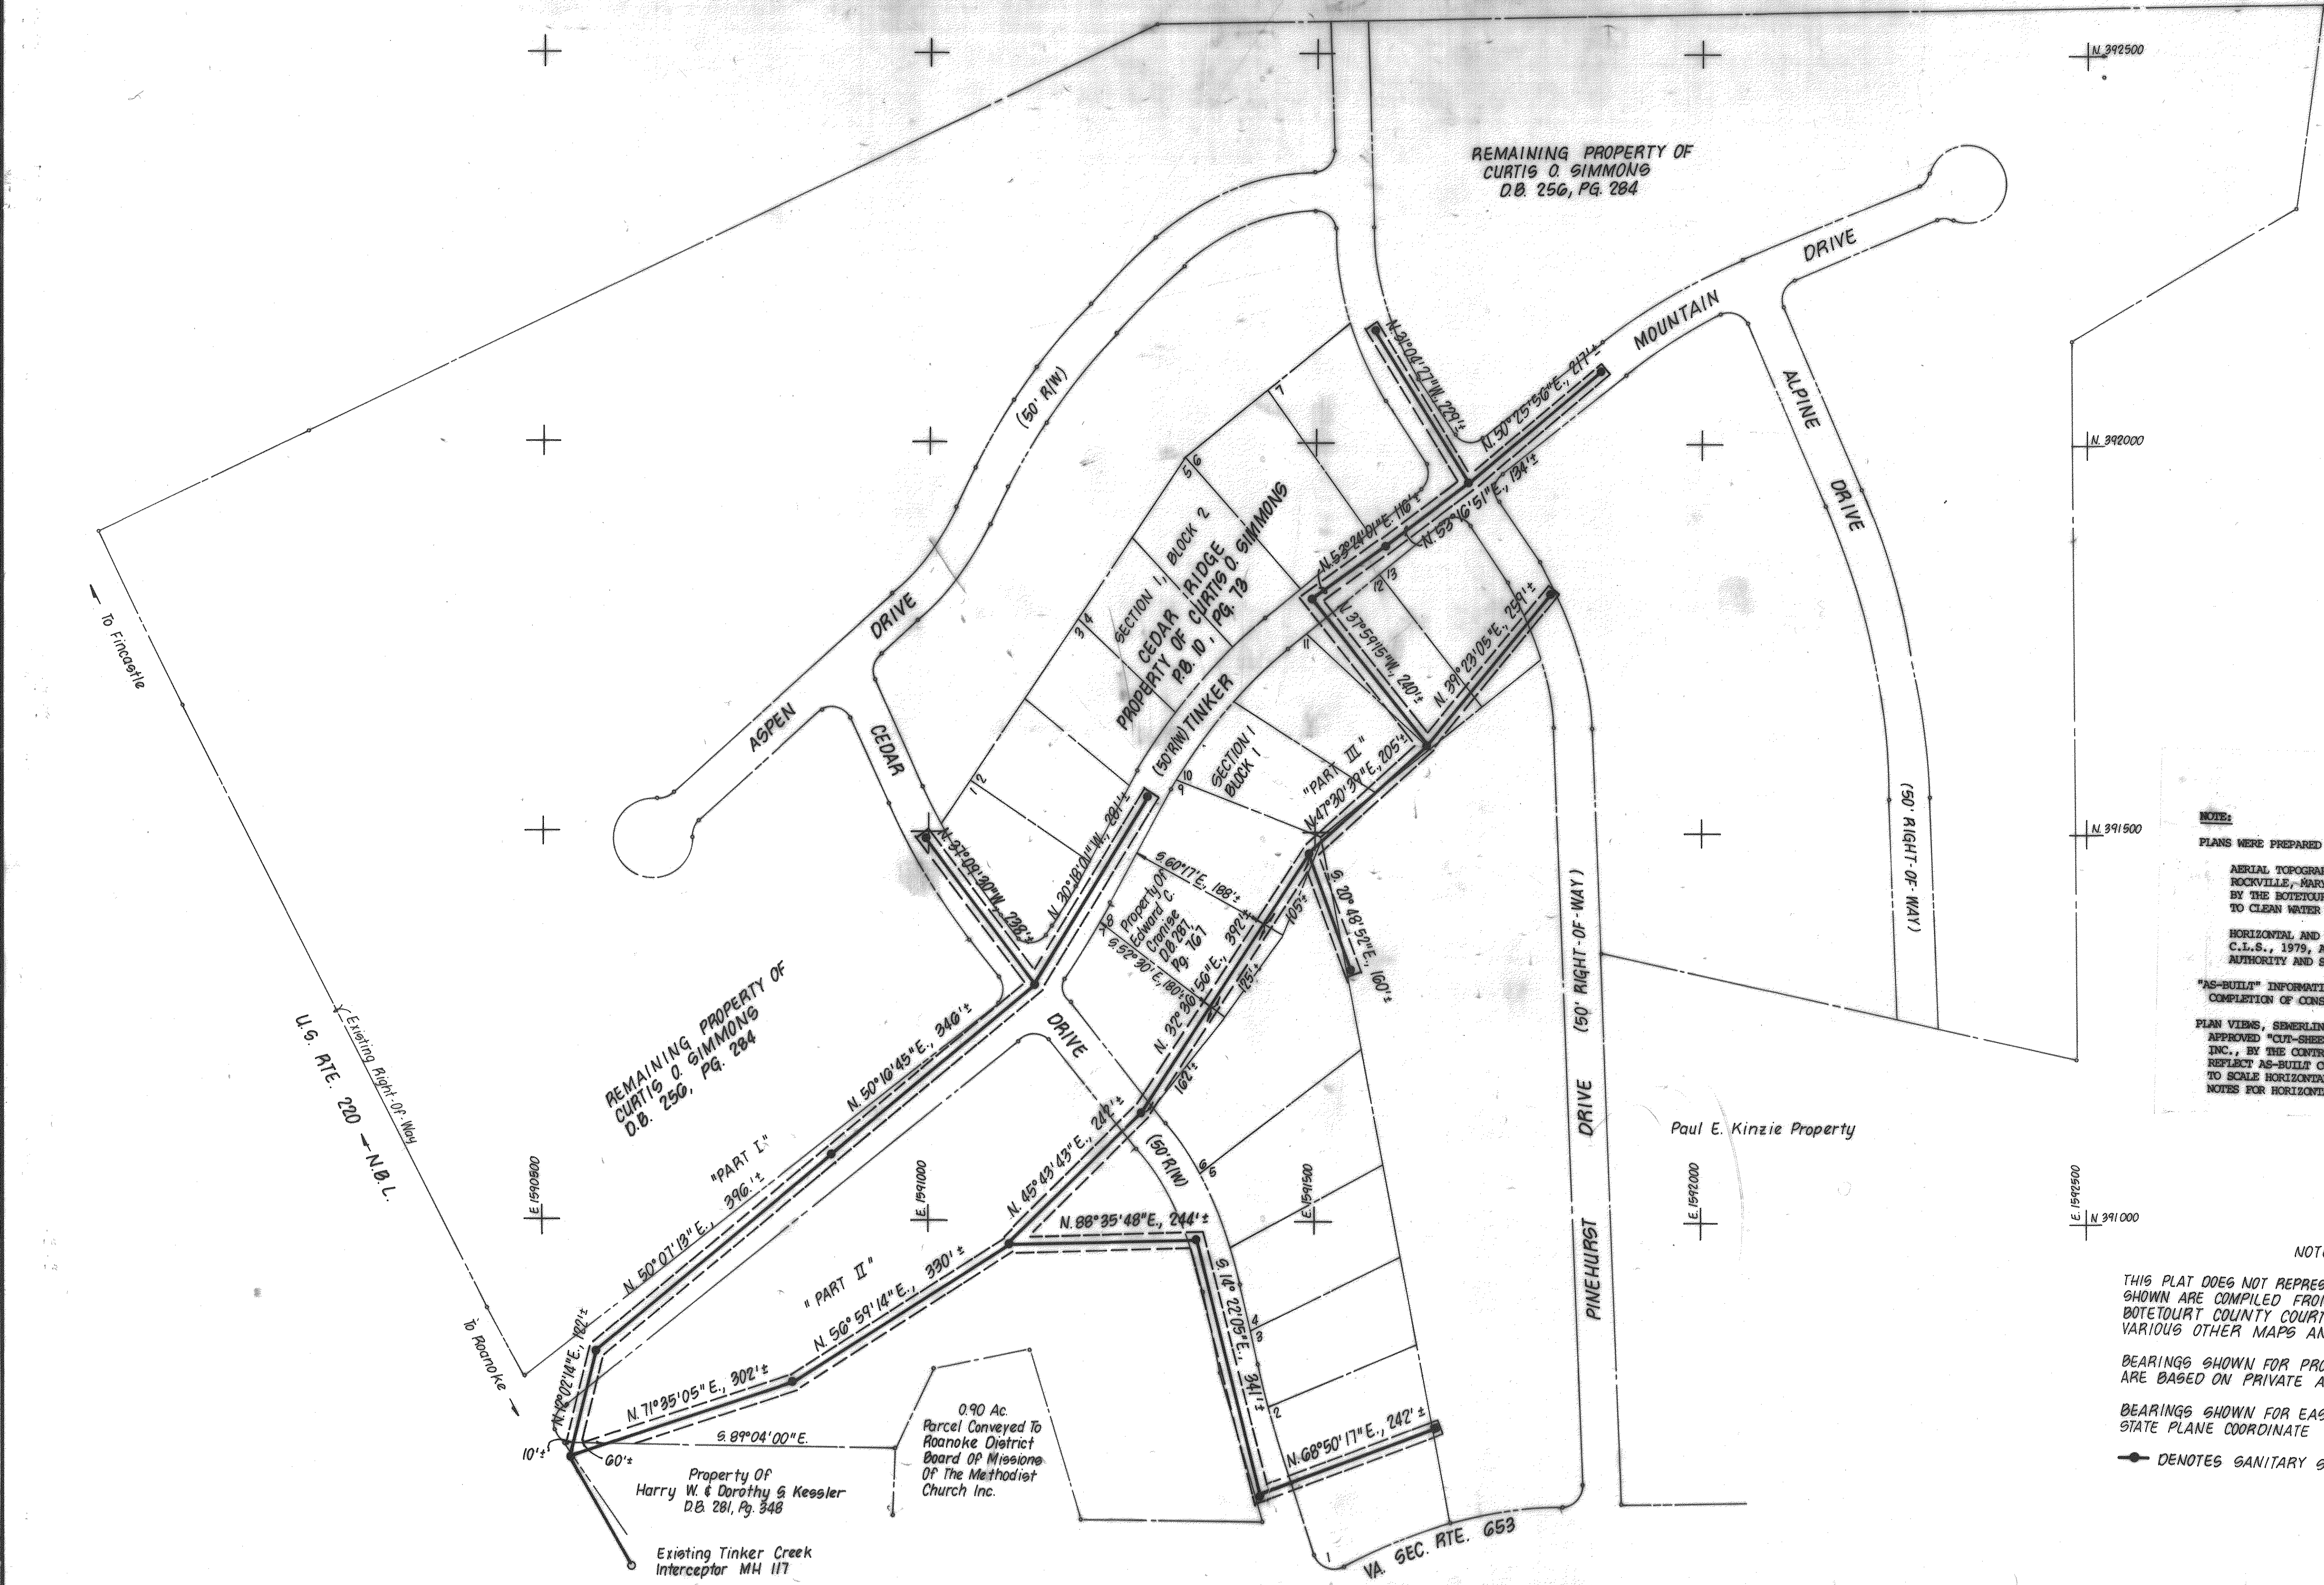

PROJECT NAME:	CEWA 8207E Sewer System
DATE:	11/18/86
LOCATION:	8207E
TOTAL SHEETS:	8
DATE:	11/18/86
BY:	CLW
# OF SETS:	1


NOTE:
PLANS WERE PREPARED BASED ON:
AERIAL TOPOGRAPHY MAPS PREPARED BY UNIVERSAL ENGINEERING, ROCKVILLE, MARYLAND, 1979, AS CONTRACTED BY THE BOTETOURT COUNTY SERVICE AUTHORITY AND SUPPLIED TO CLEAN WATER ENGINEERS, INC.
HORIZONTAL AND VERTICAL GROUND CONTROL BY CHARLES R. MURRAY, C.L.S., 1979, AS CONTRACTED BY THE BOTETOURT COUNTY SERVICE AUTHORITY AND SUPPLIED TO CLEAN WATER ENGINEERS, INC.
"AS-BUILT" INFORMATION WAS BASED ON EXISTING GROUND CONDITIONS AT COMPLETION OF CONSTRUCTION.
PLAN VIEWS, SEWERLINE GRADES, MANHOLE INVERTS ARE ALL CORRECT BASED ON APPROVED "CUT-SHEET" DATA AS SUPPLIED TO CLEAN WATER ENGINEERS, INC., BY THE CONTRACTOR. THE GROUND PROFILE WAS NOT ADJUSTED TO REFLECT AS-BUILT CONDITIONS, THEREFORE THE PROFILES MAY NOT BE TO SCALE HORIZONTALLY OR VERTICALLY. REFER TO THE NUMERICAL NOTES FOR HORIZONTAL DISTANCE AND SEWERLINE GRADES, DO NOT SCALE.

NOTES:
THIS PLAT DOES NOT REPRESENT AN ACTUAL FIELD SURVEY. ALL DATA SHOWN ARE COMPILED FROM EXISTING DEEDS RECORDED IN THE BOTETOURT COUNTY COURTHOUSE, FINCASTLE, VIRGINIA AND FROM VARIOUS OTHER MAPS AND SURVEYS.
BEARINGS SHOWN FOR PROPERTY LINES AND RIGHT-OF-WAY LINES ARE BASED ON PRIVATE AND STATE SURVEYS.
BEARINGS SHOWN FOR EASEMENT LINES ARE BASED ON VIRGINIA STATE PLANE COORDINATE SYSTEM.
—●— DENOTES SANITARY SEWER MANHOLE.

Designed:	CFA
Drafted:	CFA
Checked:	DJR
Approved:	DJR

Clean Water Engineers, Inc.
Fincastle, Virginia

PLAT OF EASEMENT
FOR CEDAR RIDGE
BOTETOURT COUNTY, VIRGINIA

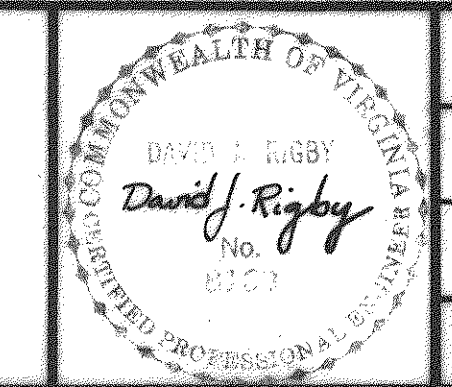

Sheet:	1 of 1
Scale:	1" = 100'
Date:	DEC. 1984
Project:	8207



CEDAR RIDGE SUBDIVISION, PHASE II
VALLEY MAGISTERIAL DISTRICT
BOTETOURT COUNTY, VIRGINIA
PB 11 PG 54 & PB 11 PG 55

- CEDAR RIDGE SUBDIVISION PHASE II SEWERLINES CONSTRUCTED BY CURTIS O. SIMMONS, DEVELOPER FOR DEDICATION TO BOTETOURT COUNTY
- - - LIMITS OF 20' PERMANENT EASEMENT, RUNNING WITH THE CENTERLINE OF THE SEWER PIPE.
- CEDAR RIDGE SUBDIVISION PHASE I SEWERLINES CONSTRUCTED BY CURTIS O. SIMMONS, DEVELOPER PREVIOUSLY DEDICATED TO BOTETOURT COUNTY SERVICE AUTHORITY SEE PLAT OF EASEMENT DATED DEC. 1984

NOTES:


VERTICAL CONTROL: NATIONAL GEODETIC VERTICAL DATUM
MEAN SEA LEVEL 1929
HORIZONTAL CONTROL: ASSUMED

THIS PLAT DOES NOT REPRESENT AN ACTUAL FIELD SURVEY. ALL DATA SHOWN ARE COMPILED FROM EXISTING DEEDS RECORDED IN THE BOTETOURT COUNTY COURTHOUSE, FINCASTLE, VIRGINIA AND FROM VARIOUS OTHER MAPS AND SURVEYS.

BEARINGS SHOWN FOR PROPERTY LINES AND RIGHT-OF-WAY LINES ARE BASED ON PRIVATE AND STATE SURVEYS.

BEARINGS SHOWN FOR EASEMENT LINES ARE BASED ON VIRGINIA STATE PLANE COORDINATE SYSTEM.

- DENOTES SANITARY SEWER MANHOLE.
- DENOTES SANITARY SERVICE CLEANOUT.

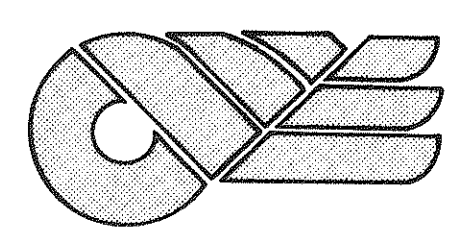


CLEAN WATER ENGINEERS, INC.

P.O. BOX 218
FINCASTLE, VIRGINIA 24090

P.O. BOX 3225
STAUNTON VIRGINIA, 24401


PLAT OF EASEMENT
FOR CEDAR RIDGE
BOTETOURT COUNTY, VIRGINIA

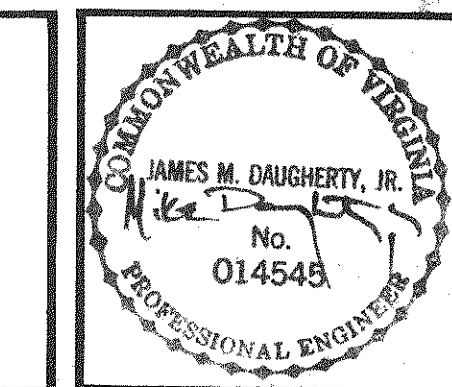

REVISIONS		
NO.	DATE	BY

DESIGNED: DJR	SHEET: 1 OF 1
DRAWN: TAM	SCALE: 1" = 100'
CHECKED: JMD	DATE: FEB., 1988
APPROVED: JMD	PROJECT: 8207-B

CEDAR RIDGE SEWER SYSTEM

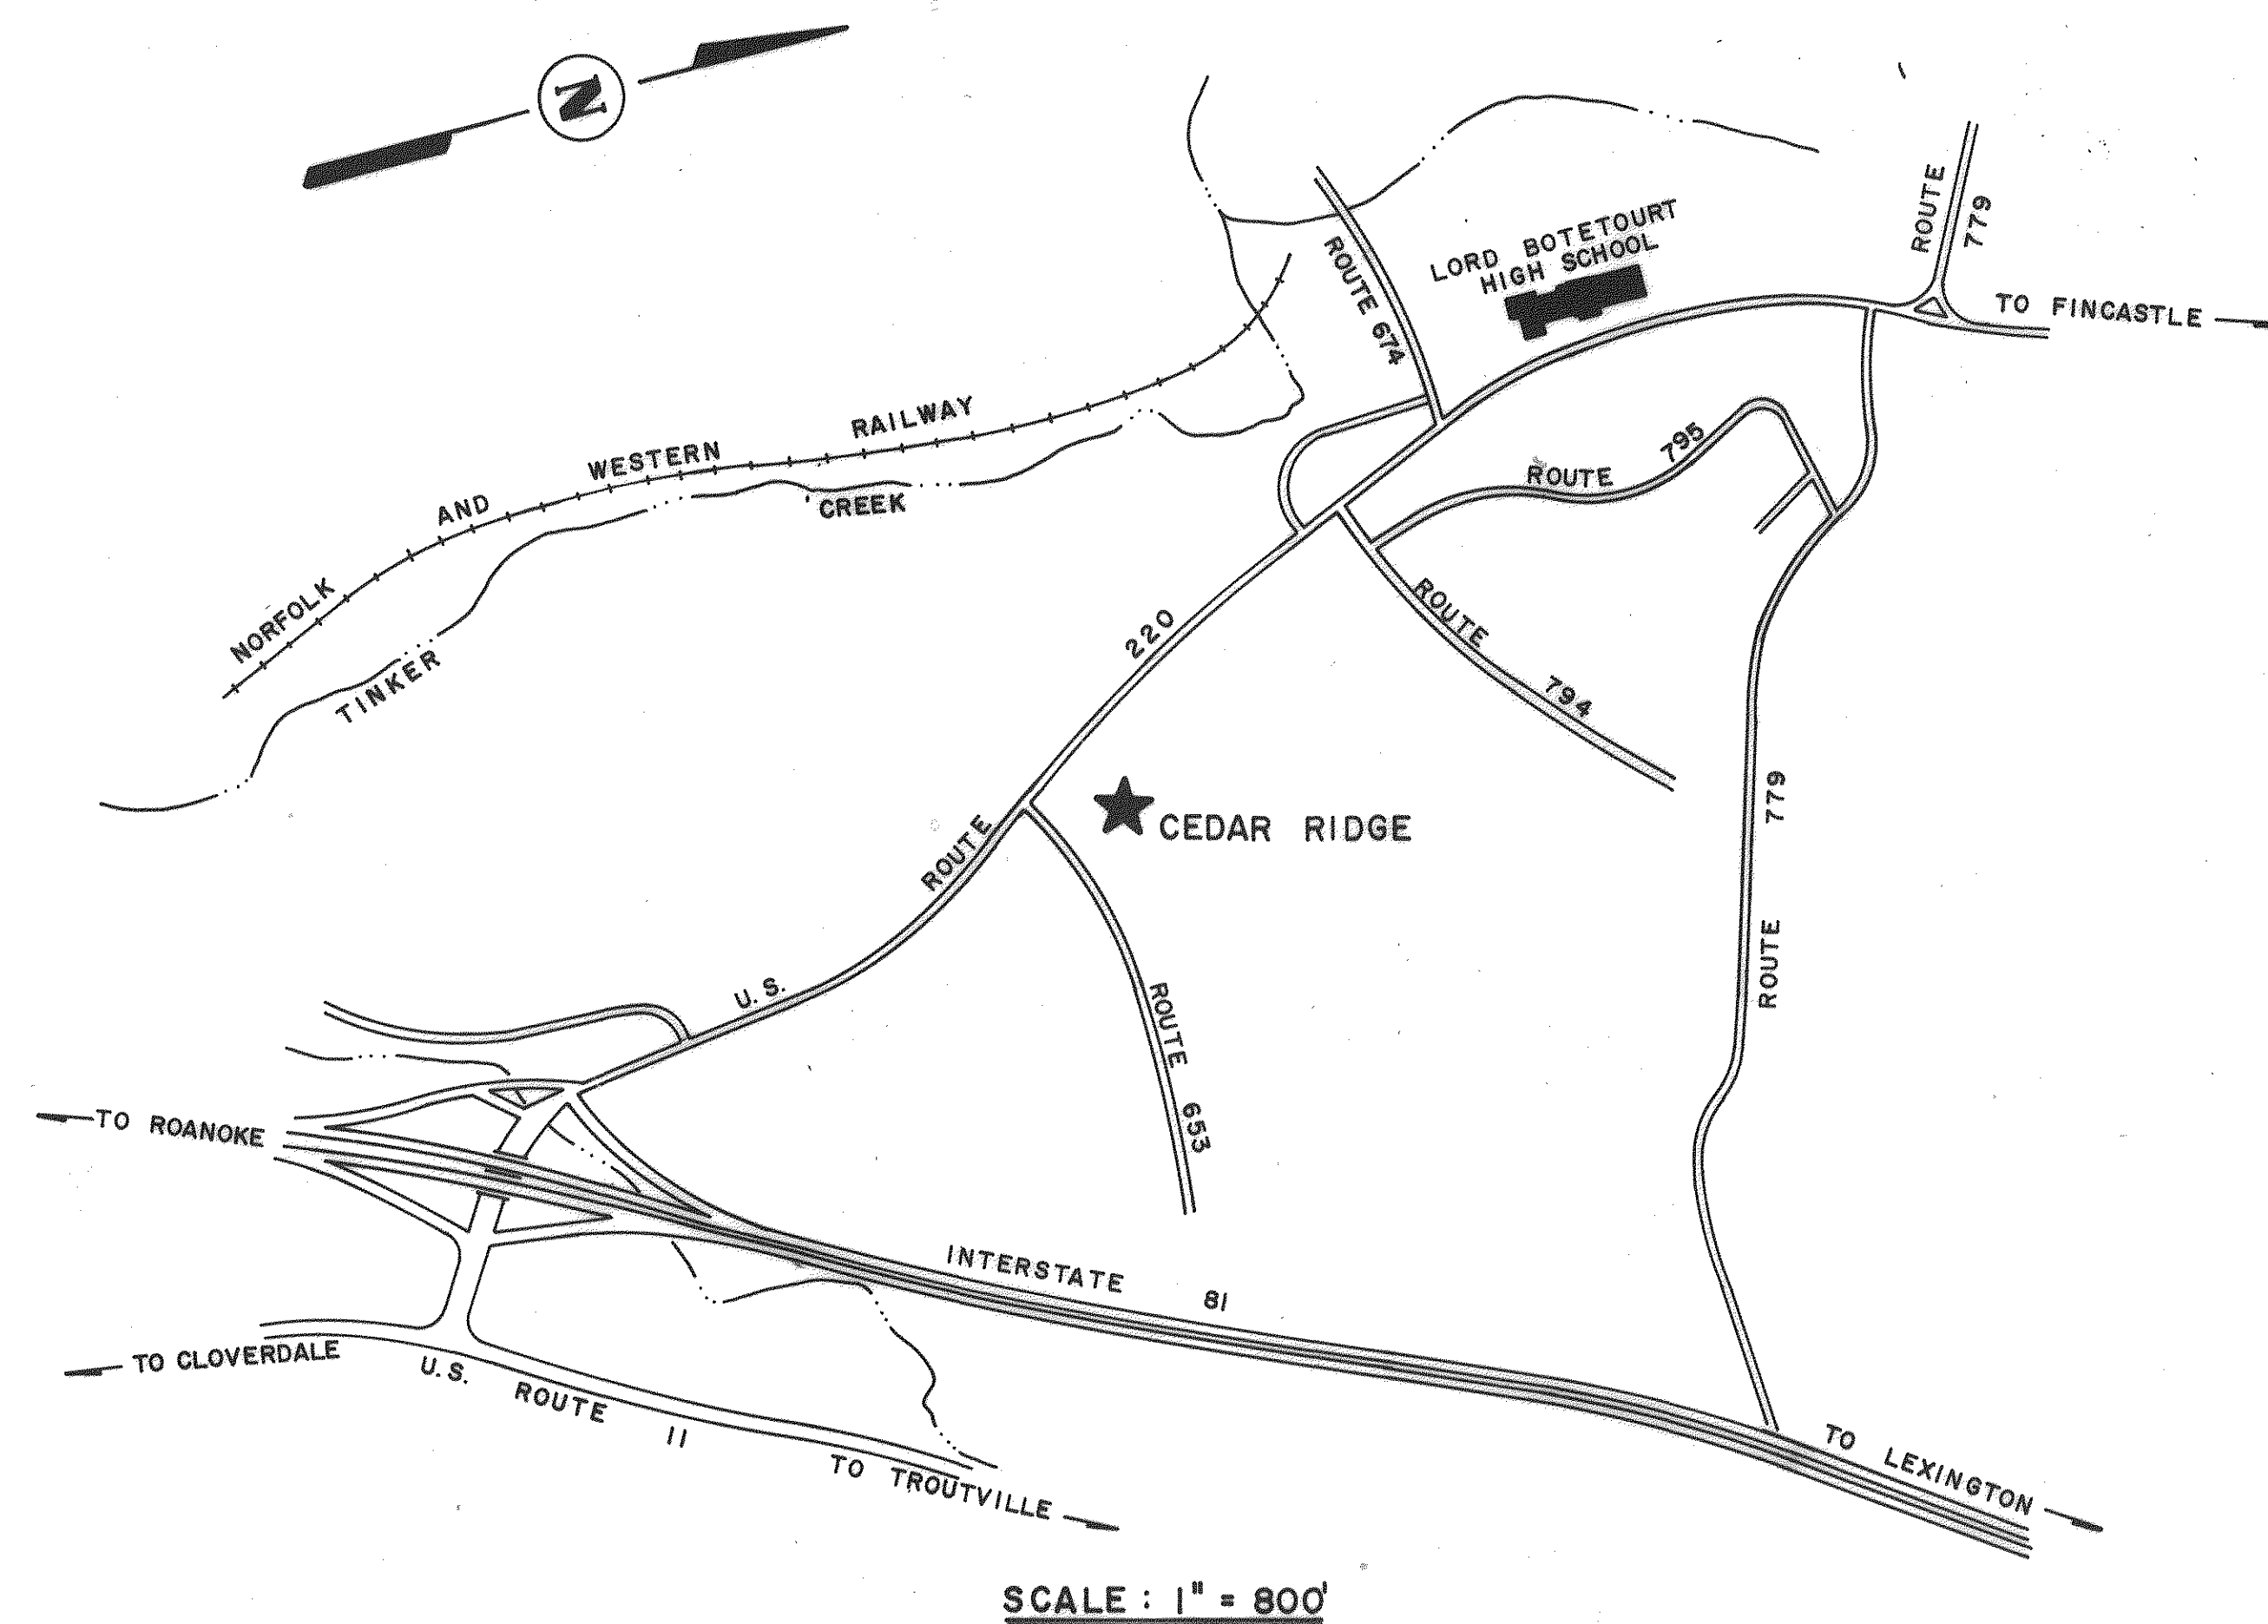

NOTE:

PLANS WERE PREPARED BASED ON:

AERIAL TOPOGRAPHY MAPPING PREPARED BY UNIVERSAL ENGINEERING, ROCKVILLE, MARYLAND FLOWN AND MAPPED 1979, AS CONTRACTED BY THE BOTETOURT COUNTY SERVICE AUTHORITY AND SUPPLIED TO CLEAN WATER ENGINEERS, INC.

HORIZONTAL AND VERTICAL GROUND CONTROL BY CHARLES R. MCMURRAY, C.L.S., 1979, AS CONTRACTED BY THE BOTETOURT COUNTY SERVICE AUTHORITY AND SUPPLIED TO CLEAN WATER ENGINEERS, INC.

"AS-BUILT" INFORMATION WAS BASED ON EXISTING GROUND CONDITIONS AT COMPLETION OF CONSTRUCTION


PLAN VIEWS, SEWERLINE GRADES, MANHOLE INVERTS ARE ALL CORRECT BASED ON APPROVED "CUT-SHEET" DATA AS SUPPLIED TO CLEAN WATER ENGINEERS, INC., BY THE CONTRACTOR. THE GROUND PROFILE WAS NOT ADJUSTED TO REFLECT AS-BUILT CONDITIONS, THEREFORE THE PROFILES MAY NOT BE TO SCALE HORIZONTALLY OR VERTICALLY. REFER TO THE NUMERICAL NOTES FOR HORIZONTAL DISTANCE AND SEWERLINE GRADES, DO NOT SCALE.

BOTETOURT COUNTY, VA

NOV. 5, 1982

CLEAN WATER ENGINEERS INC.
FINCASTLE, VIRGINIA 24090

PROJECT 8207
SHEET 1 OF 5

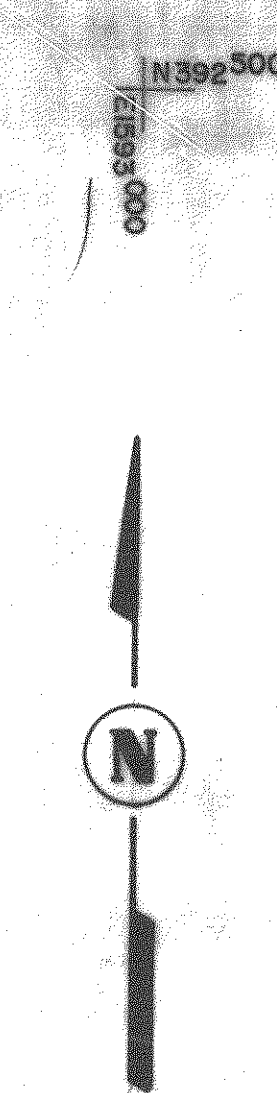

PAUL E. KINZIE
PROPERTY

NOTES

VERTICAL CONTROL : NATIONAL GEODETIC VERTICAL DATUM
MEAN SEA LEVEL 1929.

HORIZONTAL CONTROL : ASSUMED.

THE LOCATIONS OF EXISTING UNDERGROUND UTILITIES ARE
APPROXIMATE AND SHOULD BE VERIFIED BY CONTRACTOR
PRIOR TO CONSTRUCTION.

EXISTING SURFACES DISTURBED BY CONTRACTOR'S WORK
SHALL BE RESTORED TO THEIR PRESENT CONDITION.

CONTRACTOR SHALL PERFORM WORK IN SUCH A MANNER
TO MINIMIZE EROSION OF SOILS.

DUE TO RECENT GRADING AND EXCAVATION EXISTING CONTOURS
SHOWN MAY BE INACCURATE. MINOR FIELD ADJUSTMENTS
TO THE SEWER SYSTEM MAY BE REQUIRED.

FOR REVISION OF BLOCK 1, SECTION 2, REFERENCE
IS MADE TO PLAT OF SECTION NO. 2, CEDAR RIDGE
PREPARED BY T.P. PARKER & SON, ENGINEERS &
SURVEYORS, SALEM, VIRGINIA, DATED DECEMBER 10, 1984.

FOR REVISION OF BLOCK 1 AND BLOCK 2 OF SECTION
3, REFERENCE IS MADE TO PLAT OF SECTION NO. 3,
CEDAR RIDGE PREPARED BY T.P. PARKER & SON, DATED
SEPTEMBER 23, 1985.

NOTE:

PLANS WERE PREPARED BASED ON:

AERIAL TOPOGRAPHY MAPPING PREPARED BY UNIVERSAL ENGINEERING,
ROCKVILLE, MARYLAND PLANNED AND MAPPED 1979, AS CONTRACTED
BY THE BOTETOURT COUNTY SERVICE AUTHORITY AND SUPPLIED
TO CLEAN WATER ENGINEERS, INC.

HORIZONTAL AND VERTICAL GROUND CONTROL BY CHARLES R. MOURRAY,
C.L.S., 1979, AS CONTRACTED BY THE BOTETOURT COUNTY SERVICE
AUTHORITY AND SUPPLIED TO CLEAN WATER ENGINEERS, INC.

"AS-BUILT" INFORMATION WAS BASED ON EXISTING GROUND CONDITIONS AT
COMPLETION OF CONSTRUCTION.


PLAN VIEWS, SEWERLINE GRADES, MANHOLE INVERTS ARE ALL CORRECT BASED ON
APPROVED "OUT-SHEET" DATA AS SUPPLIED TO CLEAN WATER ENGINEERS,
INC., BY THE CONTRACTOR. THE GROUND PROFILE WAS NOT ADJUSTED TO
REFLECT AS-BUILT CONDITIONS, THEREFORE THE PROFILES MAY NOT BE
TO SCALE HORIZONTALLY OR VERTICALLY. REFER TO THE NUMERICAL
NOTES FOR HORIZONTAL DISTANCE AND SEWERLINE GRADES, DO NOT SCALE.

Designed: DJR
Drafted: DJR/CFA
Checked: JMD
Approved: DJR

Clean Water Engineers, Inc.
Fincastle, Virginia

CEDAR RIDGE SEWER SYSTEM
FOR
CURTIS O. SIMMONS
BOTETOURT COUNTY, VIRGINIA

REVISED 2-24-86 CFA
"AS-BUILTS"

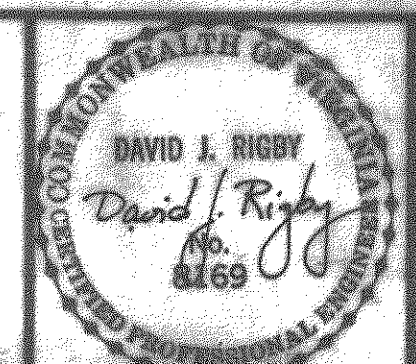

Sheet: 2 of 5
Scale: 1" = 100'
Date: NOV. 5, 1982
Project: 8207



NOTE:
PLANS WERE PREPARED BASED ON:
AERIAL TOPOGRAPHY MAPPING PREPARED BY UNIVERSAL ENGINEERING, ROCKVILLE, MARYLAND FLOWN AND MAPPED 1979, AS CONTRACTED BY THE BOTETOURT COUNTY SERVICE AUTHORITY AND SUPPLIED TO CLEAN WATER ENGINEERS, INC.
HORIZONTAL AND VERTICAL GROUND CONTROL BY CHARLES R. MCMURRAY, C.L.S., 1979, AS CONTRACTED BY THE BOTETOURT COUNTY SERVICE AUTHORITY AND SUPPLIED TO CLEAN WATER ENGINEERS, INC.
"AS-BUILT" INFORMATION WAS BASED ON EXISTING GROUND CONDITIONS AT COMPLETION OF CONSTRUCTION
PLAN VIEWS, SEWERLINE GRADES, MANHOLE INVERTS ARE ALL CORRECT BASED ON APPROVED "CUT-SHEET" DATA AS SUPPLIED TO CLEAN WATER ENGINEERS, INC., BY THE CONTRACTOR. THE GROUND PROFILE WAS NOT ADJUSTED TO REFLECT AS-BUILT CONDITIONS. THEREFORE THE PROFILES MAY NOT BE TO SCALE HORIZONTALLY OR VERTICALLY. REFER TO THE NUMERICAL NOTES FOR HORIZONTAL DISTANCE AND SEWERLINE GRADES, DO NOT SCALE.

Designed: DJR	Clean Water Engineers, Inc. Fincastle, Virginia	CEDAR RIDGE SEWER SYSTEM FOR CURTIS O. SIMMONS BOTETOURT COUNTY, VIRGINIA	"AS BUILTS"	Sheet: 2A of 5
Drafted: CCB				Scale: 1" = 100'
Checked: CFA				Date: MAR. 1986
Approved: DJR				Project: 8207

