

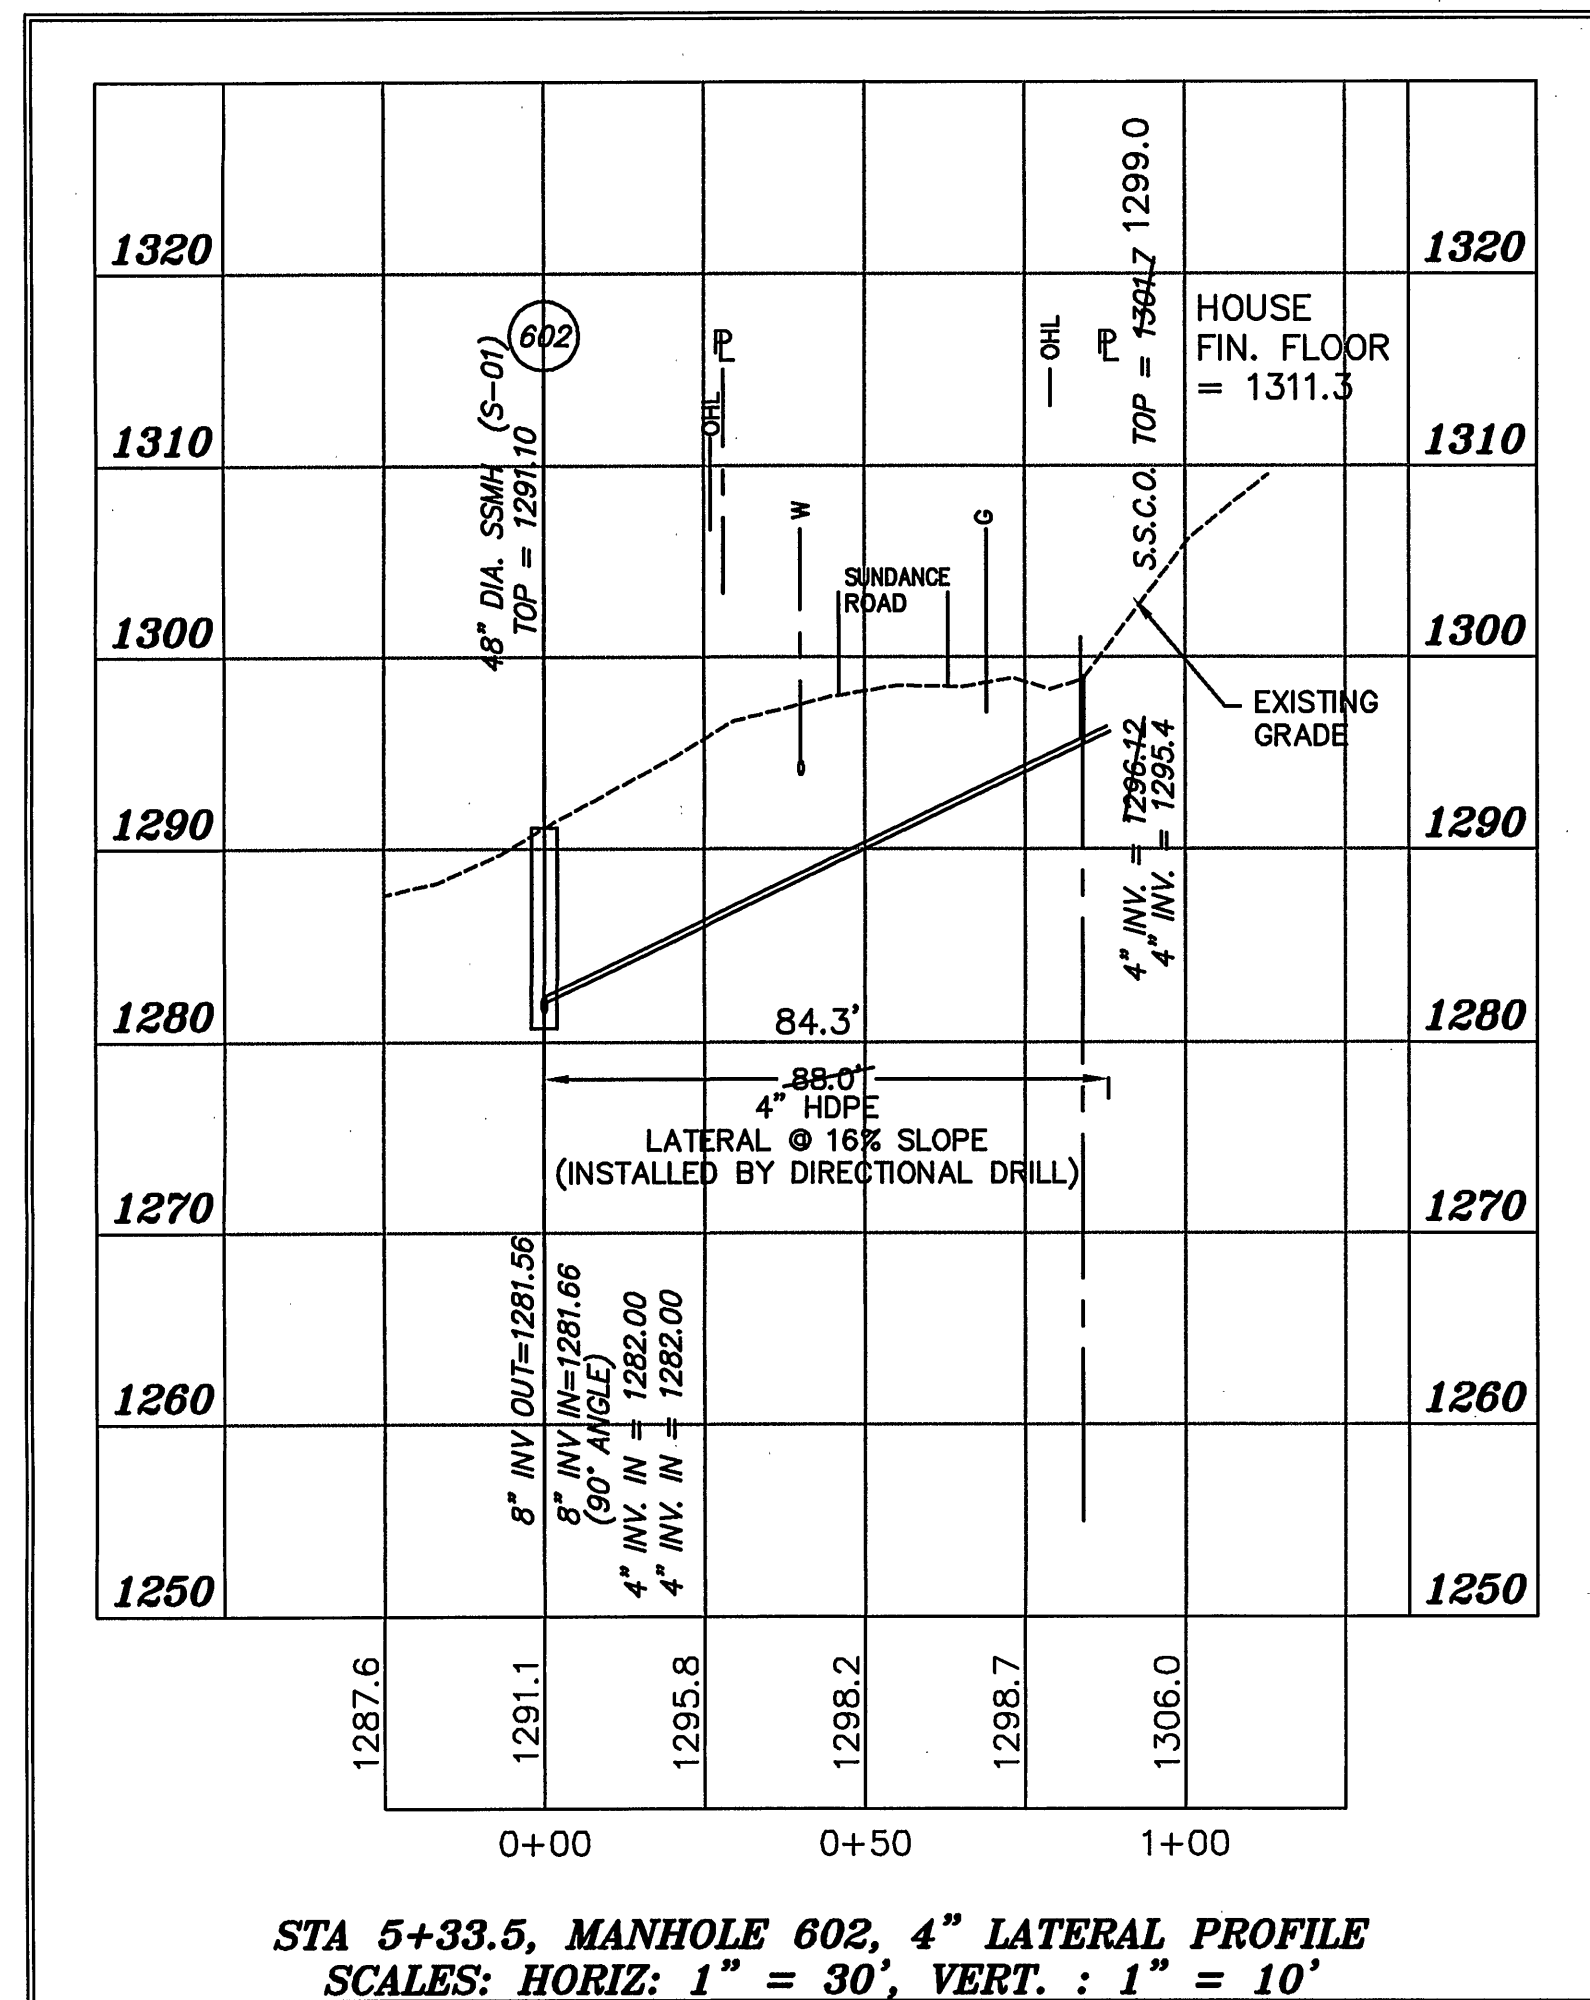
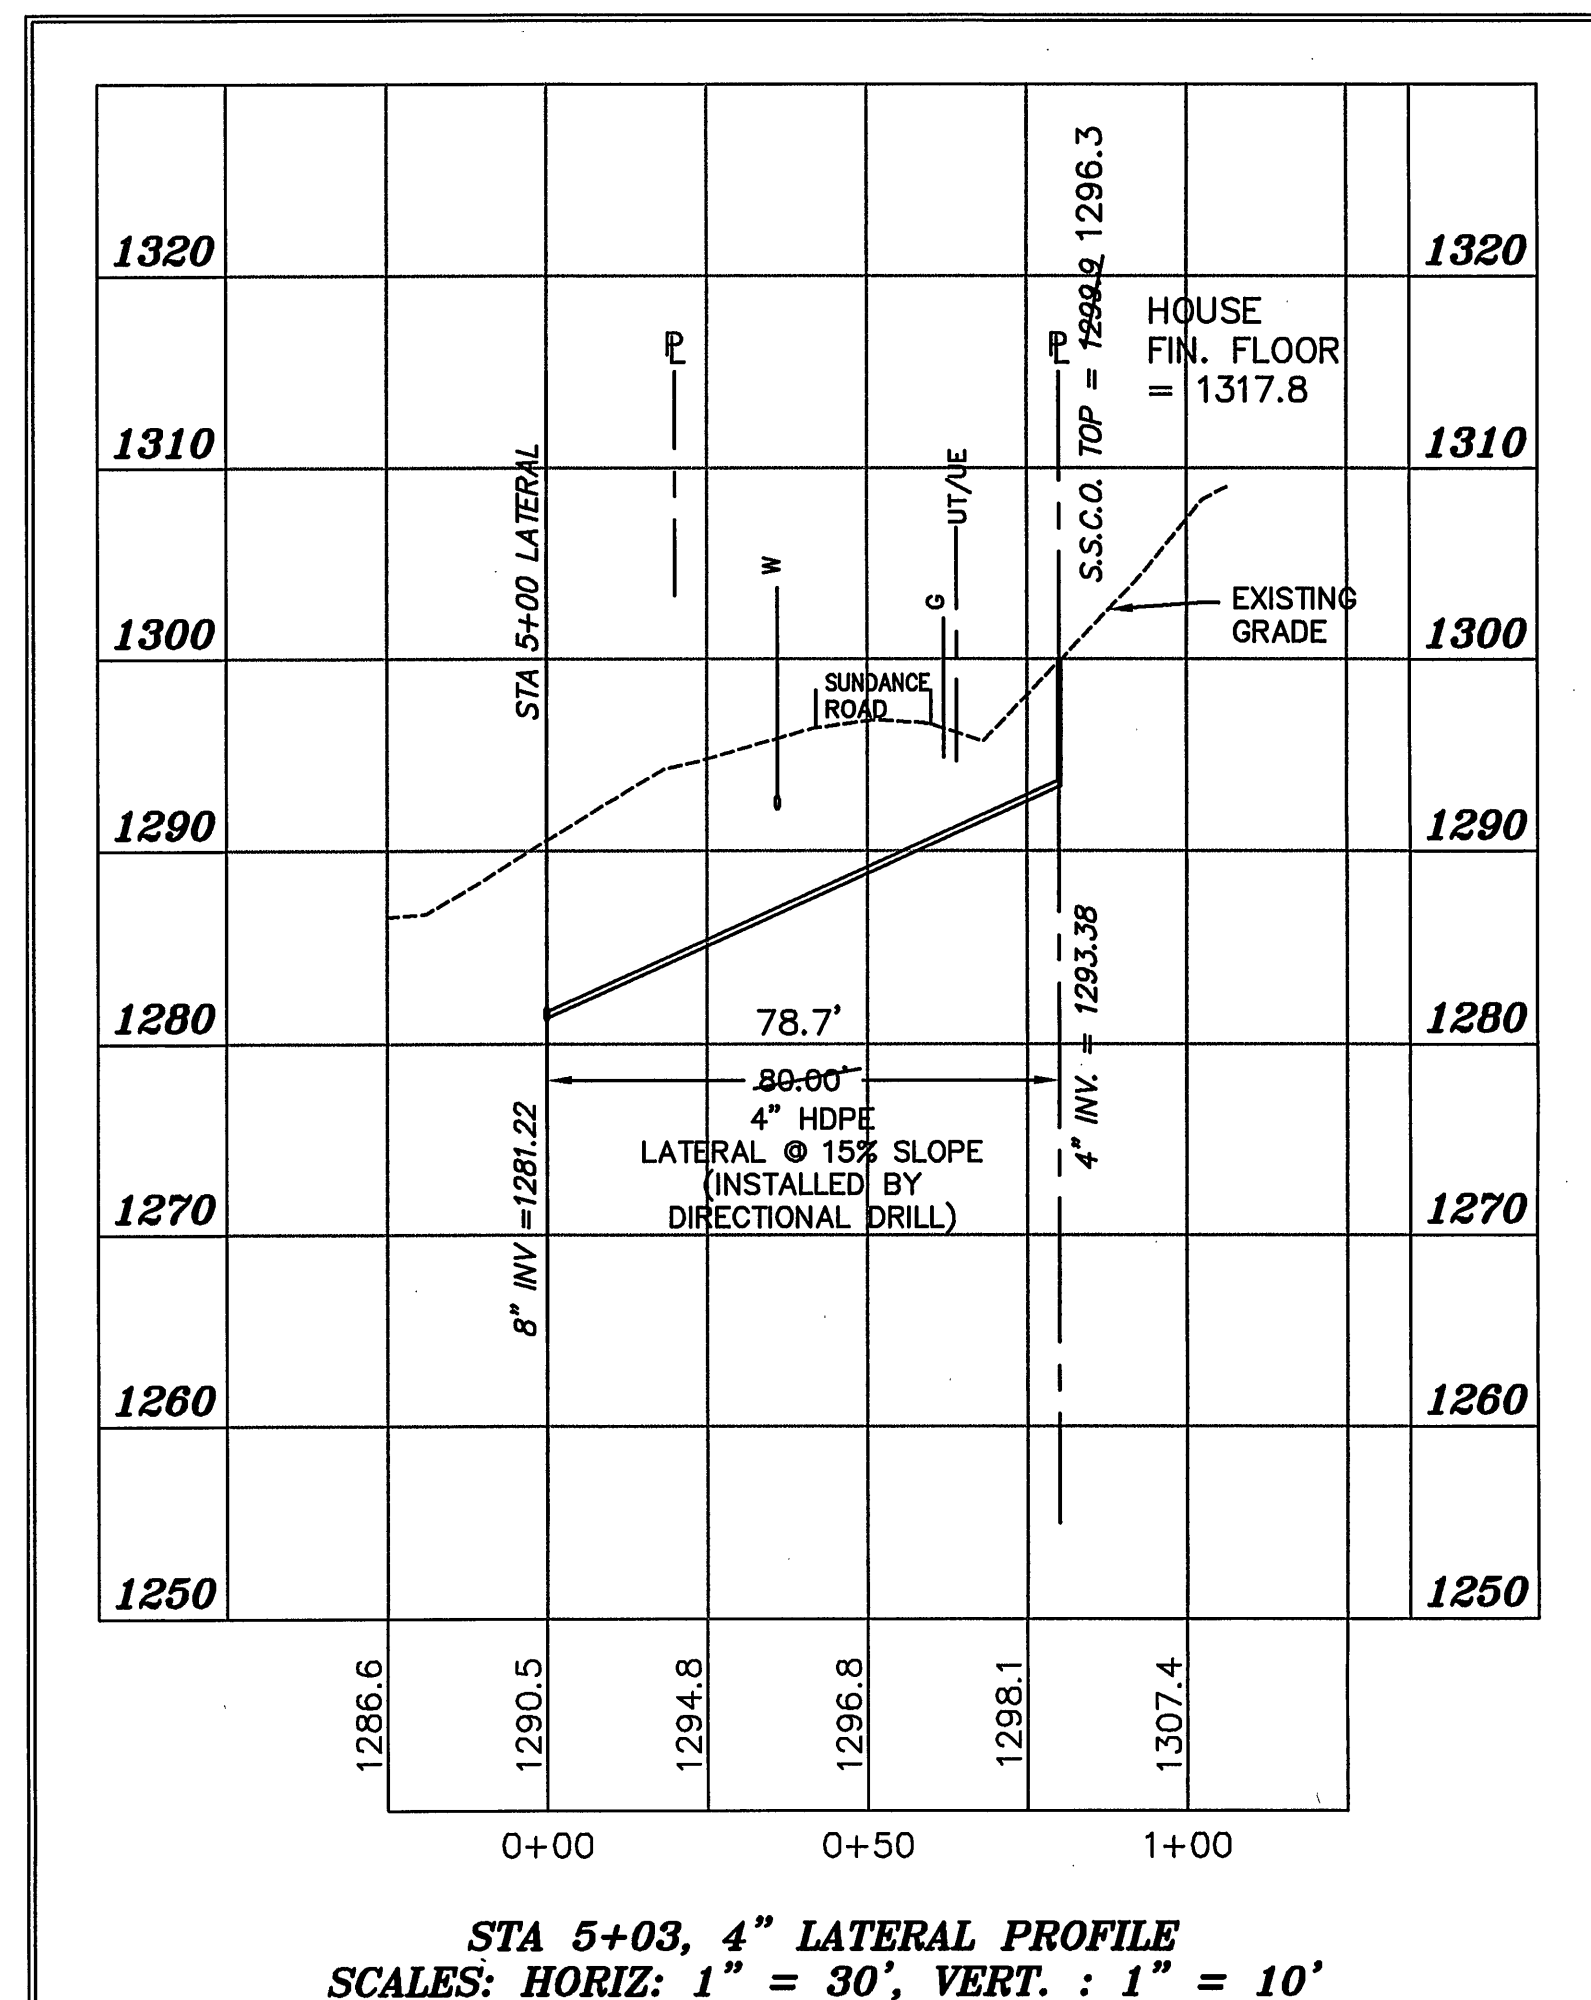
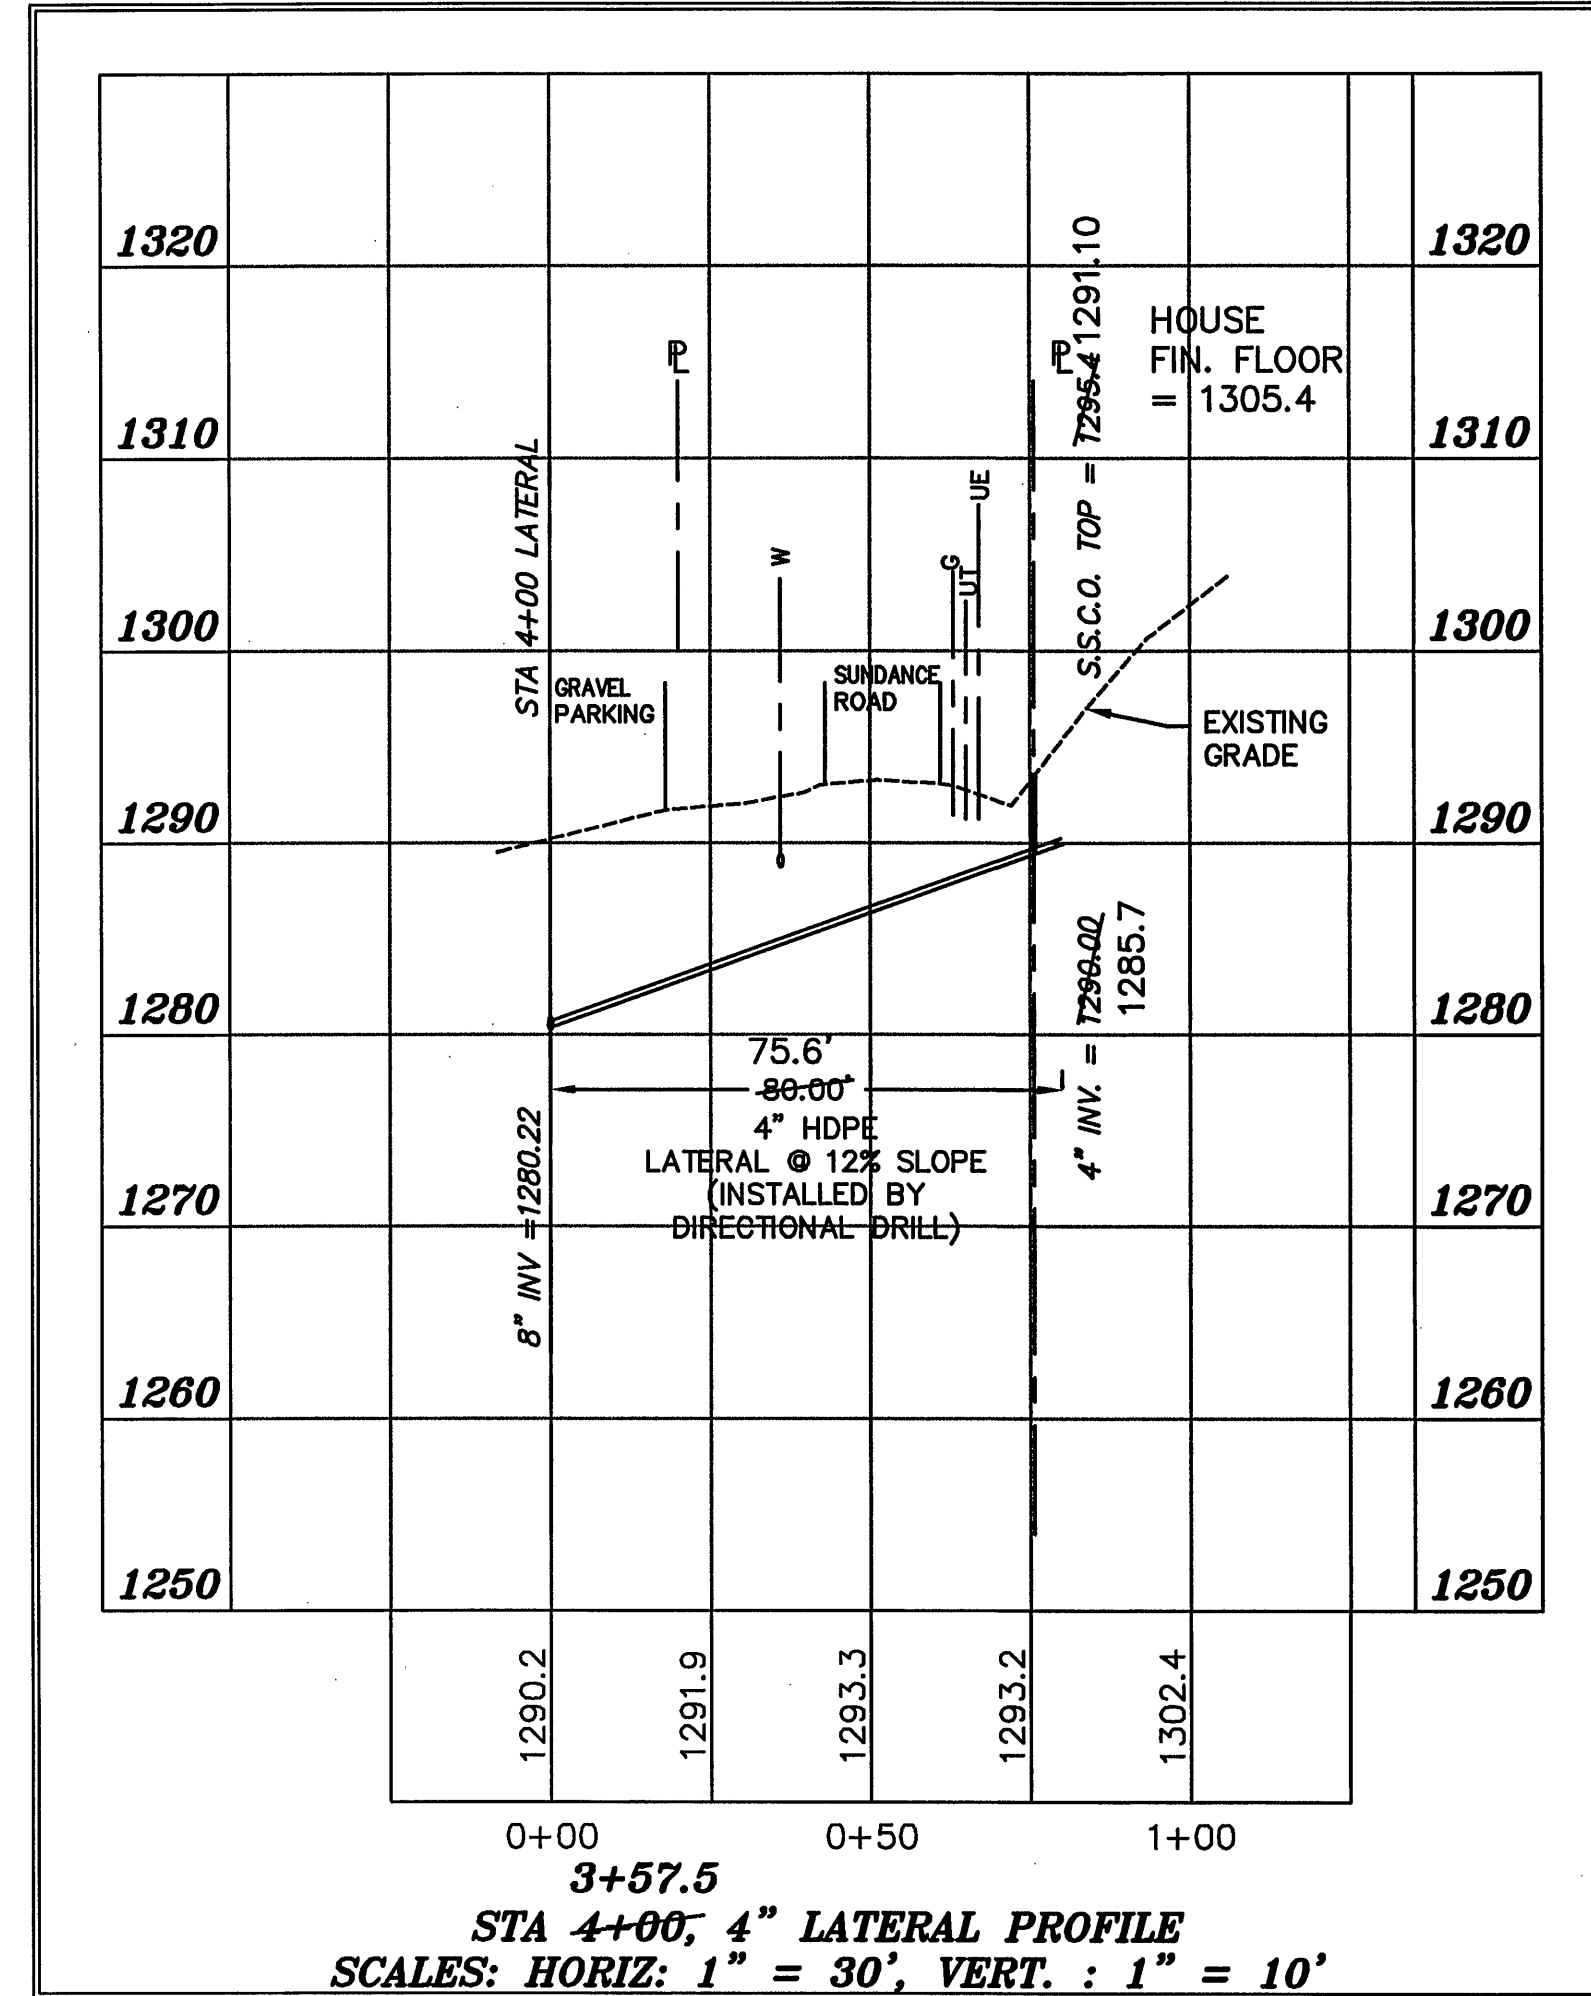
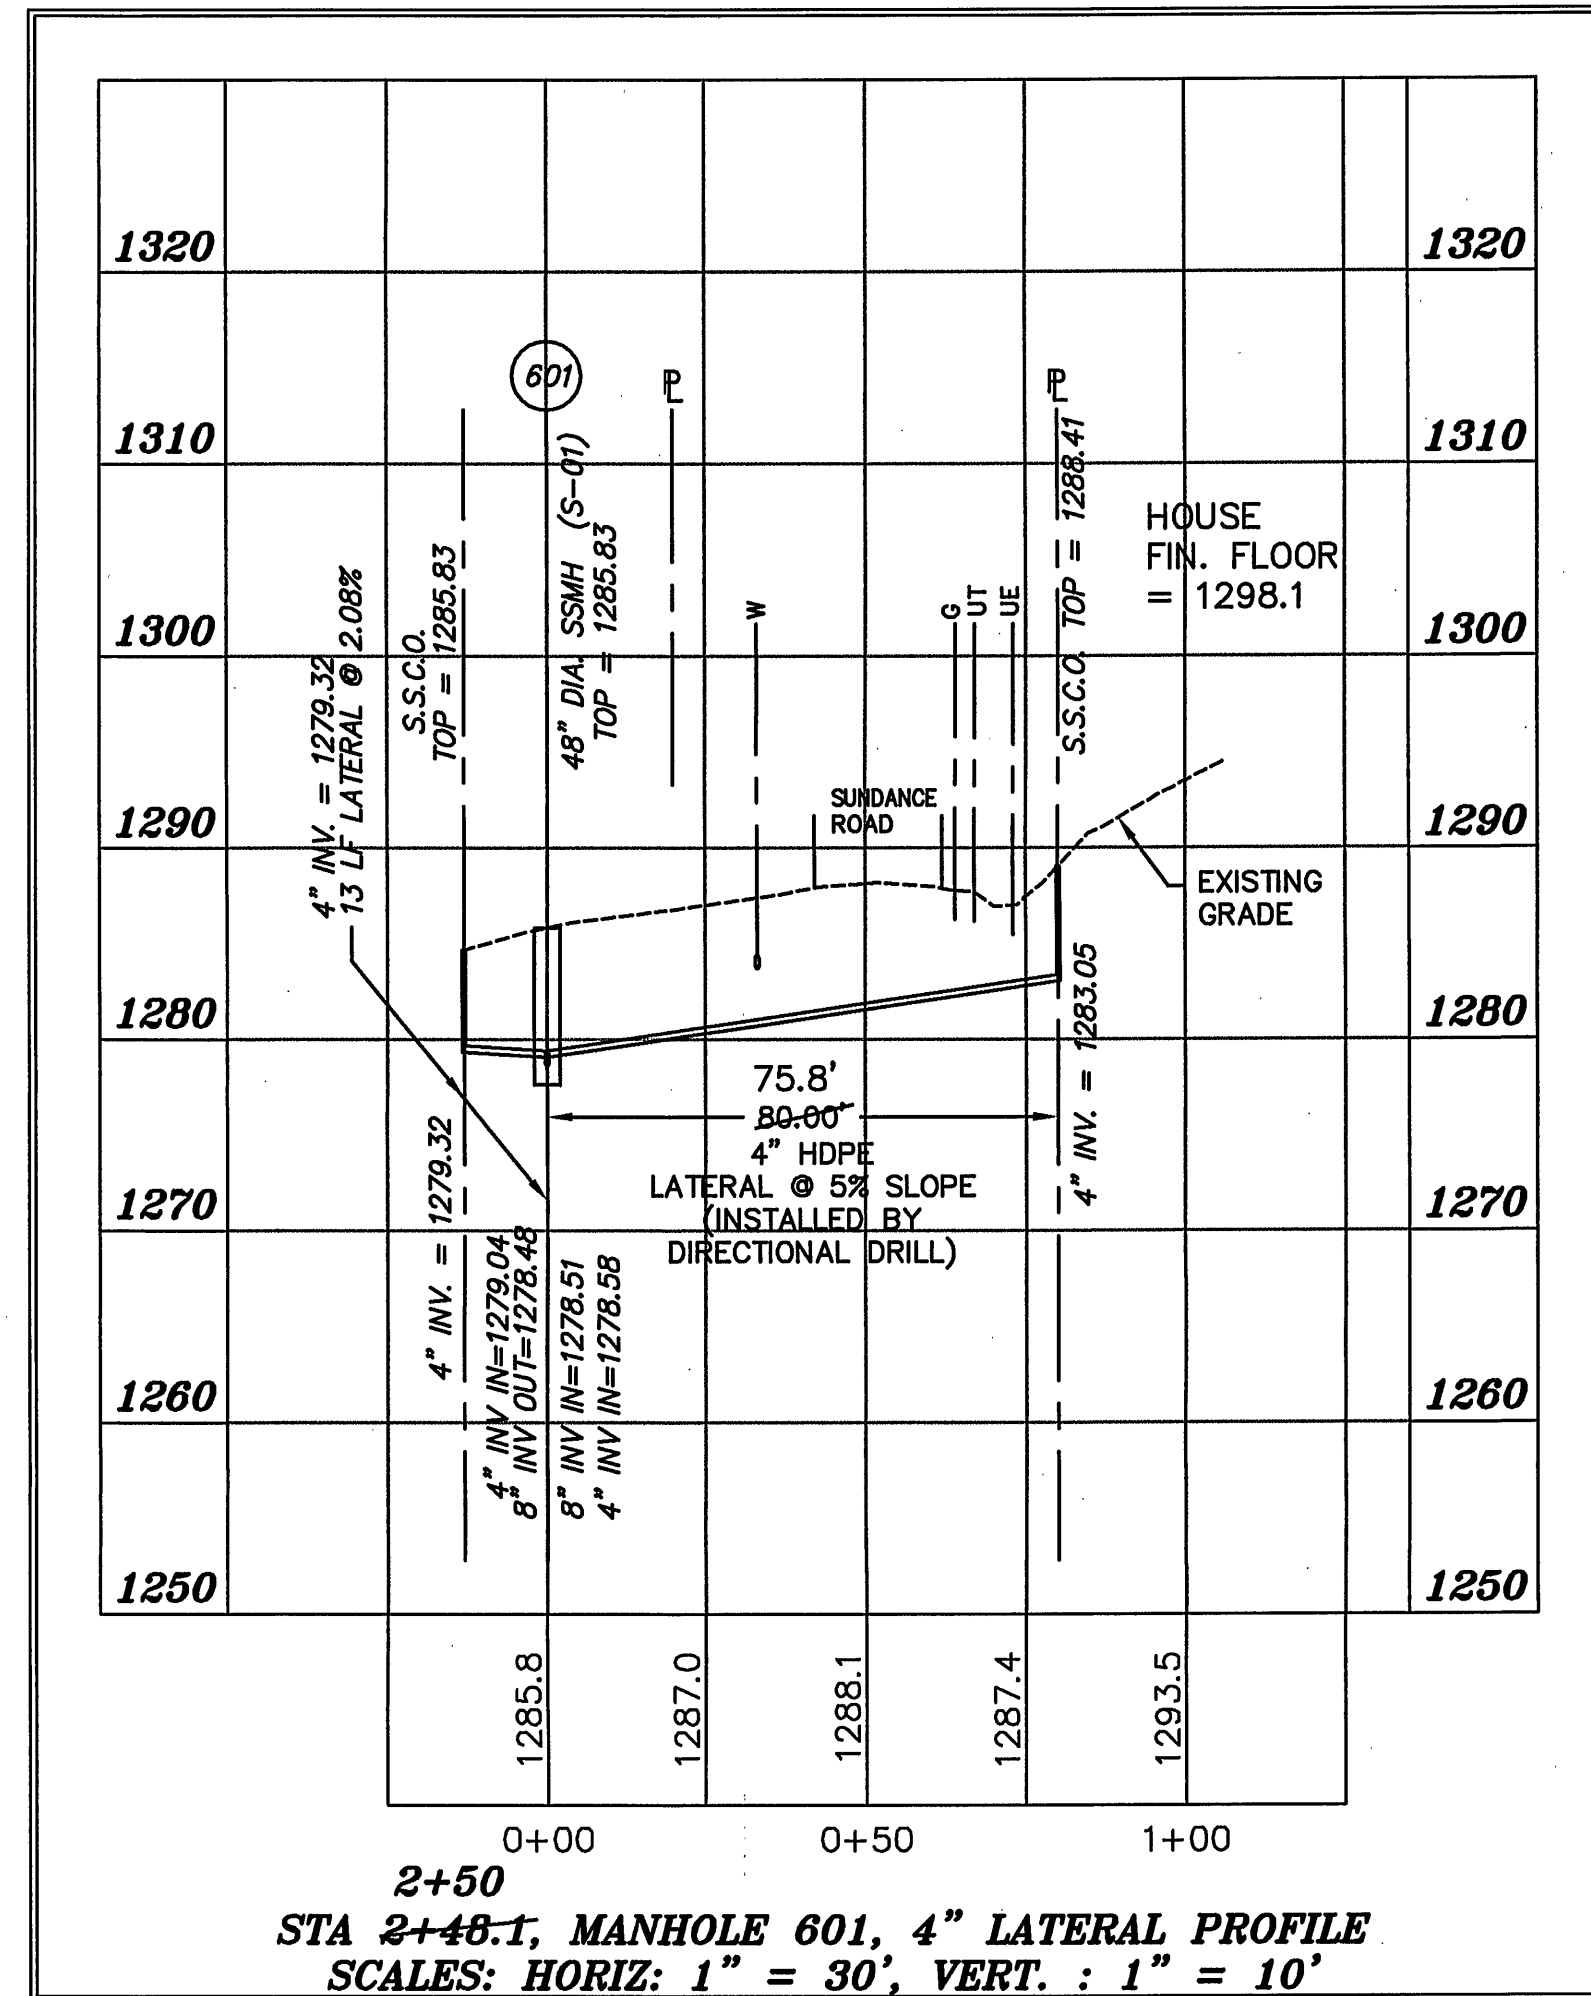


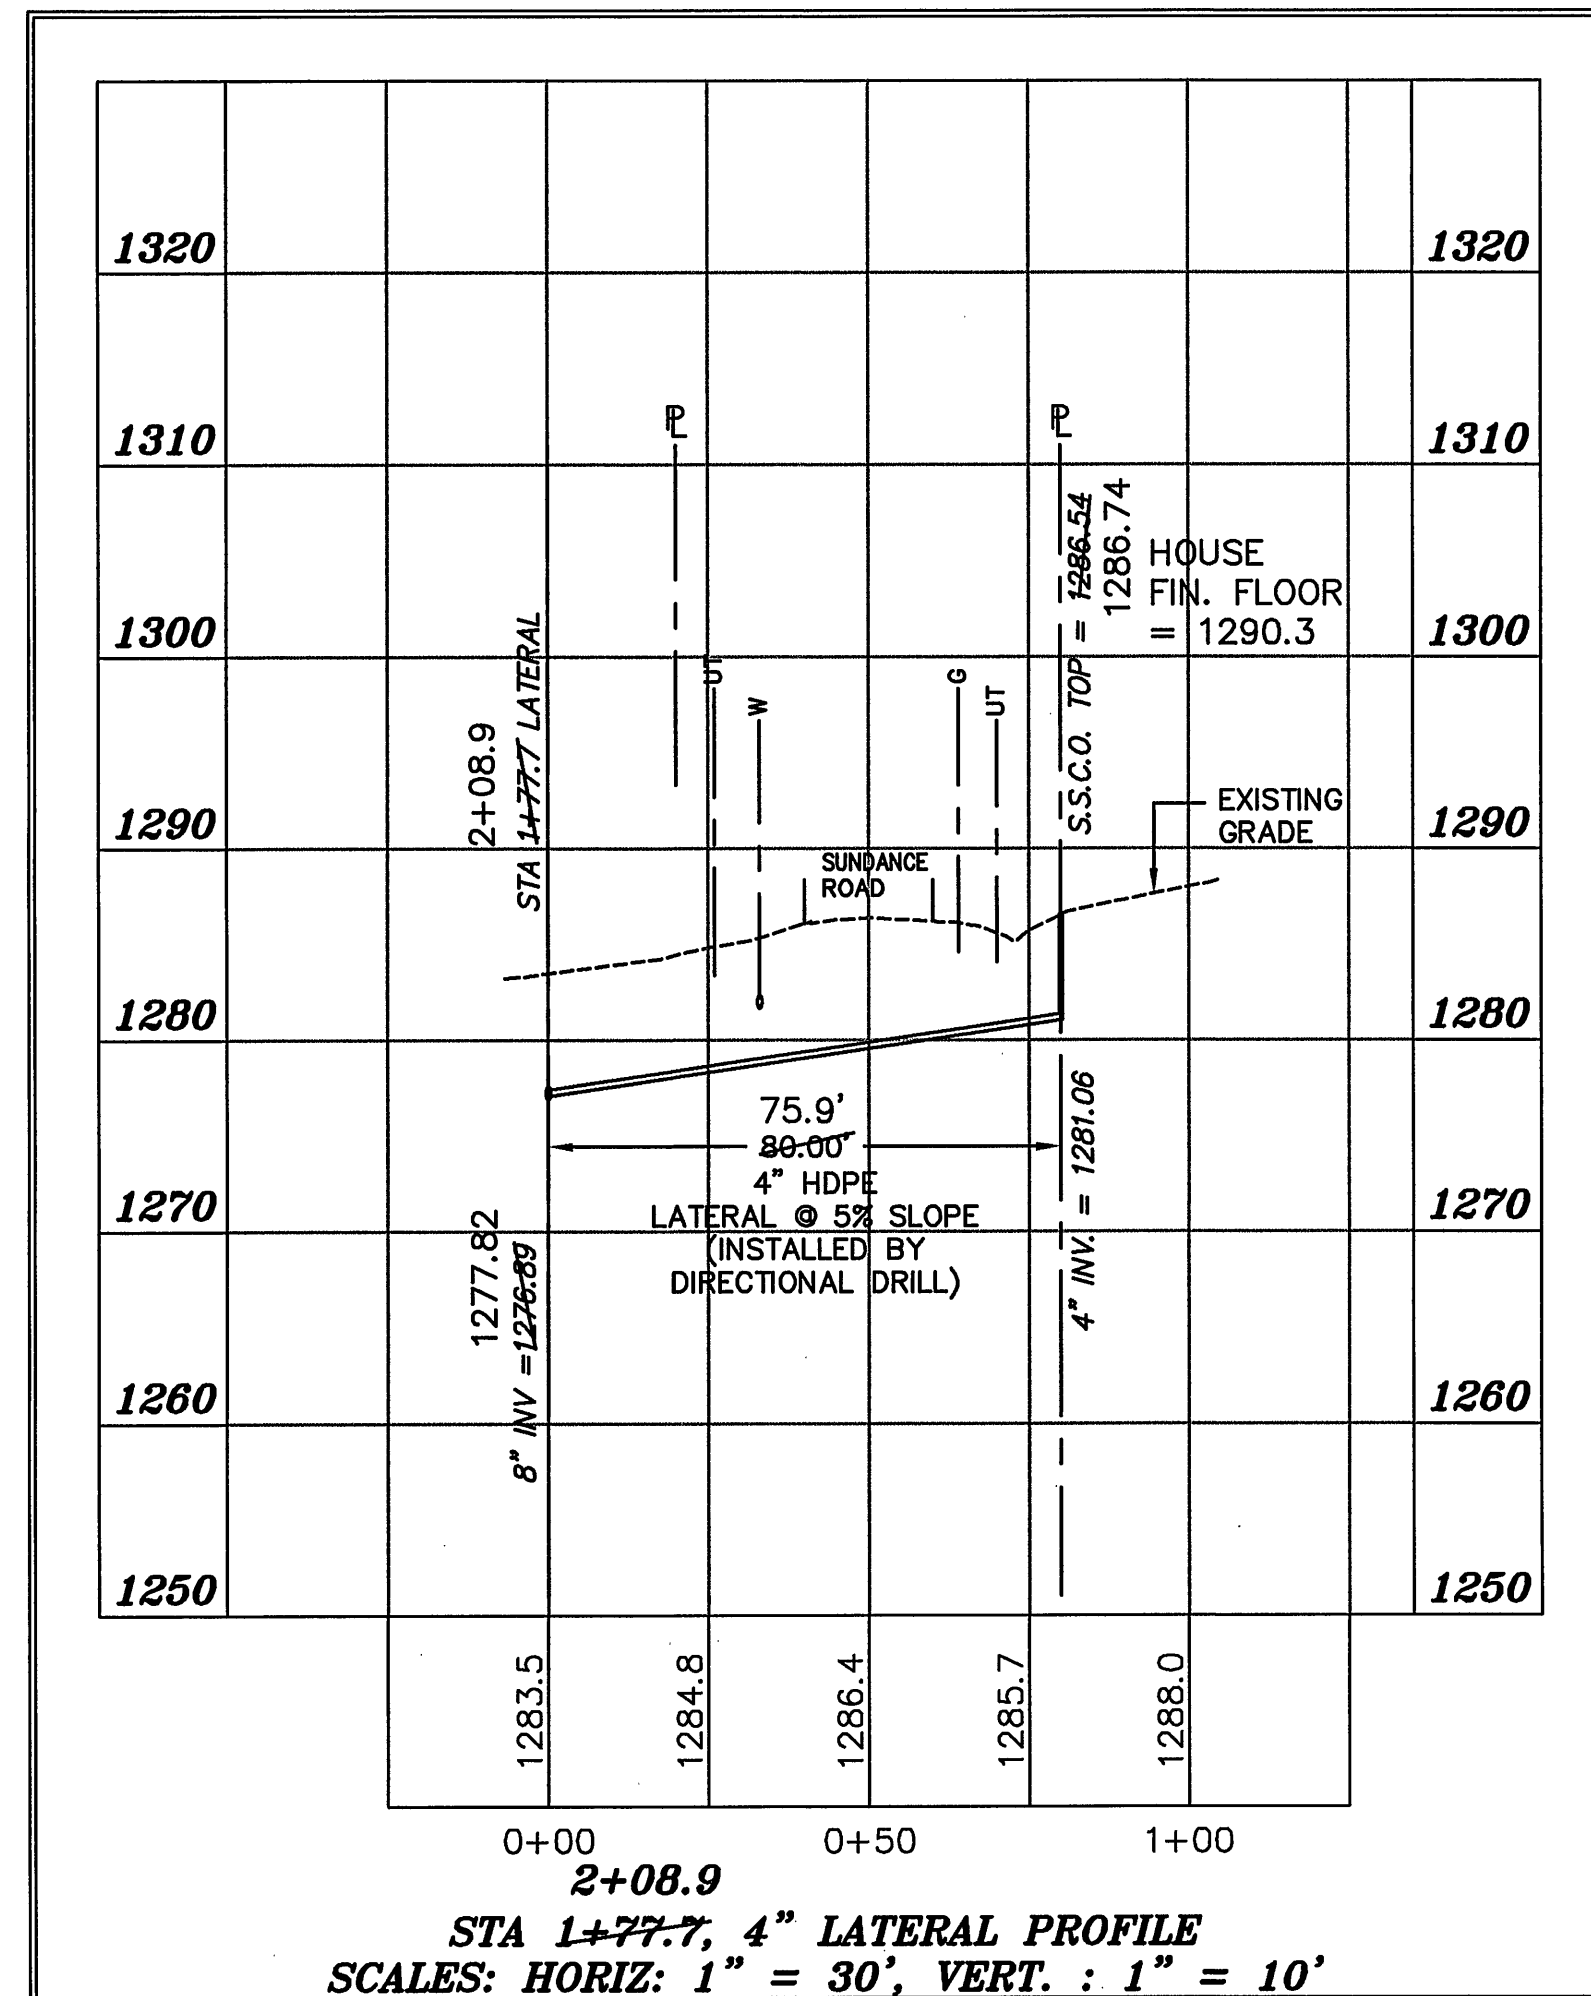

SURVEY CONTROL POINTS (PROJECT DATUM)

POINT NUMBER	NORTHING	EASTING	DESCRIPTION
#442	14559.137	16781.754	MAG NAIL, SOUTHWEST CORNER OF CHEROKEE HILLS DRIVE & SUNDANCE ROAD
#443	13891.807	16680.095	MAG NAIL, WEST EDGE OF SUNDANCE ROAD NEAR ARROWHEAD TRAIL INTERSECTION

PROP. MANHOLE	NORTHING	EASTING	DIRECTION TO UPSTREAM STRUCTURE
130	13882.424	16642.057	N 07°27'04" E, 248.1'
601	14128.410	16674.349	N 08°31'31" E, 285.5'
602	14410.699	16716.664	N 81°28'29" W, 72.5'
603	14421.449	16644.954	

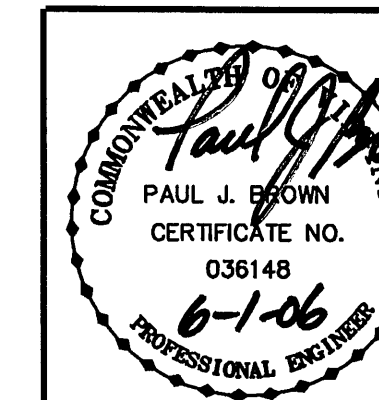

DESIGNED BY: PJB
 DRAWN BY: PJB
 CHECKED BY: PJB
 W.O. #: 05-0519
 N.B.: CH-1
 TAX NO.: VARIOUS

AS-BUILT SURVEY FOR
LATERAL PROFILES - UTILITY CONFLICTS
SANITARY SEWER MAIN EXTENSION
 FOR
WESTERN VIRGINIA WATER AUTHORITY
 SITUATE: SUNDANCE ROAD (VA. SEC. RTE. 1160)
 CATAWBA MAGISTERIAL DISTRICT
 ROANOKE COUNTY, VIRGINIA
 REV: 01 JUNE 2006 SCALE: AS SHOWN

TPP&S
 ENGINEERS
 SURVEYORS
 PLANNERS

T. P. PARKER & SON
 816 Boulevard
 Post Office Box 39
 Salem, Virginia 24153
 Telephone: 540-387-1153
 FAX: 540-388-5767