




BALZER & ASSOCIATES
 PLANNERS ARCHITECTS
 ENGINEERS
 PROVIDENCE, RHODE ISLAND
 1555 CORPORATE CIRCLE
 PROVIDENCE, RI 02918
 (401) 451-1000

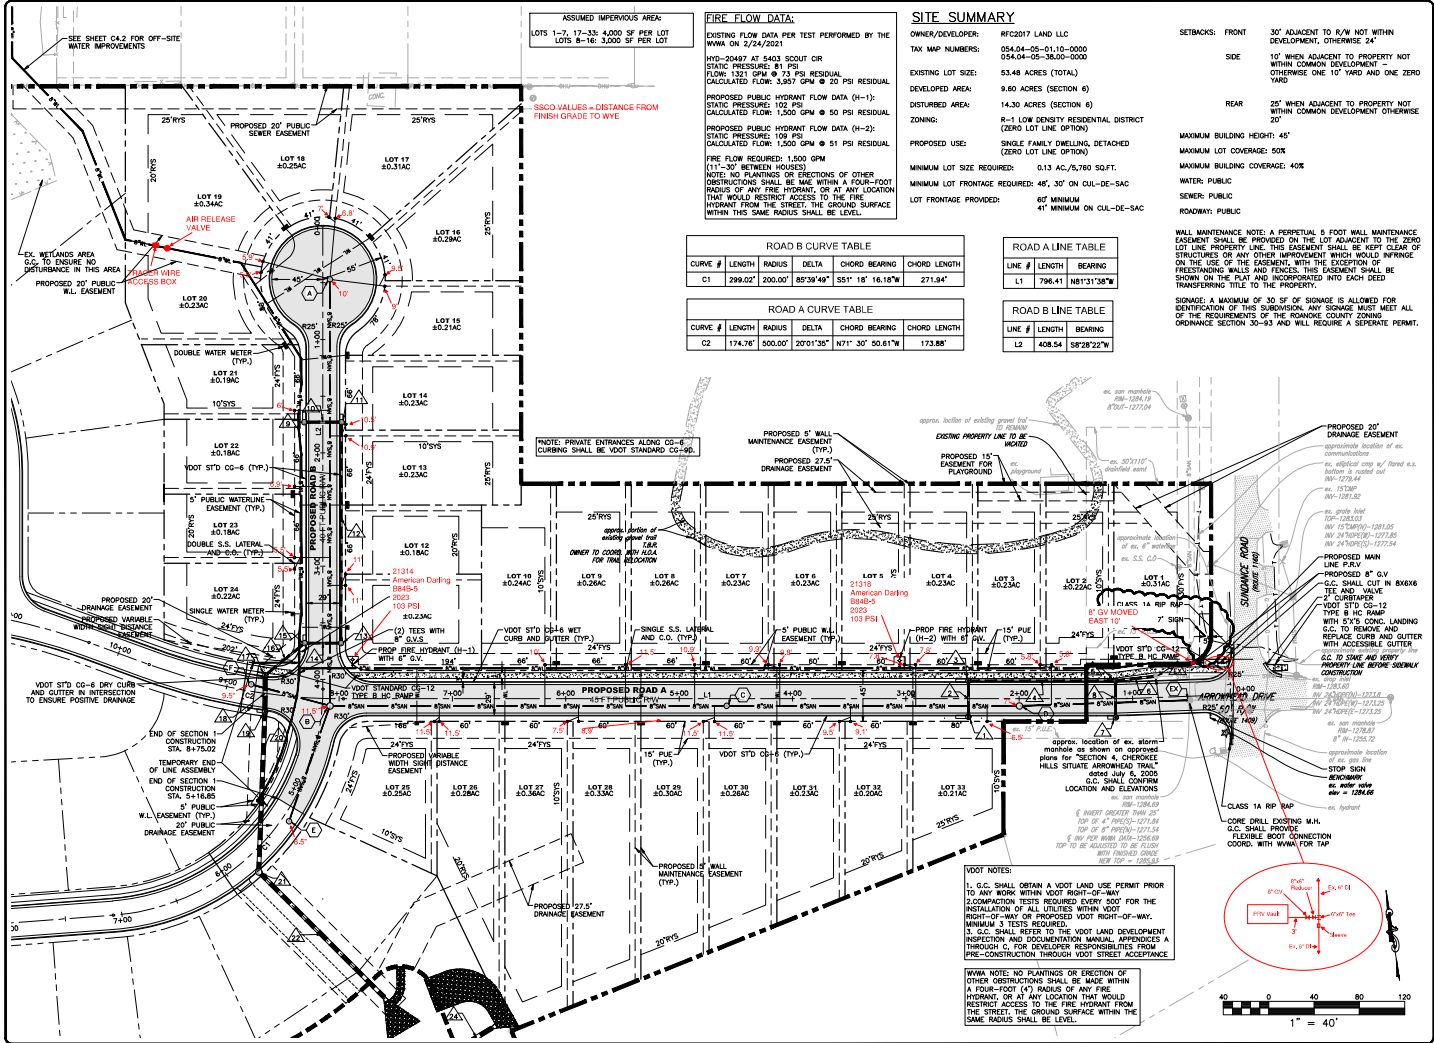

CHEROKEE HILLS SECTION 6 LAYOUT & UTILITY PLAN

DESIGNED BY: KAM
 CHECKED BY: KAM
 DATE: 12/09/2022
 SCALE: 1" = 40'
 PROJECT NO.: 2401180003
 SHEET NO.: 01/02

C4.1
 PROJECT NO.: 2401180003

APPROVED, 9/12/2023