
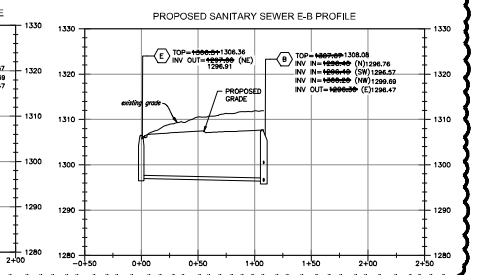
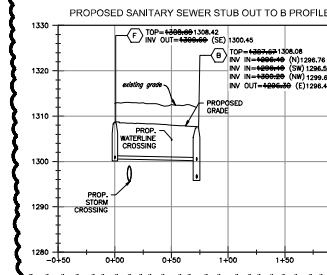
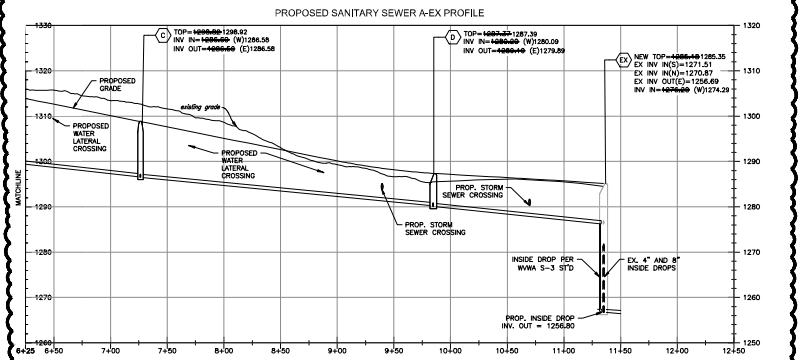
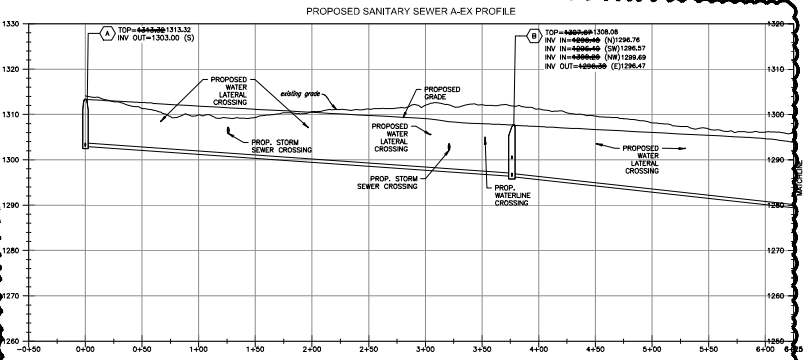


SANITARY SEWER SCHEDULE:

- A PUBLIC S.S. MANHOLE
TOP = 4200.00 (1)133.32
INV IN = 4200.00 (LATERAL)1303.18
INV IN = 4200.00 (LATERAL)1303.20
INV IN = 4200.00 (LATERAL)1303.01
INV OUT = 1303.00
- B 6" LF OF 8" SDR-35 PVC AT 1.00%
TOP = 4200.00 (1)130.08
INV IN = 4200.00 (W)1296.76
INV IN = 4200.00 (SW)1296.55
INV IN = 4200.00 (W)1296.49
INV OUT = 4200.00 (E)1296.47
- C PUBLIC S.S. MANHOLE
TOP = 4200.00 (1)128.52
INV IN = 4200.00 (W)1286.58
INV OUT = 4200.00 (E)1286.58
- D 6" LF OF 8" SDR-35 PVC AT 2.00%
TOP = 4200.00 (1)127.09
INV IN = 4200.00 (W)1280.59
INV OUT = 4200.00 (E)1279.89
- E 6" LF OF 8" SDR-35 PVC AT 2.00%
TOP = 4200.00 (1)125.36
INV IN = 4200.00 (W)1274.29
INV OUT = 4200.00 (E)1254.69
- F EXISTING PUBLIC S.S. MANHOLE
NEW TOP = 4200.00 (1)128.35
EX INV IN = 1271.51 (S)
EX INV IN = 1271.51 (S)
INV IN = 4200.00 (W)1254.69
EX INV OUT = 1254.69 (S)
- G PUBLIC S.S. MANHOLE
TOP = 4200.00 (1)129.91
INV IN = 4200.00 (W)1296.91
INV OUT = 4200.00 (E)1296.91
- H 6" LF OF 8" SDR-35 PVC AT 2.00%
TOP = 4200.00 (1)130.45
INV IN = 4200.00 (W)1296.91
INV OUT = 4200.00 (E)1296.91
- I 6" LF OF 8" SDR-35 PVC AT 2.00%
TOP = 4200.00 (1)129.89
INV IN = 4200.00 (W)1296.91
INV OUT = 4200.00 (E)1296.91

AS-BUILT DRAWING NOTE:
AS-BUILT DRAWING FOR SANITARY SEWER AND WATERLINE IMPROVEMENTS ARE FOR AS-BUILT PURPOSES ONLY. NO IMPROVEMENTS OTHER THAN WATER AND SANITARY SEWER STRUCTURES WERE AS-BUILT OR INDICATED AS SUCH ON THE SUBJECT PLAN SET. UNDERGROUND PIPING WAS NOT LOCATED. LOCATION SHOWN IS APPROXIMATE BASED ON SURFACE FEATURES AND INFORMATION PROVIDED BY CONTRACTOR.

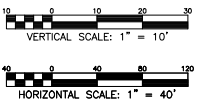

CHEROKEE HILLS
SECTION 6
WWW.AS-BUILT SANITARY SEWER PROFILES
COUNTY, VA

DESIGNED BY
CHECKED BY
DATE
SCALE
REVISIONS

AB3
PROJECT NO. 140100000