
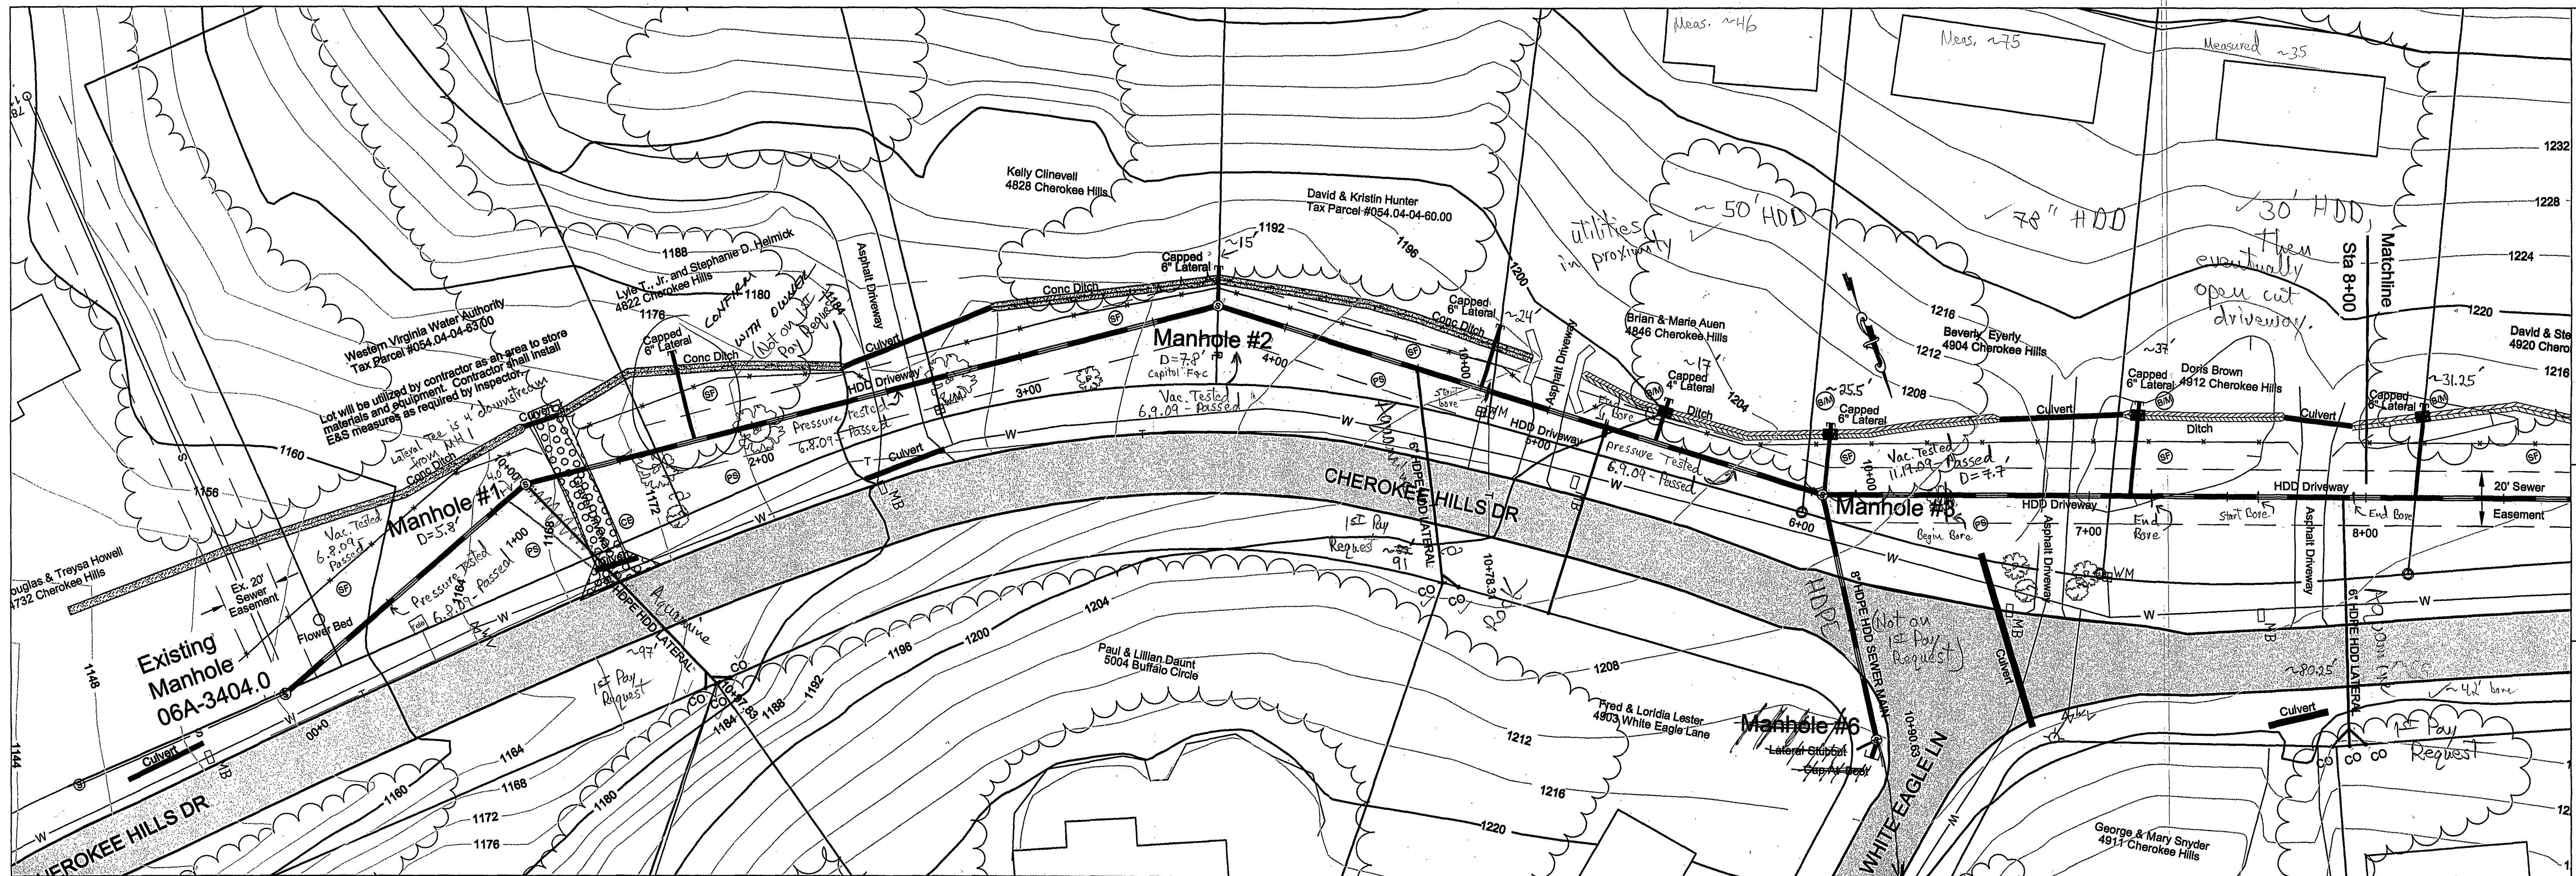


VERT 1" = 10'
HOR 1" = 30'


GENERAL NOTES:

- SEWER MAIN CAN BE HDPE DR17, CERTA-LOC SDR-21, OR EQUIVALENT.
- WATER LINE IS SHOWN SCHEMATICALLY. CONTRACTOR SHALL LOCATE WATER LINE PRIOR TO BEGINNING CONSTRUCTION.
- ALL MAINS AND LATERALS CROSSING STREETS SHALL BE INSTALLED BY HORIZONTAL DIRECTIONAL DRILLING.
- CUTS IN SOIL DITCH SHALL BE STABILIZED WITH NAGS75BN, STRAW BIONET OR EQUIVALENT. EC2-TREATMENT 1 SHALL NOT USE PLASTIC NETTING.

6" Lateral
Sta 1+15.21

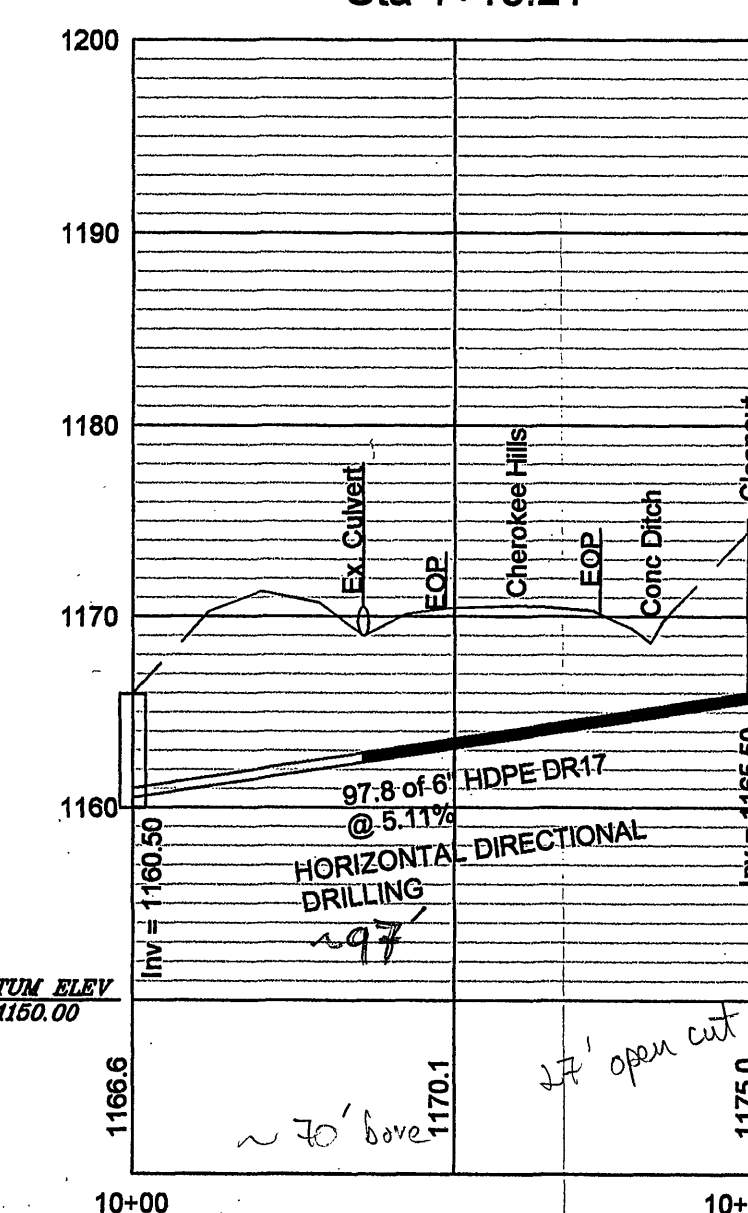

6" Lateral
Sta 4+50.00

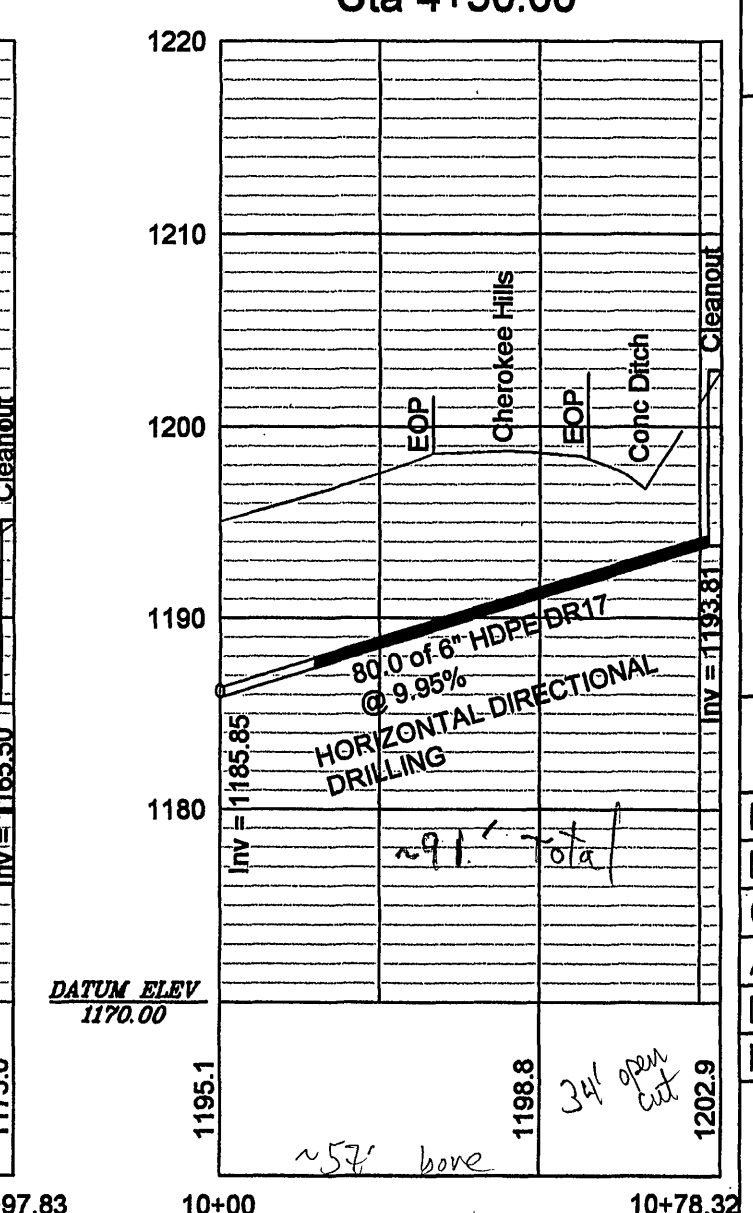

Cherokee Hills (4900 Bk) Sewer Extension

CIVIL/SITEWORK
PLAN

Rev	Description	Date	By
1	Added Lat Sta 4+50 and Revised Profile	3 APR 09	CDA
Designed: CDA			
Drawn: CDA			
Checked: CDA			
Approved: JGR			
Date: 19 MAR 2009			
Project:			

C2
Sheet 2 of 5

Core above the bunch
(to miss a joint in the
ex. MH) - will put inlet pipe
about 1' above bunch - do not
need a drop inlet. G. Reed approved 4.24.09

116.02
116.10
5.92

As-Built 12.4.09 K. Winslow