

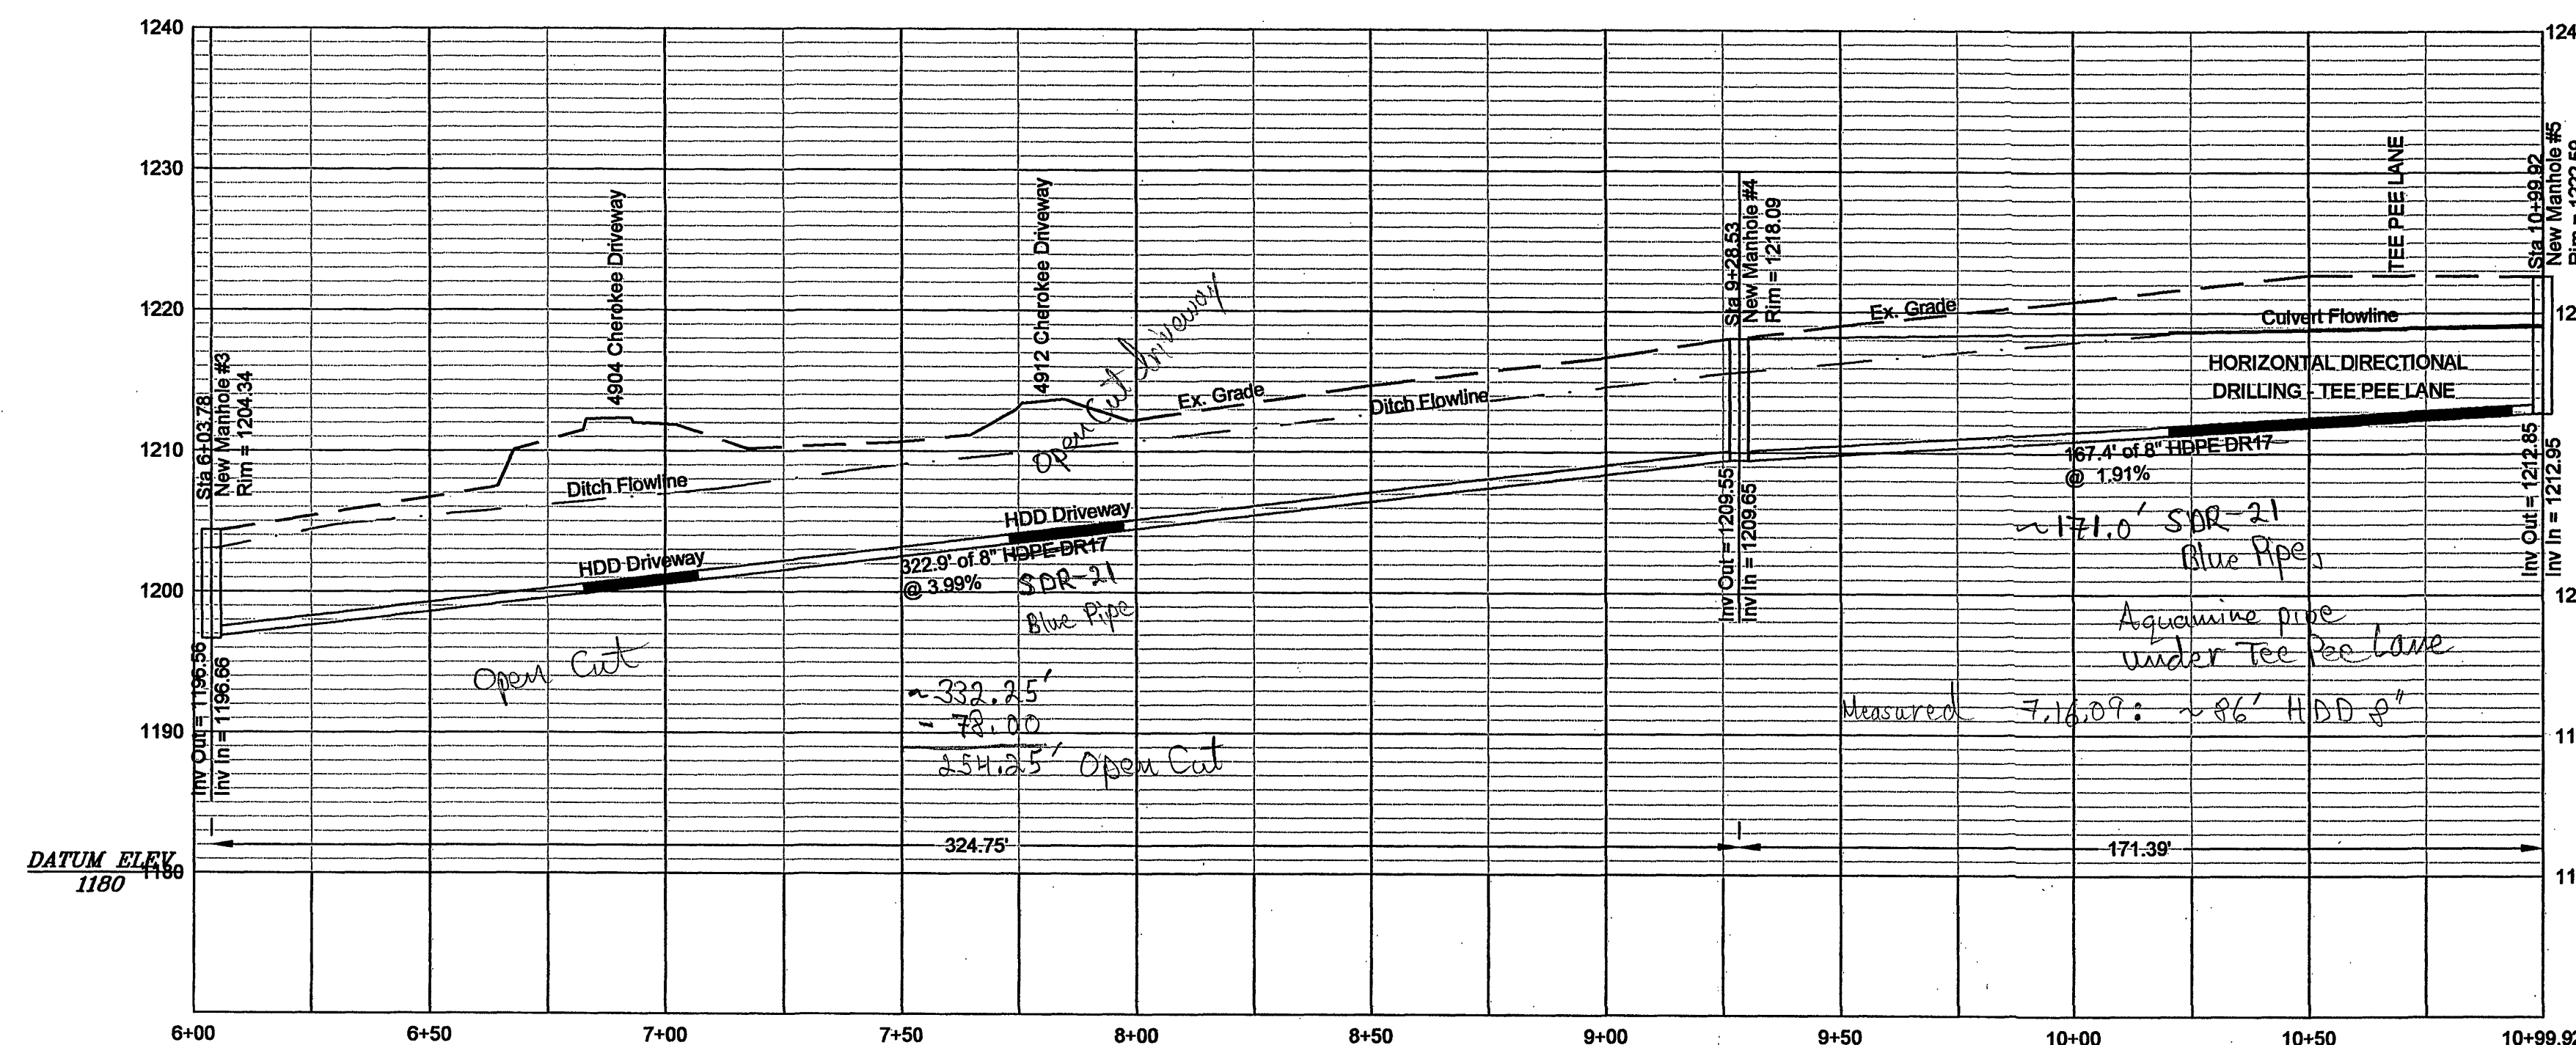
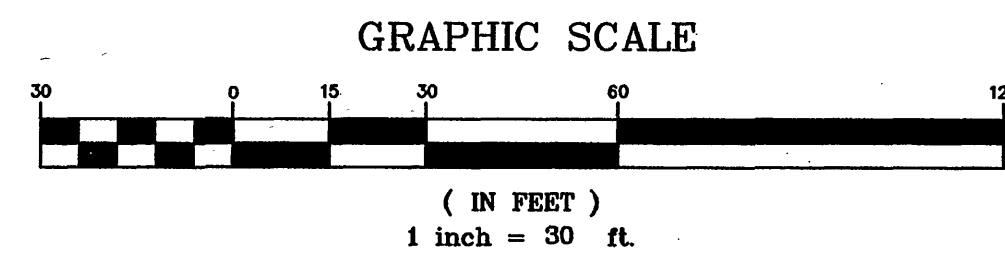


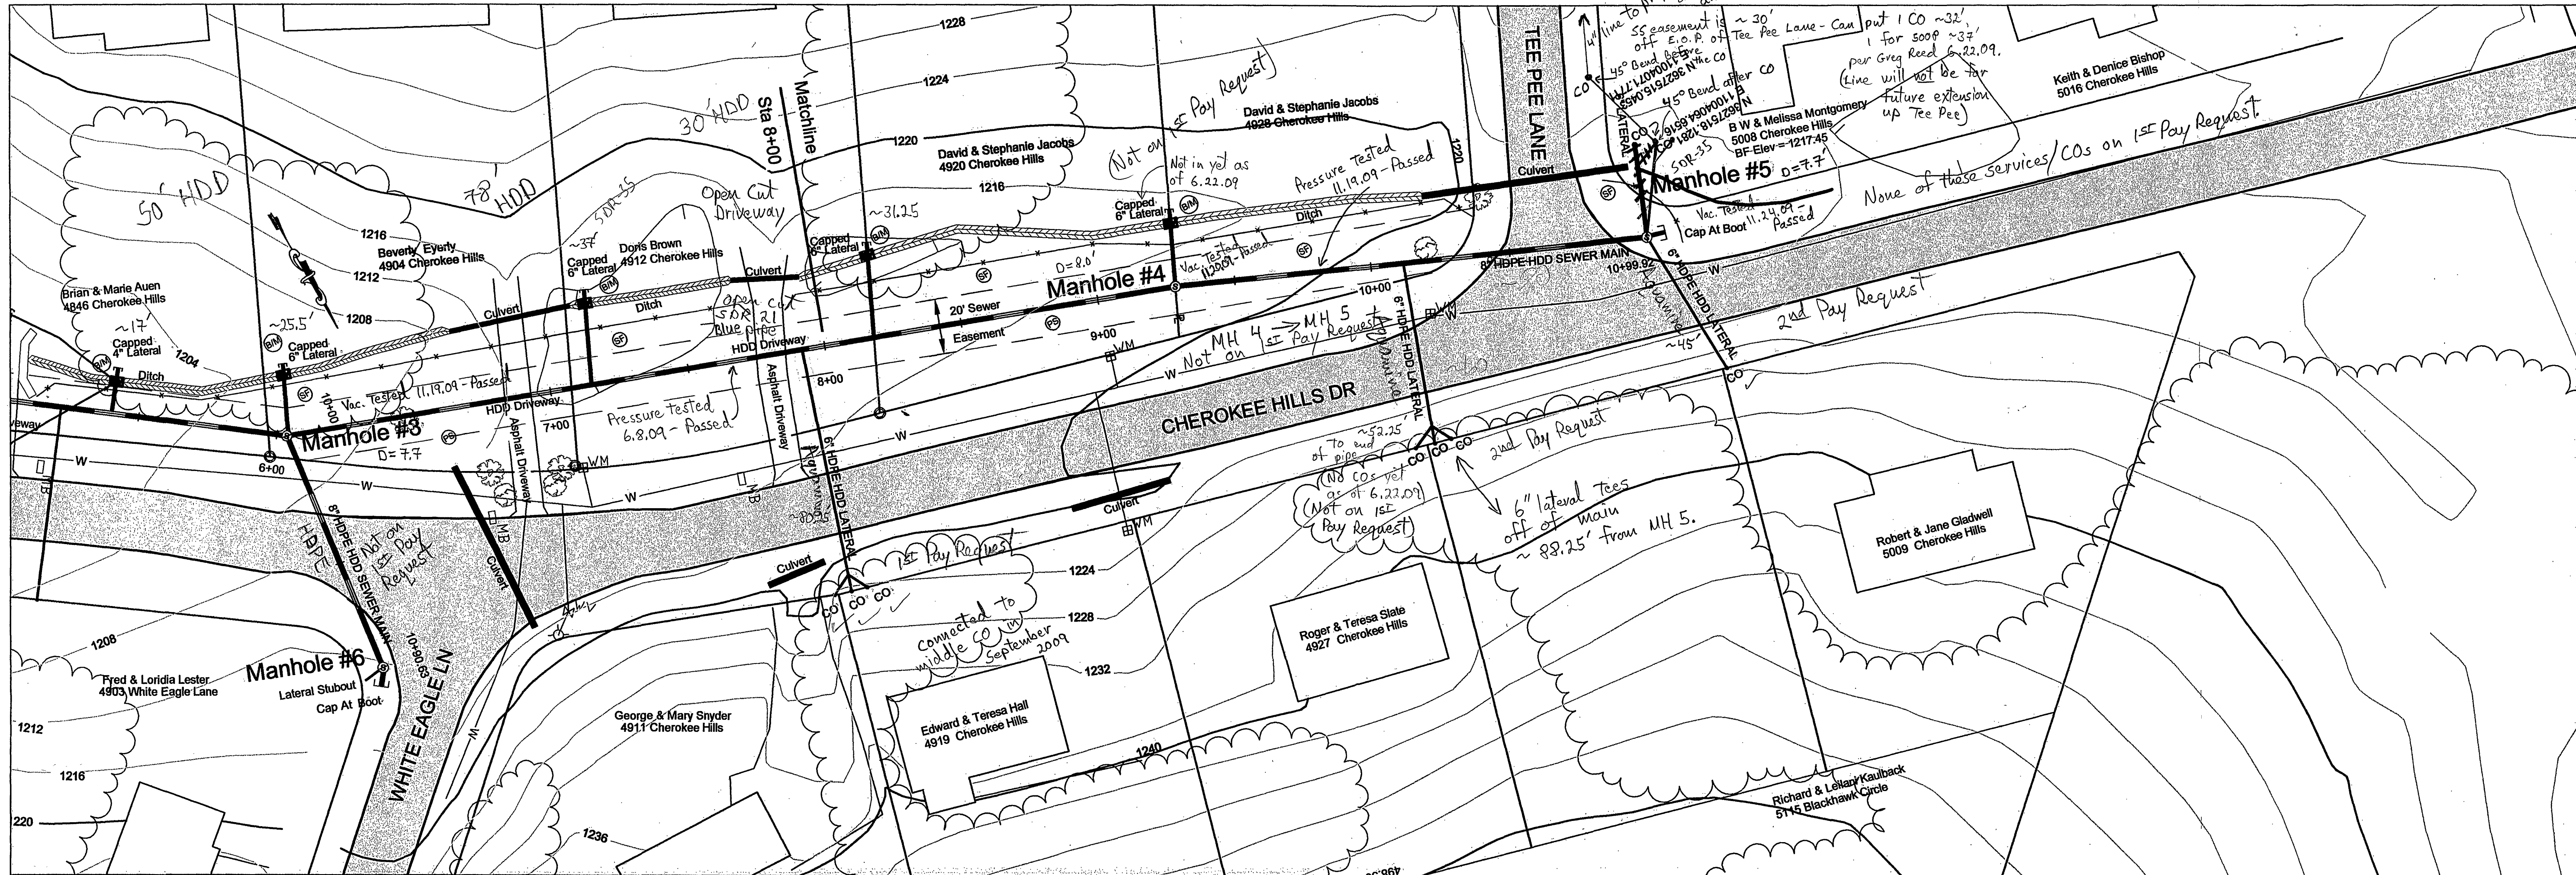


VERT 1" = 10'
HOR 1" = 30'

8" Sewer Main
Intersection of Cherokee/White Eagle
Sta 6+03.78

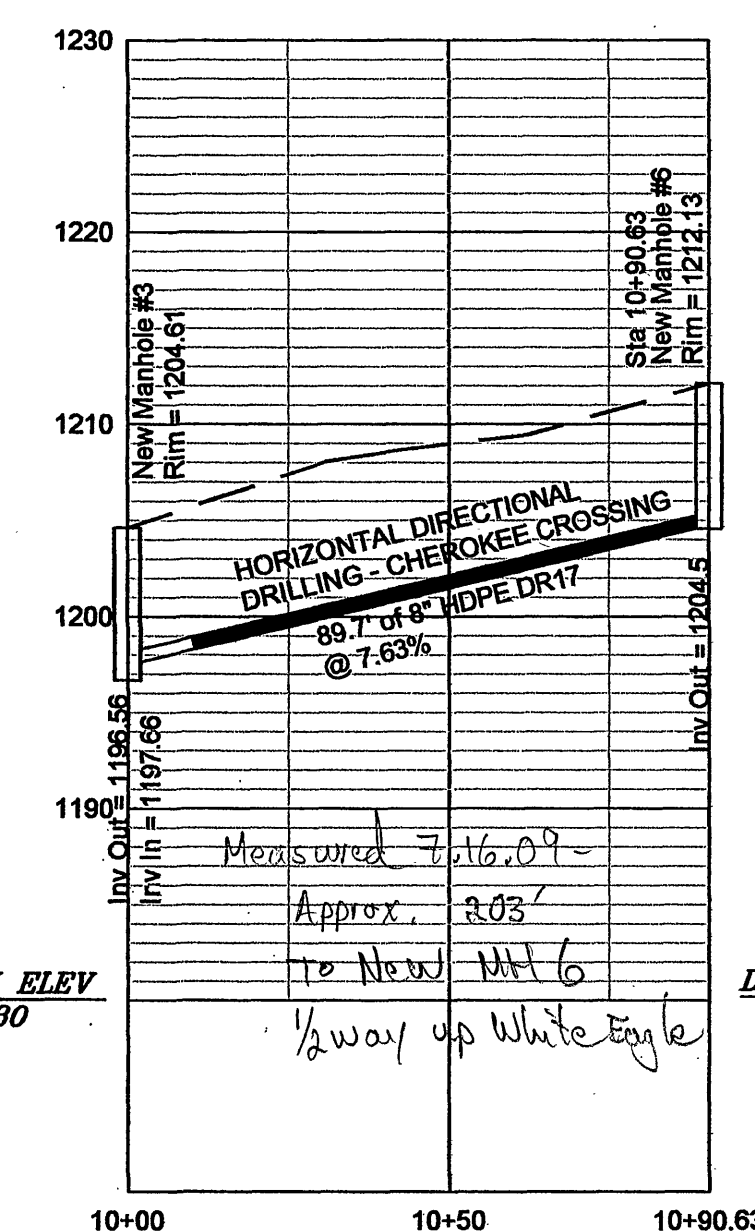

6" Lateral
Sta 7+91.80

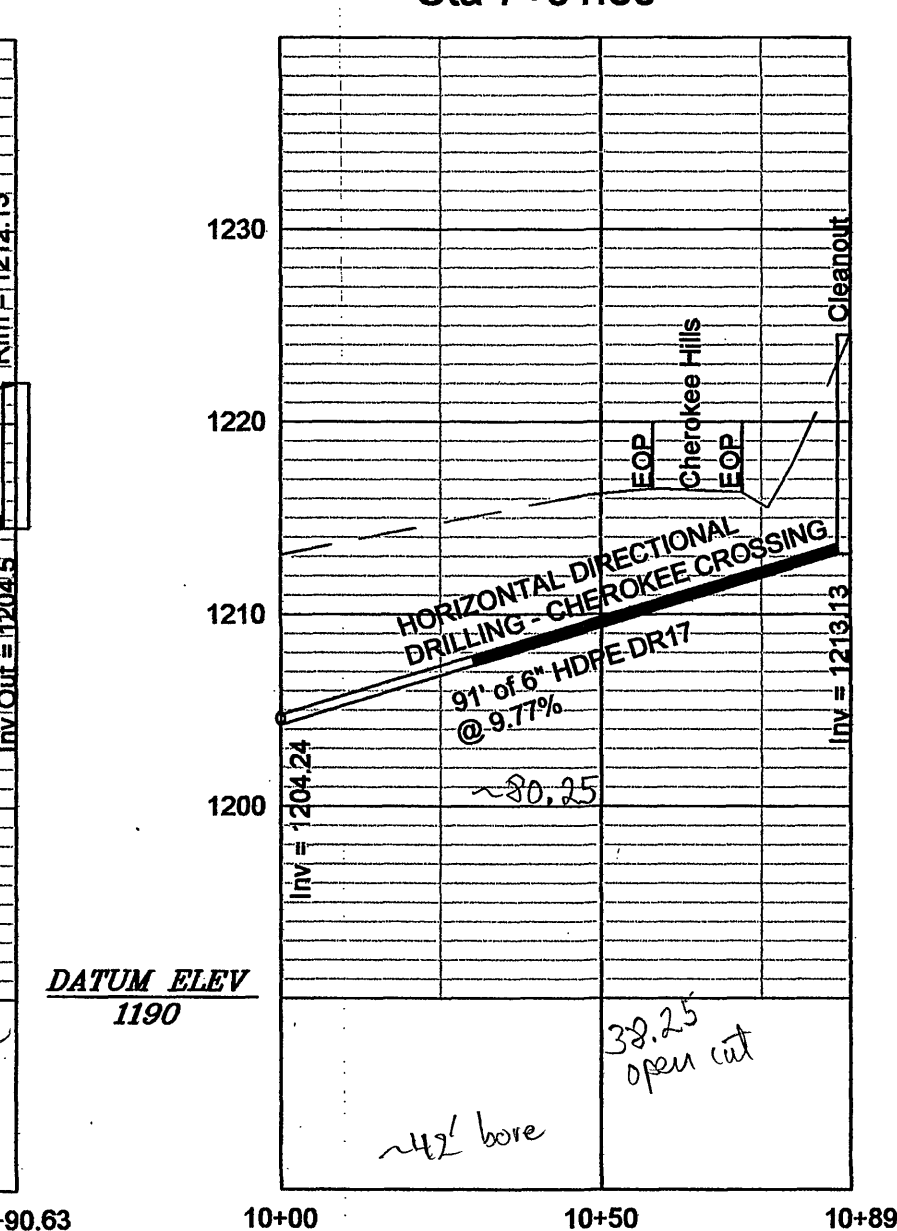

Cherokee Hills (4900 Bik) Sewer Extension CIVIL/SITEWORK PLAN

Rev	Description	Date	By
1	Added Lat Sta 4+50 and Revised Profile	3 APR 09	CDA

Designed: CDA
Drawn: CDA
Checked: CDA
Approved: JGR
Date: 19 MAR 2009
Project:

C3
Sheet 3 of 5



WESTERN VIRGINIA
WATER AUTHORITY
ENGINEERING SERVICES
601 S JEFFERSON ST, SUITE 300
ROANOKE, VA 24011
540-853-5700

As-Built 12.4.09 K. Winslow