



# CHEROKEE HILLS SEWER

## SITE MAP

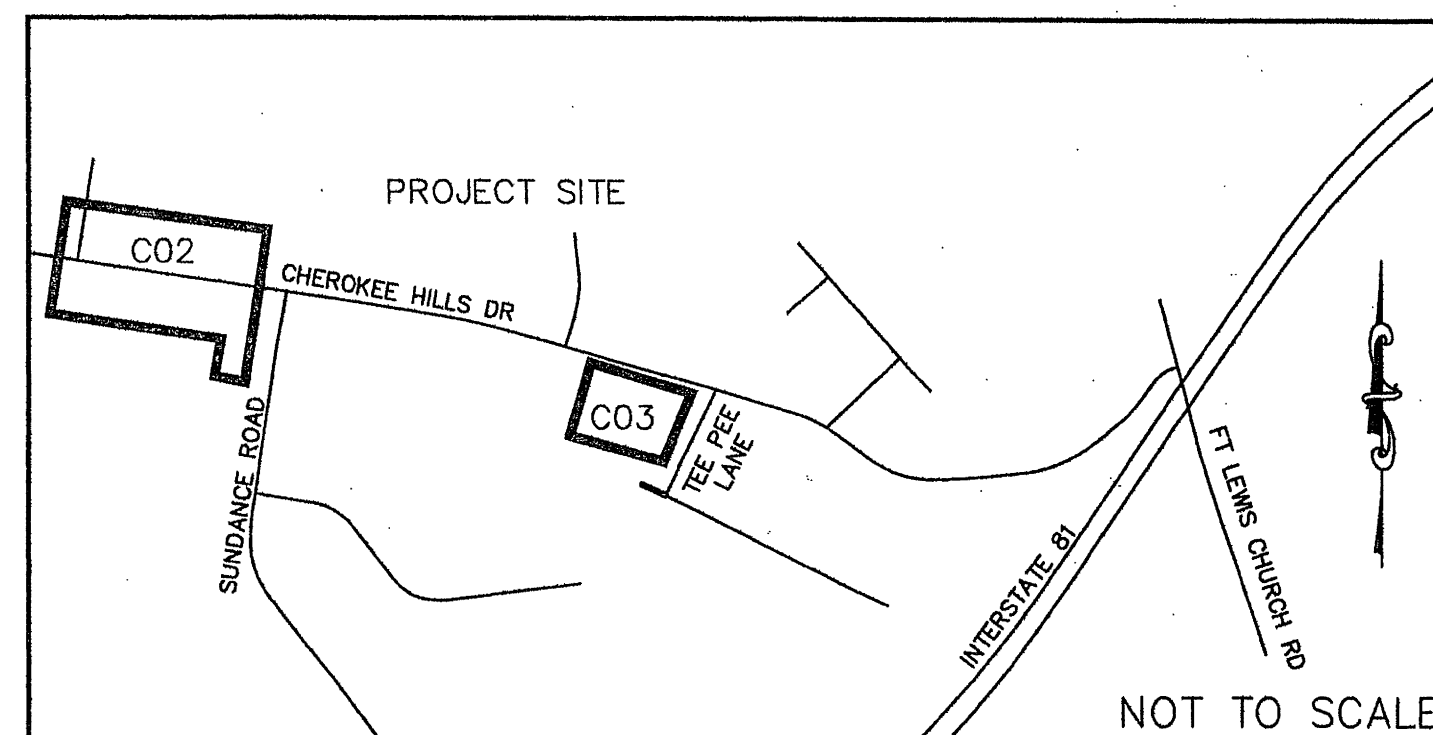

## DESIGN ENGINEER

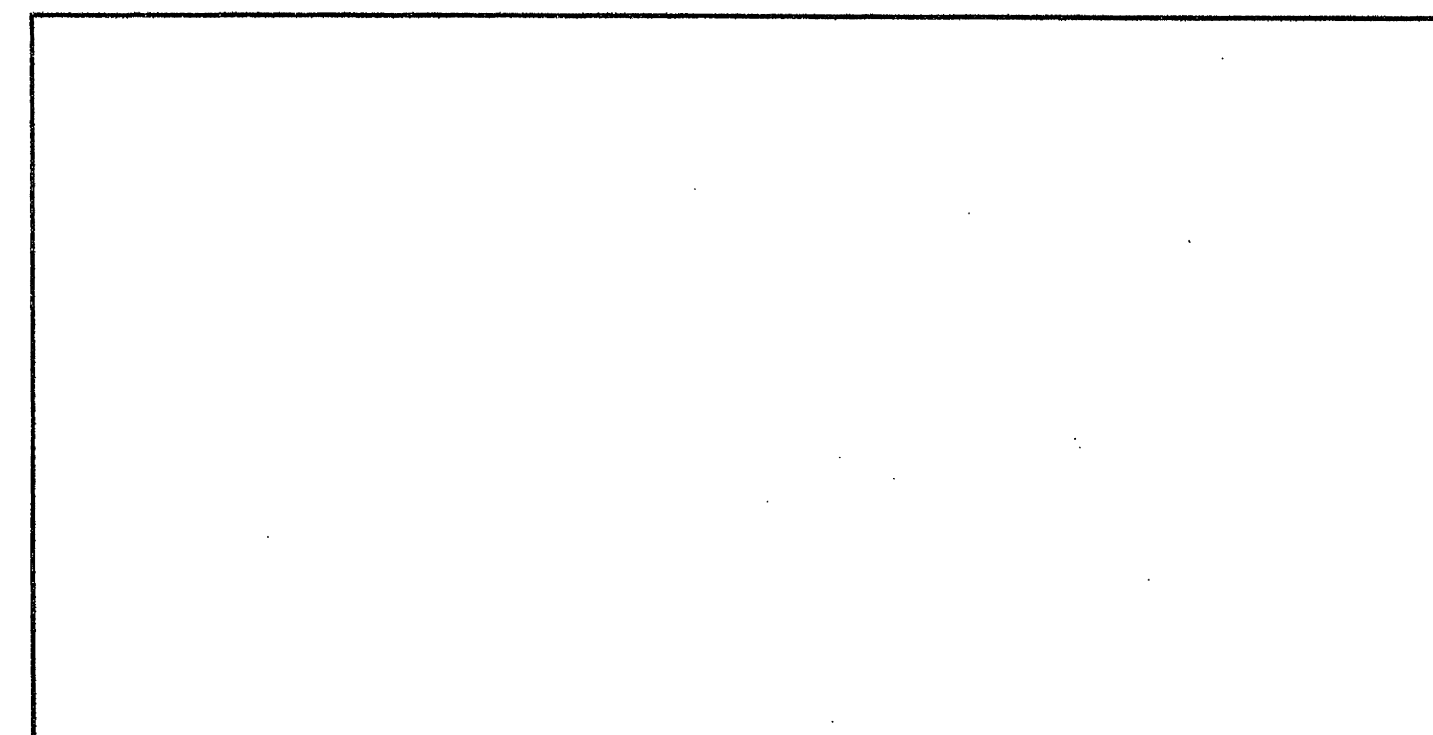

## SHEET INDEX

- 1 COVER SHEET  
2 PLAN & PROFILES 5200 BLOCK  
3 PLAN & PROFILES 5000 BLOCK  
4 DETAILS

DESIGN ENGINEER

APPROVED FOR CONSTRUCTION:


DATE      DIRECTOR OF ENGINEERING SERVICES

As-Built 07/01/2014

1  
Sheet 1 of 4

**WESTERN VIRGINIA  
WATER AUTHORITY**

**ENGINEERING SERVICES**  
601 S JEFFERSON ST, SUITE 300  
ROANOKE, VA 24011  
540-853-5641 or 540-853-5770

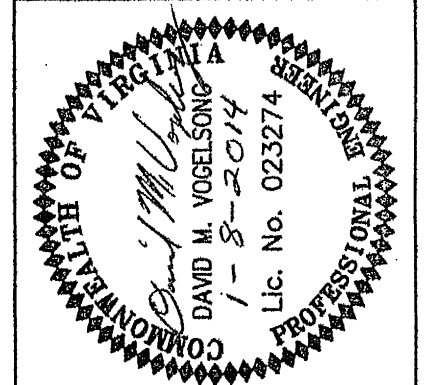

CHEROKEE HILLS SEWER

COVER SHEET

[illegible]