


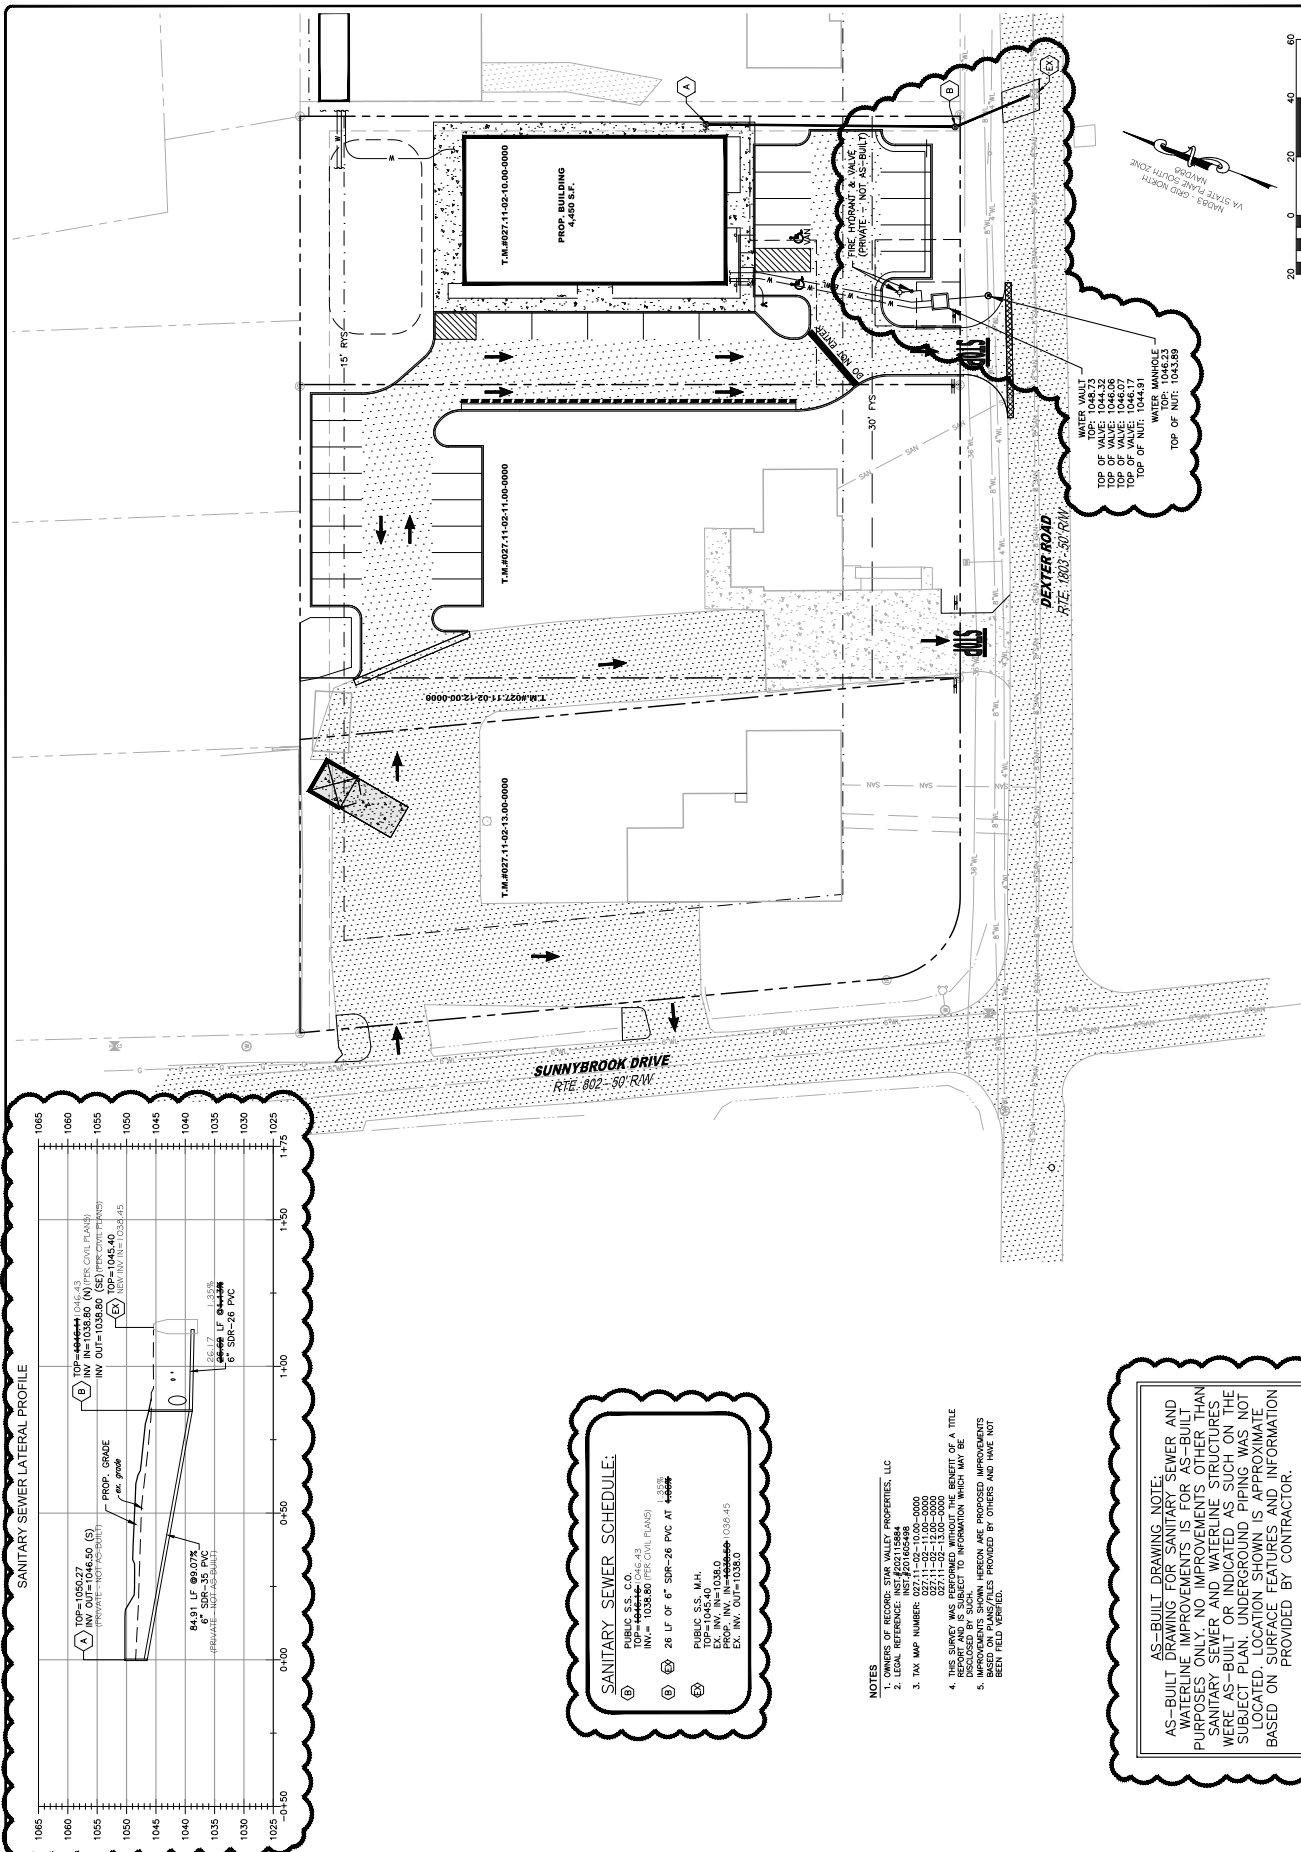

AS-BUILT DRAWING NOTE:
AS-BUILT DRAWING FOR SANITARY SEWER AND WATERLINE IMPROVEMENTS IS FOR AS-BUILT PURPOSES ONLY. NO IMPROVEMENTS OTHER THAN SANITARY SEWER AND WATERLINE STRUCTURES WERE AS-BUILT OR INDICATED AS SUCH ON THE SUBJECT PLAN. UNDERGROUND PIPING WAS NOT LOCATED. LOCATION SHOWN IS APPROXIMATE, BASED ON SURFACE FEATURES AND INFORMATION PROVIDED BY CONTRACTOR.

NOTES

1. OWNERS OF RECORD: STAR VALLEY PROPERTIES, LLC
2. LEGAL REFERENCE: INST.#202115884
INST.#201605486
3. TAX MAP NUMBER:
02711-02-11-00-0000
02711-02-11-00-0000
02711-02-12-00-0000
02711-02-12-00-0000
02711-02-13-00-0000
4. THIS SURVEY WAS PREPARED FOR THE BENEFIT OF A TITLE REPORT AND IS SUBJECT TO INFORMATION WHICH MAY BE DISCLOSED BY SUCH
5. IMPROVEMENTS SHOWN HEREON ARE PROPOSED IMPROVEMENTS BASED ON PLANS/FILES PROVIDED BY OTHERS AND HAVE NOT