



SYMBOLS

FOR CLARITY, EASEMENTS HAVE NOT BEEN SHOWN ON THIS AS-BUILT PLAN. SEE SUBDIVISION AND EASEMENT PLATS FOR ALL PUBLIC AND PRIVATE EASEMENTS THAT ENCUMBER THIS PROPERTY.

N	NORTHING
E	EASTING
EXIST.	EXISTING
R/W	RIGHT-OF-WAY
D.B.	DEED BOOK
P.B.	PLAT BOOK
PG.	PAGE
AC.	ACRE
SSMH	SANITARY SEWER MANHOLE
SSCO	SANITARY SEWER CLEANOUT
SS	SANITARY SEWER
S.F.	SQUARE FEET

VALVES, METERS & HYDRANTS

- [1] WATER VALVE
N 4980.67089
E 5173.49499
TOP=495.07'


[2] END OF LINE BLOWOFF
N 4998.36809
E 5144.66143
TOP=494.25'

[3] WATER VALVE
N 4991.75582
E 5193.50287
TOP=494.94'


[4] FIRE HYDRANT
N 4995.14115
E 5195.47179
GROUND @ HYDRANT= 495.3'

[5] WATER METER
N 4993.57785
E 5201.43023
TOP=496.47'

[6] WATER STUB OUT
N 5094.27292
E 5213.57903
TOP=501.02'

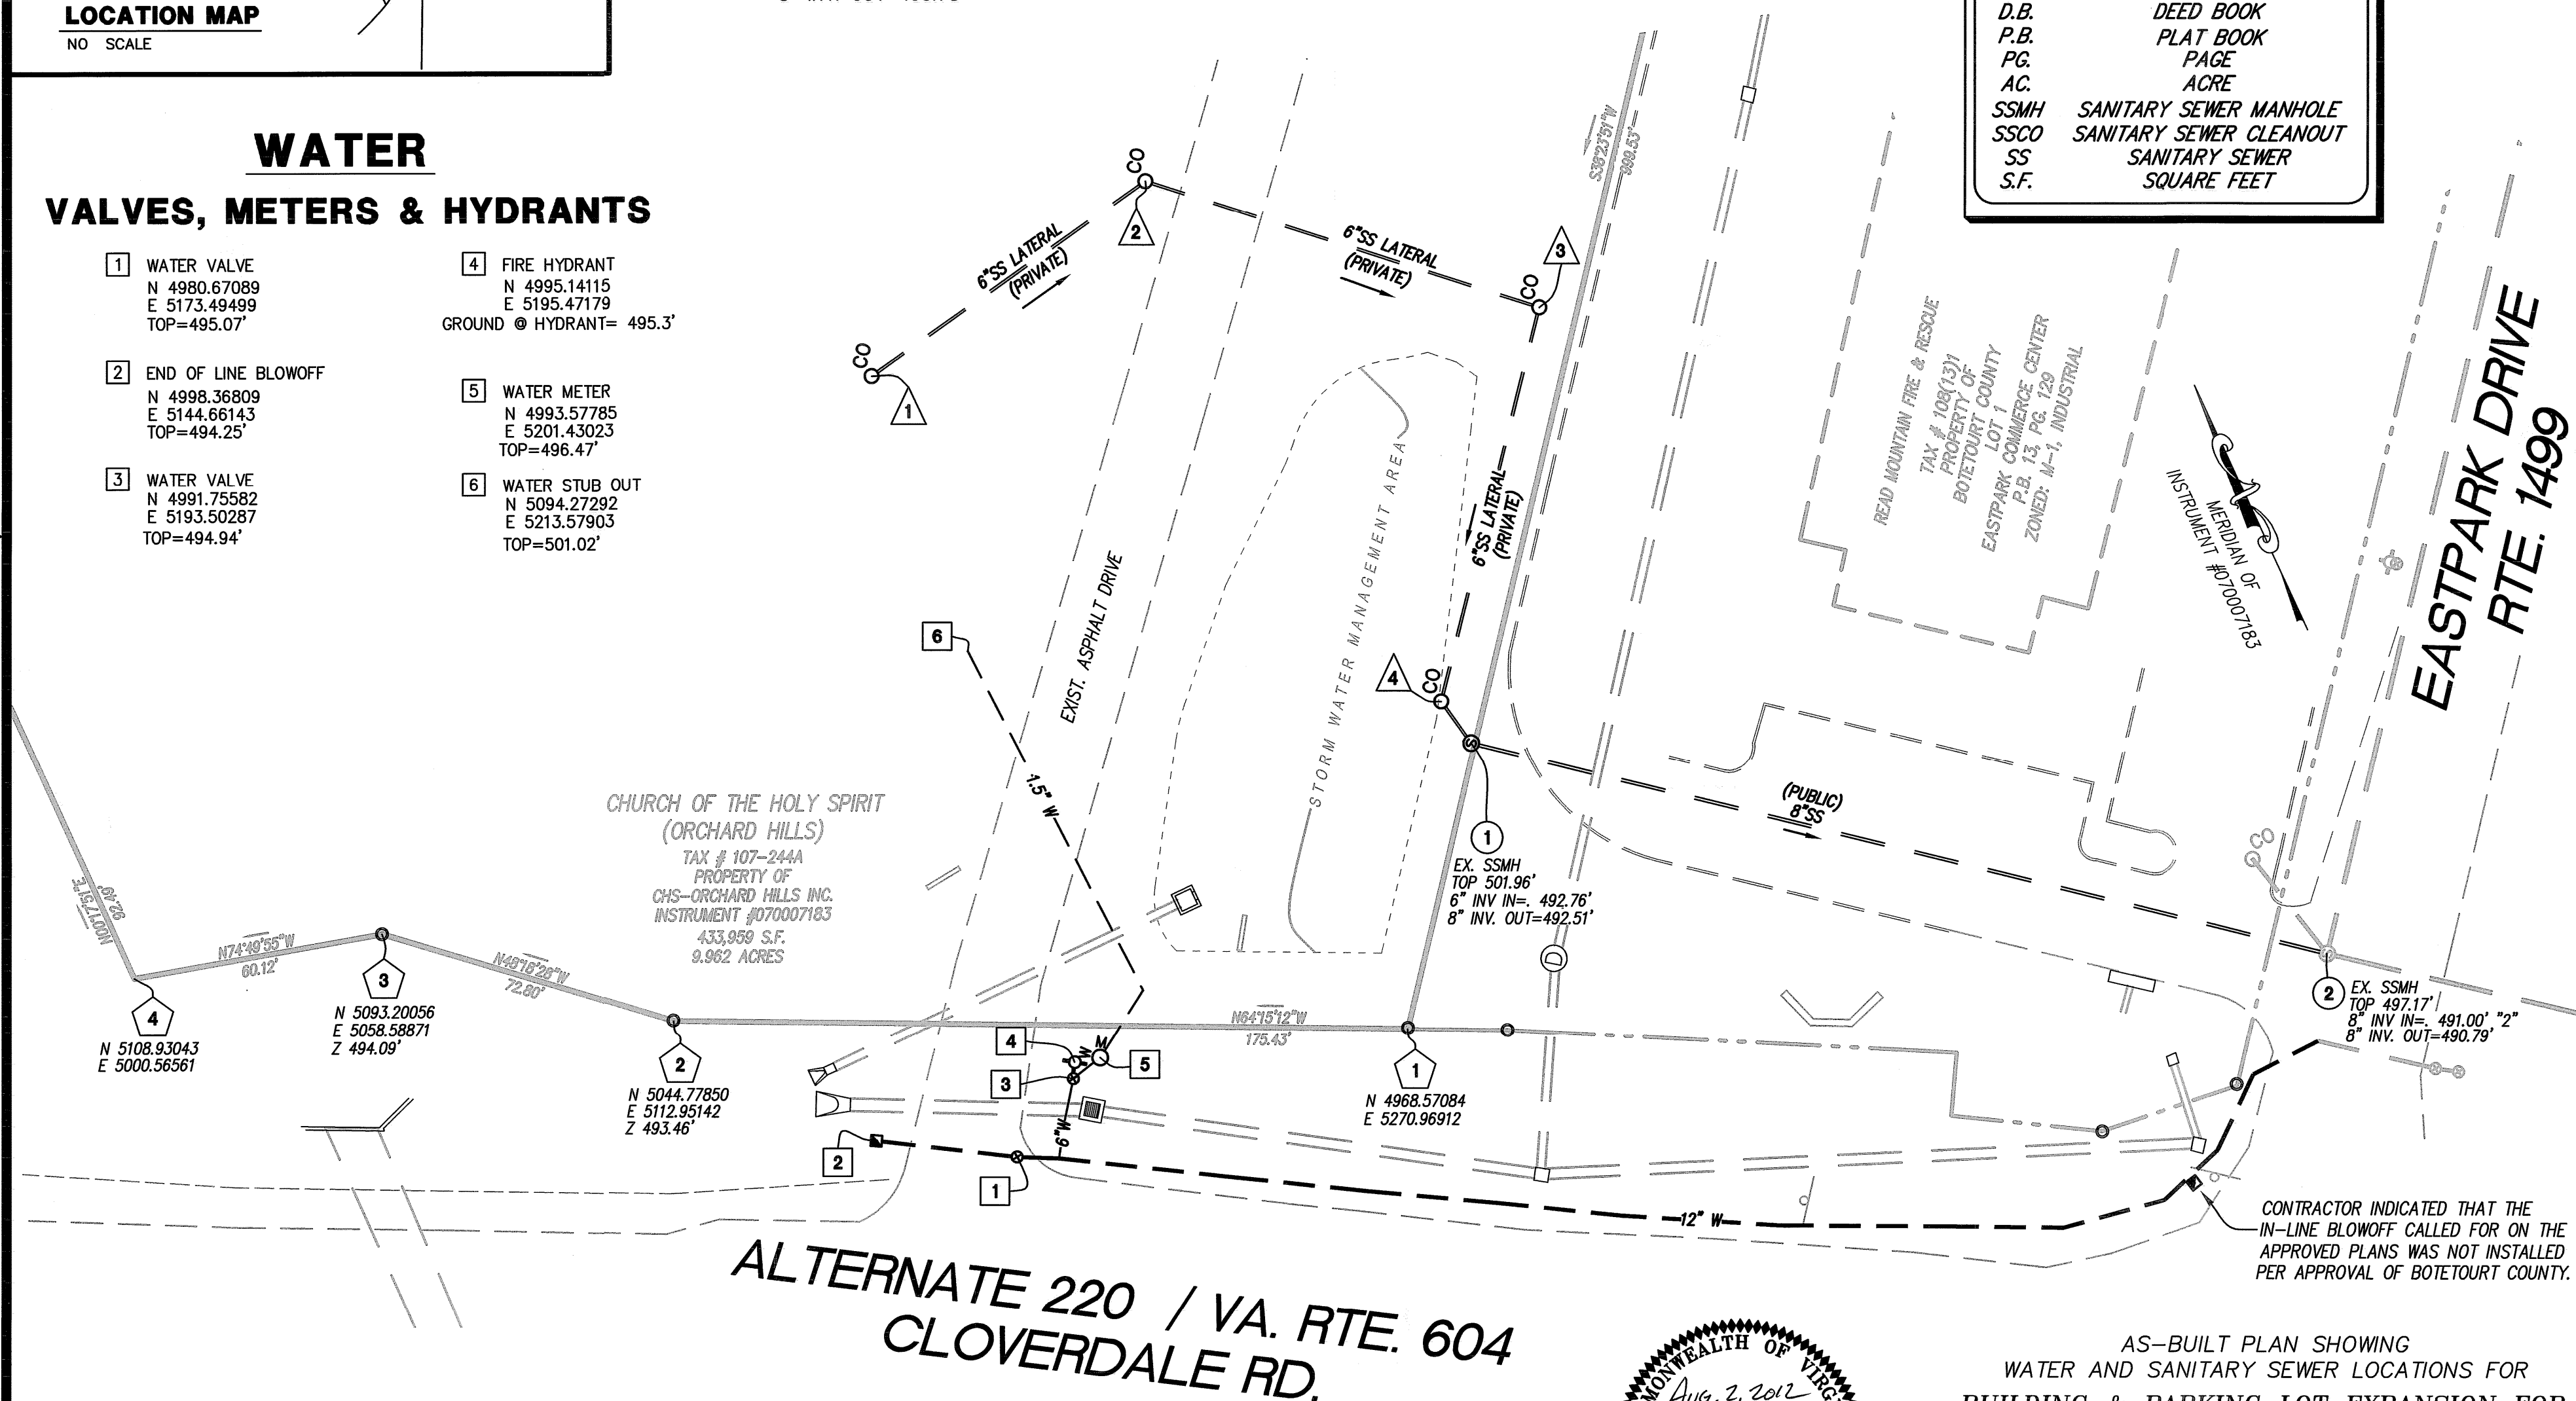


CONTRACTOR INDICATED THAT THE
— IN-LINE BLOWOFF CALLED FOR ON THE
APPROVED PLANS WAS NOT INSTALLED
PER APPROVAL OF BOTETOURT COUNTY.

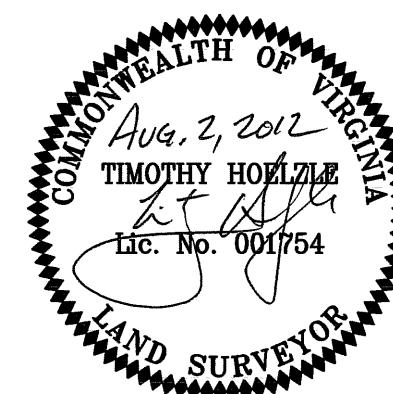

AS-BUILT PLAN SHOWING
WATER AND SANITARY SEWER LOCATIONS FOR
**BUILDING & PARKING LOT EXPANSION FOR
CHURCH OF THE HOLY SPIRIT – ORCHARD HILLS**
PREPARED FOR
CHURCH OF THE HOLY SPIRIT – ORCHARD HILLS
VALLEY MAGISTERIAL DISTRICT
BOTETOURT COUNTY, VIRGINIA

LUMSDEN ASSOCIATES, P.C.
ENGINEERS-SURVEYORS-PLANNERS
ROANOKE, VIRGINIA

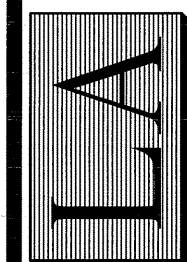

DATE:	August 2, 2012
COMM. NO.:	07-332
SCALE:	1" = 30'

PHONE: (540) 774-4411
FAX: (540) 772-9445
E-MAIL: MAIL@LUMSDENPC.COM

4664 BRAMBLETON AVENUE, SW
P.O. BOX 20669
ROANOKE, VIRGINIA 24018